
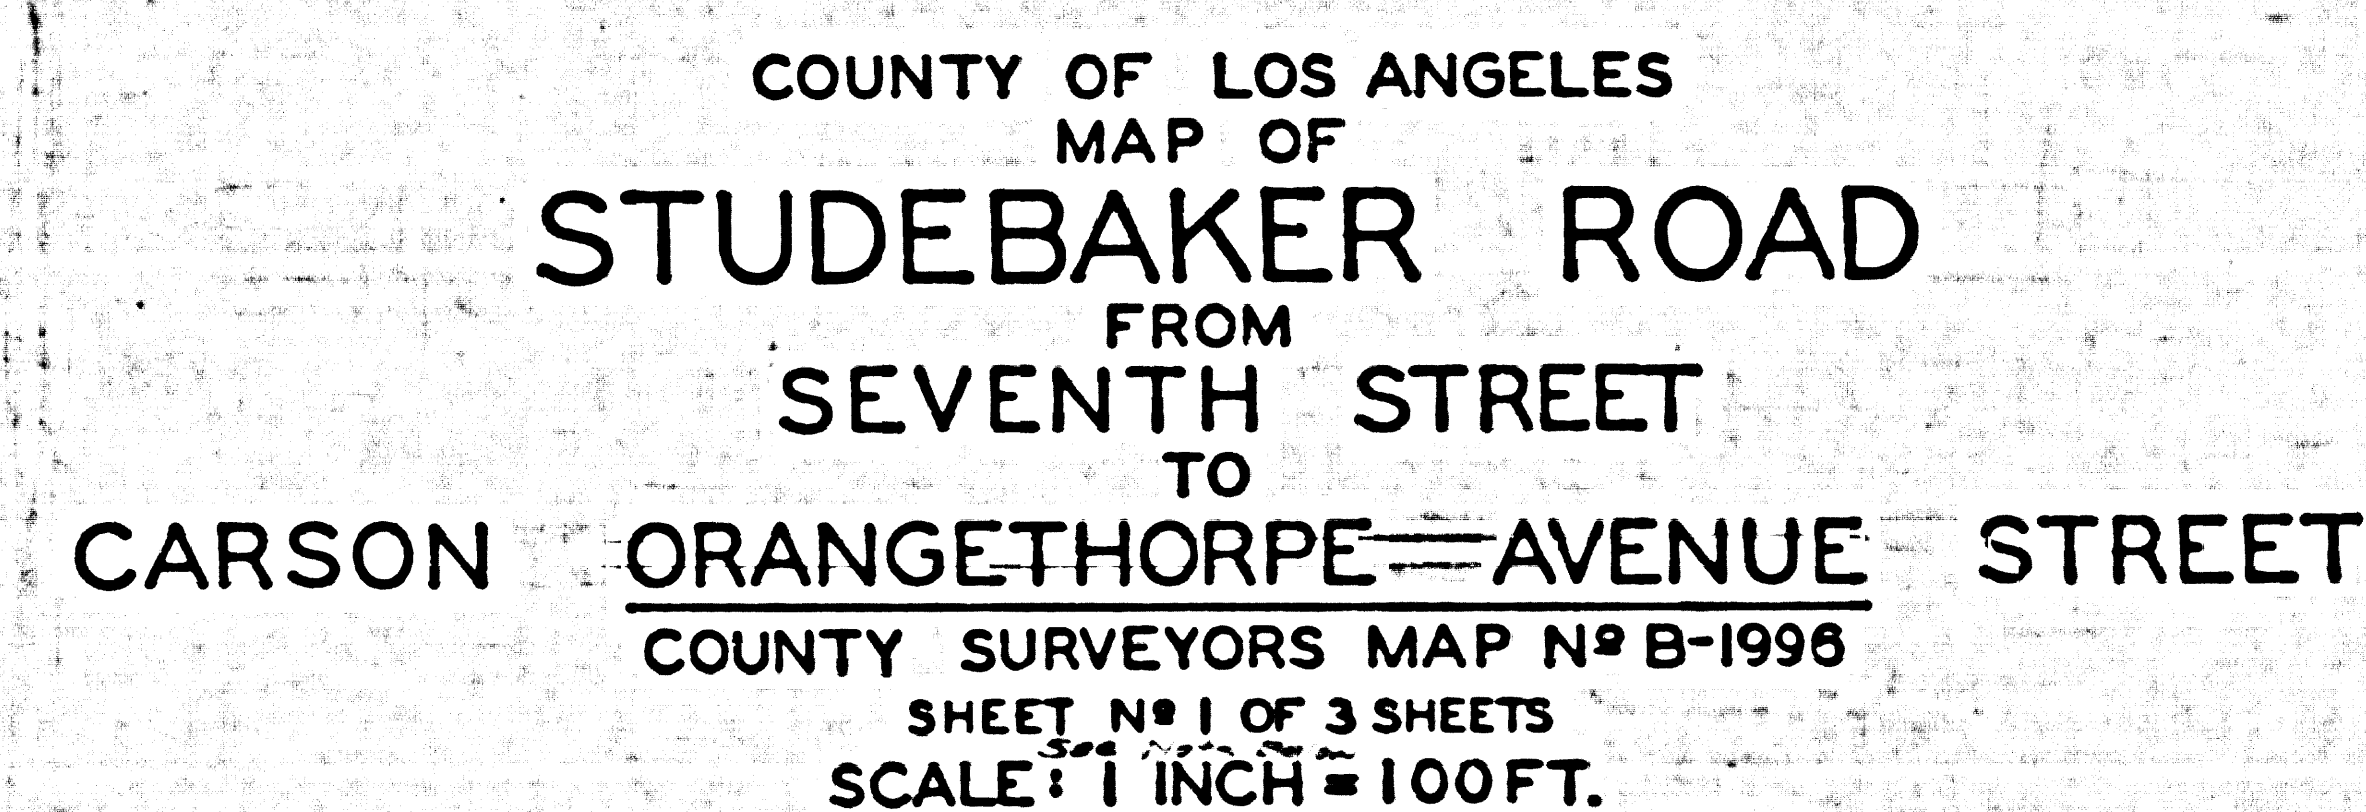


SHEET NO. 1 OF 3 SHEETS
COUNTY SURVEYORS MAP NO. B-1333

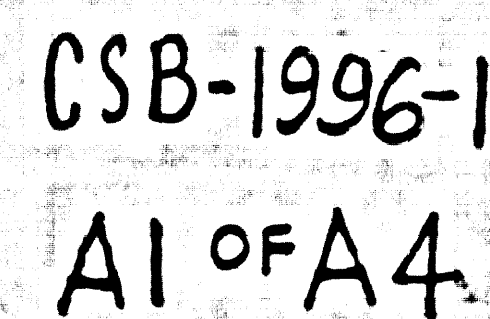

FIELD WORK BY G.H. NICHOLS
C.V. CRUMLEY
OFFICE WORK BY C.W. COX
CHECKED BY A.A. ROESE

Note ~ Sheets 223 not filed as of Nov. 1953
Revised March 1952 ~ C. M. Cox
Sheet 229 not made ~ See C.S. 668-1
Revised August, 1952 R.W.M.S.A.
SHEET NO. 3 COMPLETED AUG. 1954 L.C.W.

SUPERSEDED

BY

C.S.B-1996-1

LOS ORANGE
ANGELES

SAN

GABRIEL

~~COUNTY~~
~~COUNTY~~

ALAMITOS

S.E. 1 / 4 SEC. 35, T. 4 S., R. 12 W.

LOS

N.E. 1 / 4 SEC. 35, T. 4 S., R. 12 W.

S.E. 1/4 SEC. 35, T. 4 S., R. 12 W

CSB-1996-1

A2 OF A4

LOT 37

10548

~~STUDEBAKER~~

N 0° 03' 30" E ~ (2641.74) 2641.74 Me03

□□□□

ALAMITOS

E. 1/4 SEC. 28, T. 4 S., R. 12 W.

COUNTY

SURVEYOR

N.E. 11A

RANCHO

S.E. 1/4 SEC. 26, T. 4 S., R. 12 W.

P. 1-460-462
C.F. 228
R.F. 228
D.M. 516
D.M. 4048-240
D.M. 700-138-141

N. E. 1 / 4 SEC. 35, T. 4 S., R. 12

RANCH

CSB-1996-1
A3 of A4

