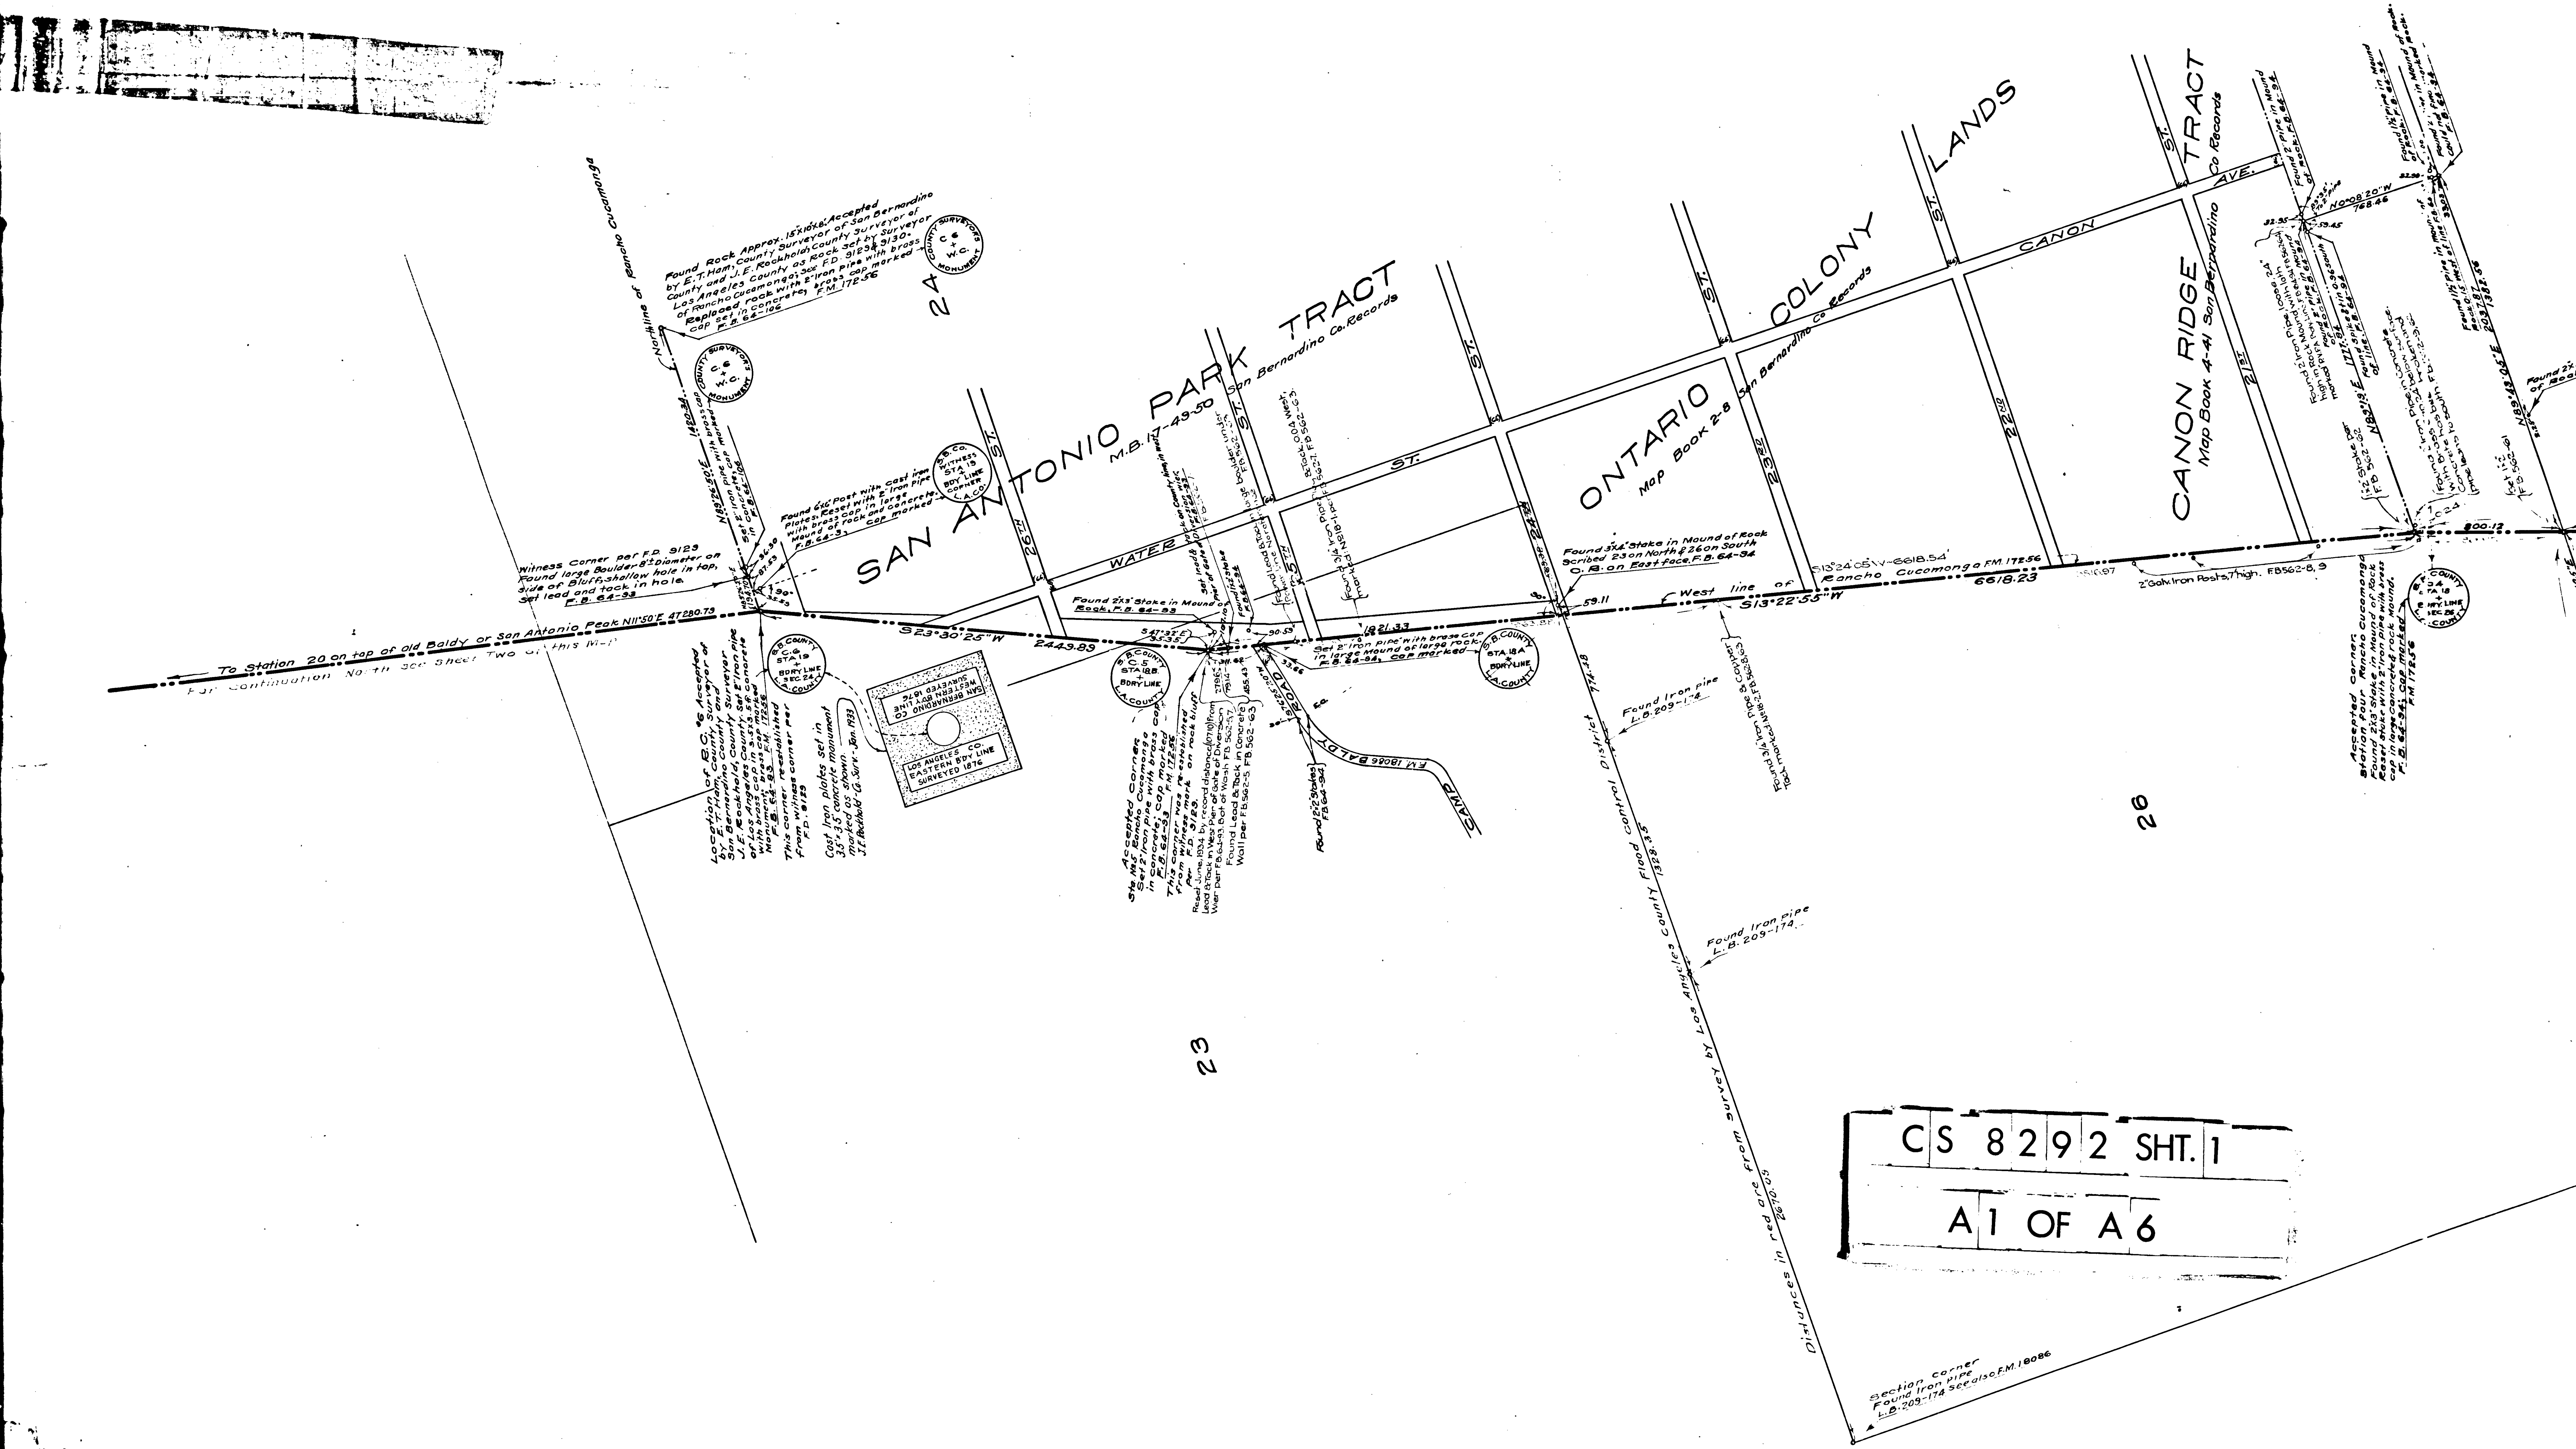

SAN ANTONIO PARK TRACT
M.B. 17-49-50 San Bernardino Co. Records
ONTARIO COLONY LANDS
Map Book 2-8 San Bernardino Co. Records
CANON RIDGE TRACT
Map Book 4-41 San Bernardino Co Records
WATER ST.
CANON AVE.
26TH ST.
25TH ST.
24TH ST.
23RD ST.
22ND ST.
21ST ST.
CAMP BALDY ROAD
F.M. 18086
24
23
26
Northline of Rancho Cucamonga
Found Rock Approx. 15"x10"x8". Accepted by E.T. Ham, County Surveyor of San Bernardino County and J.E. Rockhold, County Surveyor of Los Angeles County as Rock set by Surveyor of Rancho Cucamonga; see F.D. 9129 & 9130. Replaced rock with 2" Iron pipe with brass cap set in concrete, brass cap marked F.M. 172-56 F.B. 64-106
COUNTY SURVEYOR'S C.6 + W.C. MONUMENT
N89°26'50"E 1420.34
Set 2" Iron pipe with brass cap marked in concrete, F.B. 64-106
Found 6"x6" Post with cast iron plates. Reset with 2" Iron Pipe with brass cap in large Mound of rock and concrete, cap marked F.B. 64-3
S.B. Co. WITNESS STA 19 + BDY LINE CORNER L.A. CO.
Witness Corner per F.D. 9129 Found large Boulder 8'± Diameter on side of Bluff, shallow hole in top, Set lead and tack in hole. F.B. 64-93
To Station 20 on top of old Baldy or San Antonio Peak N11°50'E 47280.73
For Continuation North see Sheet Two of this Map
S.B. COUNTY C.6 STA 19 + BDRY LINE SEC. 24 L.A. COUNTY
Location of B.C. #6 Accepted by E.T. Ham, County Surveyor of San Bernardino County and J.E. Rockhold, County Surveyor of Los Angeles County. Set 2" Iron pipe with brass cap in 3.5x3.5 ft. concrete monument; brass cap marked F.M. 172.56 Mon. F.B. 64-93
This corner re-established from witness corner per F.D. 9129
Cast Iron plates set in 3.5'x3.5' concrete monument marked as shown. J.E. Rockhold - Co. Surv. - Jan. 1933
SAN BERNARDINO CO WESTERN B'DY LINE SURVEYED 1876
LOS ANGELES CO. EASTERN B'DY LINE SURVEYED 1876
S23°30'25"W 2449.89
Found 2"x3" Stake in Mound of Rock, F.B. 64-93
S47°32'E 35.35
S.B. COUNTY C.5 STA 18.B. + BDRY LINE L.A. COUNTY
Accepted Corner Sta. No. 5 Rancho Cucamonga Set 2" Iron pipe with brass cap in concrete; cap marked F.M. 172.56 F.B. 64-93
This corner was re-established from witness mark on rock bluff per F.D. 9129.
Reset June, 1934 by record distance (107.10) from Lead & Tack in West Pier of Gate of Diversion Wier per F.B. 64-93. Bot of Wash F.B. 562-57
Found Lead & Tack in Concrete Wall per F.B. 562-5, F.B. 562-63
Found 2"x2" Stakes F.B. 64-94
1821.33
Set 2" Iron pipe with brass cap in large Mound of large rock. F.B. 64-94, cap marked
S.B. COUNTY STA. 18A BDRY LINE L.A. COUNTY
Found 3"x4" Stake in Mound of Rock Scribed 23 on North & 26 on South C.R. on East face. F.B. 64-94
59.11
West line of Rancho Cucamonga F.M. 172.56
S13°22'55"W 6618.23
S13°24'05"W - 6618.54'
2" Galv. Iron Posts, 7' high. F.B. 562-8, 9
774.48
Found Iron pipe L.B. 209-174
Found 3/4 Iron Pipe & Copper Tack marked No. 18-2, F.B. 562-8, 63
Los Angeles County Flood Control District 1328.35
Found Iron pipe L.B. 209-174
Distances in red are from survey by Los Angeles County Flood Control District 2670.05
Section corner Found Iron pipe L.B. 209-174 See also F.M. 18086
N0°08'20"W 768.46
Found 2" Pipe in Mound of Rock. F.B. 64-94
Found 1½" pipe in Mound of Rock. F.B. 64-94
N89°19'E 1777.
N89°43'05"E 2037.87 1382.56
800.12
Accepted Corner Station Four Rancho Cucamonga Found 2x3" Stake in Mound of Rock Reset stake with 2" Iron pipe with brass cap in large Concrete & rock mound. F.B. 64-94; Cap marked F.M. 172.56
S.B. COUNTY STA 18 + BDRY LINE SEC. 26 L.A. COUNTY
CS 8292 SHT. 1
A1 OF A6

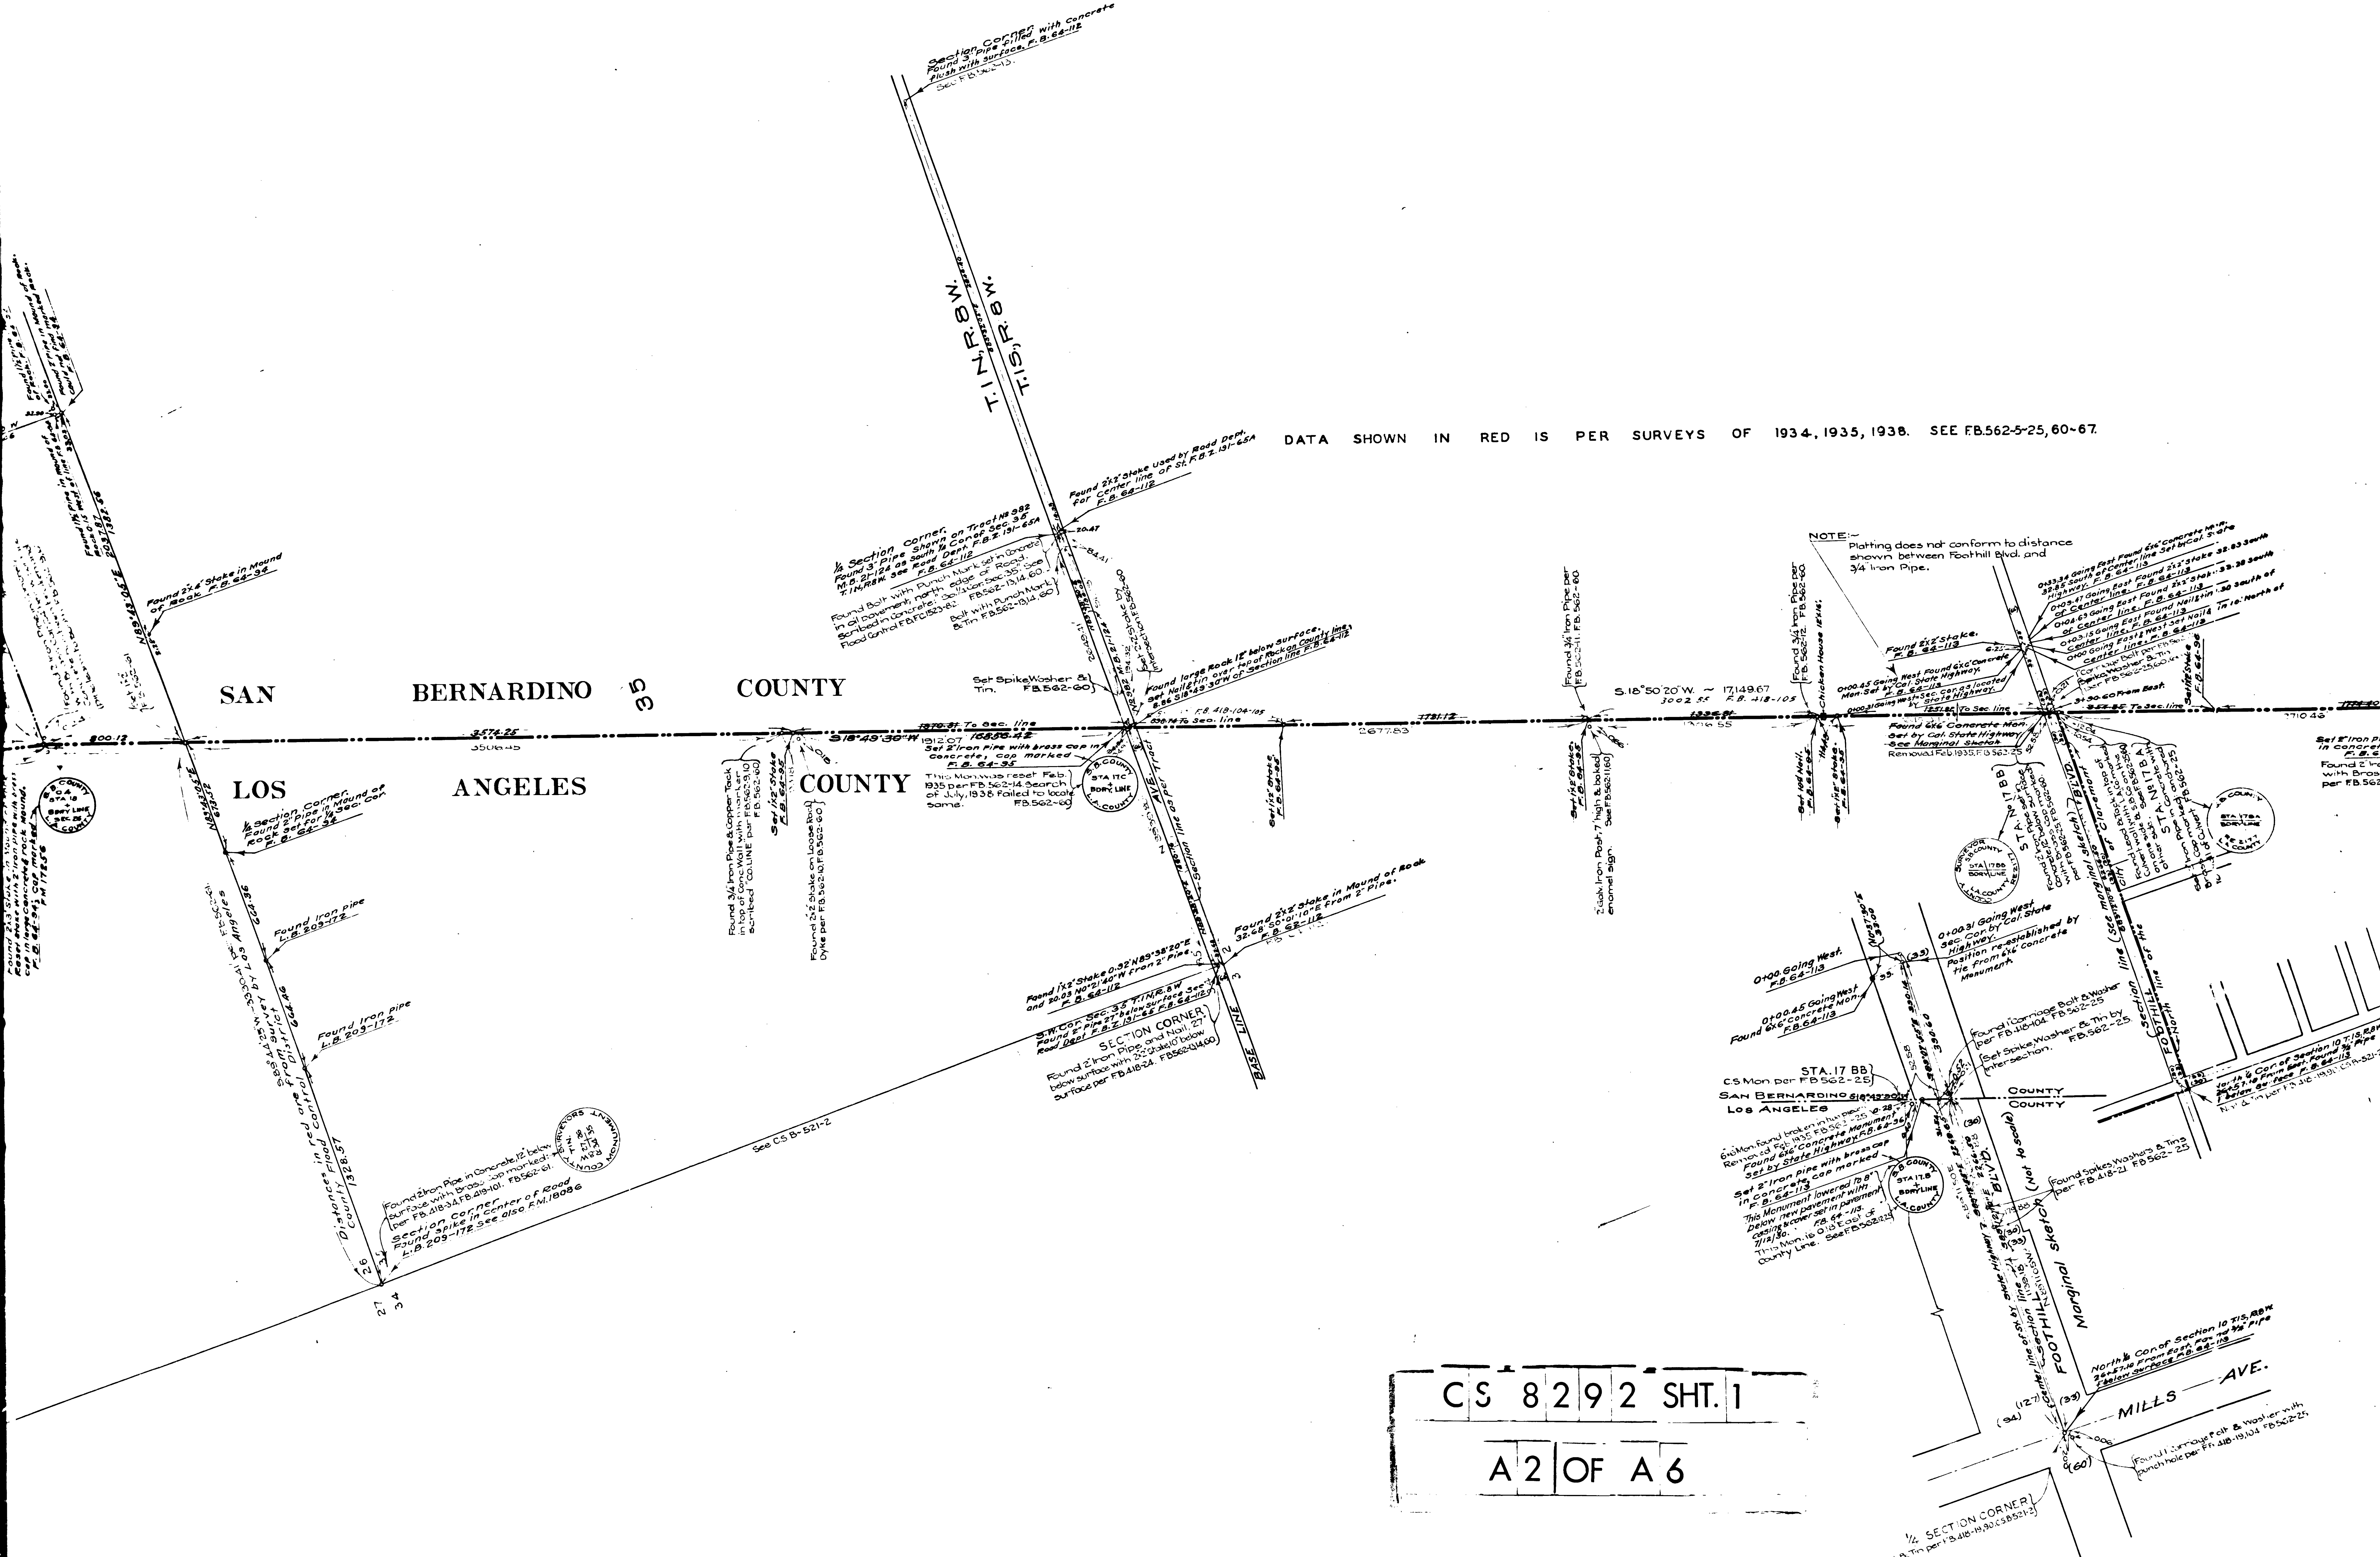

DATA SHOWN IN RED IS PER SURVEYS OF 1934, 1935, 1938. SEE F.B.562-5~25, 60~67.
SAN BERNARDINO COUNTY
LOS ANGELES COUNTY
35
T.1N.,R.8W.
T.1S.,R.8W.
Section Corner. Found 3" Pipe filled with Concrete flush with surface. F.B. 64-112
See F.B.562-13.
Found 1½" pipe in mound of Rock. F.B. 64-34
Found 2" Pipe in Mound of Rock. Could not find marked Rock. F.B. 64-34
Found 1½" Pipe in mound of Rock 0.15 West of line F.B. 64-94
2037.87
1382.66
N89°43'05"E
Found 2"x4" Stake in Mound of Rock F.B. 64-34
Set 1x2 F.B. 562-61
800.12
3574.25
3506.45
N89°43'05"E
673.52
¼ Section Corner. Found 2" Pipe in Mound of Rock set for ¼ Sec. Cor. F.B. 64-34
Found 2x3 Stake in Mound of Rock. Reset stake with 2" iron pipe with brass cap in large concreted rock mound. F.B. 64-94; Cap marked F.M. 17856
S.B. COUNTY 0.4 STA 18 + BDRY LINE SEC. 26 L.A. COUNTY
664.36
Found Iron pipe L.B. 209-172
664.46
Found Iron pipe L.B. 209-172
S.89°44'25"W. ~3330.41 per F.B.562-61.
Survey by Los Angeles County Flood Control District
Distances in red are from survey by Los Angeles County Flood Control District
1328.57
Found 2" Iron Pipe in Concrete, 12" below surface with Brass cap marked: per F.B. 418-34, F.B. 419-101. F.B.562-61.
Section Corner Found spike in center of Road L.B. 209-172 See also F.M. 18086
COUNTY SURVEYORS MONUMENT T.1N. R.8W 27 26 34 35
26
35
27
34
See C.S B-521-2
Found 3/4" Iron Pipe & Copper Tack in top of Conc. Wall with marker scribed "CO. LINE" per F.B.562-9,10 F.B.562-60
Set 1x2" Stake F.B. 64-95
Found 2x2 Stake on Loose Rock Dyke per F.B.562-10, F.B.562-60
0.18
1870.81 To Sec. line
S18°49'30"W 1912.07
16856.42
Set 2" Iron Pipe with brass cap in Concrete, cap marked F.B. 64-95
This Mon. was reset Feb. 1935 per F.B.562-14. Search of July, 1938 failed to locate same. F.B.562-60
S.B. COUNTY STA 17C + BDRY. LINE L.A. COUNTY
¼ Section Corner. Found 3" Pipe Shown on Tract No 982 M.B. 21-124 as South ¼ Cor. of Sec. 35 T.1N.,R.8W. See Road Dept. F.B.Z. 131-65A F.B. 64-112
Found Bolt with Punch Mark set in Concrete in oil pavement, north edge of Road. Scribed in concrete: "So. ¼ Cor. Sec. 35". See Flood Control F.B.F.C.1523-82. F.B.562-13,14,60.
Bolt with Punch Mark & Tin. F.B.562-13,14,60
Found 2"x2" Stake used by Road Dept. for Center line of St. F.B.Z. 131-65A F.B. 64-112
20.47
84.41
2649.11
M.B. 21-124
No 982
194.32
Set 2x2 Stake by intersection. F.B.562-60
Set Spike Washer & Tin. F.B.562-60
Found large Rock 12" below surface. Set Nail & tin over top of Rock on County line, 8.86 S18°49'30"W of Section line F.B. 64-112
F.B. 418-104-105
838.74 To Sec. line
AVE. line as per Tract
Section line
BASE LINE
Set 1x2" Stake F.B. 64-95
2677.83
1781.12
Found 2"x2" Stake in Mound of Rock 32.68' S0°01'10"E from 2" Pipe. F.B. 62-112
Found 1x2" Stake 0.32' N89°38'20"E and 20.03 N0°21'40"W from 2" Pipe. F.B. 64-112
S.W. Cor. Sec. 35 T.1N.,R.8W Found 2" Pipe 27" below surface See Road Dept F.B.Z. 131-65 F.B. 64-112
SECTION CORNER Found 2" Iron Pipe and Nail, 27" below surface with 2x2 stake, 10" below surface per F.B.418-24. F.B.562-13,14,60
Found 3/4" Iron Pipe per F.B.562-11. F.B. 562-60
S.18°50'20"W. ~ 17,149.67
3002.55 F.B. 418-105
1336.81
1306.55
Set 1x2" Stake. F.B. 64-95
0.86
2" Galv. Iron Post, 7' high & baked enamel sign. See F.B.562-11,60
Found 3/4" Iron Pipe per F.B. 562-12. F.B.562-60
Chicken House 18'x16'
Set 10d Nail. F.B. 64-95
Set 1x2" Stake. F.B. 64-95
NOTE:~ Platting does not conform to distance shown between Foothill Blvd. and 3/4" Iron Pipe.
Found 2x2" Stake. F.B. 64-113
0+00.45 Going West Found 6x6" Concrete Mon. Set by Cal. State Highway. F.B. 64-113
0+00.31 Going West = Sec. Cor. as located by State Highway.
1251.86 To Sec. line
Found 6x6" Concrete Mon. Set by Cal. State Highway See Marginal Sketch
Removed Feb. 1935. F.B.562-25
0+33.34 Going East Found 6x6" Concrete Mon. 32.85 South of Center line Set by Cal. State Highway. F.B. 64-113
0+09.47 Going East Found 2x2" Stake 32.83 South of Center line. F.B. 64-113
0+04.69 Going East Found 2x2" Stake 33.28 South of Center line. F.B. 64-113
0+03.15 Going East Found Nail & tin 1.30 South of Center line. F.B. 64-113
0+00 Going East & West set Nail & tin 10' North of Center line. F.B. 64-113
Carriage Bolt per F.B.562 Spike Washer & Tin per F.B.562-25,60
3+90.60 From East.
357.85 To Sec. line
Set 1x2" Stake F.B. 64-96
1710.46
Set 2" Iron Pipe in concrete F.B. 6
Found 2" Iron with Brass per F.B.562
STA. No 17 BB
Found 2" Iron Pipe set in Concrete 12" below surface with Brass cap marked per F.B.562-25. F.B.562-60.
SURVEYOR S.B. COUNTY STA 17BB BDRY LINE L.A. COUNTY RE 2.17
(See marginal sketch) BLVD.
of Claremont
City
Found Lead & Tack in top of Culvert wall with L.A. Co. on the one side & S.B. Co. on the other side. See F.B.562-25,60
STA. No 17 B.A.
Iron Pipe in Concrete with Brass Cap marked F.B.562-25
S.B. COUNTY STA 17BA BDRY LINE RE 2.17 L.A. COUNTY
Section line of the FOOTHILL North line
0+00 Going West. F.B. 64-113
0+00.45 Going West Found 6x6" Concrete Mon. F.B. 64-113
N0°37'30"E 33.00
(33)
0+00.31 Going West Sec. Cor. by Cal. State Highway. Position re-established by tie from 6x6" Concrete Monument.
S89°07'55"E 390.14
390.60
Found 1" Carriage Bolt & Washer per F.B.418-104. F.B.562-25
Set Spike, Washer & Tin by intersection. F.B.562-25.
STA. 17 BB
C.S. Mon. per F.B.562-25
SAN BERNARDINO
LOS ANGELES
COUNTY
COUNTY
52.58
6x6 Mon. found broken in two pieces Removed Feb. 1935. F.B.562-25
Found 6x6" Concrete Monument Set by State Highway. F.B. 64-36
Set 2" Iron Pipe with brass cap in concrete, cap marked F.B. 64-113
This Monument lowered to 8" below new pavement with casing & cover set in pavement 7/12/30. F.B. 64-113.
This Mon. is 0.18' East of County Line. See F.B.562-25
S.B. COUNTY STA 17.B + BDRY LINE L.A. COUNTY
(30)
BLVD.
(Not to scale)
Found Spikes, Washers & Tins per F.B.418-21. F.B.562-25
Center line of St. by State Highway
Section line
FOOTHILL
Marginal Sketch
North ¼ Cor. of Section 10 T.1S.,R.8W. 26+57.10 From East. Found ½" Pipe 1' below surface F.B. 64-113
N.W. & Tin per F.B. 418-19,90. C.S.B-521-2
North ¼ Cor. of Section 10 T.1S.,R.8W. 26+57.10 From East. Found ½" Pipe 1' below surface F.B. 64-113
(127)
(33)
(94)
MILLS AVE.
(60)
0.06
Found 1" Carriage Bolt & Washer with punch hole per F.B. 418-19,104. F.B.562-25
¼ SECTION CORNER Nail & Tin per F.B.418-19,90. C.S.B-521-2
CS 8292 SHT. 1
A2 OF A6

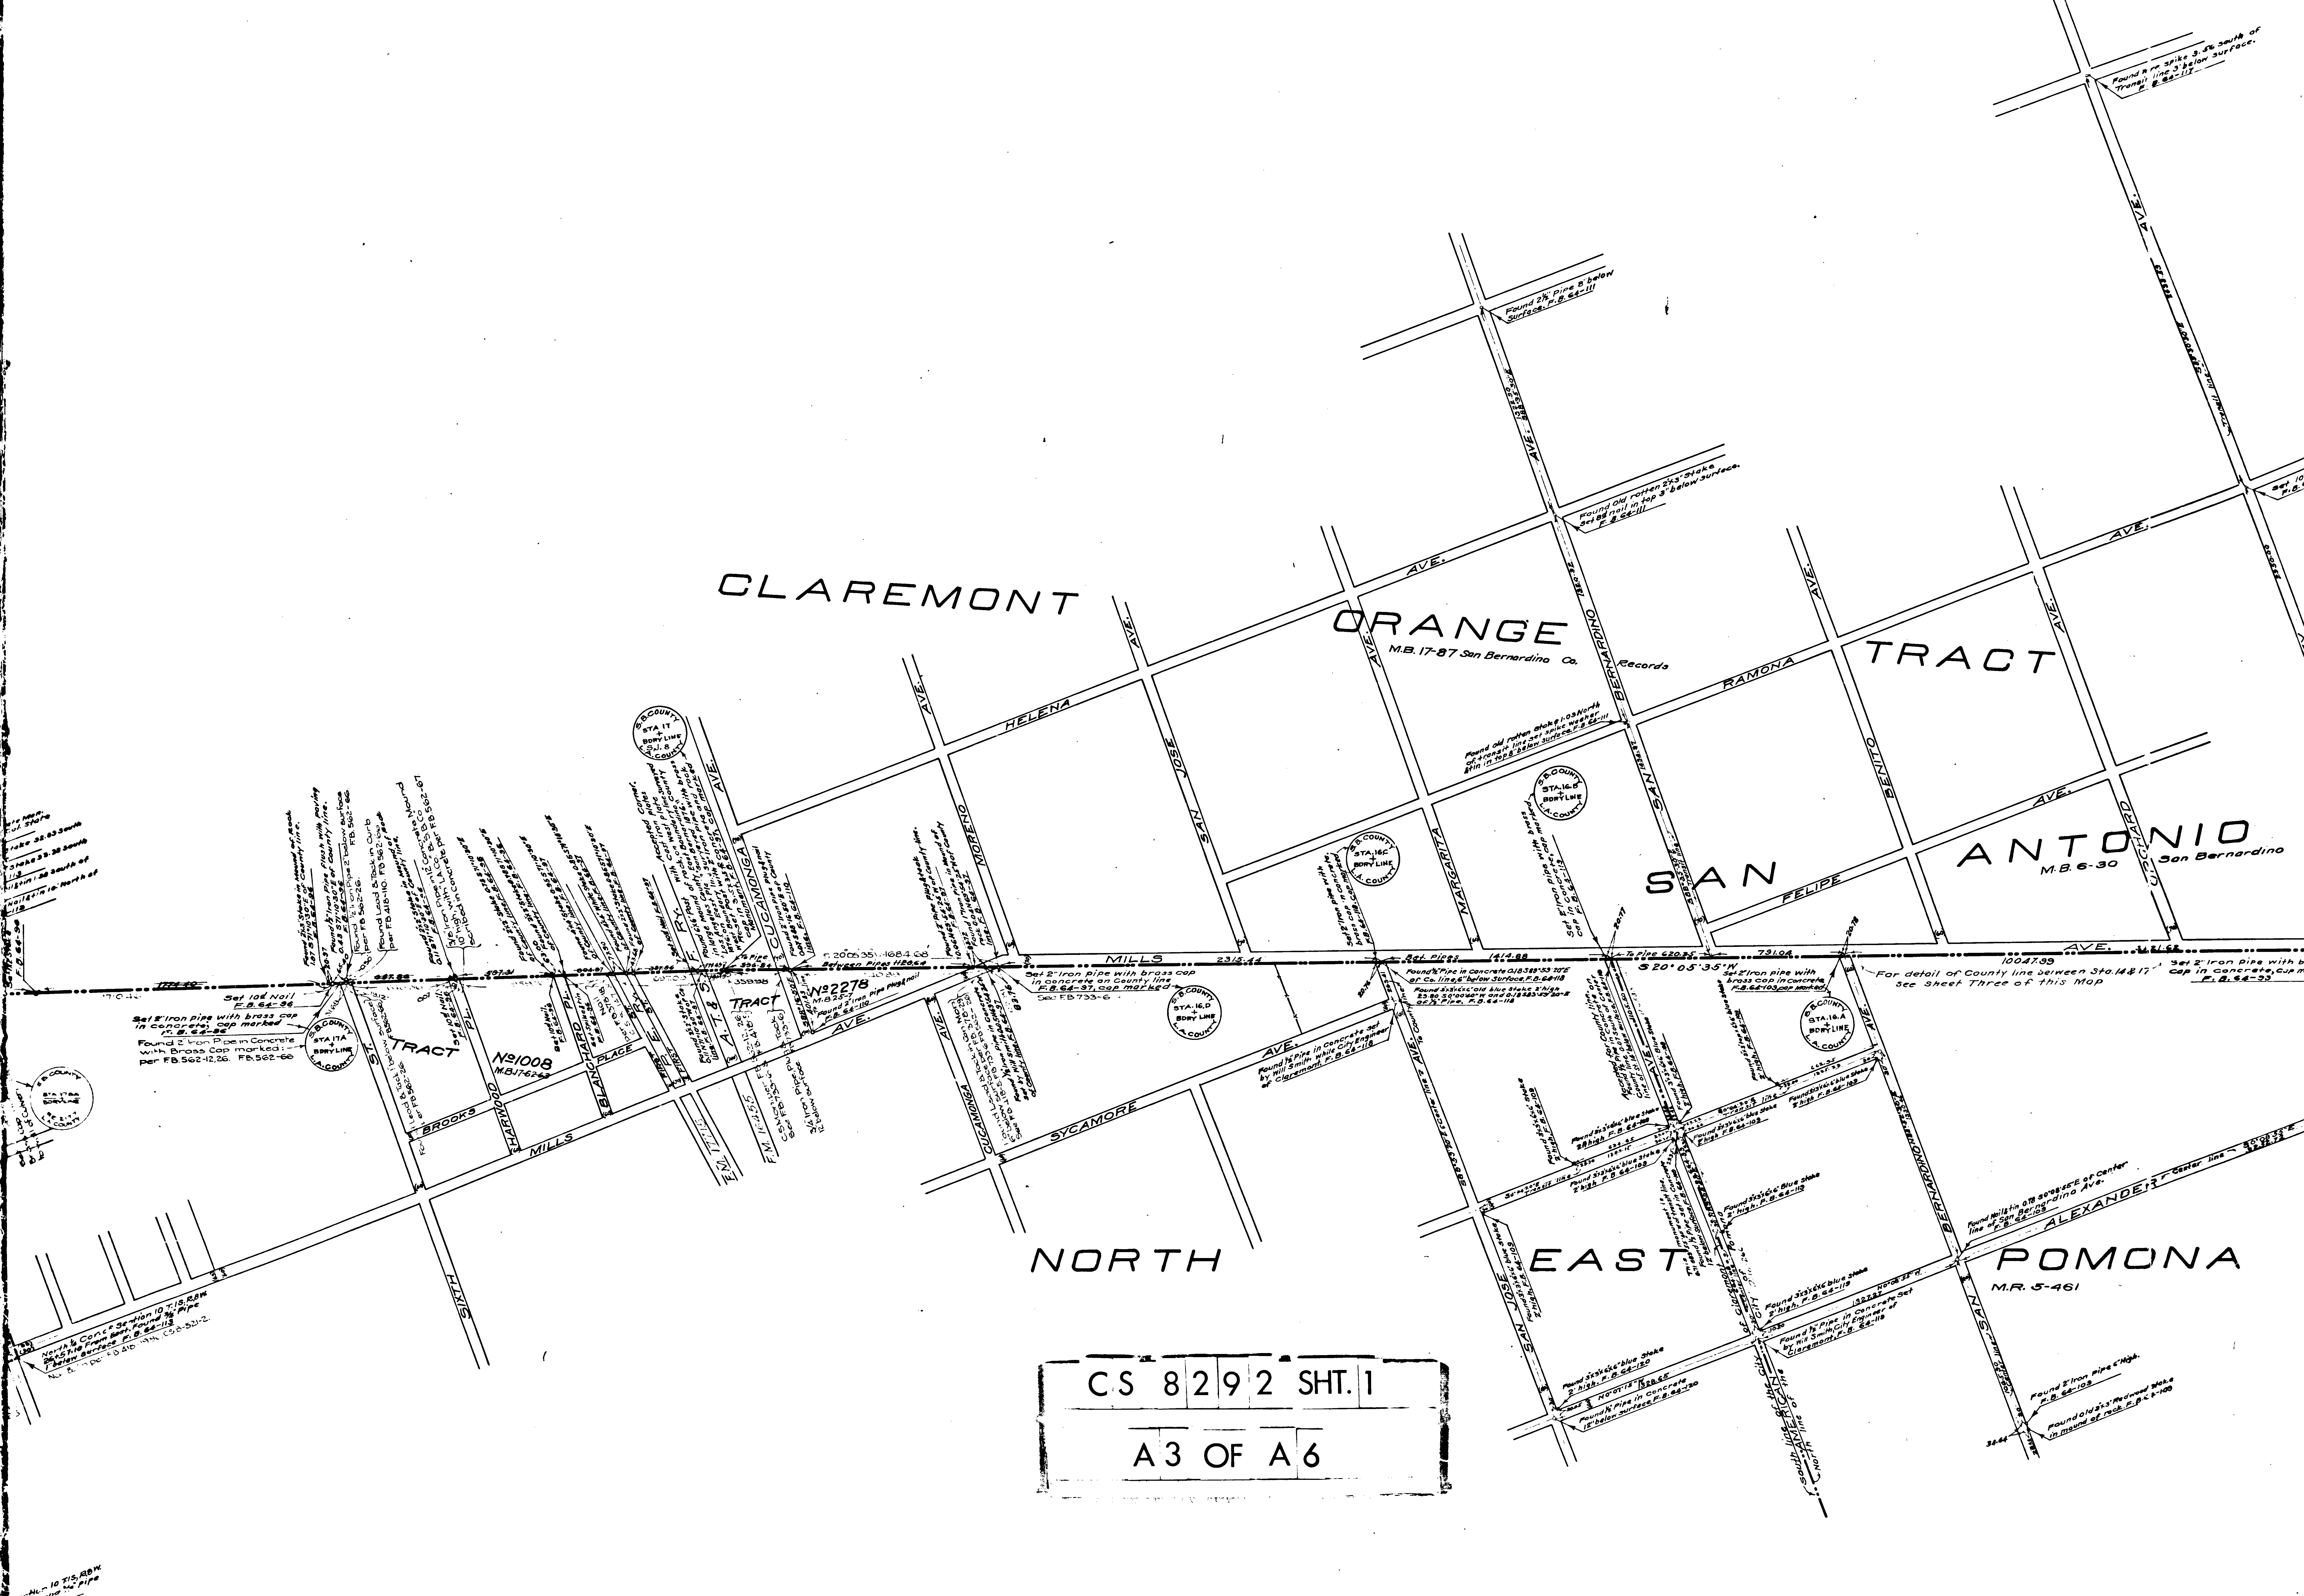

CS 8292 SHT. 1

A3 OF A6

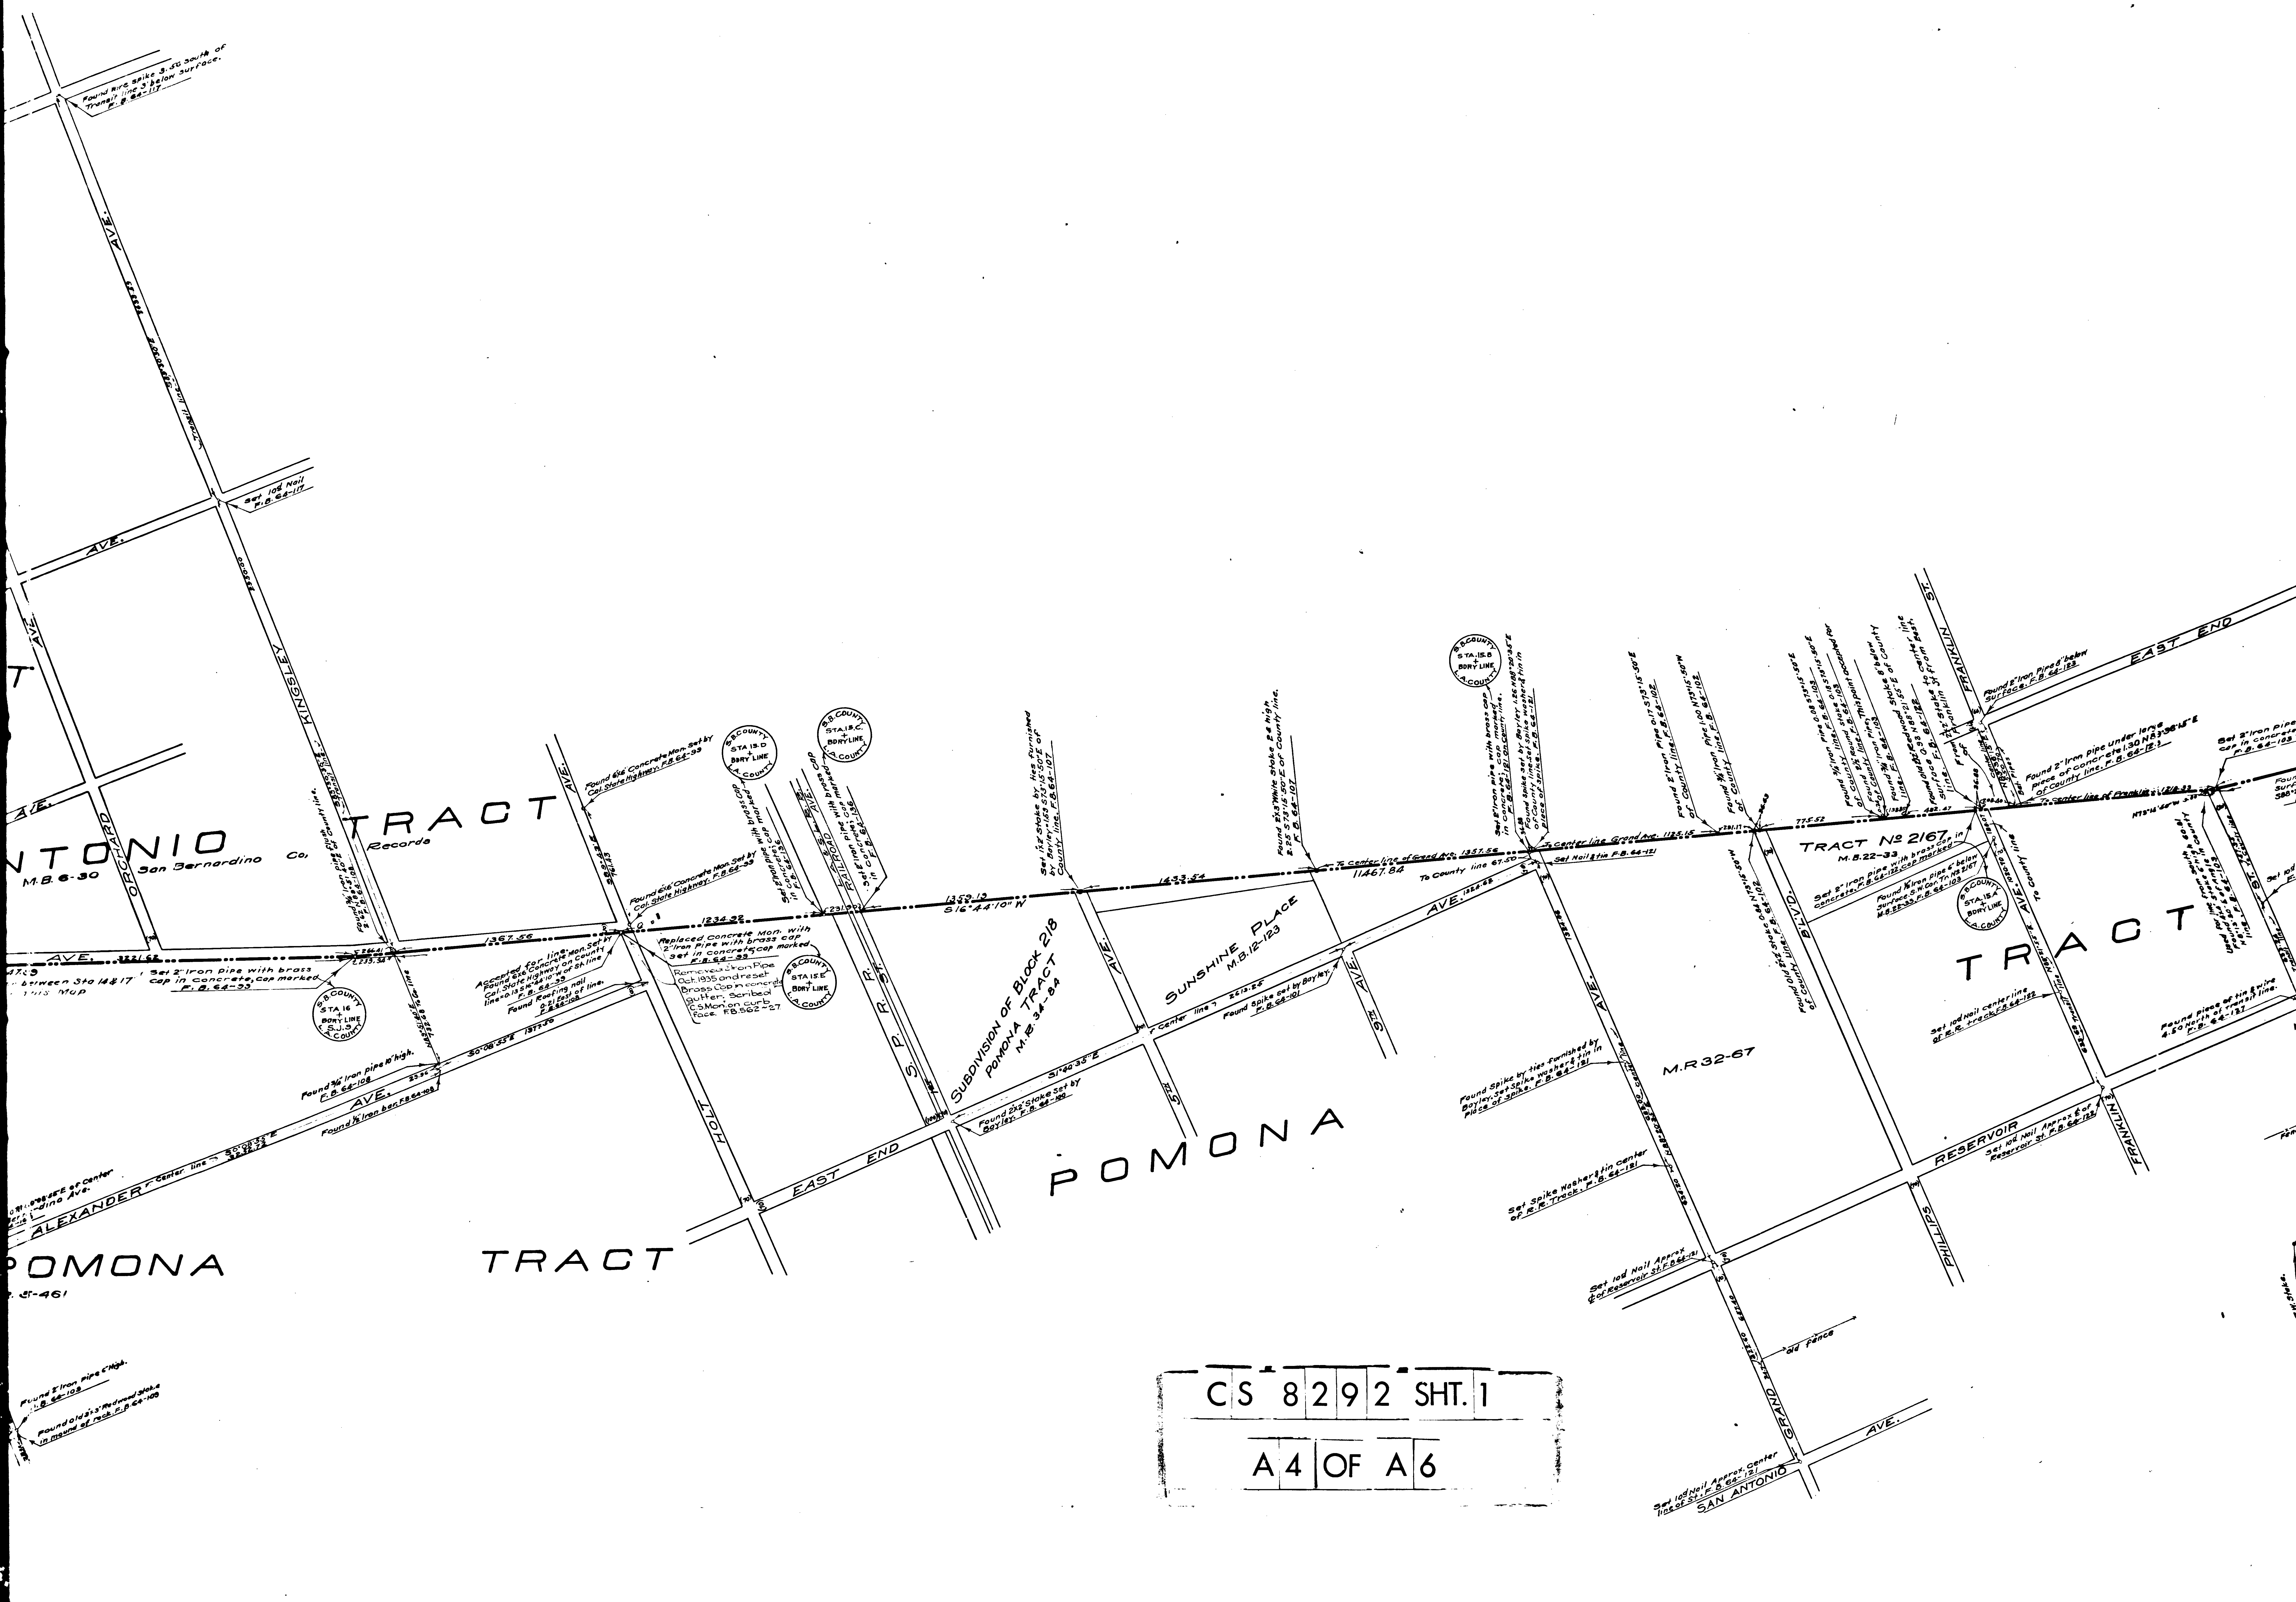

Found wire spike 3.56 south of Transit line 3' below surface. F.B. 64-117
AVE.
Transit line S.23°30'30"E
Set 10d Nail F.B. 64-117
KINGSLEY
2350.00
ORCHARD
ANTONIO TRACT
M.B. 6-30
San Bernardino Co. Records
ALEXANDER AVE.
POMONA TRACT
Set 2" Iron pipe with brass cap in concrete, cap marked F.B. 64-33
S.B. COUNTY STA 16 + BDRY LINE S.J.3 L.A. COUNTY
1367.56
Found 3/4" Iron pipe 10" high. F.B. 64-108
Found 1/2" Iron bar. F.B. 64-108
S0°08'55"E 1377.50
Accepted for line. Found 6x6 Concrete Mon. Set by Col. State Highway on County line=0.13 S16°44'10"W of Sh line F.B. 64-33
Found Roofing nail 0.21 East of line. F.B. 64-108
Found 6x6 Concrete Mon. Set by Col. State Highway. F.B. 64-33
Replaced Concrete Mon. with 2" Iron Pipe with brass cap set in concrete, cap marked F.B. 64-33
Removed Iron Pipe Oct. 1935 and reset Brass Cap in concrete gutter. Scribed C.S. Mon. on curb face. F.B. 562-27
HOLT
EAST END
1234.32
S.B. COUNTY STA 15.D + BDRY LINE L.A. COUNTY
S.B. COUNTY STA 15.E + BDRY LINE L.A. COUNTY
S.B. COUNTY STA 15.C + BDRY LINE L.A. COUNTY
RAILROAD
S.P. R.R. ST.
1359.13
S16°44'10"W
SUBDIVISION OF BLOCK 218 POMONA TRACT M.B. 34-84
Found 2x2 Stake Set by Bayley. F.B. 64-100
S1°40'35"E
Set 1x2 Stake by ties furnished by Bayley = 1.53 S73°15'50"E of County line. F.B. 64-107
1433.54
SUNSHINE PLACE M.B. 12-123
Found Spike set by Bayley. F.B. 64-101
9TH AVE.
5TH
POMONA
Found 2x3 White Stake 24 high 2.25 S73°15'50"E of County line. F.B. 64-107
To center line of Grand Ave. 1357.56
11467.84
To County line 67.50
S.B. COUNTY STA 15.B + BDRY LINE L.A. COUNTY
Set 2" Iron pipe with brass cap in concrete; cap marked F.B. 64-121 on County line.
Found Spike set by Bayley 1.26 N88°20'35"E of County line. Set Spike washer & tin in place of spike. F.B. 64-121
Set Nail & tin F.B. 64-121
To center line Grand Ave. 1125.15
Found Spike by ties furnished by Bayley. Set Spike washer & tin in place of spike. F.B. 64-121
Set Spike washer & tin center of R.R. Track. F.B. 64-121
M.R. 32-67
GRAND AVE.
Set 10d Nail Approx. ℄ of Reservoir St. F.B. 64-121
old fence
Set 10d Nail Approx. center line of St. F.B. 64-121
SAN ANTONIO AVE.
Found 2" Iron Pipe 0.17 S73°15'50"E of County line. F.B. 64-102
Found 3/4" Iron Pipe 1.00 N73°15'50"W of County line. F.B. 64-102
775.52
Found Old 2x2 Stake 0.84 N73°15'50"W of County line. F.B. 64-102
TRACT Nº 2167 M.B. 22-33
Set 2" Iron pipe with brass cap in concrete. F.B. 64-122, cap marked
Found 1/2" Iron pipe 6" below surface. S.W. Cor. Tr. Nº 2167 M.B. 22-33. F.B. 64-103
S.B. COUNTY STA 15.A + BDRY LINE L.A. COUNTY
B'LV'D.
482.47
Found 2" Iron Pipe 8" below surface. F.B. 64-123
FRANKLIN ST.
EAST END
Found 2" Iron pipe under large piece of concrete 1.30 N83°36'15"E of County line. F.B. 64-123
To center line of Franklin 1218.33
Set 10d Nail center line of R.R. track. F.B. 64-122
RESERVOIR
Set 10d Nail Approx. ℄ of Reservoir St. F.B. 64-122
PHILLIPS
FRANKLIN
TRACT
Found piece of tin & wire 4.50 North of transit line. F.B. 64-127
Set 2" Iron pipe with brass cap in concrete. F.B. 64-103
Found 2" Iron pipe 6" high. F.B. 64-103
Found old 3x3 Redwood stake in mound of rock. F.B. 64-109
CS 8292 SHT. 1
A4 OF A6

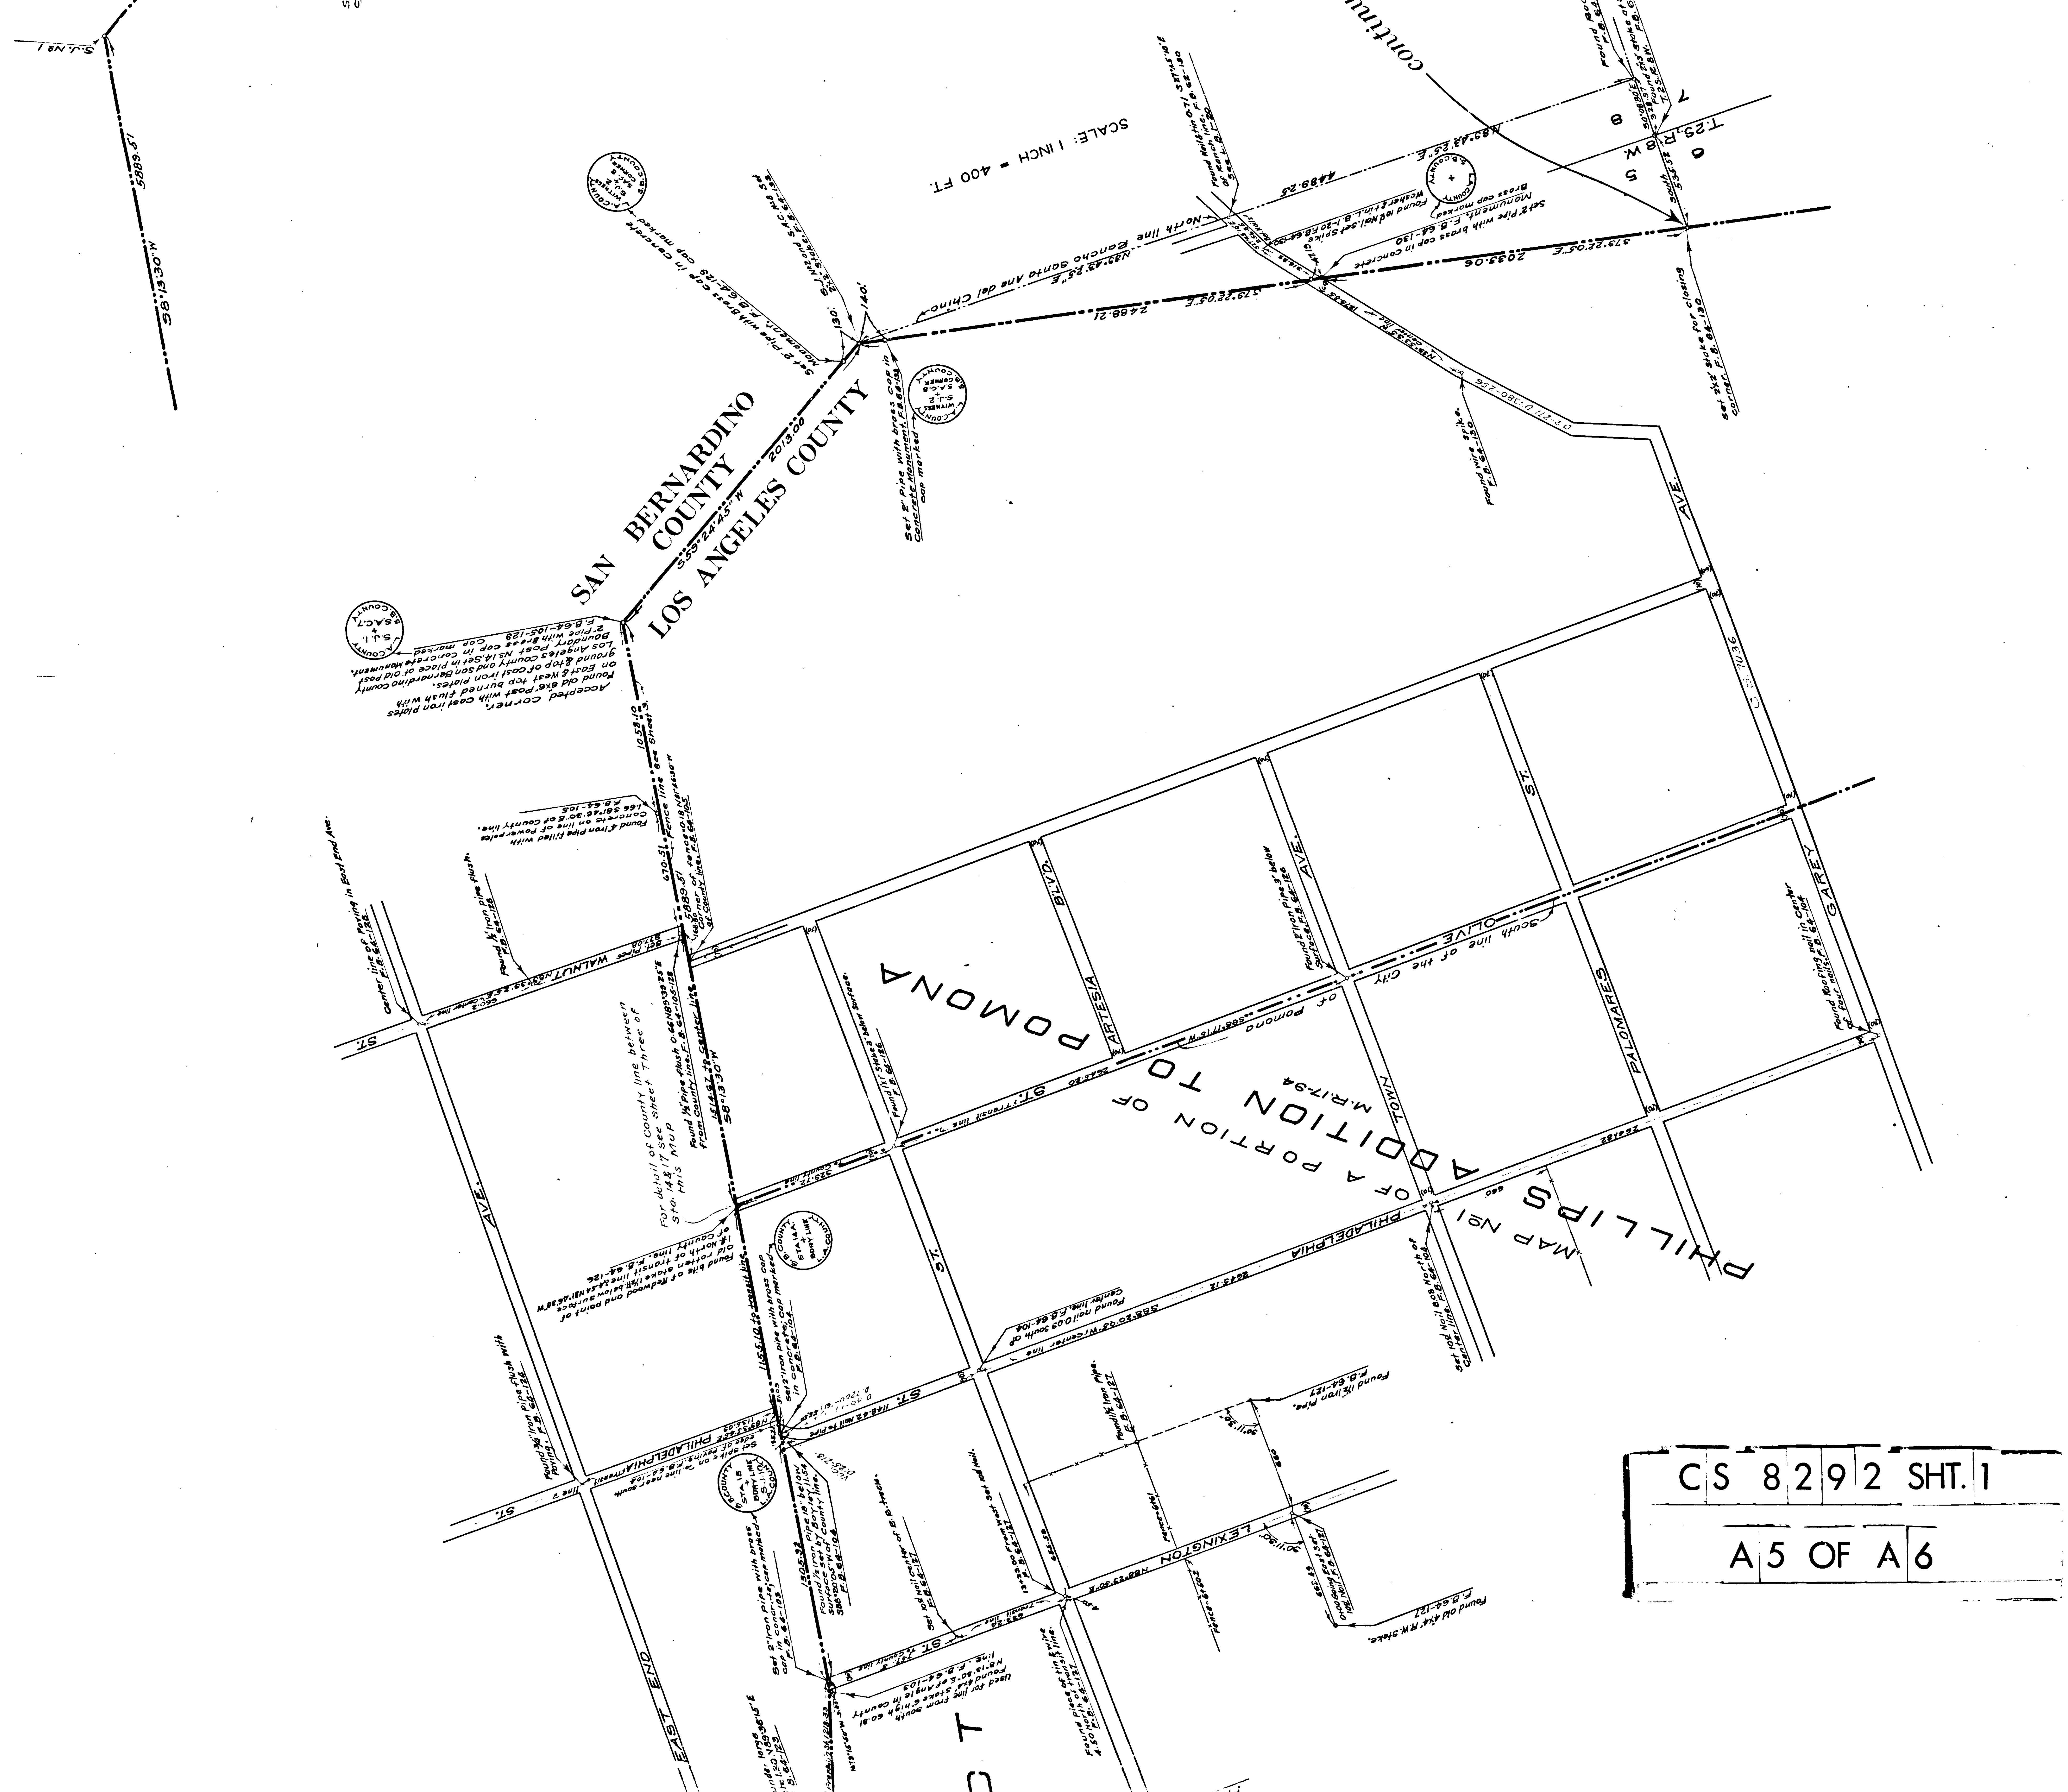

SCALE: 1 INCH = 400 FT.
SAN BERNARDINO COUNTY
LOS ANGELES COUNTY
North line Rancho Santa Ana del Chino
T.2S.R.8W.
PHILLIPS ADDITION TO POMONA
MAP No1 OF A PORTION OF
M.R.17-94
South line of the City of Pomona
WALNUT ST.
OLIVE ST.
PHILADELPHIA ST.
LEXINGTON
EAST END AVE.
ARTESIA B'LVD.
TOWN AVE.
PALOMARES ST.
GAREY AVE.
For detail of County line between Sta. 14 & 17 see Sheet Three of this Map
CS 8292 SHT. 1
A5 OF A6

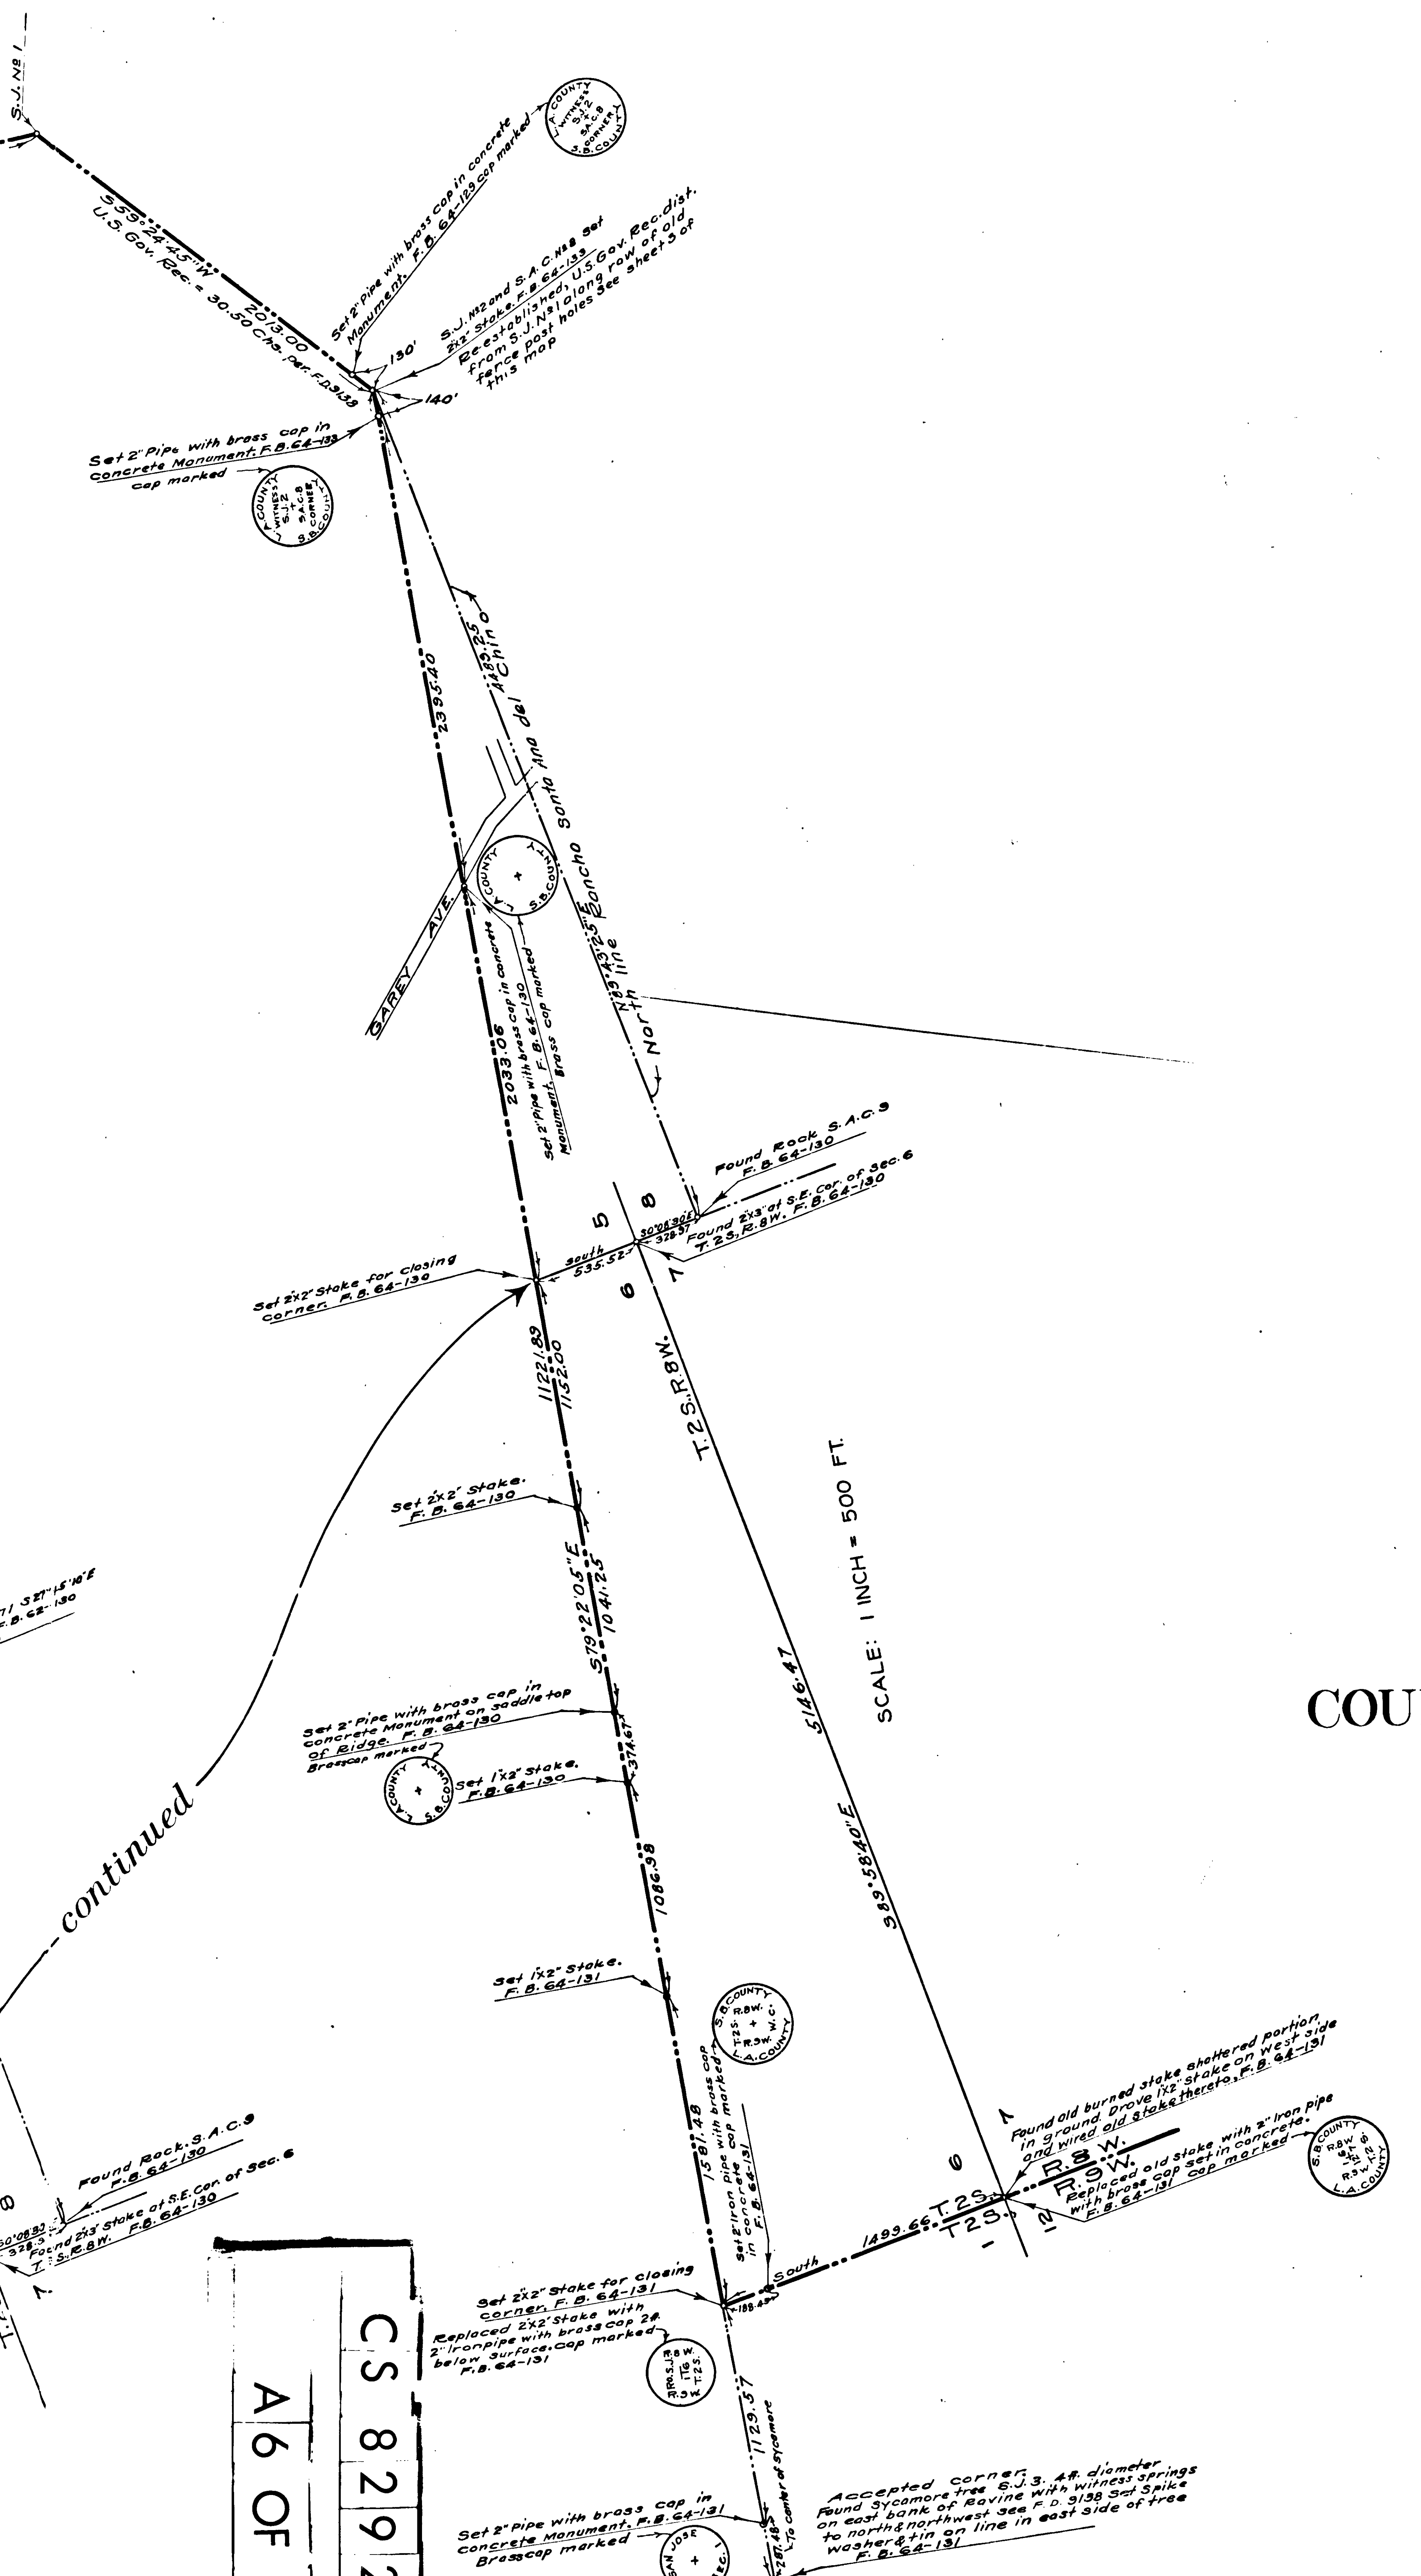

MAP OF

BOUNDARY LINE
BETWEEN THE
COUNTIES OF LOS ANGELES AND SAN BERNARDINO
AS RESURVEYED BY
COUNTY SURVEYORS OF SAID COUNTIES

SHEET 1 OF 3 SHEETS

SCALE 1 INCH = 400 FEET

J. E. Rockhold, County Surveyor of Los Angeles County.
Edgar T. Ham, County Surveyor of San Bernardino County

Surveyed in 1920 and 1921
Bearings based on Solar Observations

Field Work by...H. I. Comly and J. P. Kemmerer....Deputies
Office Work by.....................A. D. Irwin.....Deputy.
Checked by.....................J. M. Kingsbury.....Deputy.

FIELD BOOK 64 (LOS ANGELES COUNTY)

See F.M. 18620

INDEX 49
" 50

CS	8292	SHT. 1
A6	OF	A6