FED. ROAD DIST. No.	STATE	FED. AND PROJ. No.	FISCAL YEAR	SHEET No.	TOTAL SHEETS
2	CAL.				

DIST.	COUNTY	ROUTE	SEC.	SHEET No.	TOTAL SHEETS
VII	LA	60	A	27	

D.W. Lorentzen
Dist. Eng. Dist. VII

Approved .....

Engineer, Surveys and Plans.

RANCHO TOPANGA MALIBU SEQUIT

F.M. 11260-2
~~C.S. B 1200-2~~

SOLSTICE CANYON ROAD C.S. B 8856

Malibu Road

℄ 80' R/W described in O.R. 12839-30 C.S.-B. 588

E 32+217.0 R 16845-253 (1)
Const Plant Mixed Resurfacing - Var. Width

D 97-255 O.R. 12839-30

3⅛" O.D. Steel tubing pipe water line (State owned)

2" R.W.s. So. Cal. Edison Co. O.R. 11391-280

Const 10' P.C.C. Pav't

Const 0.33' Plant Mixed Surfacing - Var. Width

Const Plant Mixed Resurfacing - Var. Width

30' P.C.C. Pav't at Br.

Heavy wire mesh debris fence

Also E 19+194.0 O.R. 15228-342

(Rattlesnake Point)

E 32+217.0 R 16845-253 (2)

Remove Existing P.C.C. Pav't - Var. Width

Const 0.33' Plant Mixed Surfacing - 0.33' Thick

Const Plant Mixed Resurfacing - Var. Width

Const 0.33' Plant Mixed Surfacing - Var. Width

Remove Existing P.C.C. Pav't - Var. Width

Fd Ldplkg & Track (6.00' Rt. P.O.S.T. 167.05')

Valve

20'-30' Bituminous Mac. Pav't

Remove Existing P.C.C. Pav't - Var. Width No 356, 76.97 on Right

20' Bit. Mac. Pav't

20' P.C.C. Pav't

Const 10' P.C.C. Pav't

Ld pipe line

18" R.C.M.P. drain

Mean high tide Sept. 1928 Co. Surv.

(Elev. 1.93 U.S.G.S.) C.S.-B. 307-57

80' R/W per S. Co. C. No. 135650 (O.R. 9434-338) D 78-22

N 84°37'05" E 1854.16

F.M. 10588-3

F.M. 11260-3

F.M. 11260-4

F.M.

FED. ROAD DIST. No.	STATE	FED. AID PROJ. No.	FISCAL YEAR	SHEET No.	TOTAL SHEETS
2	CAL.				

DIST.	COUNTY	ROUTE	SEC.	SHEET No.	TOTAL SHEETS
VII	LA	60	A	28	

D.W. Montelyon
Dist. Eng. Dist. VII

Approved .....

Engineer, Surveys and Plans.

RANCHO TOPANGA MALIBU SEQUIT

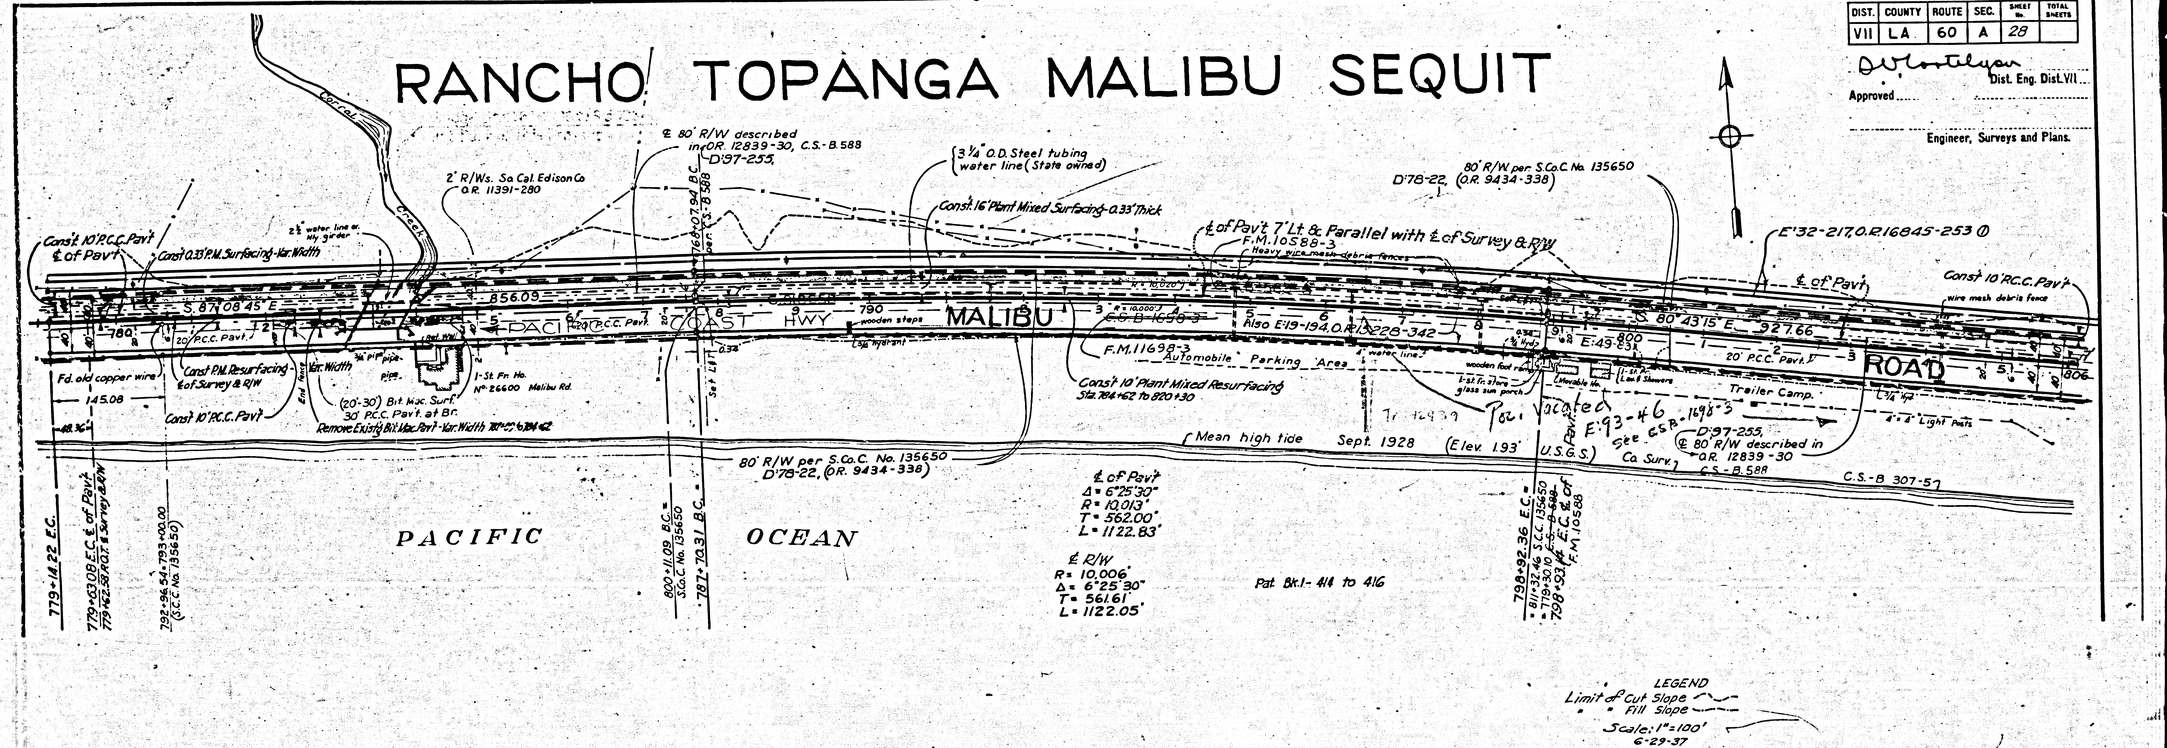

F.M. 11260-3

A 2 OF A 14

FED. ROAD DIST. No.	STATE	FED. AID PROJ. No.	FISCAL YEAR	SHEET No.	TOTAL SHEETS
2	CAL.				

DIST.	COUNTY	ROUTE	SEC.	SHEET No.	TOTAL SHEETS
VII	LA	60	A	29	

Dist. Eng. Dist. VII

Approved

Engineer, Surveys and Plans.

This is FM-11260-3

RANCHO TOPANGA MALIBU SEQUIT

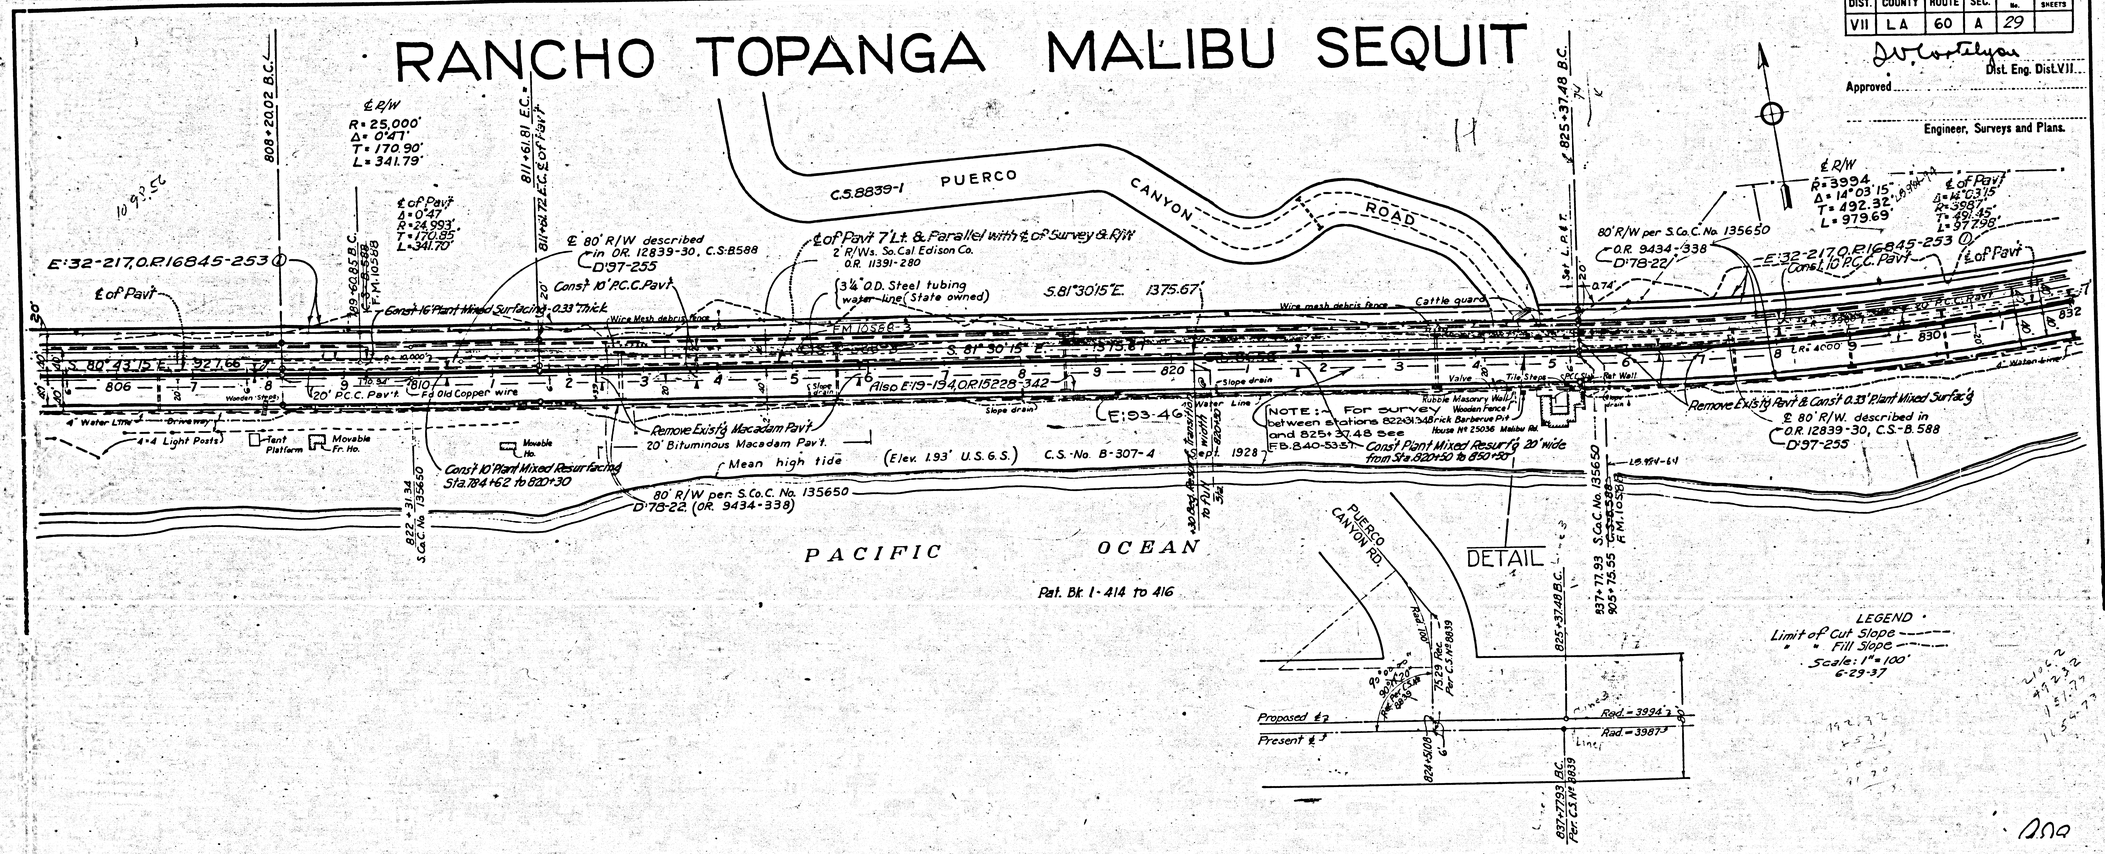

F.M. 11260-3

A3 OF A14

This is CSB-1260-3

DIST. No.	STATE	PROJ. No.	YEAR	No.	SHEETS
2	CAL.				

DIST.	COUNTY	ROUTE	SEC.	SHEET No.	TOTAL SHEETS
VII	LA	60	A	30	

Dist. Eng. Dist. VII.

Approved

Engineer, Surveys and Plans.

RANCHO TOPANGA MALIBU SEQUIT

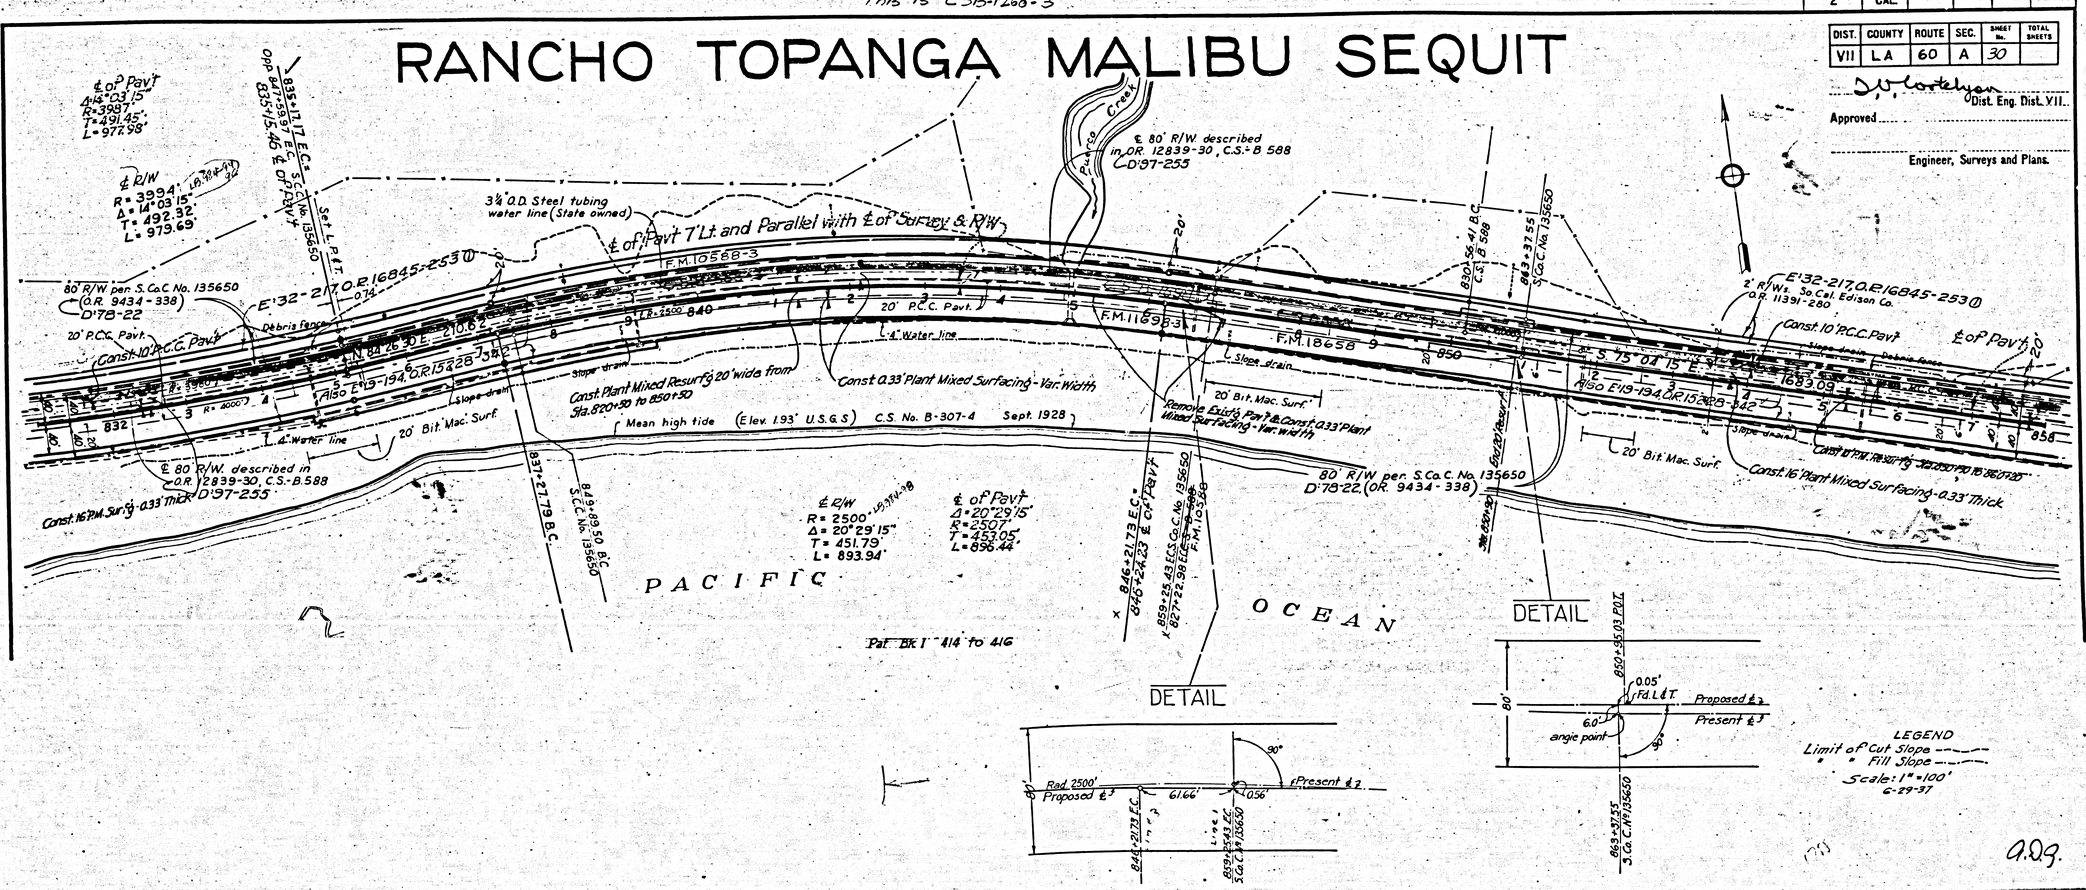

A.D.G.

F.M. 11260-3

A4 OF A14

This is CSB-1260-3

FED. ROAD DIST. No.	STATE	FED. AID PROJ. No.	FISCAL YEAR	SHEET No.	TOTAL SHEETS
2	CAL.				

DIST.	COUNTY	ROUTE	SEC.	SHEET No.	TOTAL SHEETS
VII	LA	60	A	31	

Dist. Eng. Dist. VII

Approved ...

Engineer, Surveys and Plans.

RANCHO TOPANGA MALIBU SEQUIT

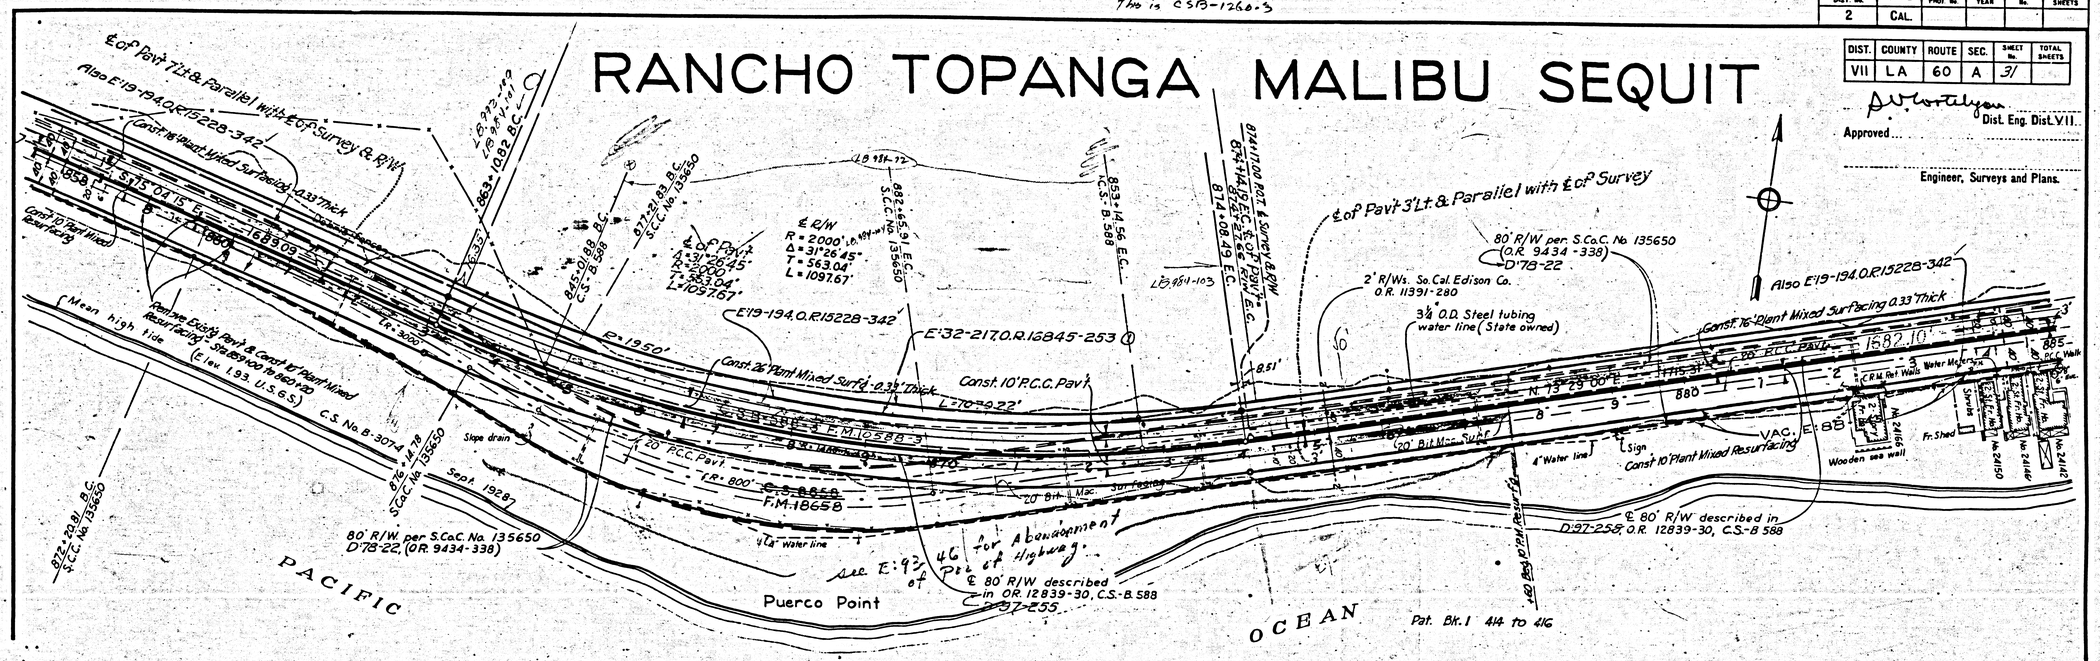

~~INDEX 19~~ ~~INDEX 59~~

LEGEND
Limit of Cut Slope
" " Fill Slope
Scale: 1" = 100'
6-29-37

CSB 1260

O LB992-111

5

F.M. 11260-3

A5 OF A14

FED. ROAD DIST. No.	STATE	FED. AID PROJ. No.	FISCAL YEAR	SHT. No.	TOTAL SHEETS
2	CAL.				

DIST.	COUNTY	ROUTE	SEC.	SHEET No.	TOTAL SHEETS
VII	L.A.	60	A	32	

D. W. Whittlesey
Dist. Eng. Dist. VII

Approved .....

Engineer, Surveys and Plans.

This is CSB-1260-3

RANCHO TOPANGA MALIBU SEQUIT

LB 984-78

LB 984-57

℄ R/W { R = 1390' Δ = 16°45'30" T = 293.12' L = 582.05'

℄ Survey { R = 2000' Δ = 16°45'30" T = 294.59' L = 584.98'

LB 984-106

2' R/Ws. So. Cal. Edison Co. O.R. 11391-280

80' R/W described in O.R. 12839-307 D-97-255

3¼" O.D. Steel tubing water line (State owned)

Winter Canyon

Rec. in O.R. Bk. 14512, P. 315

Dirt Road

Fd. L.P.T. 9.0'-58.76 E.C. S.C.C. No. 135650

Fd. L.P.T. 9.0'-90.06 L.S.C.C. No. 135650

E:32-217, O.R. 16845-253 ①

N 83°15'00" E. 53.68'

N 83°15'00" E. 31.30

Also E19-194, O.R. 15228-342

O.R. 12839-307

30' PCC. Pavt.

20' PCC. Pavt.

N 73°29'00" E. 1715.31'

Fd. L.P.T. 9.0'-71.78 S.C.C. No. 135650 O.R. 12839-307 891°-23.80 B.C.

Fd. L.P.T. 9.0'-32.44 S.C.C. No. 135650 O.R. 12839-307

903+71.78 P.O.T.

877+32.44 P.O.T.

Fd. L.P.T. 9.0'-72.64 E.C. S.C.C. No. 135650

909+57.05 E.C.

897+08.78 E.C.

911+63.90 B.C. S.C.C. No. 135650 (Fd. L.P.T.)

N 56°43'30" E. 873.44' VAC. E 8-93

C.S. B-586-3

R = 1980'

L.R. = 2000'

N 56°43'30" E. 133.11' P.C.C. Apron

Light Pole

Water meter

2" Pipe

4" Pipe Line

5" Pipe line

4" Pipe line

6" Pipe line

Small Cypress Hedge

Court

Garage

Lawn

Pool

Tennis Court

Fill

Brick wall

Wooden Sea Wall

Br. Barb. Pit

1-Story Frame No.

2-Story Frame No.

PCC. Pav.

PCC. Apron

PCC. Wall

PCC. Ret. Wall

Sea Wall Concrete Bags (Sand bags)

Rip Rap













Mean high tide (Elev 1.93' U.S.G.S.)

Sea portion not included in area

VAC. E 8-66, O.R. 3760-186

20' St. Vac. Surf.

2 R/Ws So. Cal. Edison Co. O.R. 11395-263

11439-161

E:32-217, O.R. 16845-253

80' R/W per S.C.C. No. 135650 D-78-22 (O.R. 9434-338)

No. 24142 No. 24138 No. 24128 No. 24124 No. 24120

No. 23920 No. 23914 No. 23908 No. 23900 No. 23896 No. 23880 No. 23946

No. 1 No. 7 No. 23869 No. 23864 No. 23860 No. 23850 No. 23844 No. 23838

890+90.59 P.O.T. 90°-49'-00" E.C. S.C.C. No. 135650

898+81.95 B.C.

C.S. No. B-307-4

℄ Survey R = 1500' Δ = 26°31'30" T = 353.55' L = 694.42'

℄ R/W { R = 1500' Δ = 26°31'30" T = 353.55' L = 694.42'

Sept 1928

905+76.37 E.C. S.C.C. No. 23844

905+76.26 P.O.T. equals R/W Station

Equa. 906+49.60

PACIFIC OCEAN

Pat. Bk. 1 - 414 to 416

O LB 992-113

O LB 992-117, 121

LEGEND
Limit of Cut Slope ----
Fill Slope ----

Scale: 1" = 100'

6-29-37

B-1260-3

F.M. 11260-3

A6 OF A14

FED. ROAD DIST. NO.	STATE	FED. AID PROJ. NO.	FISCAL YEAR	SHEET NO.	TOTAL SHEETS
2	CAL.				

DIST.	COUNTY	ROUTE	SEC.	SHEET NO.	TOTAL SHEETS
VII	L.A.	60	A	33	

D. E. Cortelyou
Dist. Eng., Dist. VII

Approved
Fred Grunsky
Engineer, Surveys and Plans.

State Highway Engineer

RANCHO TOPANGA MALIBU SEQUIT

Book 1 of Patents, Pages 414 to 416

Marblehead Land Company

℄ R/W
R = 1986'
Δ = 16°45'30"
T = 293.12'
L = 562.05'
℄ Survey
R = 2000'
Δ = 16°45'30"
T = 294.59'
L = 584.98'

903+71.78 S.C.C. № 135650
871+32.44 O.R. 12839-33
891+23.80 B.C.

891+08.78 E.C.
909+57.05 E.C.
S.C.C. № 135650 Tel. L.P. I.T.
899+22.64 E.C.

891+63.90
S.C.C. № 135650 Tel. L.P. I.T.

Rec. in O.R. Bk. 14512, P. 815

2 R/Ms So. Cal. Edison Co. O.R. 11391-280

N. 56°43'30" E.

Old County Road SE

SHEET 1 TO LEFT

County Road

Existing 20' P.C.C. Pavement

























































































































































































This is CSB-11260-3

FED. ROAD DIST. NO.	STATE	FED. AID PROJ. NO.	FISCAL YEAR	SHEET NO.	TOTAL SHEETS
2	CAL.				

DIST.	COUNTY	ROUTE	SEC.	SHEET NO.	TOTAL SHEETS
VII	L.A.	60	A	34	

S. V. Cortelyou
Cnst. Engr. Dist. VII

Approved
Fred Grunsky
Engineer, Surveys and Plans.

State Highway Engineer

RANCHO TOPANGA MALIBU SEQUIT

Book 1 of Patents, Pages 414 to 416

Marblehead Land Company

~~Move & Reset Property Fence Sta 886+50 to 930+46 On Left & Right~~

Private Pipe Line of Malibu Land Company To Malibu Reservoir

3½" Steel tubing water line State owned.

E 32-217, O.R. 16845-253 ①
E 85-229

F.M. 11698-3 ~~C.S. B-135-2~~ — Existing 20' P.C.C. Pavement — F.M. 10588-3 C.S. B-135-2

N 83°11'15" E 3983.81'

F.M. 18658 C.S. 8858

20' Bituminous Macadam Pav't.

MALIBU ROAD — PACIFIC COAST HWY

E 49-83

Seaside Patrol & Fire Station

E 32-217, O.R. 16845-253 ③
E 85-229

D 78-22, O.R. 9434-338
D 97-255, O.R. 12839-30
Also E 19-194, O.R. 15228-342
E 85-229

30" Sycamore

Concrete Irrigation Standpipe

Fire Plug — 6" Water Line — Fire Plug — Fire Plug

Paved Tennis Court — Paved Tennis Court — Paved Tennis Court

Vac. E 88-93, O.R. 32797-148

VACATED E 146-174

PACIFIC COAST HWY

LEGEND
Limit of Cut Slope ----
" " Fill Slope ~~~~
Scale: 1"=100'
6-29-37

F.M.	11260-3
A8	OF A14

This is C.S. B 1260-3

FED. ROAD DIST. NO.	STATE	FED. AID PROJ. NO.	FISCAL YEARS	SHEET NO.	TOTAL SHEETS
2	CAL.				

DIST.	COUNTY	ROUTE	SEC.	SHEET NO.	TOTAL SHEETS
VII	L.A.	60	A	35	

S. F. Cordtz
Dist. Engr. Dist. VII

Approved Fred Grunwald
Engineer, Surveys and Plans.

State Highway Engineer

RANCHO TOPANGA MALIBU SEQUIT

O.R. 16906-89
M.H. Adamson

Book 1 of Patents, Pages 414 to 416

Marblehead Land Company

Construct New Property Fence
~~Sta. 925+88.8 to 955+84 on Left~~
~~Sta. 926+25 to 966+49 on Right~~

Malibu Creek

Malibu Lagoon

Old Malibu R.R. Bridge used as view bridge

Rubble Masonry Wall (2 miles of Hwy)

Wood Deck Landing

Rubble Masonry Pier Wall 2'x 8'

Rubble Masonry Wall 2'x 8'

20' Bituminous Macadam Pav't

Telephone Cable

4" Water line under bridge

4" Water line on bridge

Δ=39°19'30"
R=1500'
T=535.97'
L=1029.53'

Δ=39°19'30"
R=1450'

U.S.C.&G.S. Malibu Triangulation Point
D:97-255 O.R. 12839-130
Also E19-194 O.R. 15228-342

F.M. 10588-3
~~S.B. 588-3~~

Existing 20' P.C. Pav't
R=1050'

Concrete Block Wall

D:78-22 O.R. 9434-338

O.R. 16322-60

LB 992-130

LB 992-127

LB 992-13

3/4" O.D. Steel tubing water line
State owned.
E 32-217, O.R. 16845-253 ①

OLD COUNTY ROAD

VAC E 8-63

Ditch Line

6 Poles

Concrete Wall

Wall

Gate

N 43°51'45" E 362.63'

6" Main

4" Main

14 Board Fence

P-A-C-I-F-I-C O-C-E-A-N

Δ= 21°17'45"
R= 2000'
T= 376.02'
L= 743.36'

MALIBU WHARF

940± 22.37 C

E.C. 9+62.96

LEGEND
Limit of Cut Slope ——
" Fill Slope ——
Scale: 1"=100'
6-29-37

9

F.M. 11260-3

A9 OF A14

FED. ROAD DIST. NO.	STATE	FED. AID PROJ. NO.	FISCAL YEAR	SHEET NO.	TOTAL SHEETS
2	CAL.				

DIST.	COUNTY	ROUTE	SEC.	SHEET NO.	TOTAL SHEETS
VII	LA	60	A	36	

S. F. Cottingham
Dist. Eng. Dist. VII

Approved
Fred Brennan
Engineer, Surveys and Plans.

State Highway Engineer

RANCHO TOPANGA MALIBU SEQUIT

Book 1 of Patents, Pages 414 to 416

Marblehead Land Company

E:63-20, O.R. 13962-391

Arroyo Sequit

Stream

Canyon

D:97-255, O.R. 12839-30
Also E:119-134, O.R. 15228-342

① E:36-6, O.R. 17004-240

② Sheet Metal Warehouse

Sheet Metal House

Move & Reset Property Fence
Sta. 955+04 to 965+96.77 on Left

Construct New Property Fence
Sta. 956+25 to Sta. 966+00 on Right

E:32-217, O.R. 16845-253 ①

3½" O.D Steel tubing water line
State owned.

③

E:36-6, O.R. 17004-240

④

Vac. E:8-63

MALIBU ROAD
C.S. 80P

8" Water Line

Gas Pole

N65°09'30"E 735.70'

945 6 7 8 9 950 1 2 3 4 5 6 7

F.M. 10588-39

960 F.M. 16658 1 2 3 4 5 6 7 8

F.M. 11698-3

E:8-155 Vac.

Existing 20' P.C.C. Pavement

1 Story Frame House

D:78-22, O.R. 9434-338

Remove Existing 20' P.C.C. Pav't.
Sta. 962+00 to 965+96.77
101 Cu. Yds.

Remove portion of pav't as needed for new pav't constr.
Sta. 957+80 to Sta. 962+00
68 Cu. Yds.

Conc. Wall

Wall

Wall Gate

MALIBU

WHARF

Δ=21°17'45"
R=2000'
T=376.02'
L=743.36'

947+66.93 E.C.

P A C I F I C

935+04.63 B.C.

O C E A N

Δ=20°51'30"
R=3000'
T=552.18'
L=1092.14'

965+96.77 E.C.

N86°01'E 1365.39'

970

8" Water Line

Tent Houses

LEGEND
Limit of Cut Slope
" " Fill Slope
Scale: 1"=100'
6-29-37

LB 772-32

(21)

(22)

10

F.M. 11260-3

A10 OF A14

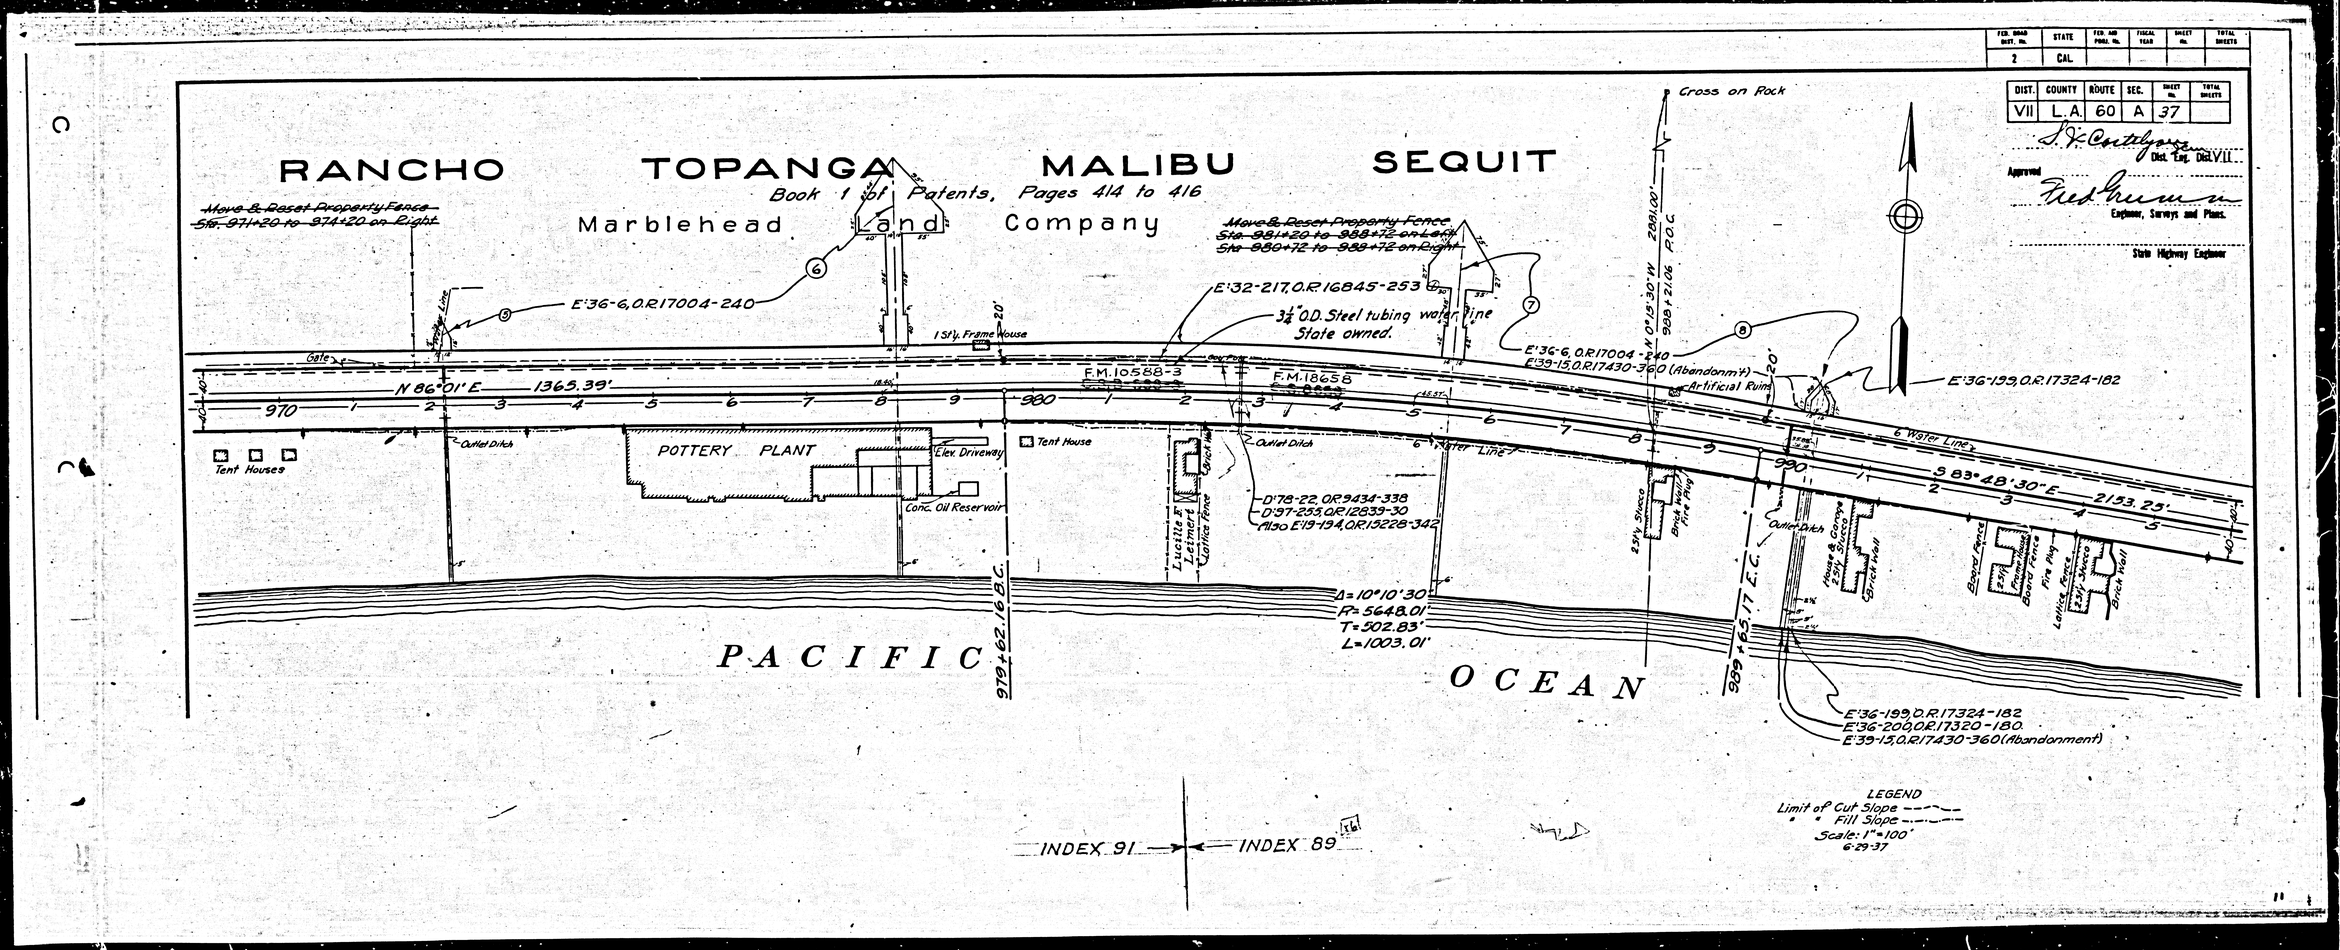

FED. ROAD DIST. No.	STATE	FED. AID PROJ. No.	FISCAL YEAR	SHEET No.	TOTAL SHEETS
2	CAL.				

DIST.	COUNTY	ROUTE	SEC.	SHEET No.	TOTAL SHEETS
VII	L.A.	60	A	37	

S. F. Cortelyou
Dist. Eng. Dist. VII

Approved
Fred Greenwood
Engineer, Surveys and Plans.

State Highway Engineer

F.M. 11260-3

A11 OF A14

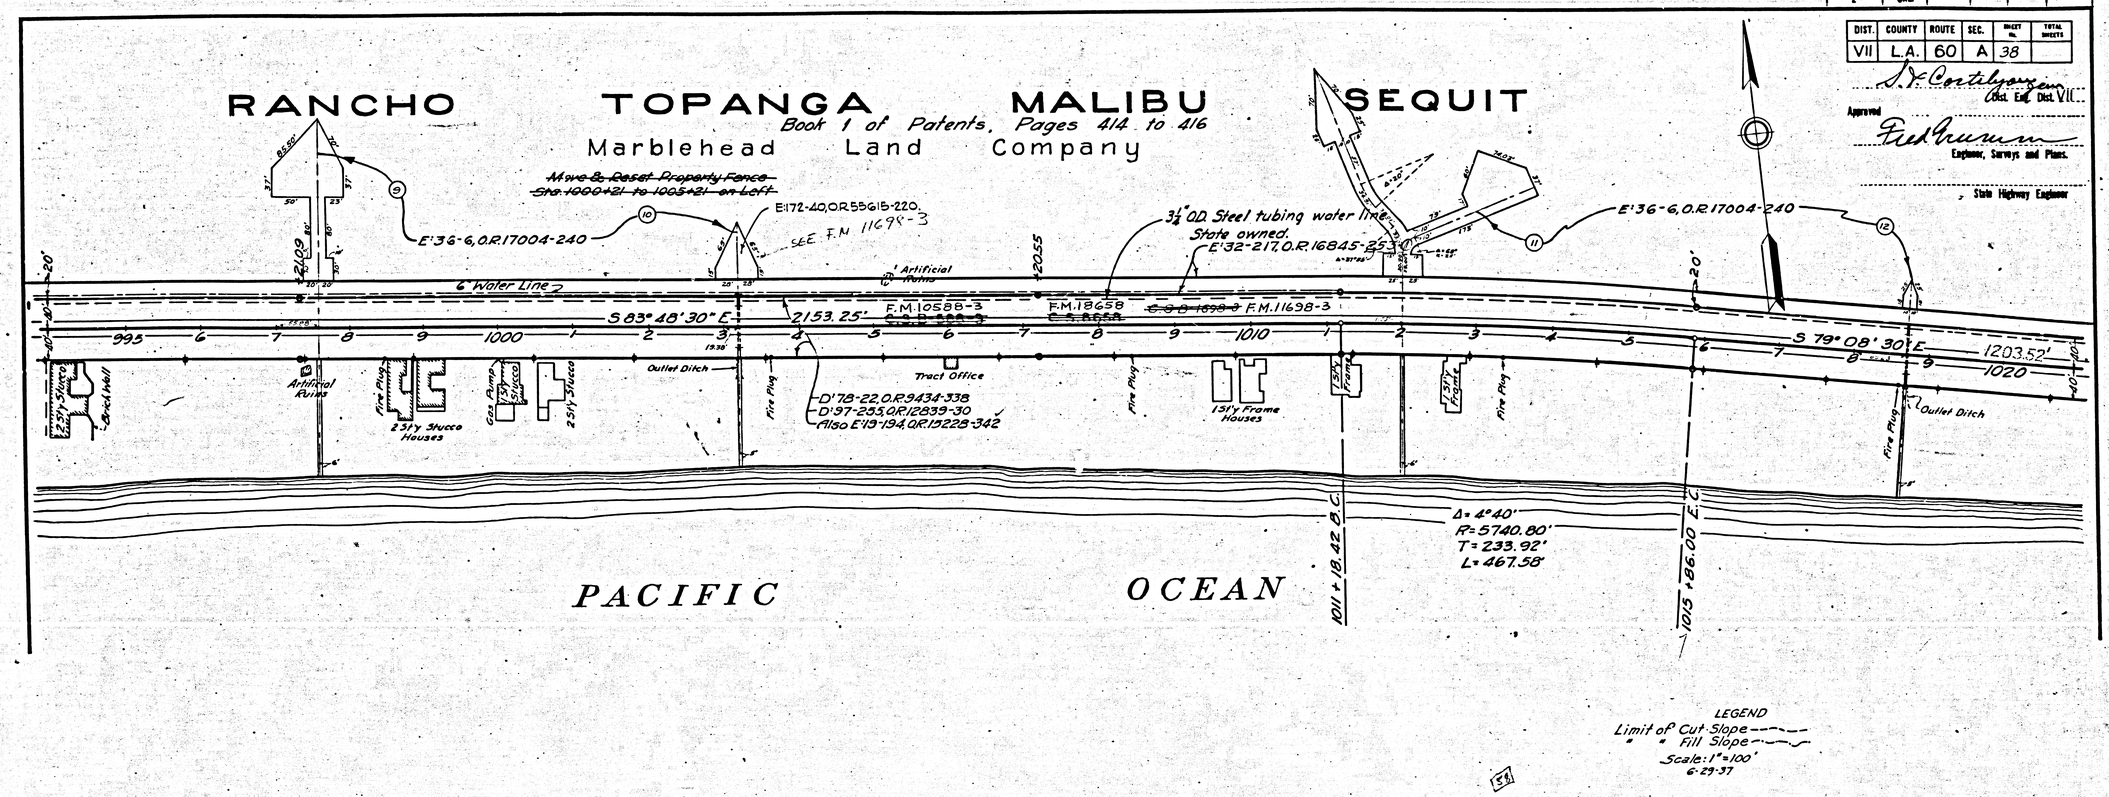

DIST.	COUNTY	ROUTE	SEC.	SHEET No.	TOTAL SHEETS
VII	L.A.	60	A	38	

S. F. Cortelyou
Dist. Eng. Dist. VII

Approved
Fred Grumm
Engineer, Surveys and Plans.

State Highway Engineer

F.M. 11260-3

A12 OF A14

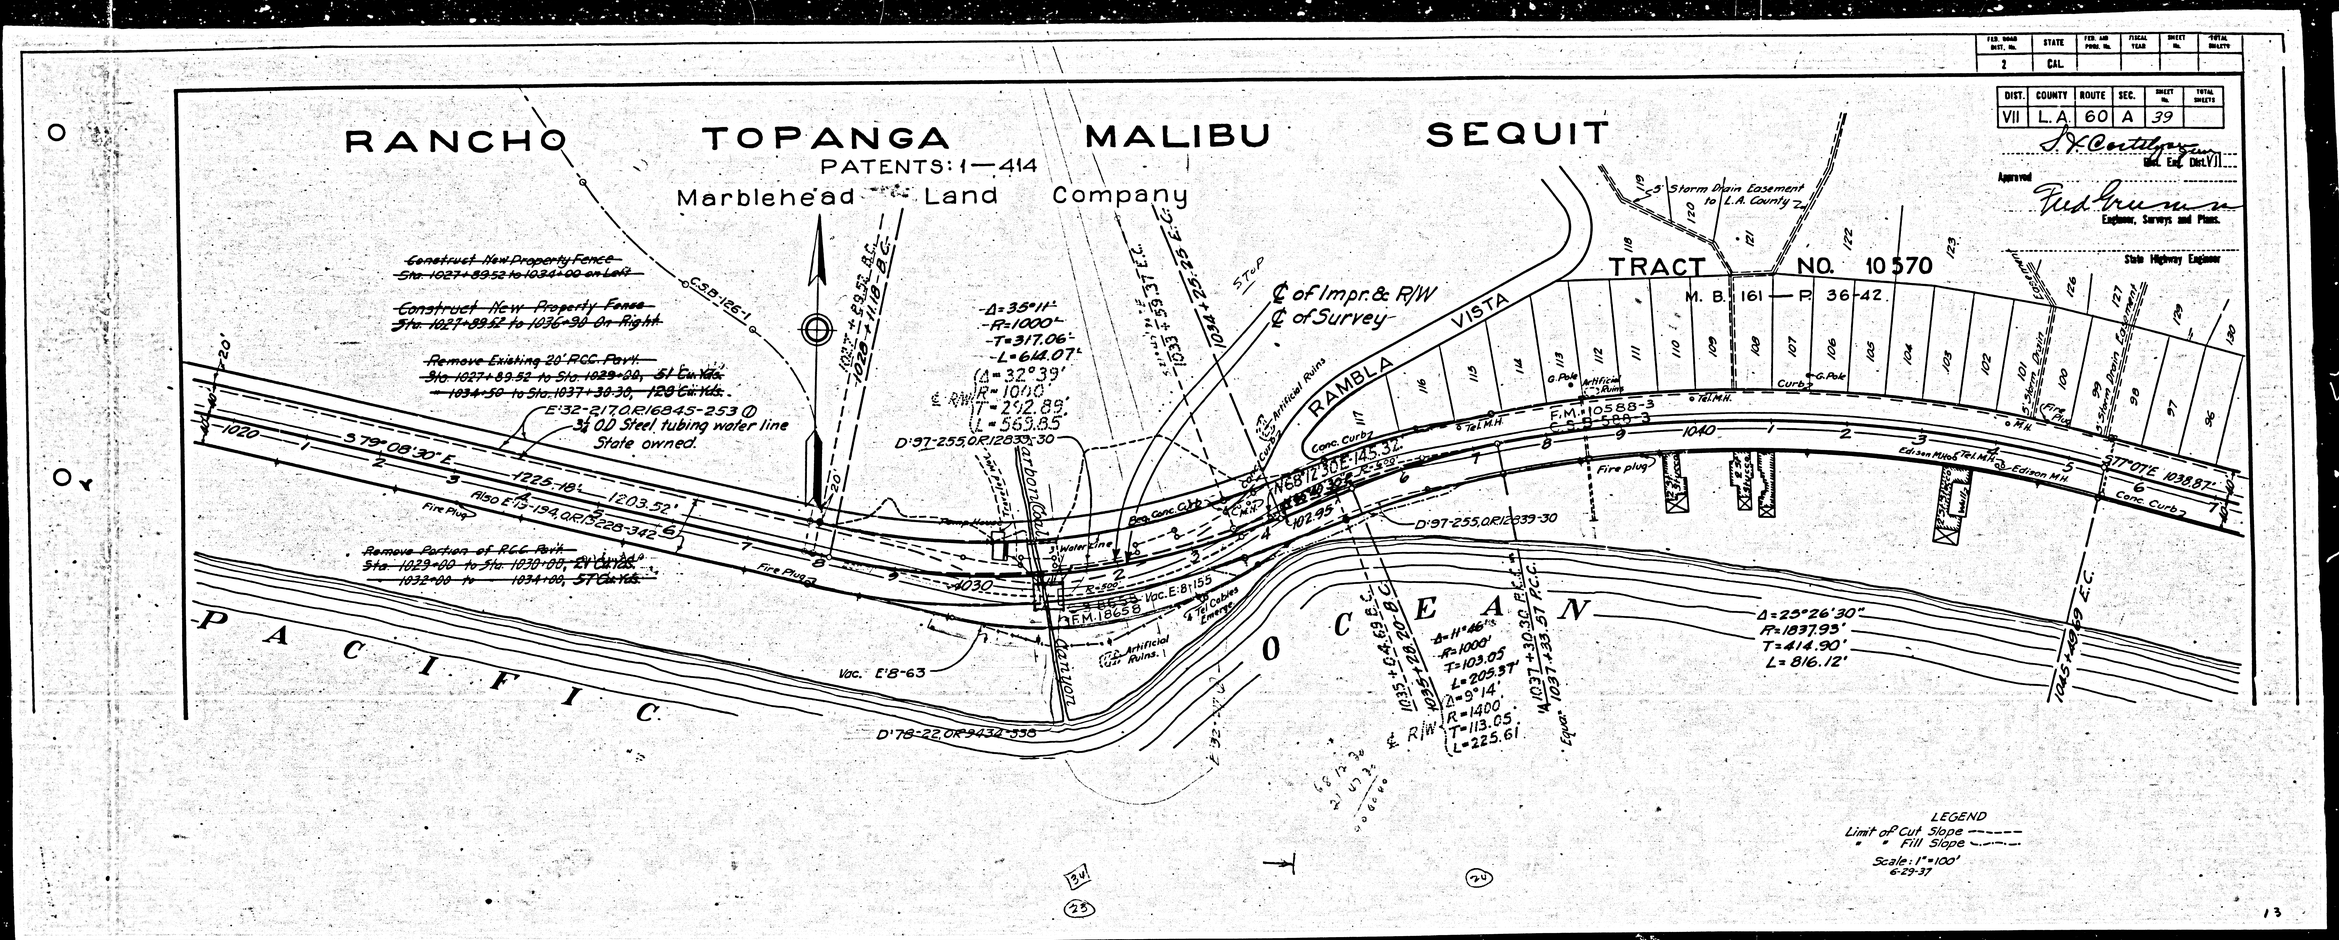

FED. ROAD DIST. No.	STATE	FED. AID PROJ. No.	FISCAL YEAR	SHEET No.	TOTAL SHEETS
2	CAL.				

DIST.	COUNTY	ROUTE	SEC.	SHEET No.	TOTAL SHEETS
VII	L.A.	60	A	39	

S. H. Cortelyou
Dist. Eng. Dist. VII

Approved
Fred Greenwood
Engineer, Surveys and Plans.

State Highway Engineer

13

F.M. 11260-3

A13 OF A14

FED. ROAD DIST. No.	STATE	FED. AID PROJ. No.	FISCAL YEAR	SHEET No.	TOTAL SHEETS
2	CAL.	-			

DIST.	COUNTY	ROUTE	SEC.	SHEET No.	TOTAL SHEETS
VII	L.A.	60	A	40	

RANCHO TOPANGA MALIBU SEQUIT

PATENTS: 1 — 414

Marblehead Land Company

TRACT NO. 10570

M. B. 161 — P. 36-42

RAMBLA VISTA

RAMBLA PACIFICO

LOT A

LOT C

Easterly Boundary of Topanga Malibu Sequit Rancho

3½" O.D. Steel tubing water line State owned.

5' Storm Drain Easement to L.A. County

5' Storm Drain Easement to L.A. County

5' Walks

5' Walk

Artificial Fountain

Los Flores Inn Gas Station

2 Pumps

23' Frame Conc. Area

Adobe Wall

Bath House

Wall

Trad. Office

Conc. Wall

Tent Flr.

1 Story Ho.

Office

Rest Rooms

Last Store Inn

2 Story Ho.

1 Story Ho.

Fd. 4"x4" Redwood Post inscribed T.M. No.1

Flores Canyon

Conc. Curb

Island

Tel. M.H.

Edison M.H.

Fire Plug

18" R.C. Pipe

23' Fr.

1st. Stucco

1st. Shed

F.M. 11698-3

F.M. 10588-3

F.M. 18658

F.M. 10594

S 77° 07' E 1038.87'

S 73° 48' 15" E 595.11'

S 01° 00' 30" E L.A.60 B.C.

S 01° 33' 15" E L.A.60A 325.85'

Curve Data Air ℄ of Improvement A3

Δ=7°27'
R=2000'
T=130.20'
L=260.06'

Δ=2°55'43"
R=1000'
L=51.11'

Δ=24°25'47"
R=1300'
L=426.38'

℄ R/W
Δ=7°27'
R=1000'
T=65.10'
L=130.03'

1065+44.19 B.C. A3

1067+05.42 E.C. A3

1069+66.17 B.C. A3

1070+22.20 P.O.C. L.A.60B

1070+42.22 P.O.C. L.A.60A

N 39° 02' E

D-5(11) P.O.C. L.A.60B

D-97-253.0R2839-30

D-78-22.0R9434-338

D-97-253.0R12839-30

Also E19-194.0R15228-342

1055+88.56 B.C.

1059+15.18 E.C.

Δ=3°18'45"
R=5649.55'
T=163.36'
L=326.62'

P A C I F I C O C E A N

Gutter & Gutter Grades

Remove Existing Curb & Construct New Curb
Sta. 1065+35 to 1068+49 on Left
Sta. 1065+52 to 1068+52 on Right

℄ of Improvement
℄ of Survey & R. of W.
Remove Existing 20' P.C.C. Pavt.
Sta 1064+45.19 to Sta. 11069+00
208 Cu. Yds.
Sta 1066+00 to 1068+00 Place Additional 18" Strip of Concrete on Right

D. E. Cuthbertson
Dist. Engr. Dist. VII

Approved
Fred Grunsky
Engineer, Surveys and Plans.

State Highway Engineer

INDEX ~~59~~ 89

LEGEND
Limit of Cut Slope ——
" " Fill Slope ——

Scale: 1" = 100'
6-29-37

Negatives of this map (Sht. 3) filed in Blue Print Dept. as Negative 320 (Shts. 27 to 40)

F.M. 11260-3

A14 OF A14