R A N C H O

The Newhall Land and Farming Company

Fd Brass Plate in conc. mon. on top of ridge

Fd Brass Plate in conc. mon. at fence

1395.14' meas. 1393.38' rec.

N 87°09'18" E

BOUNDARY LINE NO. 11 RD. SAN FRANCISCO

N 22°15'45" W - 5806.38' meas. 5807.47' rec.

N 22°09'45" W

665.67 Ven. Co. = 40.56.48 L.A. Co.

County Surveyor set a 3" standard brass cap monument here in Jan. 1943. See R.S. 402-133

N 83°56'20" E Ven. Co. = 8.665

N 84°02'20" E L.A. Co.

℄ PROPOSED STATE HIGHWAY

N 84°02'20" E - 1112.11'

1118.00' deed

N 84°02'20" E - 1161.90' Cal. 1138.64' Cal.

VENTURA CO. / LOS ANGELES CO.

COUNTY LINE

51+68.59 B.C.

Δ = 12°03'20"
R = 3250'
T = 343.18'
L = 683.83'

631+05.9 ℄ 628+42.4 B.C. PT

R.R. Δ = 12°03'20" meas. 12°03'30" rec.

626+92.4 C.C. 3'Lt.

624+05 C.C.T.L

622+96.5 E.C.

58+52.42 E.C.

E: 39-170, O.R. 17609-297 (O.C.)
E: 39-200, O.R. 17683-239 (O.C.)

℄ PROPOSED STATE HIGHWAY

N 71°59'00" E - 1024.68

749.83 826.90' Deed

℄ 50' R/W per D: 4230-2

℄ S.P.R.R. Co's R/W per D: 1227-245

825.17' meas. 826.1' rec.

N 71°59'00" E - 1639.04' meas. P.I. to P.I.

274.85'

614+63 B.C. T.L.

611+33.8 C.C. 6° Rt.

611+77.10 B.C.

R.R. Δ = 42

S 11°59'20" E - 90.50'

335.88' Deed

Set 2½"-Hgw. P.I.

Set 2½"-R.R.P.I.

r = 75.94'

DETAIL
NOT TO SCALE

PRESENT R/W

NEW ℄

PRESENT ℄

PRESENT R/W

This monument removed by Surveyor Jan. 1943 replaced by Fd C.S. brass capped Mon.

Fd Lead and Tack

Fd C.S. brass capped Mon.

10' 15' 25'

15.51' 26.03'

F.M. 11277-1

A1 OF A3

S A N F R A N C

PAT: 1-521 & 522

Δ=17°00'00"
R=3000'
T=448.35'
L=890.12'

79+08.71 B.C.

87+98.83 E.C.

The Newhall Land

E:33-170,O.R.17609-297(O.C.)
E:39-200,O.R.17683-239(O.C.)

nd Farming Company

℄ PROPOSED STATE HIGHWAY

N 66°27'00"E - 865.19'

N 82°27'00"E - 300.90'

T 274.85'

Set 2½"-R.R.Pl.

VENTURA

SOUTHERN

PACIFIC

SAUGUS

R. R.

RD.

R.R.Δ=67°49'00"meas.
67°46'45"rec.

R.R.Δ=42°57'15"meas.
42°57'00"rec.

Δ=10°28'00"
R=4000'
T=366.38'
L=730.71'

R.R.Δ=14°57'00"meas.&rec.

R.R.Δ=25°25'05"meas. 25°2

Δ=22°02'20"
R=3000'
T=584.20'
L=1153.95

679.58' Deed

114.60' Deed

850.52' Deed

116.64' cal.
114.2 rec.
N 41°07'15" E - 908.28' meas.

849.61' cal. 851.6' rec.
N 62°04'15" E - 1716.15' meas.

F.M. 11277-1

A2 OF A3

DIST.	COUNTY	ROUTE	SEC.	SHEET NO.	TOTAL SHEETS
VII	LA	79	C	1	3

D. V. Cortelyou
CHIEF ENGINEER

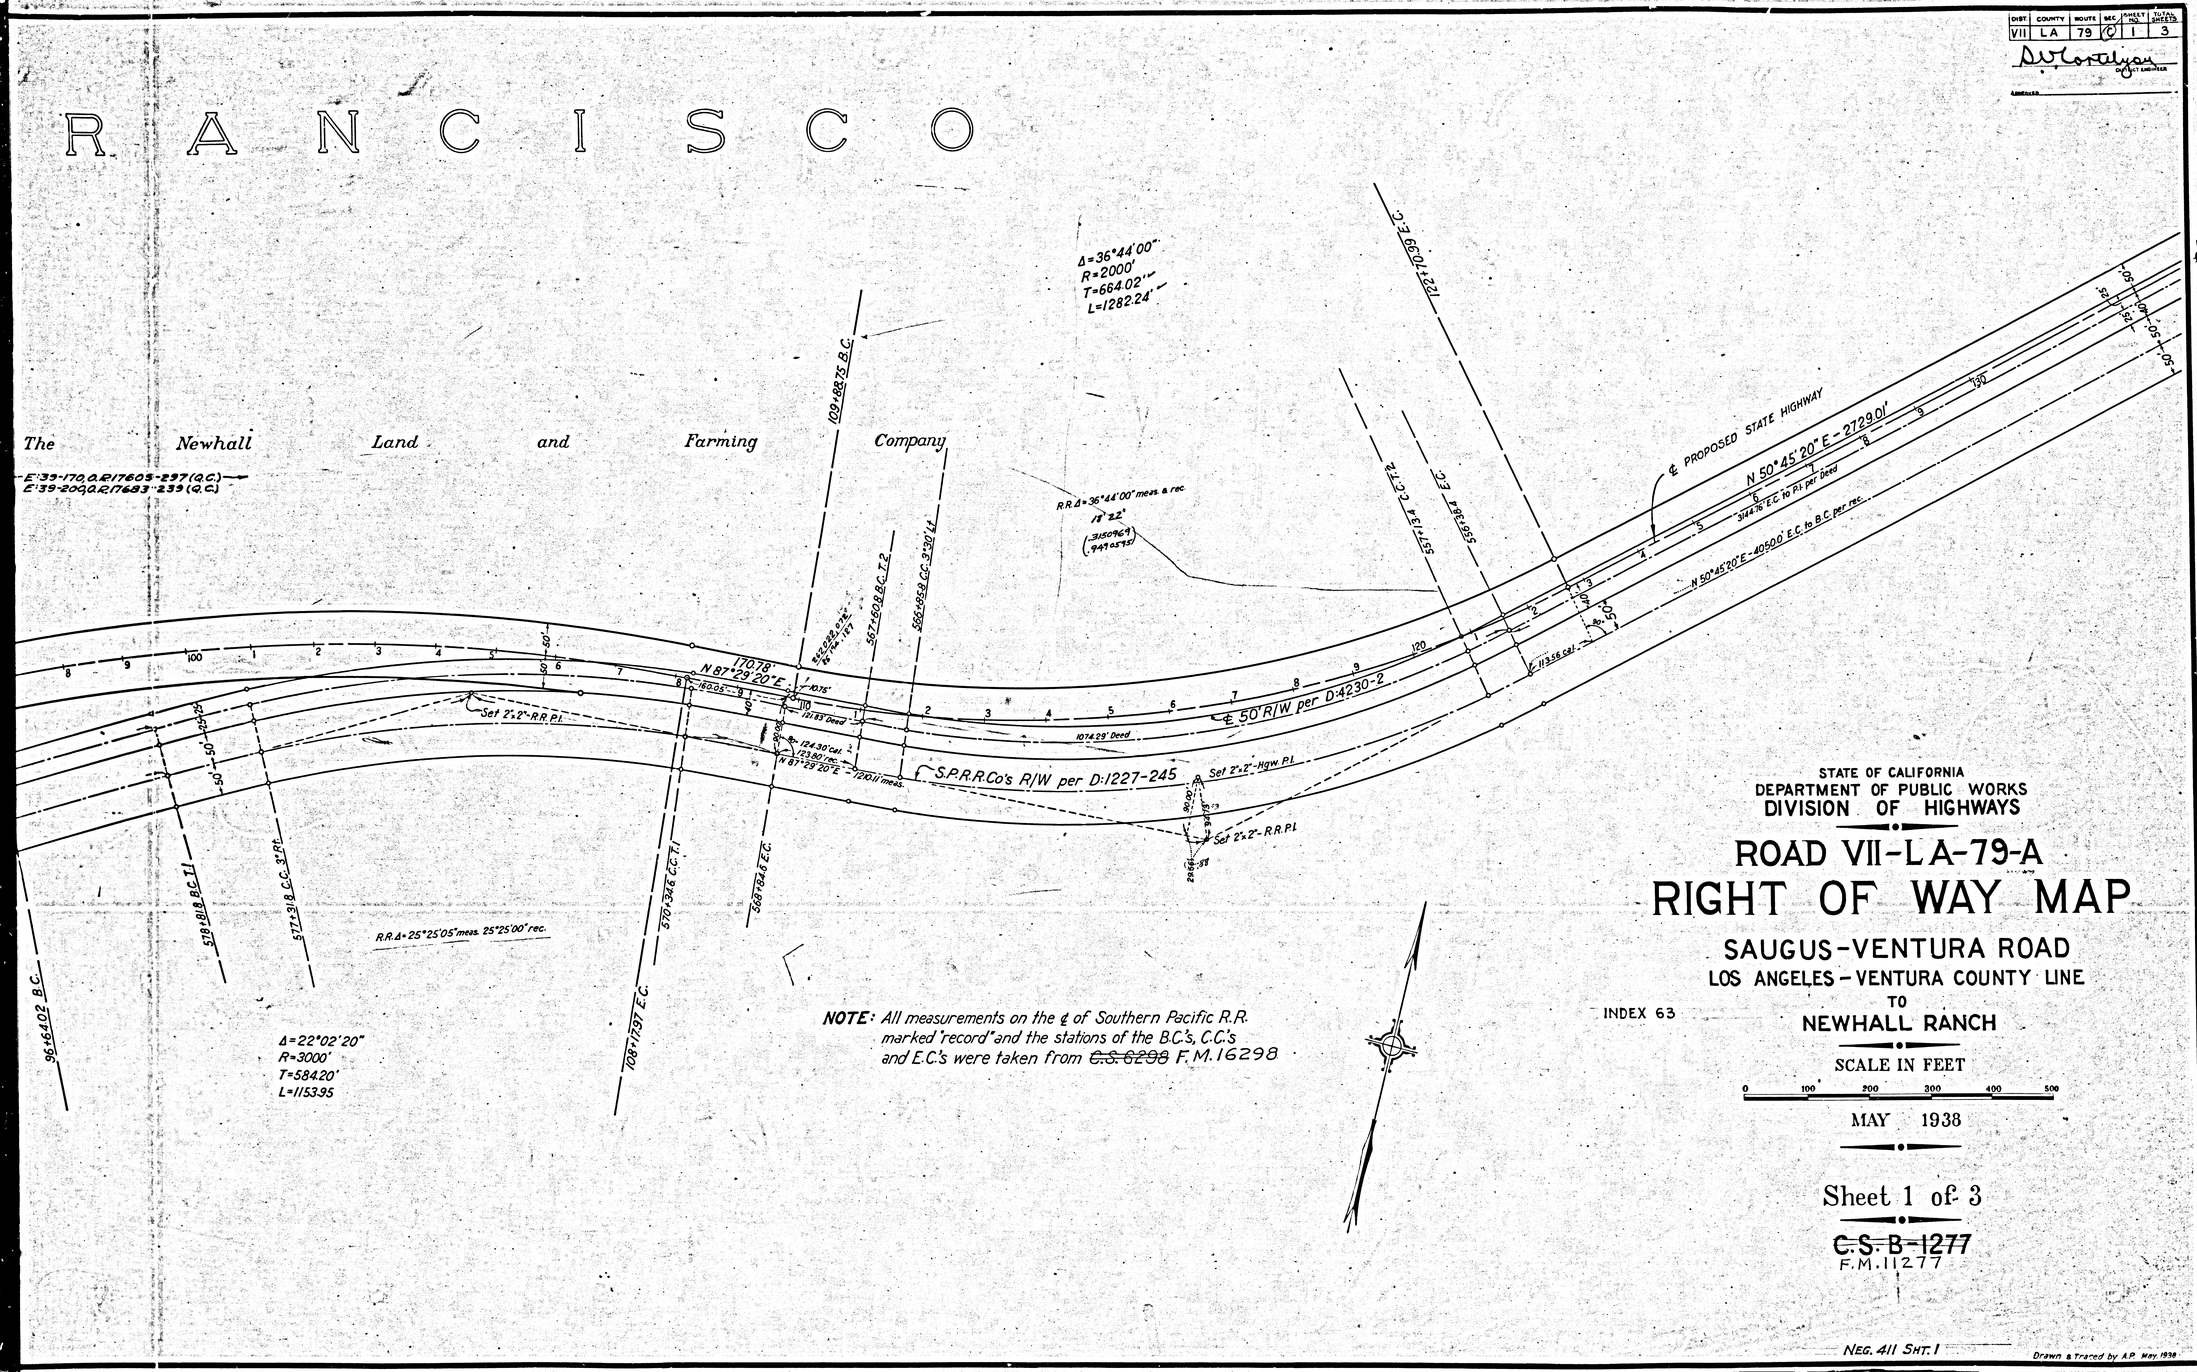

NOTE: All measurements on the ℄ of Southern Pacific R.R. marked "record" and the stations of the B.C.'s, C.C.'s and E.C.'s were taken from ~~C.S. 6298~~ F.M. 16298

STATE OF CALIFORNIA
DEPARTMENT OF PUBLIC WORKS
DIVISION OF HIGHWAYS

ROAD VII-LA-79-A
RIGHT OF WAY MAP

SAUGUS-VENTURA ROAD
LOS ANGELES-VENTURA COUNTY LINE
TO
NEWHALL RANCH

INDEX 63

SCALE IN FEET
0 100 200 300 400 500

MAY 1938

Sheet 1 of 3

~~C.S. B-1277~~
F.M. 11277

NEG. 411 SHT. 1

Drawn & Traced by A.P. May 1938

F.M. 11277-1

A3 OF A3

LA-79-A Sh. 1

VII-LA-79-A Sh. 1 of 3 Sheets - VENTURA COLLINE TO 2TH 130

65-2121