



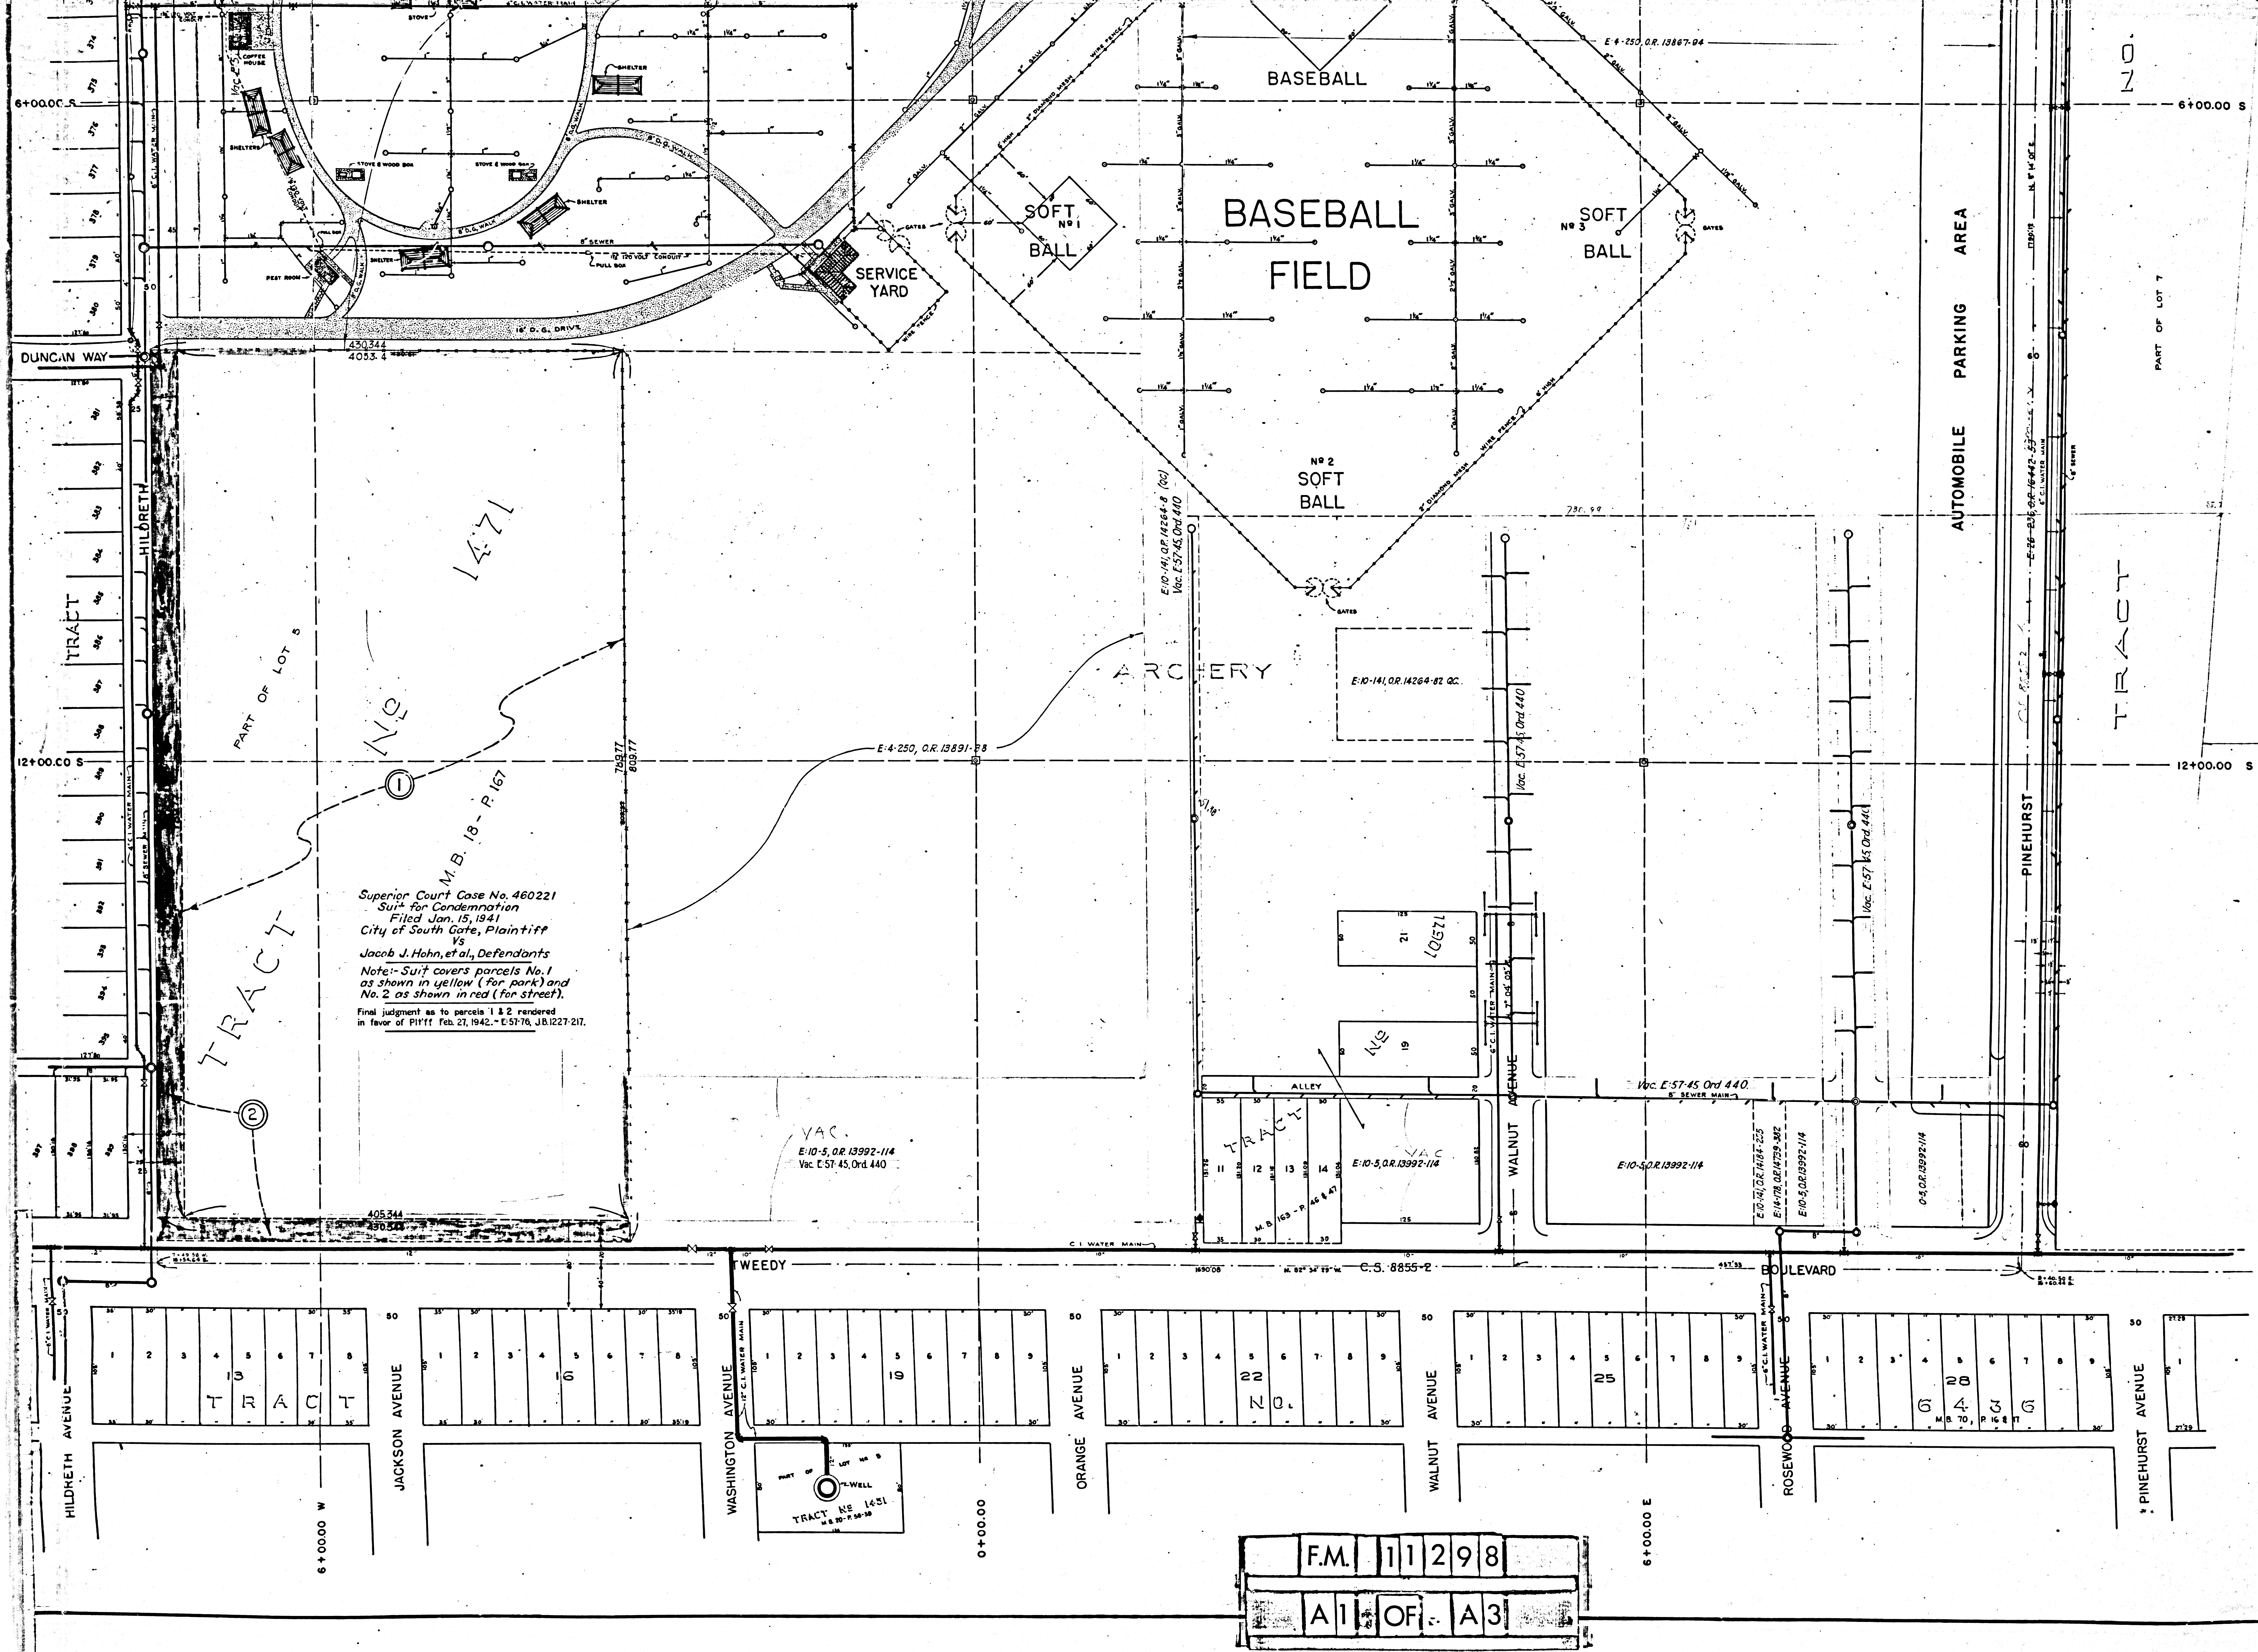

Superior Court Case No. 460221
Suit for Condemnation
Filed Jan. 15, 1941
City of South Gate, Plaintiff
Vs
Jacob J. Hohn, et al., Defendants
Note: Suit covers parcels No. 1
as shown in yellow (for park) and
No. 2 as shown in red (for street).
Final judgment as to parcels 1 & 2 rendered
in favor of Plaintiff Feb. 27, 1942. - E-5176, JB.1227-217.

FM 11298
A1 OF A3

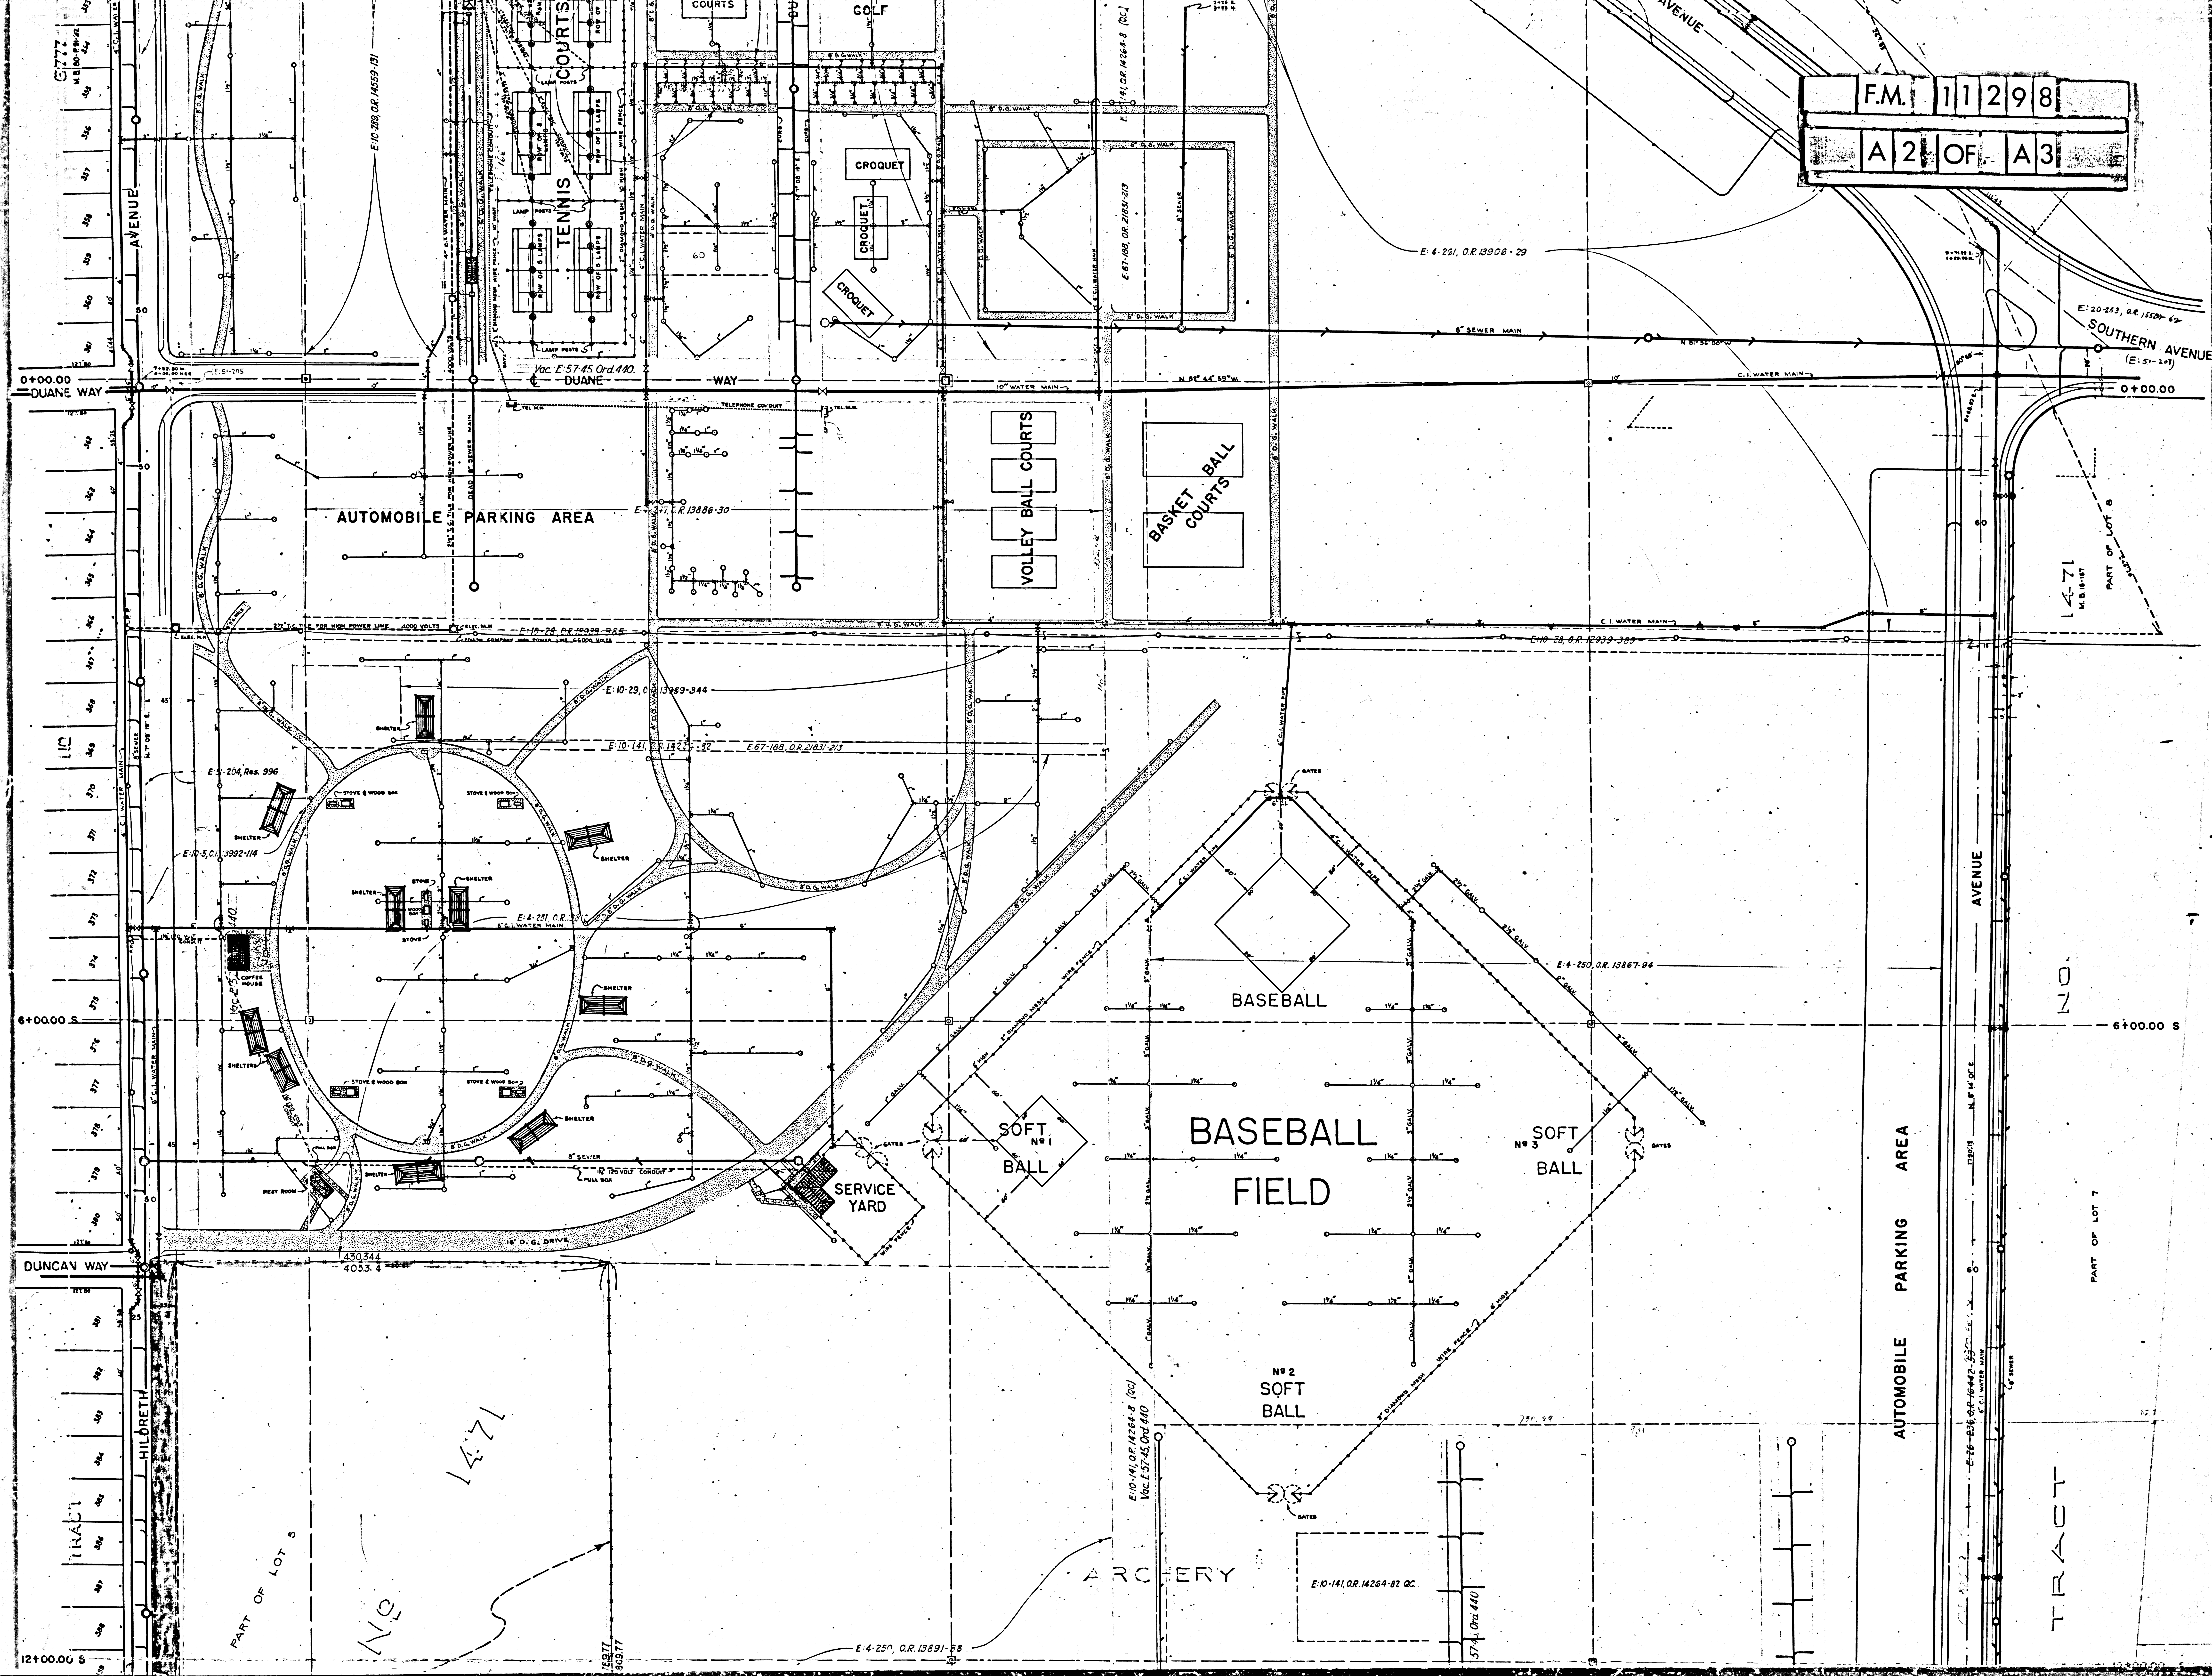

INDEX 32
MAP
SHOWING COORDINATE LOCATION
OF UTILITIES
IN
RECREATION PARK
IN THE CITY OF
SOUTH GATE
CALIFORNIA
JUNE 1938

SCALE: 1" = 50'-0"

OFFICE OF THE CITY ENGINEER
CITY OF SOUTH GATE

DRAWN BY - W. W. Cunningham
CHECKED BY - W. W. Cunningham
FIELD WORK BY - J. Sharnon & W. W. Cunningham
FIELD BOOK NO. 24

- LEGEND
- WATER PIPE LINE
 - SEWER PIPE LINE
 - POWER CONDUIT
 - TELEPHONE CONDUIT
 - GATE VALVE
 - SPRINKLER HEAD
 - DRINKING FOUNTAIN
 - FIRE HYDRANT
 - STANDARD SEWER MANHOLE
 - FLUSHING SEWER MANHOLE
 - TELEPHONE CONDUIT MANHOLE
 - ELECTRIC CONDUIT MANHOLE

