









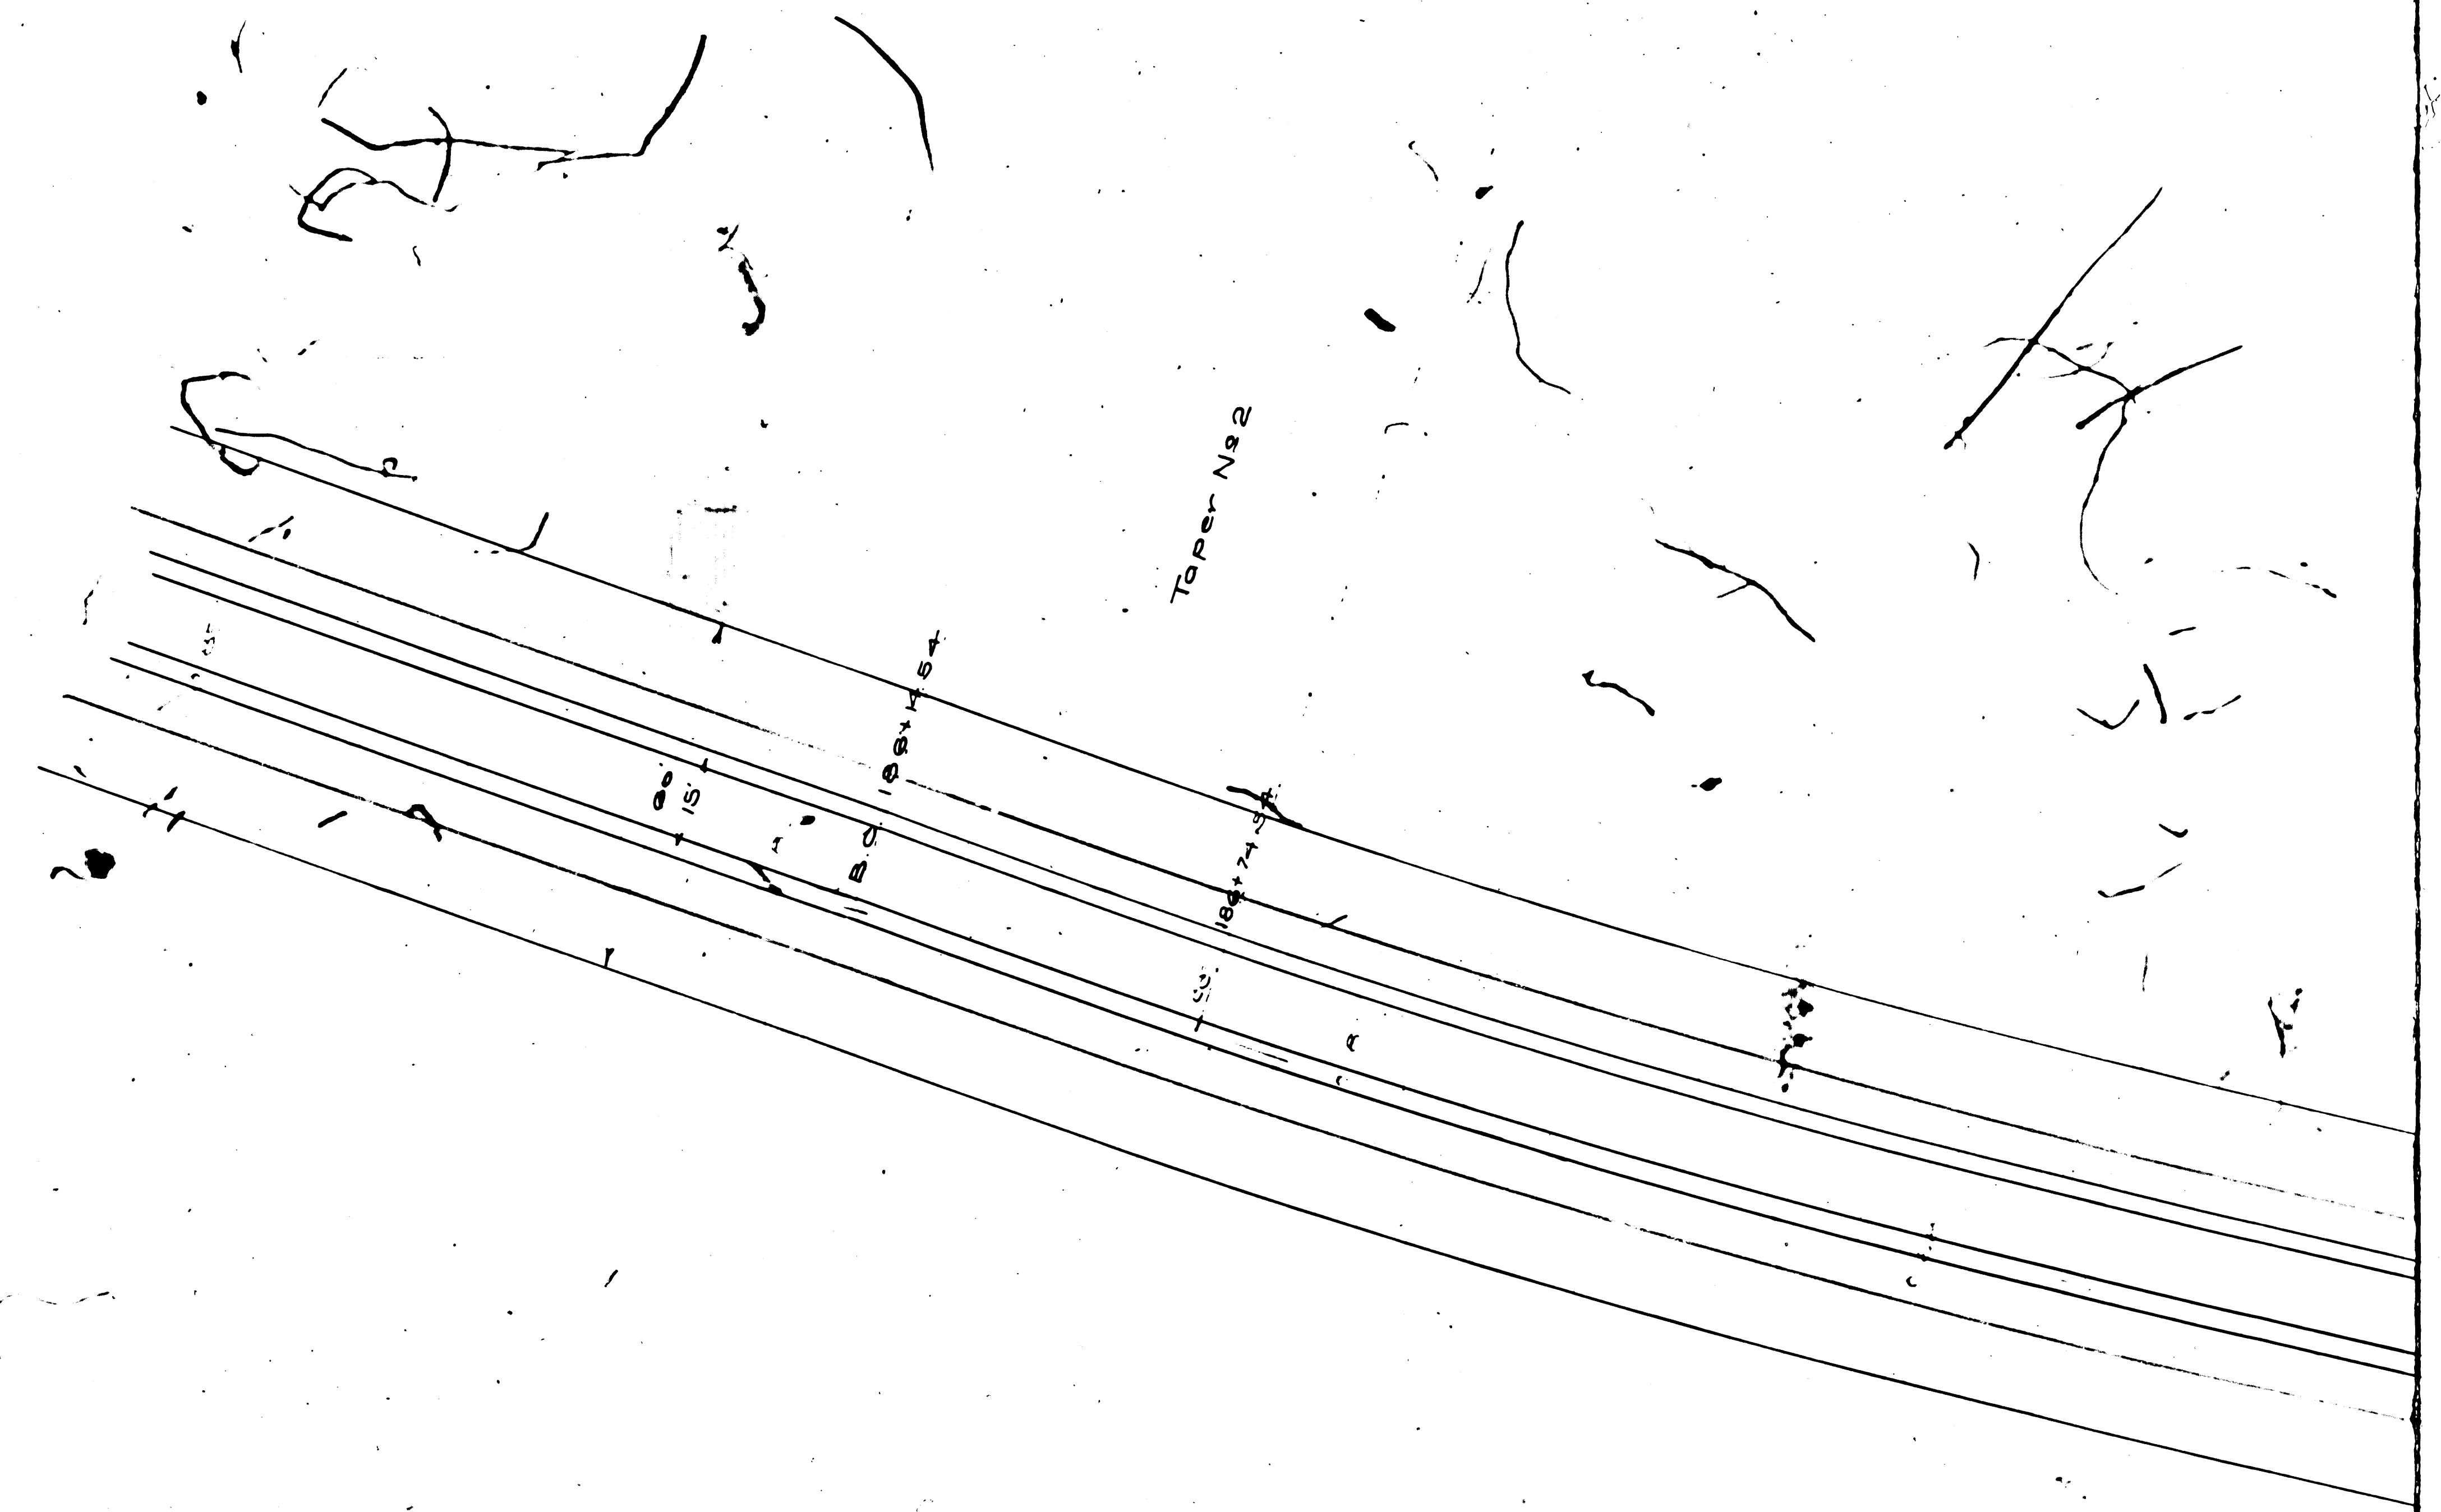

F.M. 117388

A 11 O 11 4


Topog N42

D: 40-275-O.R. 4052 C.R.

D: 40-275-O.R. 4052-18 C.R.

F/M 117388

A 2 OF A 114

ROAD

AVE. 45

D:40-275
O.R. 3072


GLASS

D:40-275-O.R. 4052-18-O.R. 11405249

D:40-275-O.R. 4052-18-O.R. 11405249

F/M 11 7 3 8 8

A 31 O/P A 11 41

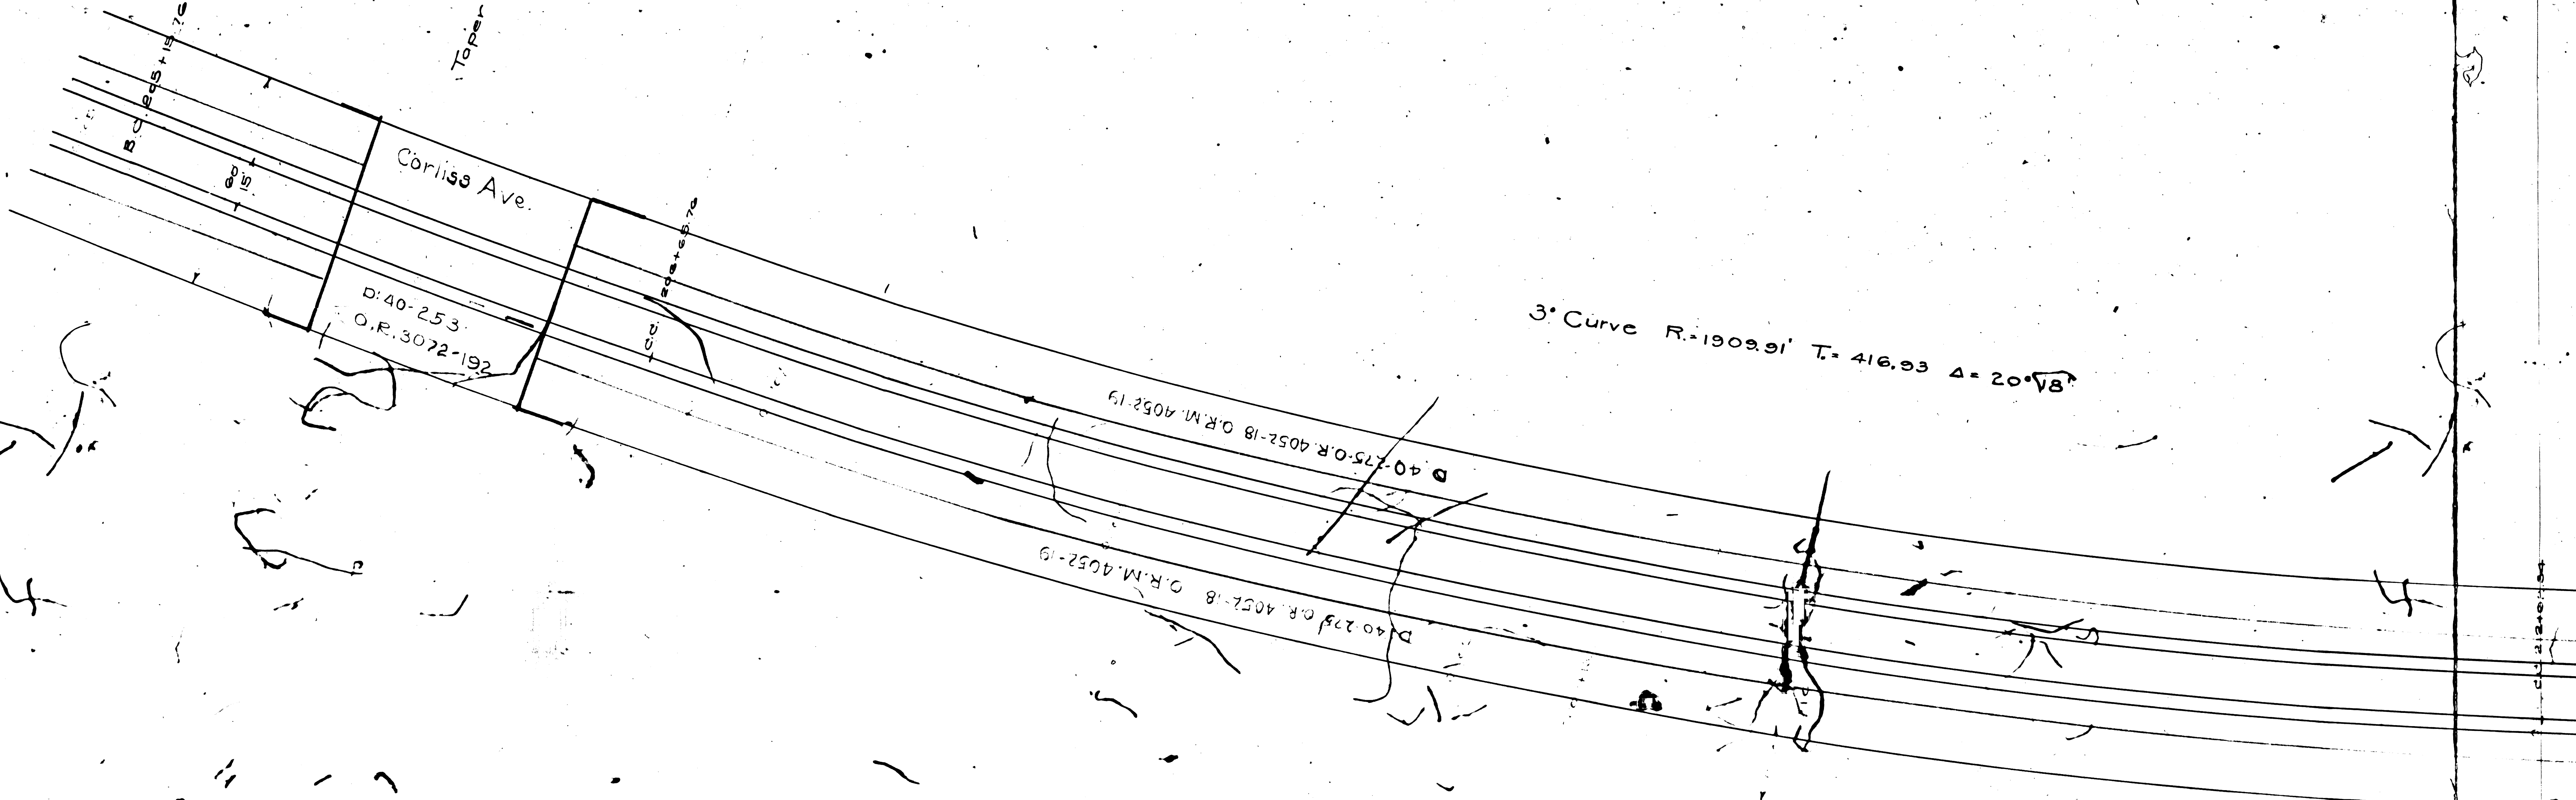

F/M 11 7 38 8
 A 4 OF A 11 4

SUB OF LOT 44

LAWRENCE AVE HEIGHTS

RIDGEWAY AVE. PARK

CENTRAL AV

E.C. 218-3834

F.M. 117388

A 5 OF A 14

W A T T O

52

88

87

48

47

46

45

44

43

59.02

52.36

15

73.68

50

50

80

73.25

50

52.36

37.36

26.47

39

50

75

35

65.5

38

42

TOP OF

CLIFF

35

50

30

35

50



27.25

27.15

30

14.4

52

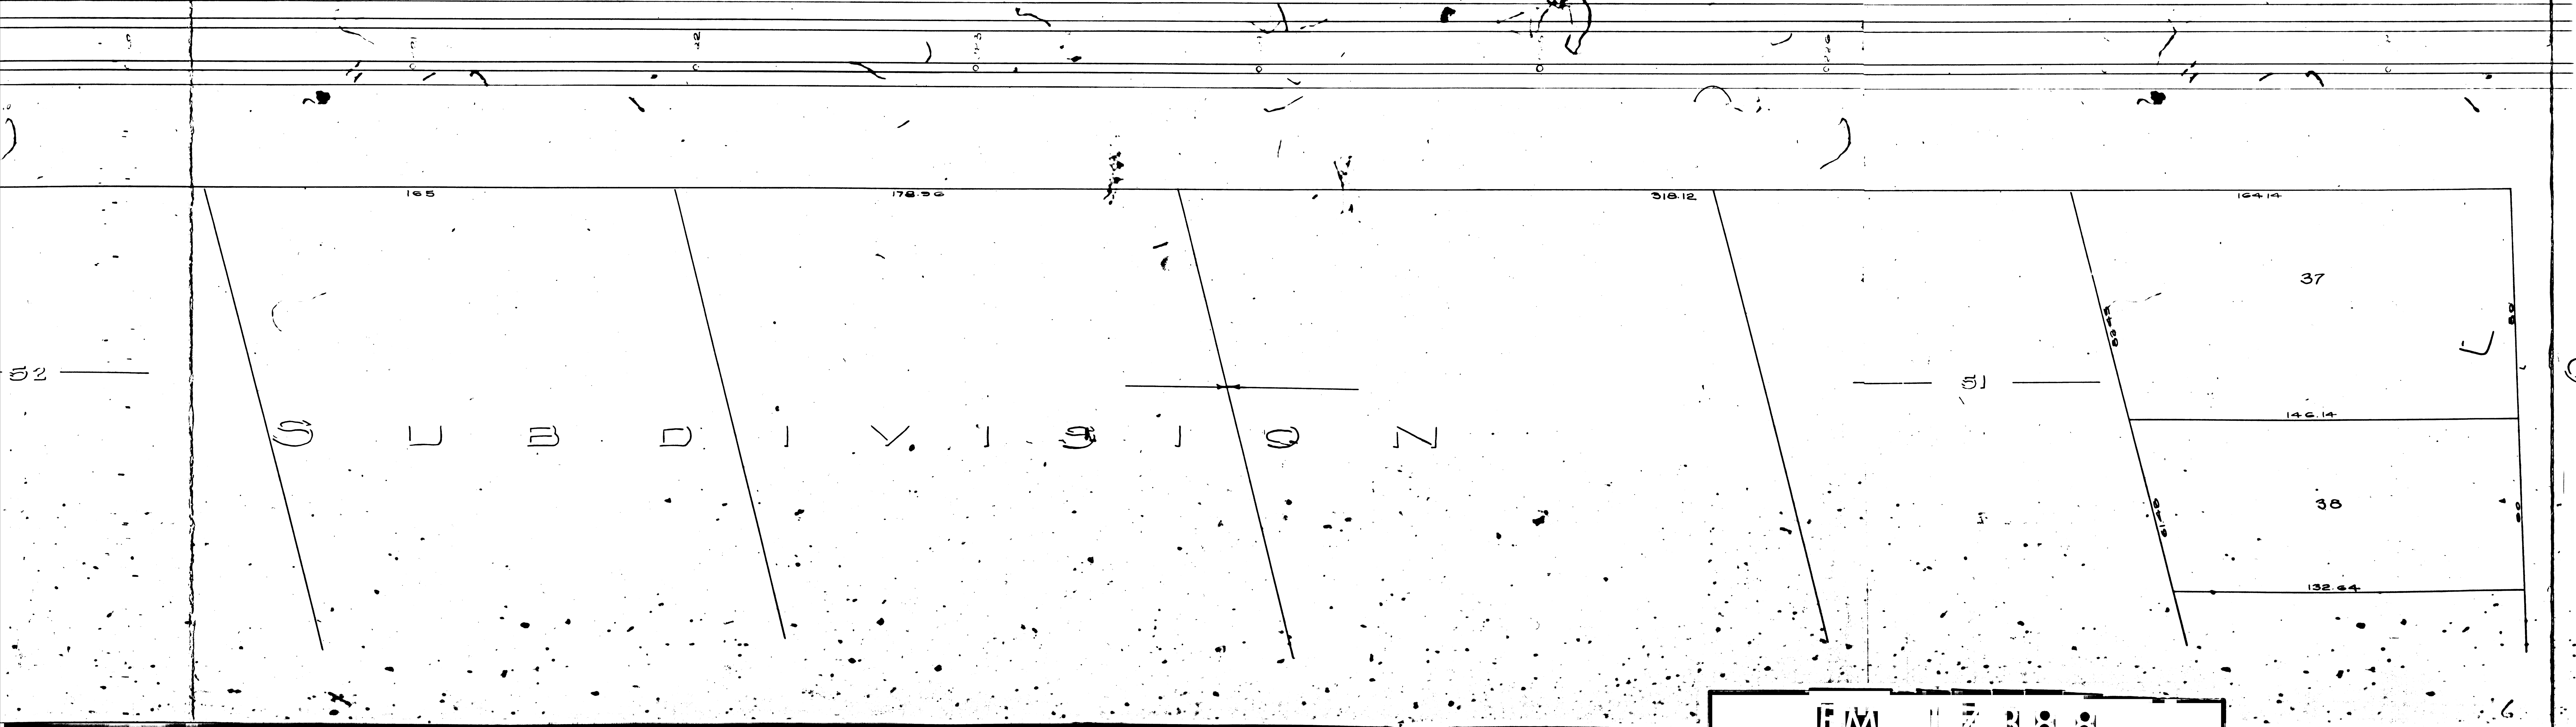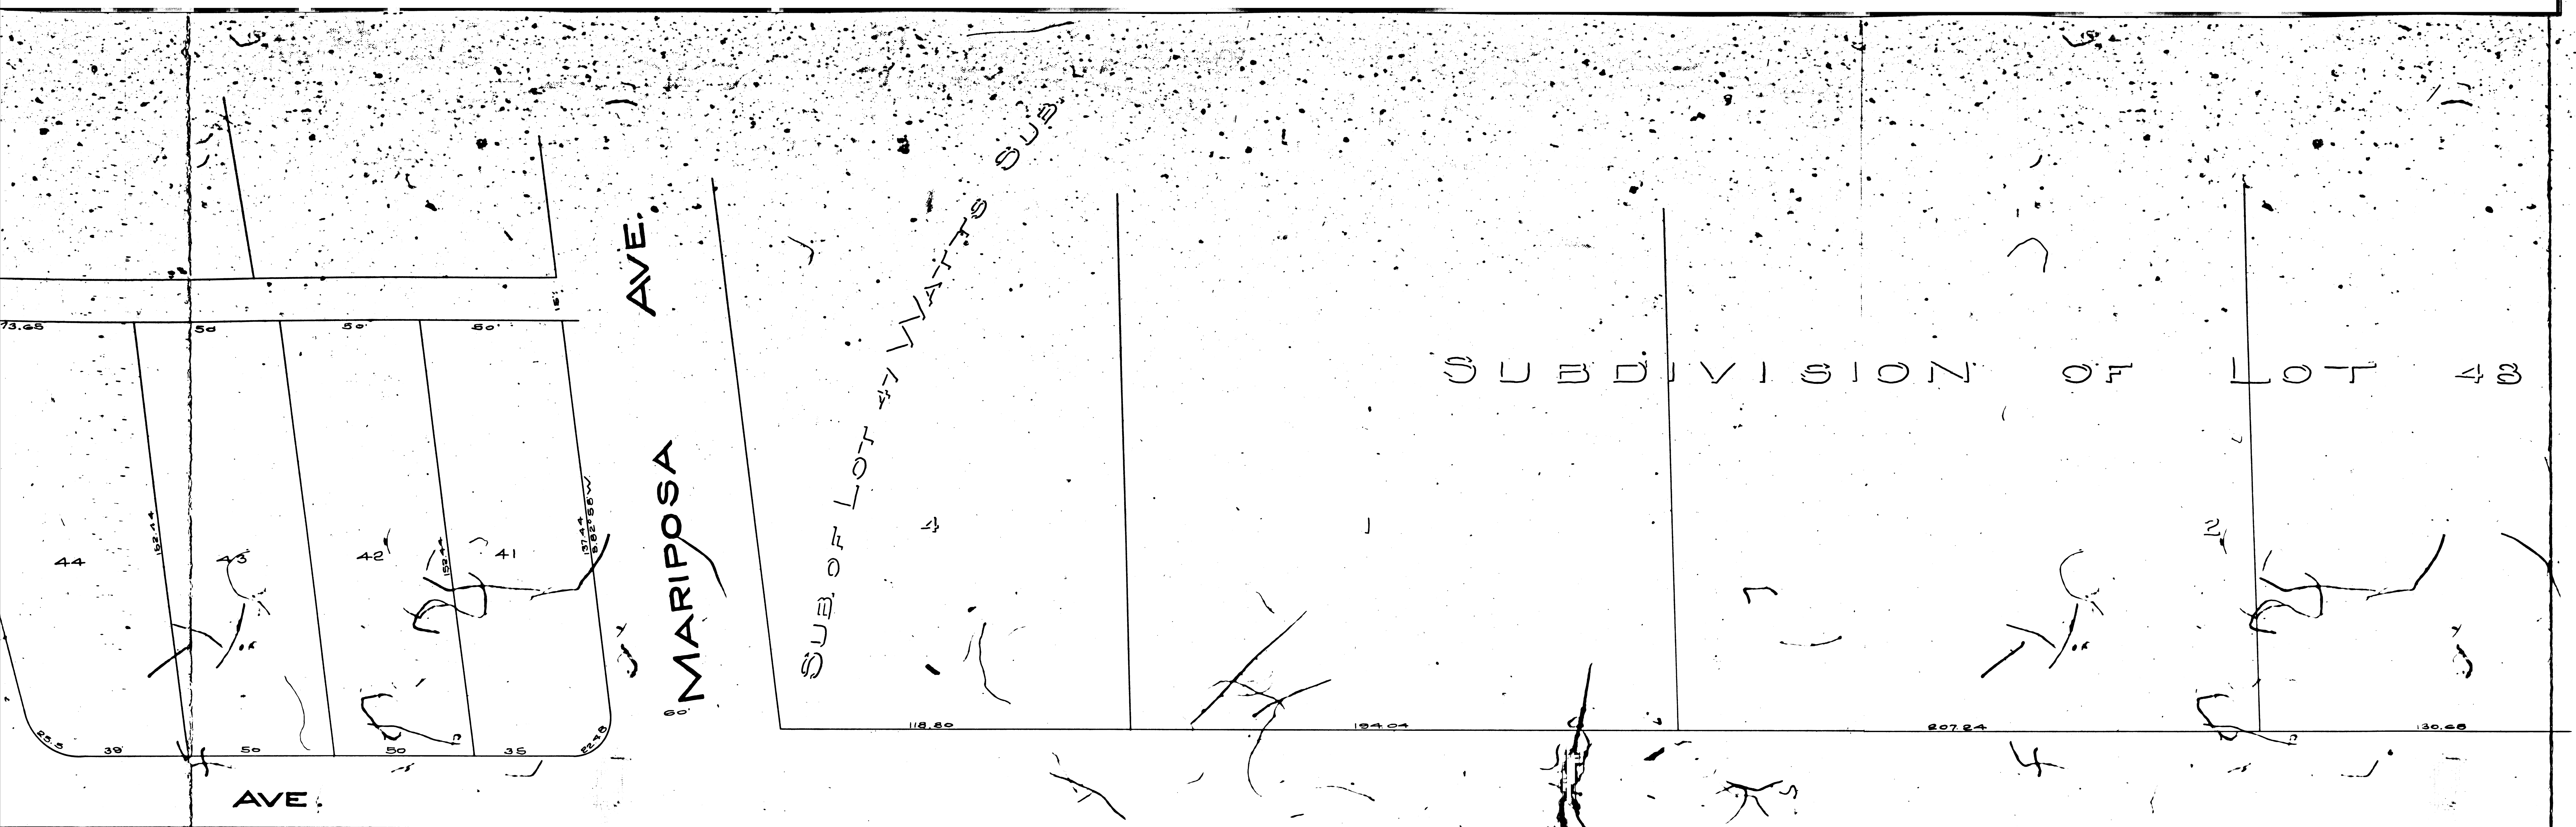

1981 JUN 30 8:01 AM
4 2 14 4 4

WATTS SUBD.


AVE.

HAMILTON PLACE


AVE.

CENTRAL AVE.


PALM ST.

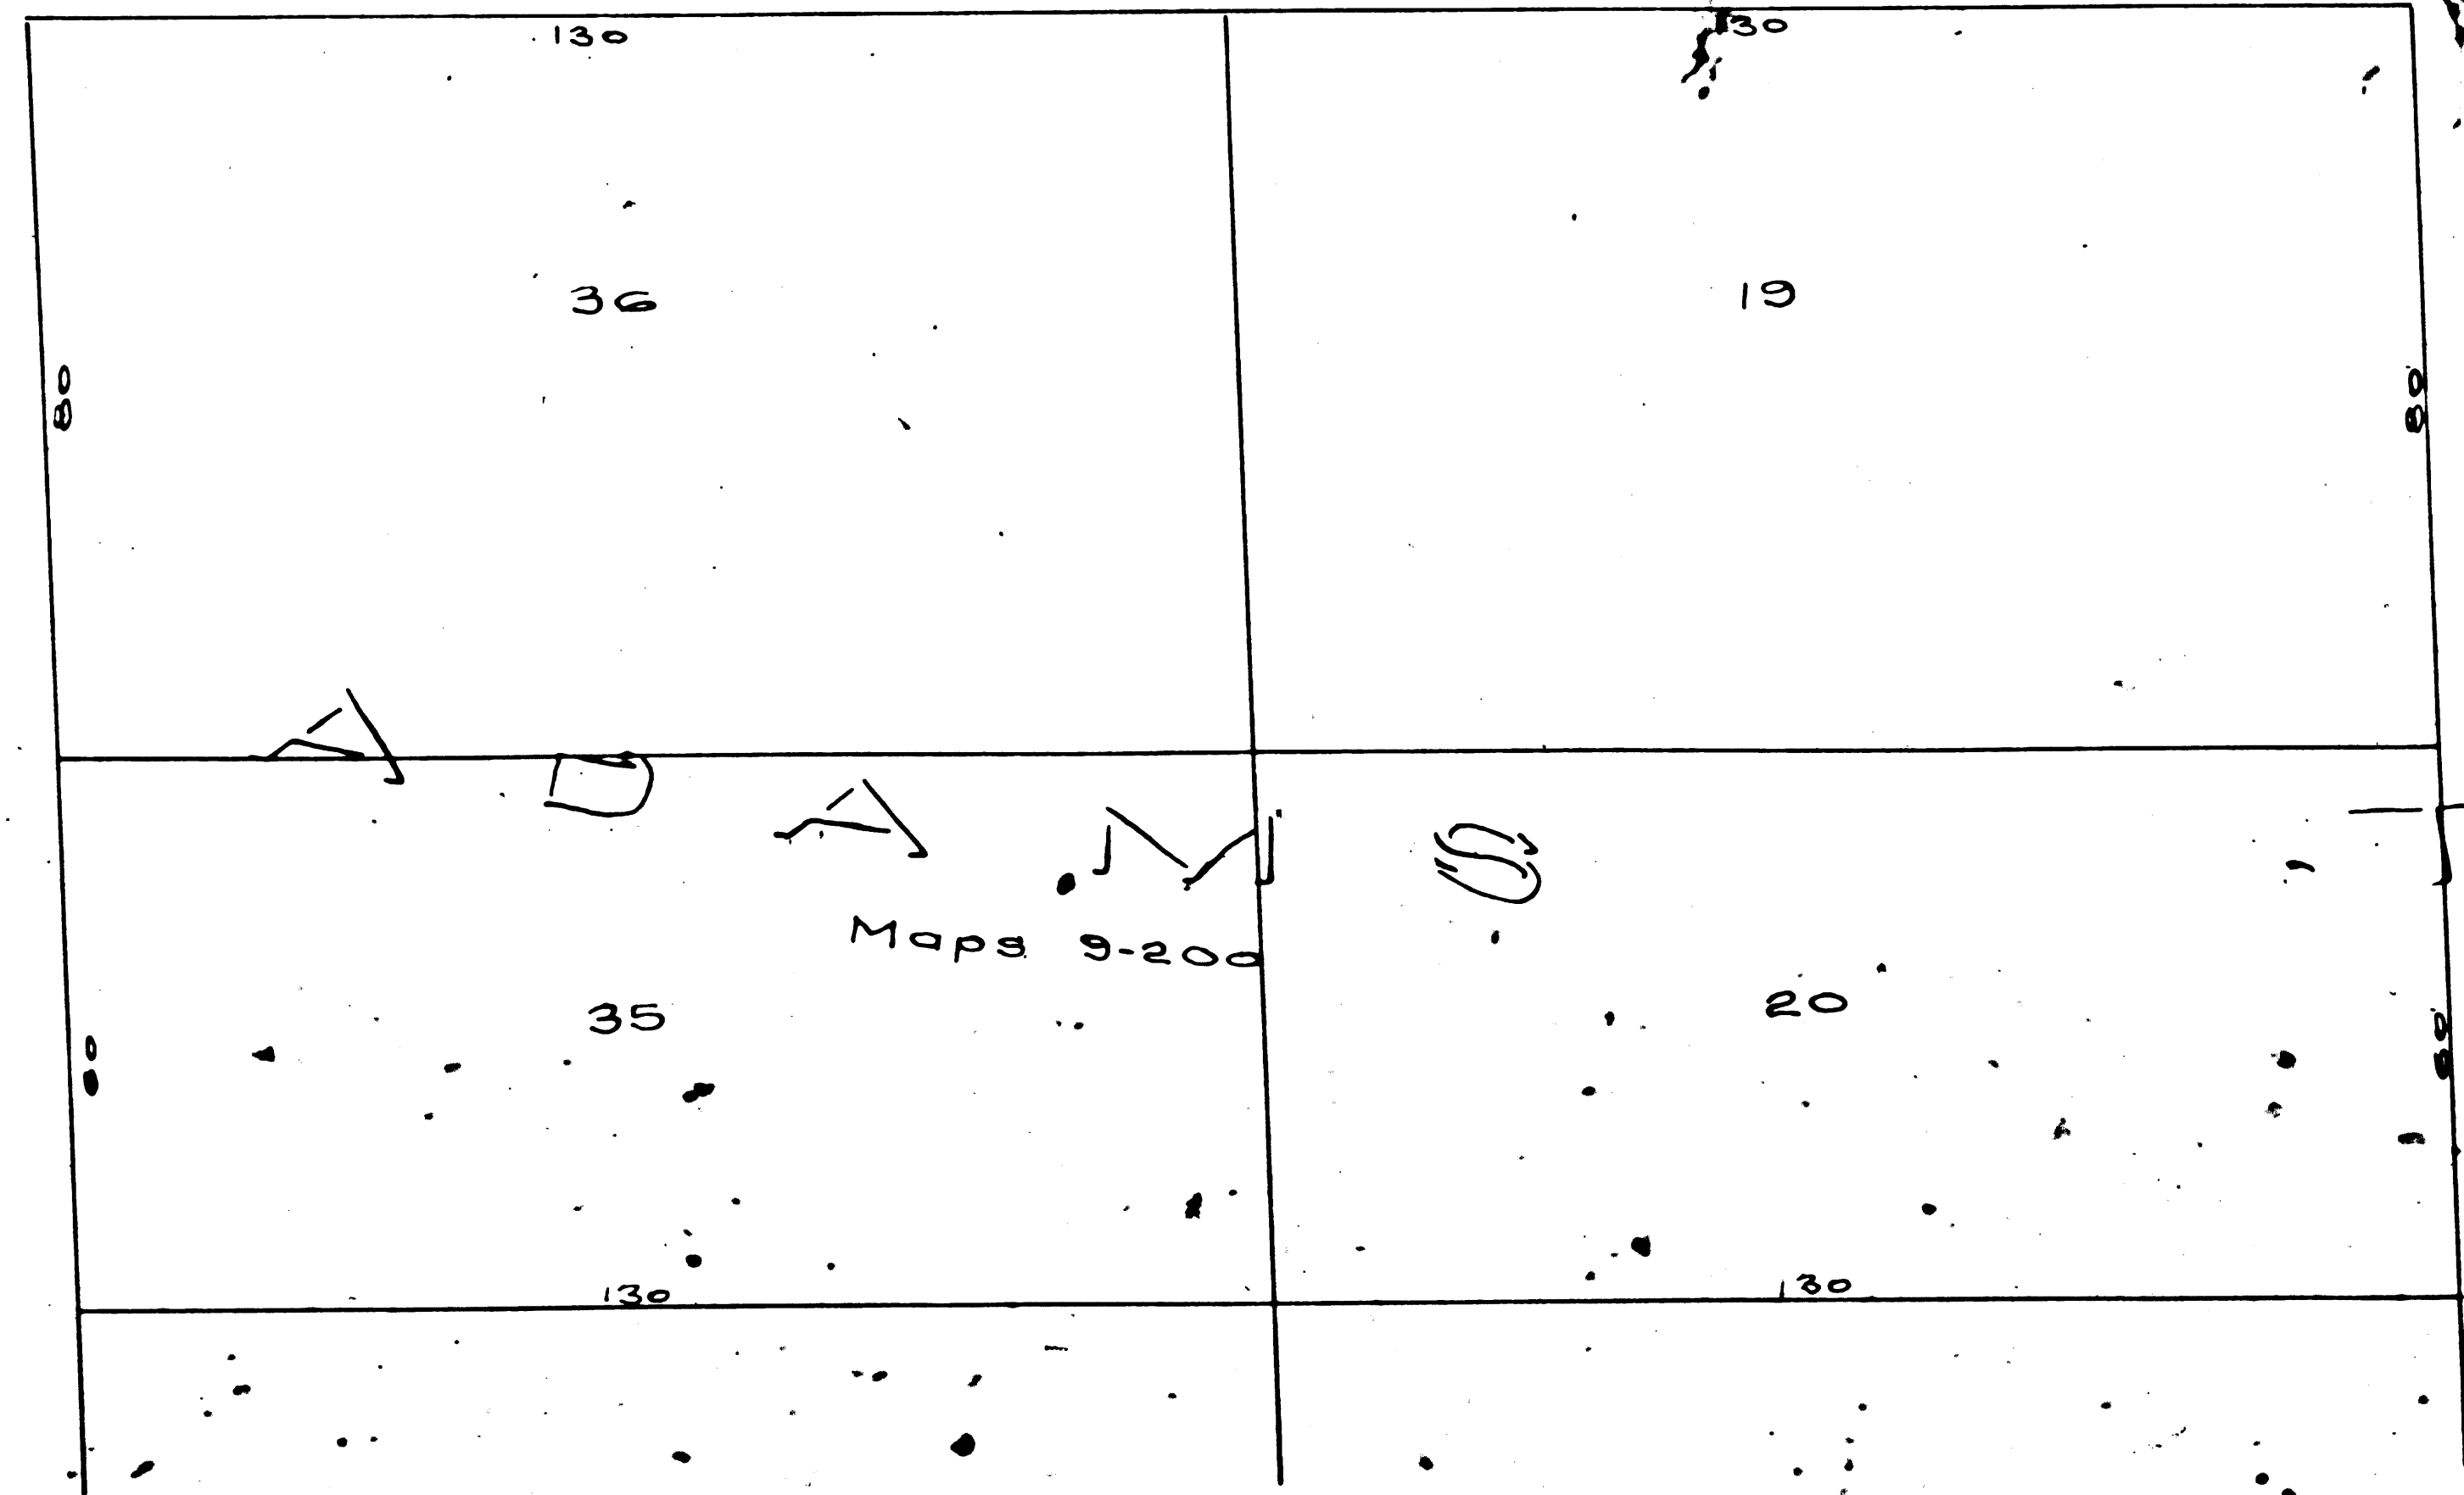

ADAMS


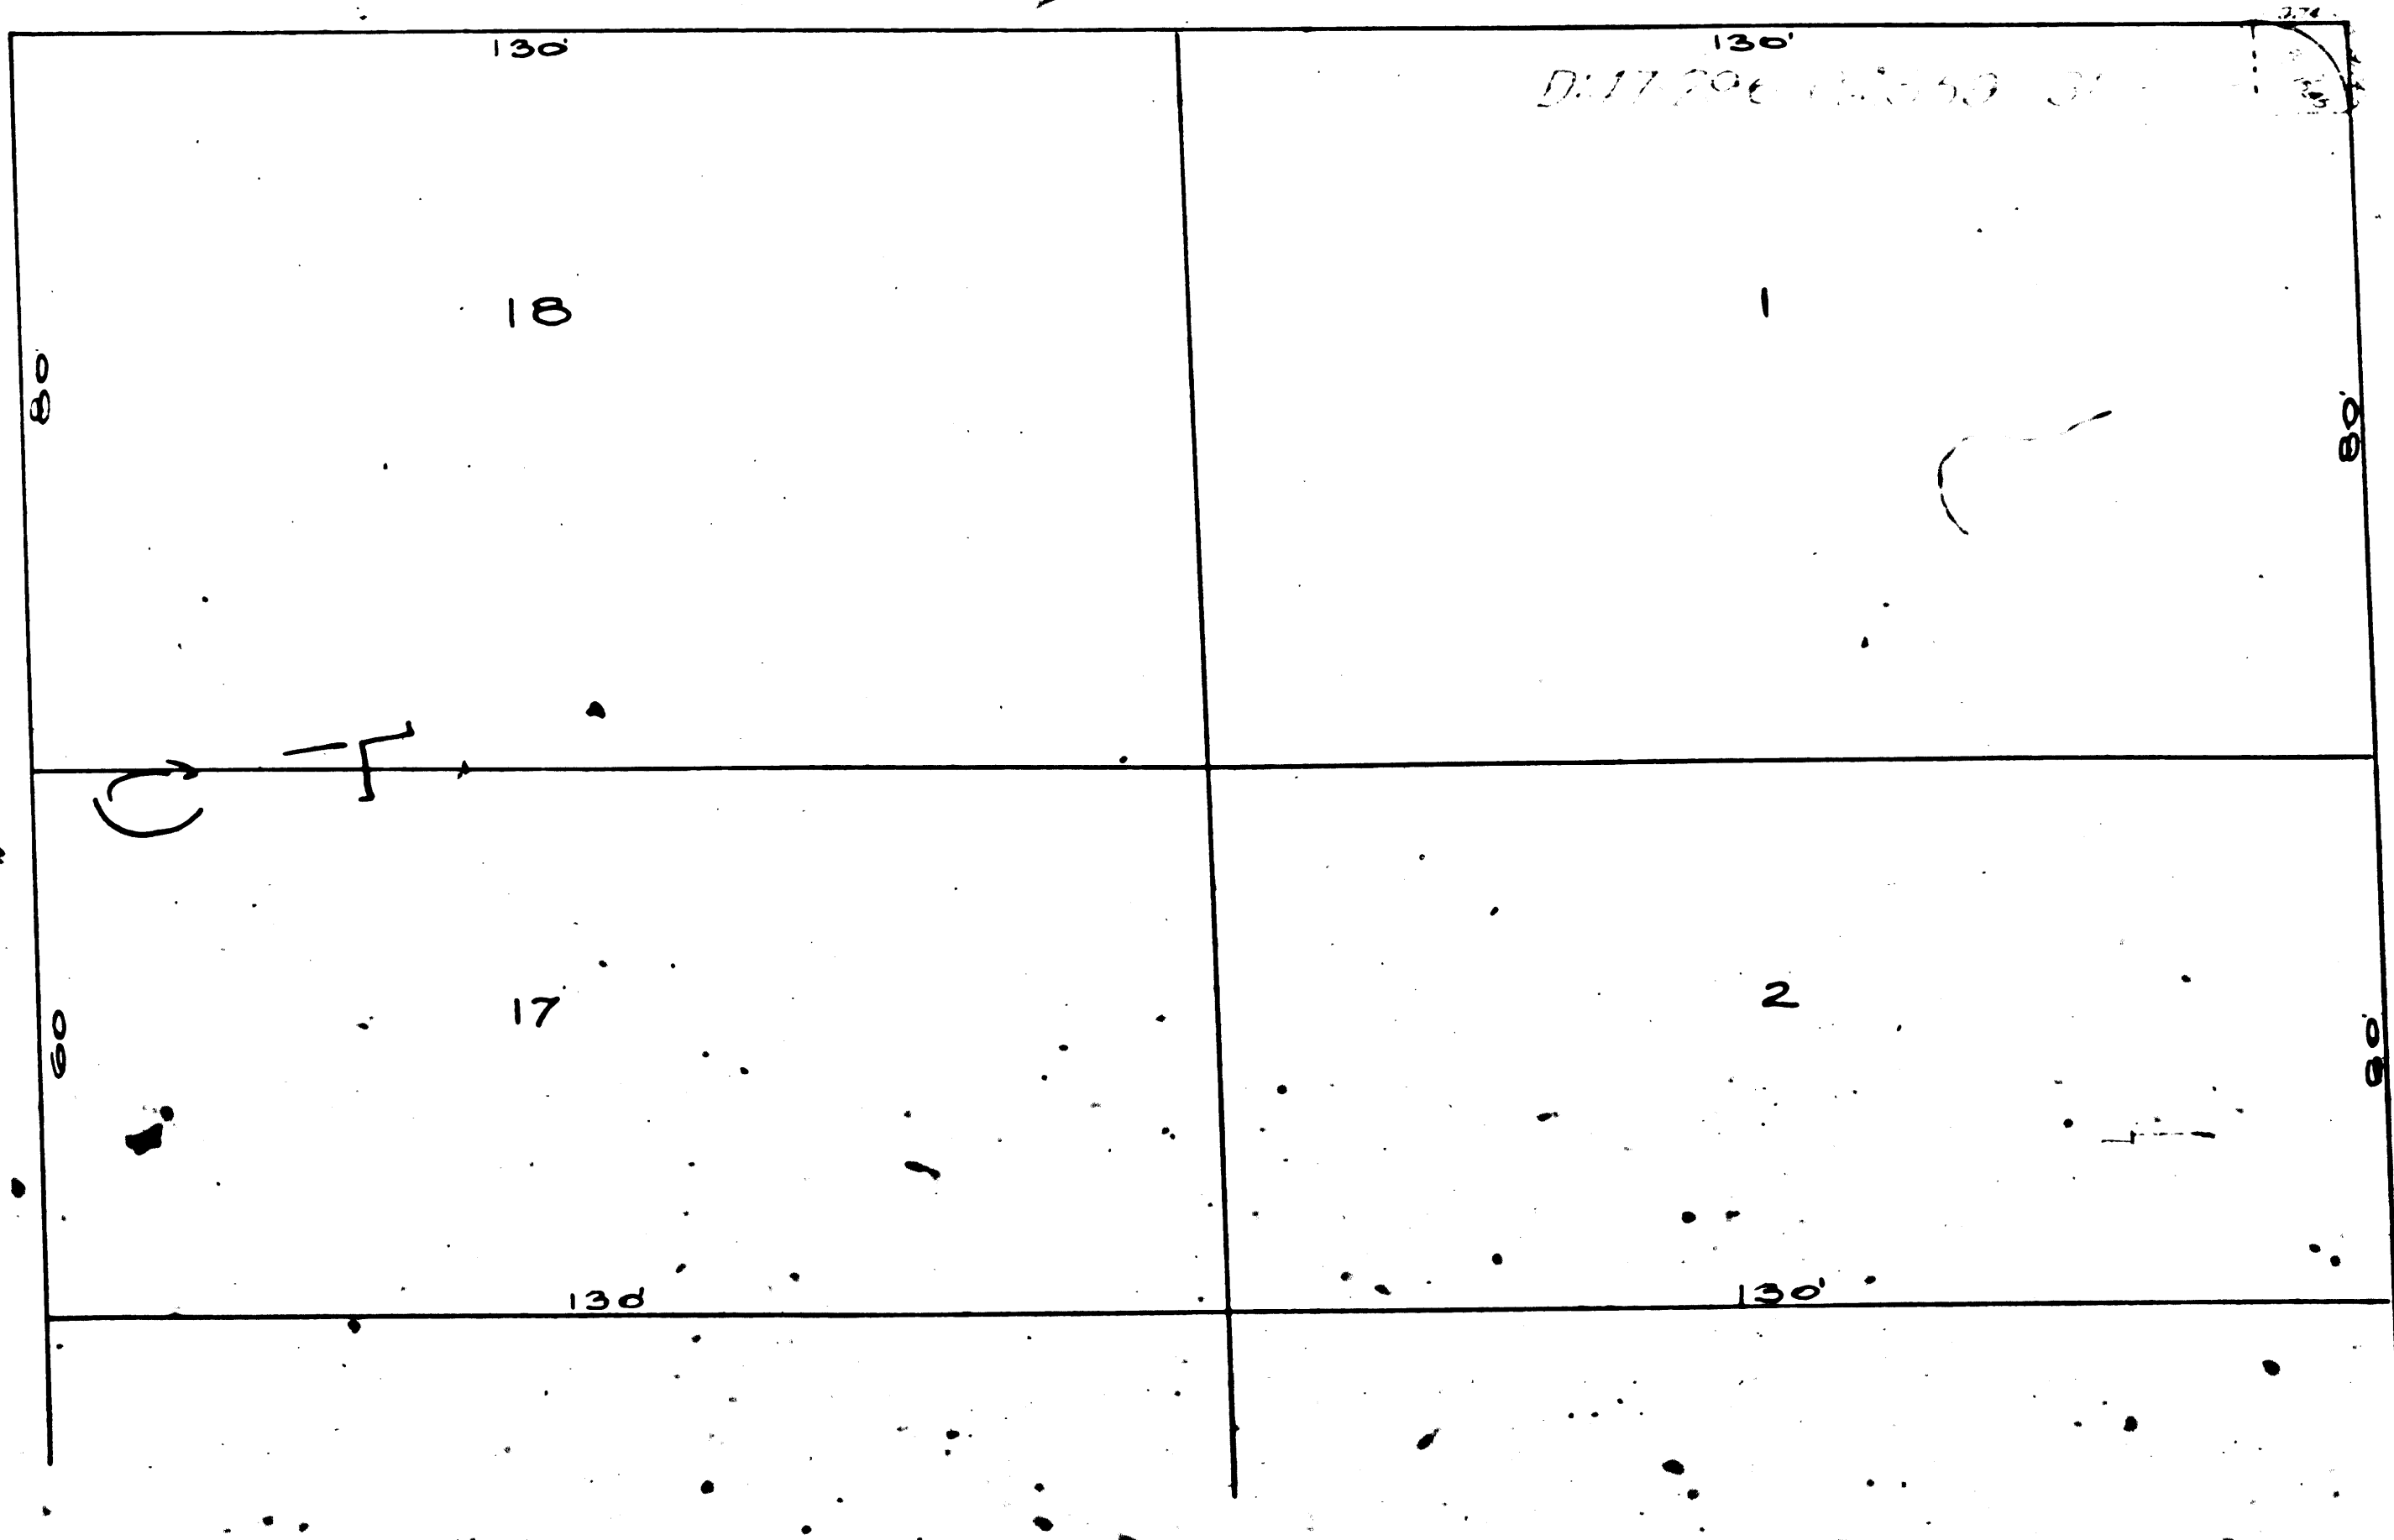


SYCAMORE

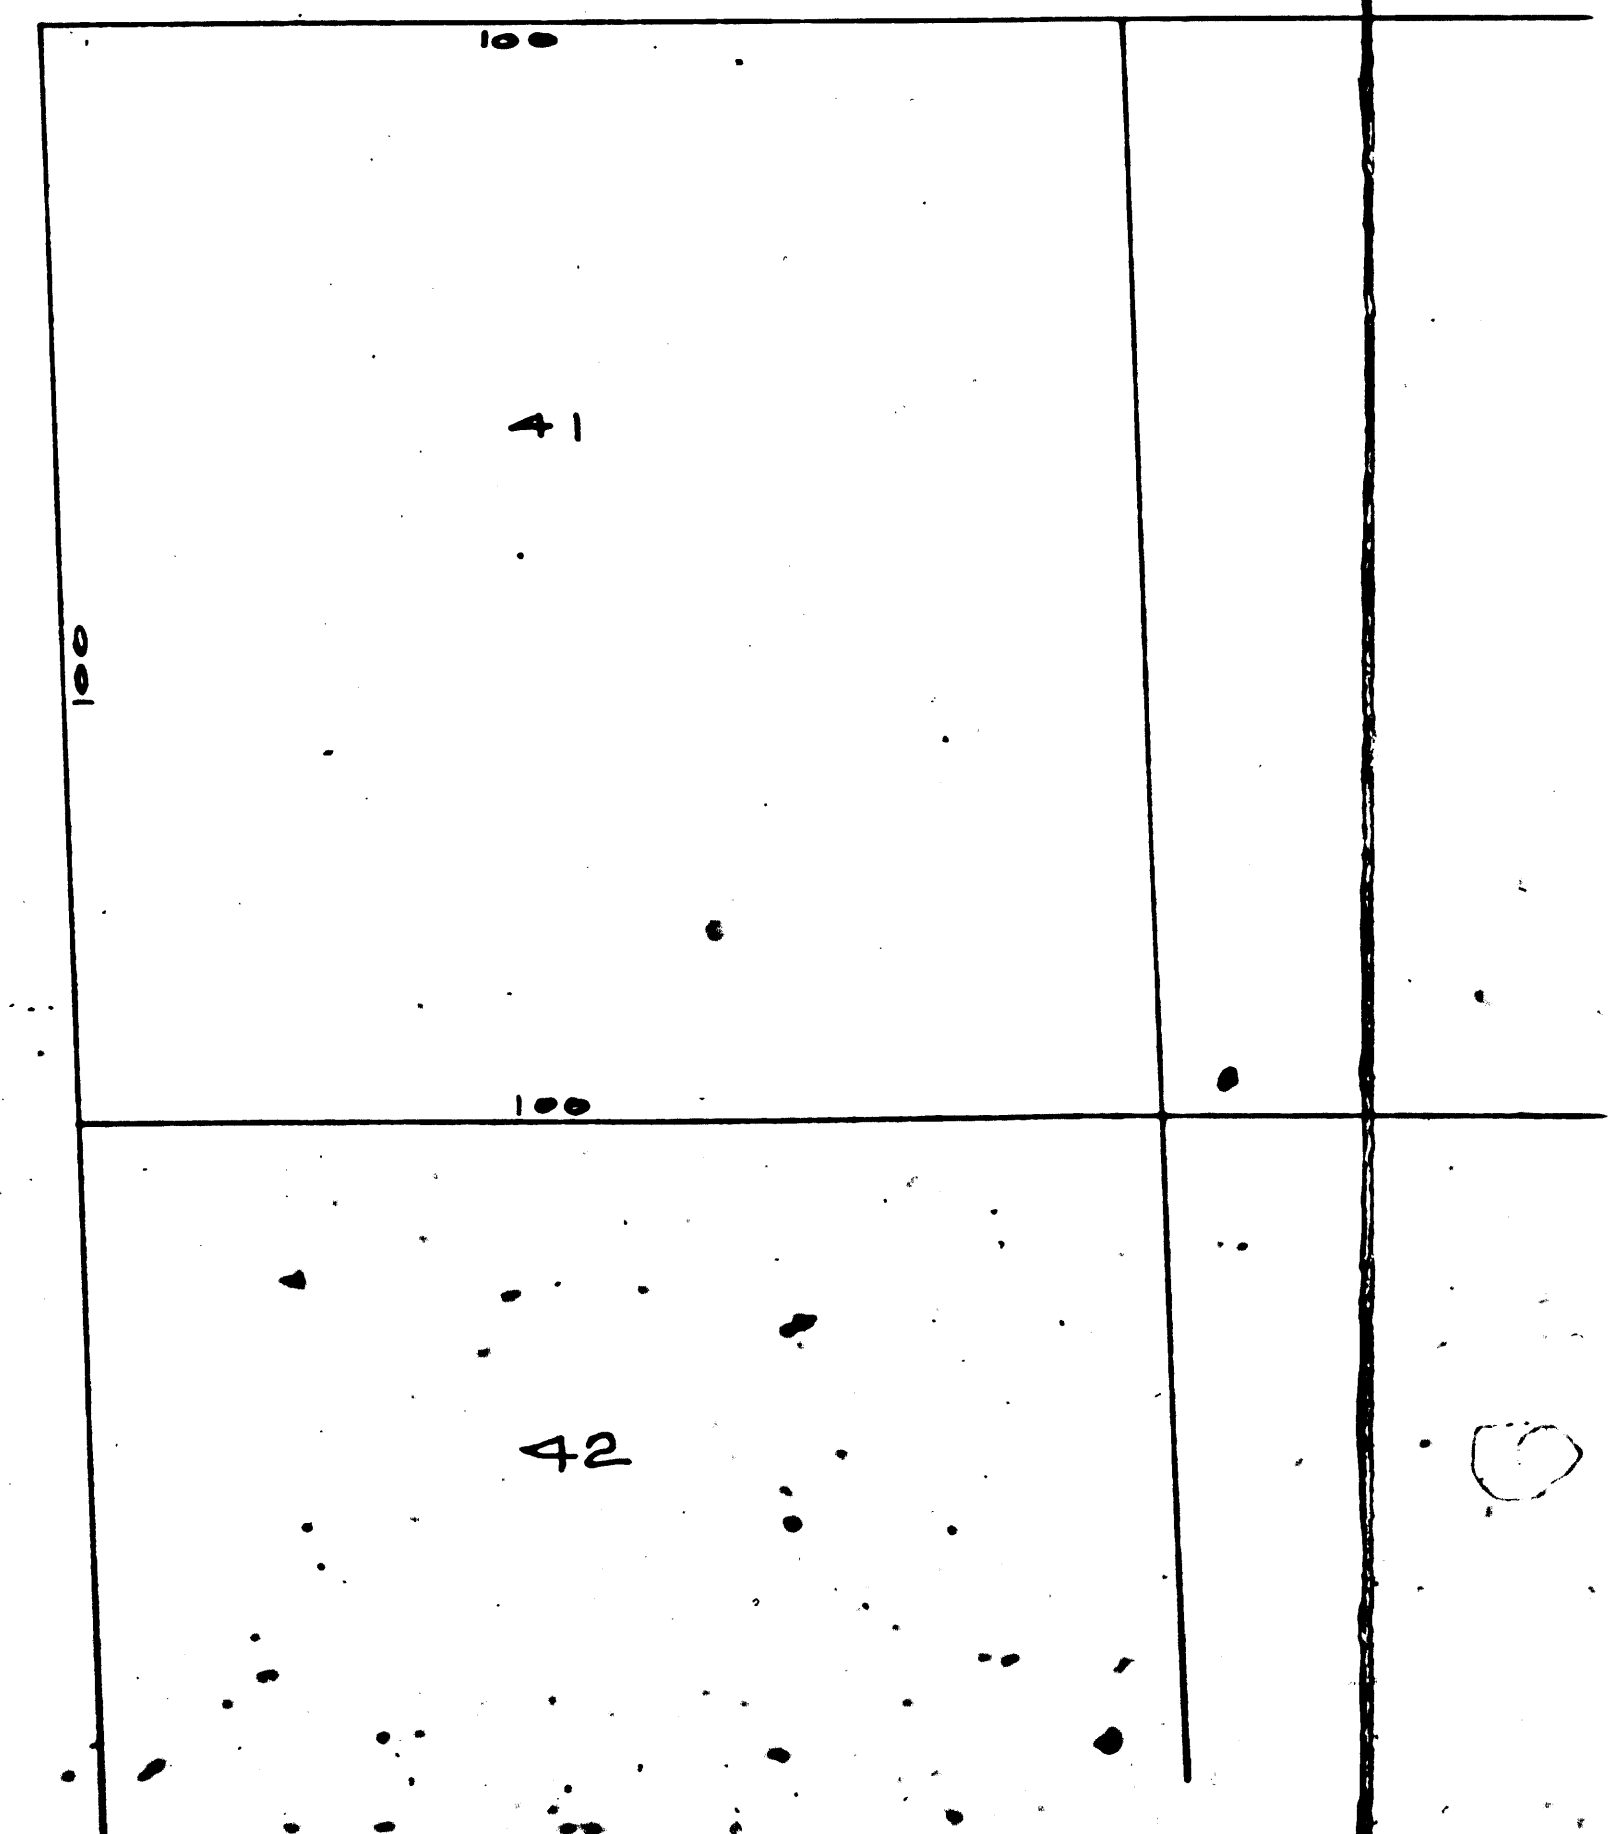

D-57-29 O.R. 4746-60

REMA 1 7 31 8 8

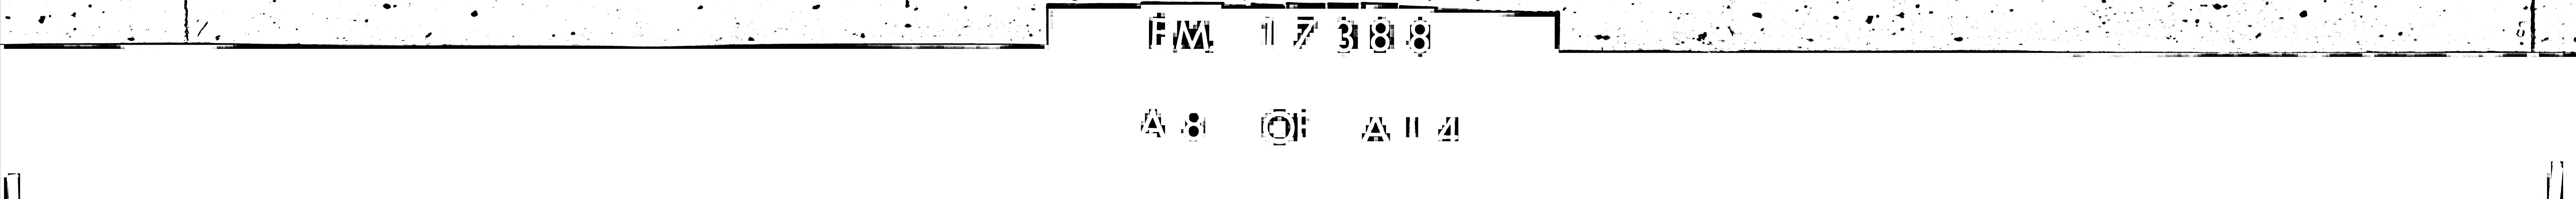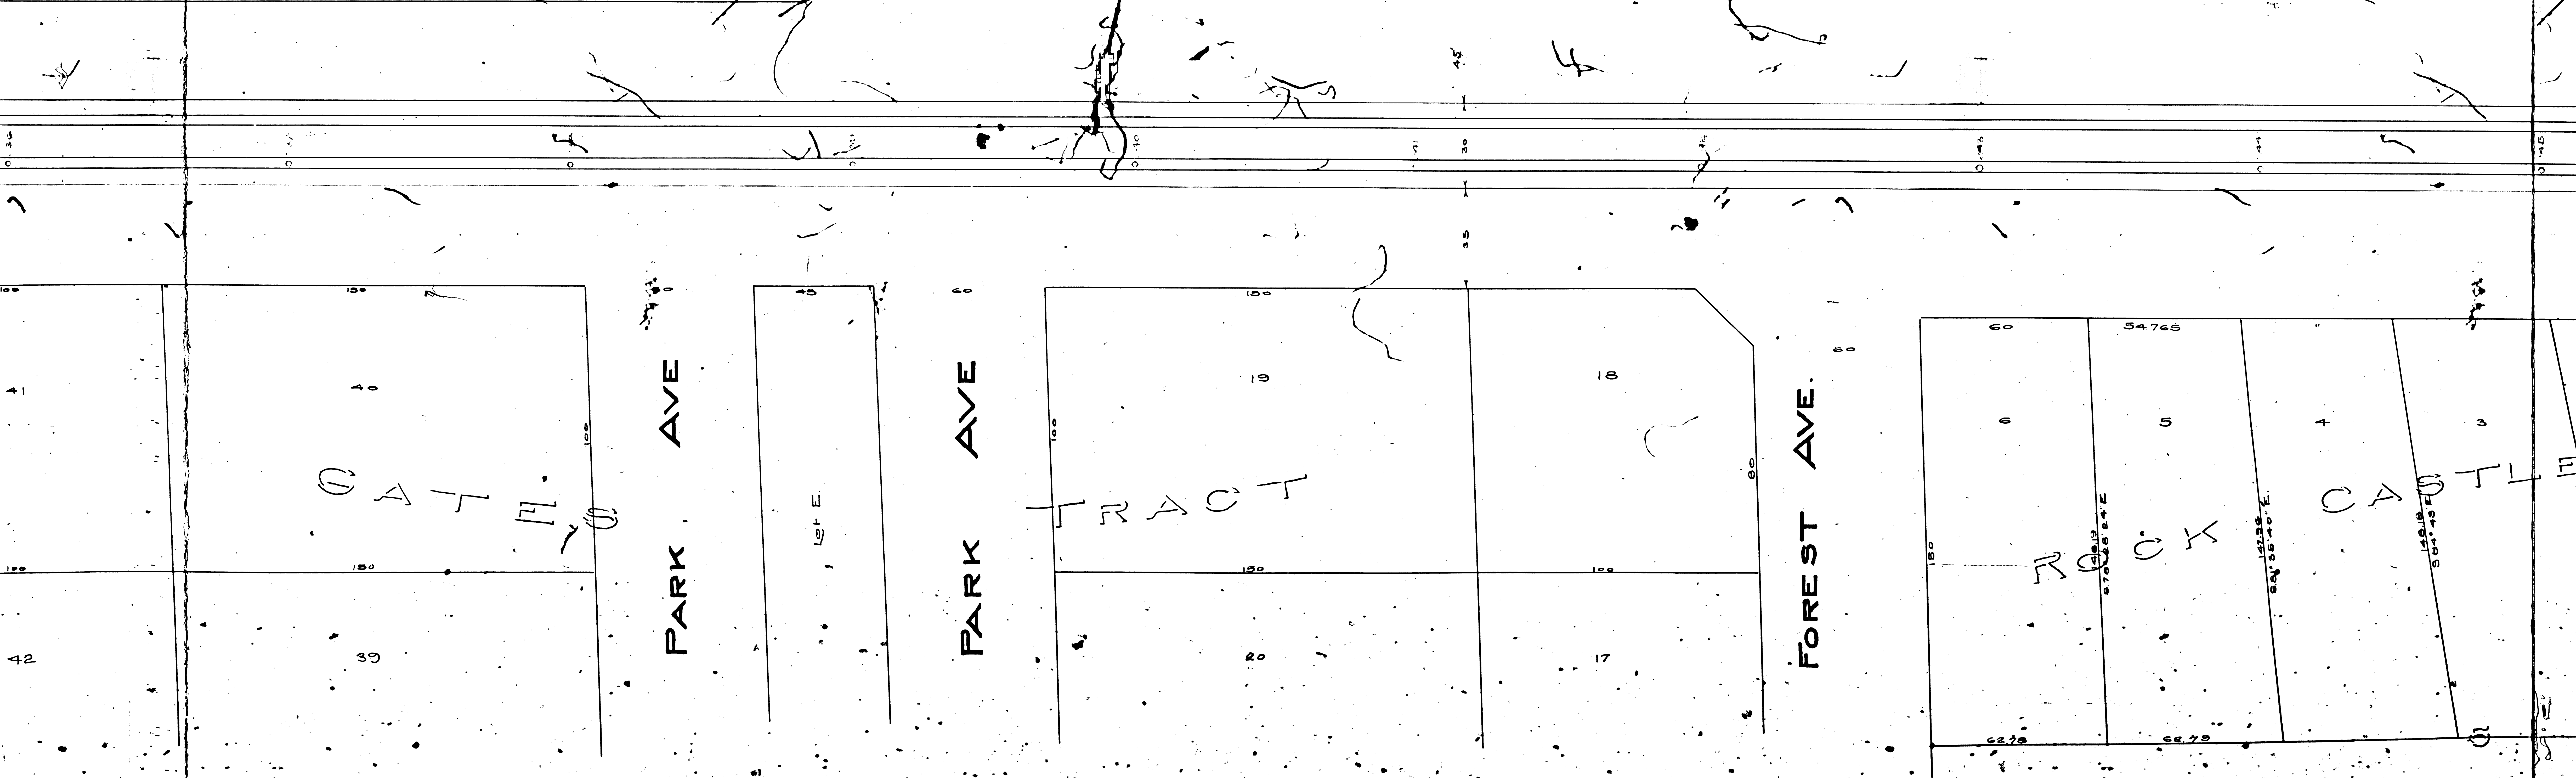


F/M 11 7 31 8 8

A 8 O A 11 4

MB 14-70

66

MYRTLE AVE.

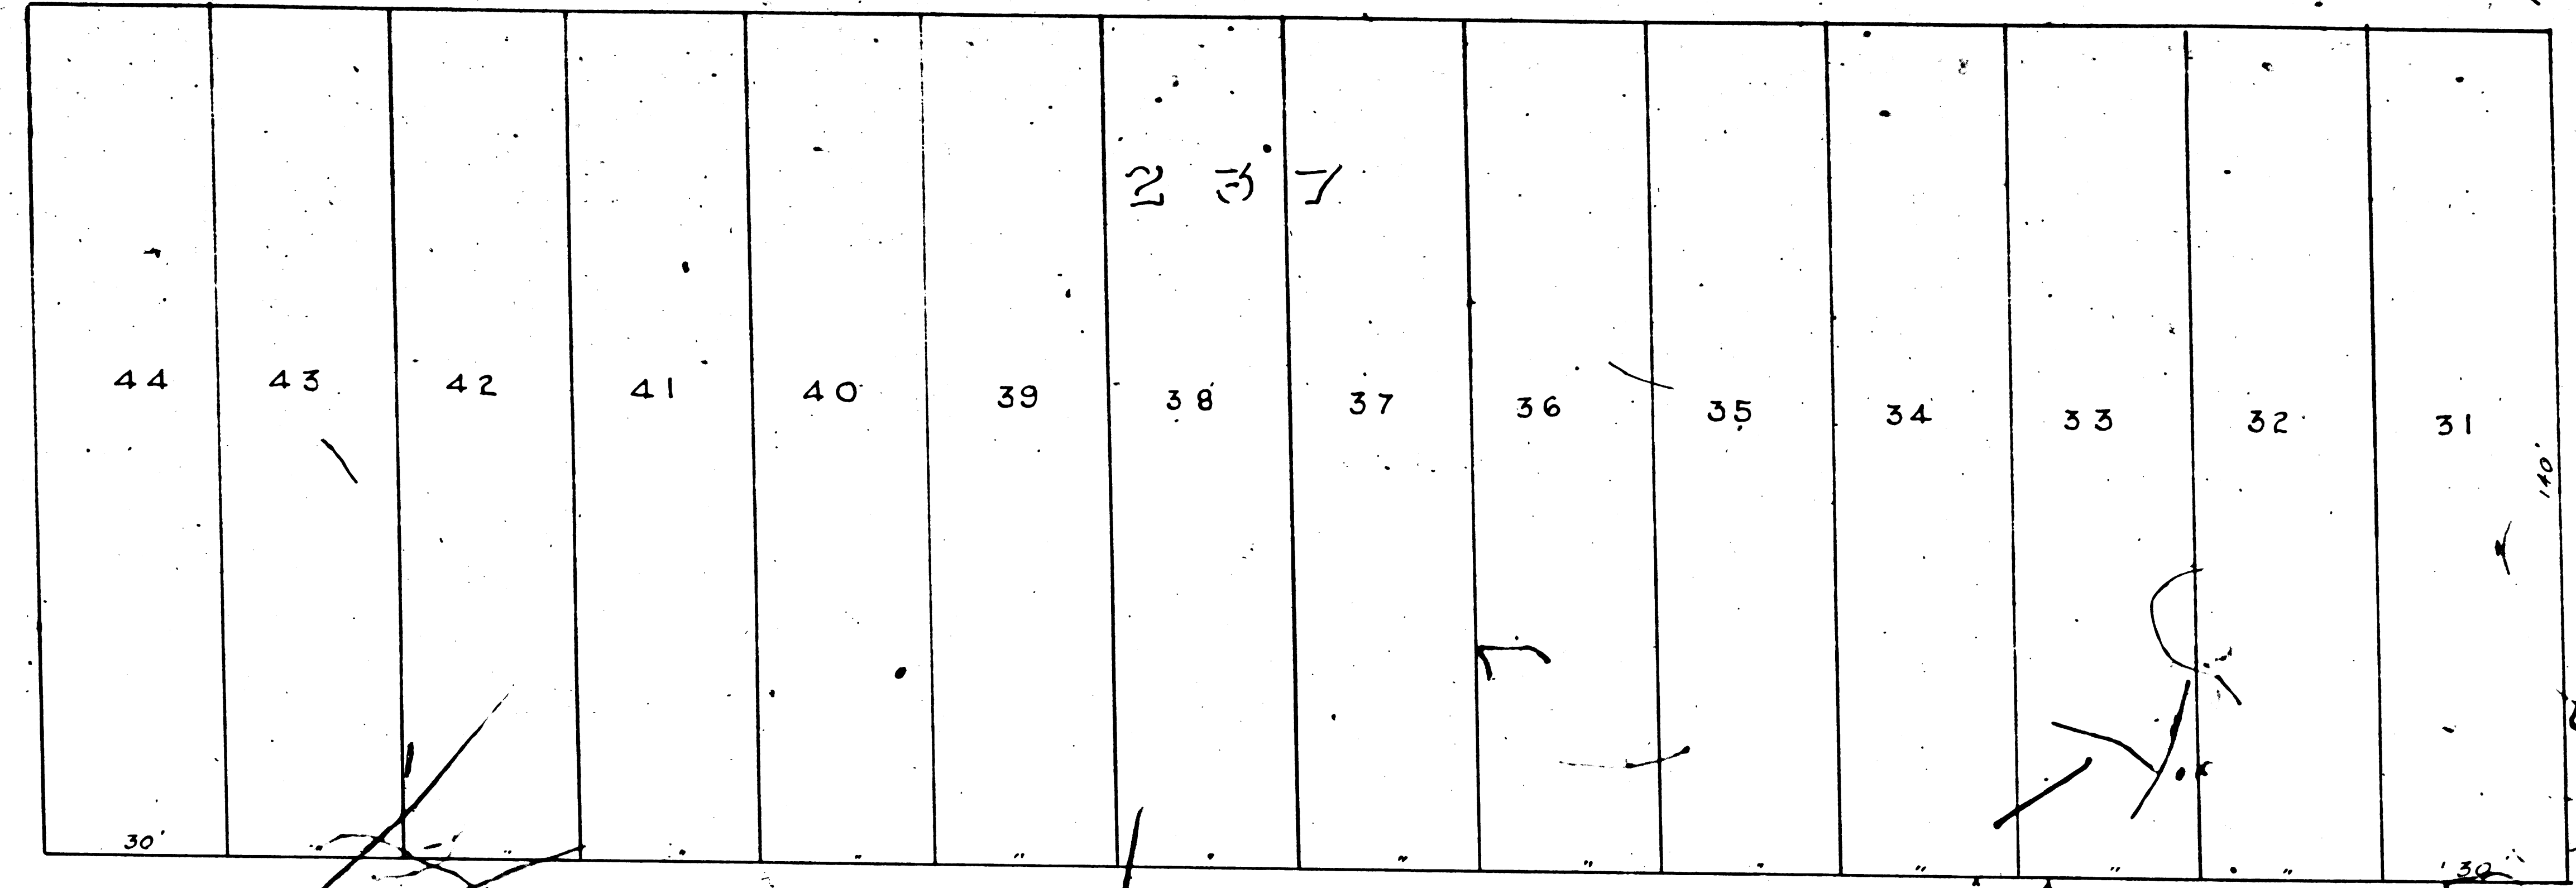

EAGLE ROCK ROAD


EAGLE ROCK ROAD

CENTRAL AVE

Broken Black line is old RefW.
Solid Red line is present RefW.
D.M. 2578-25






JOHNSTON ST.

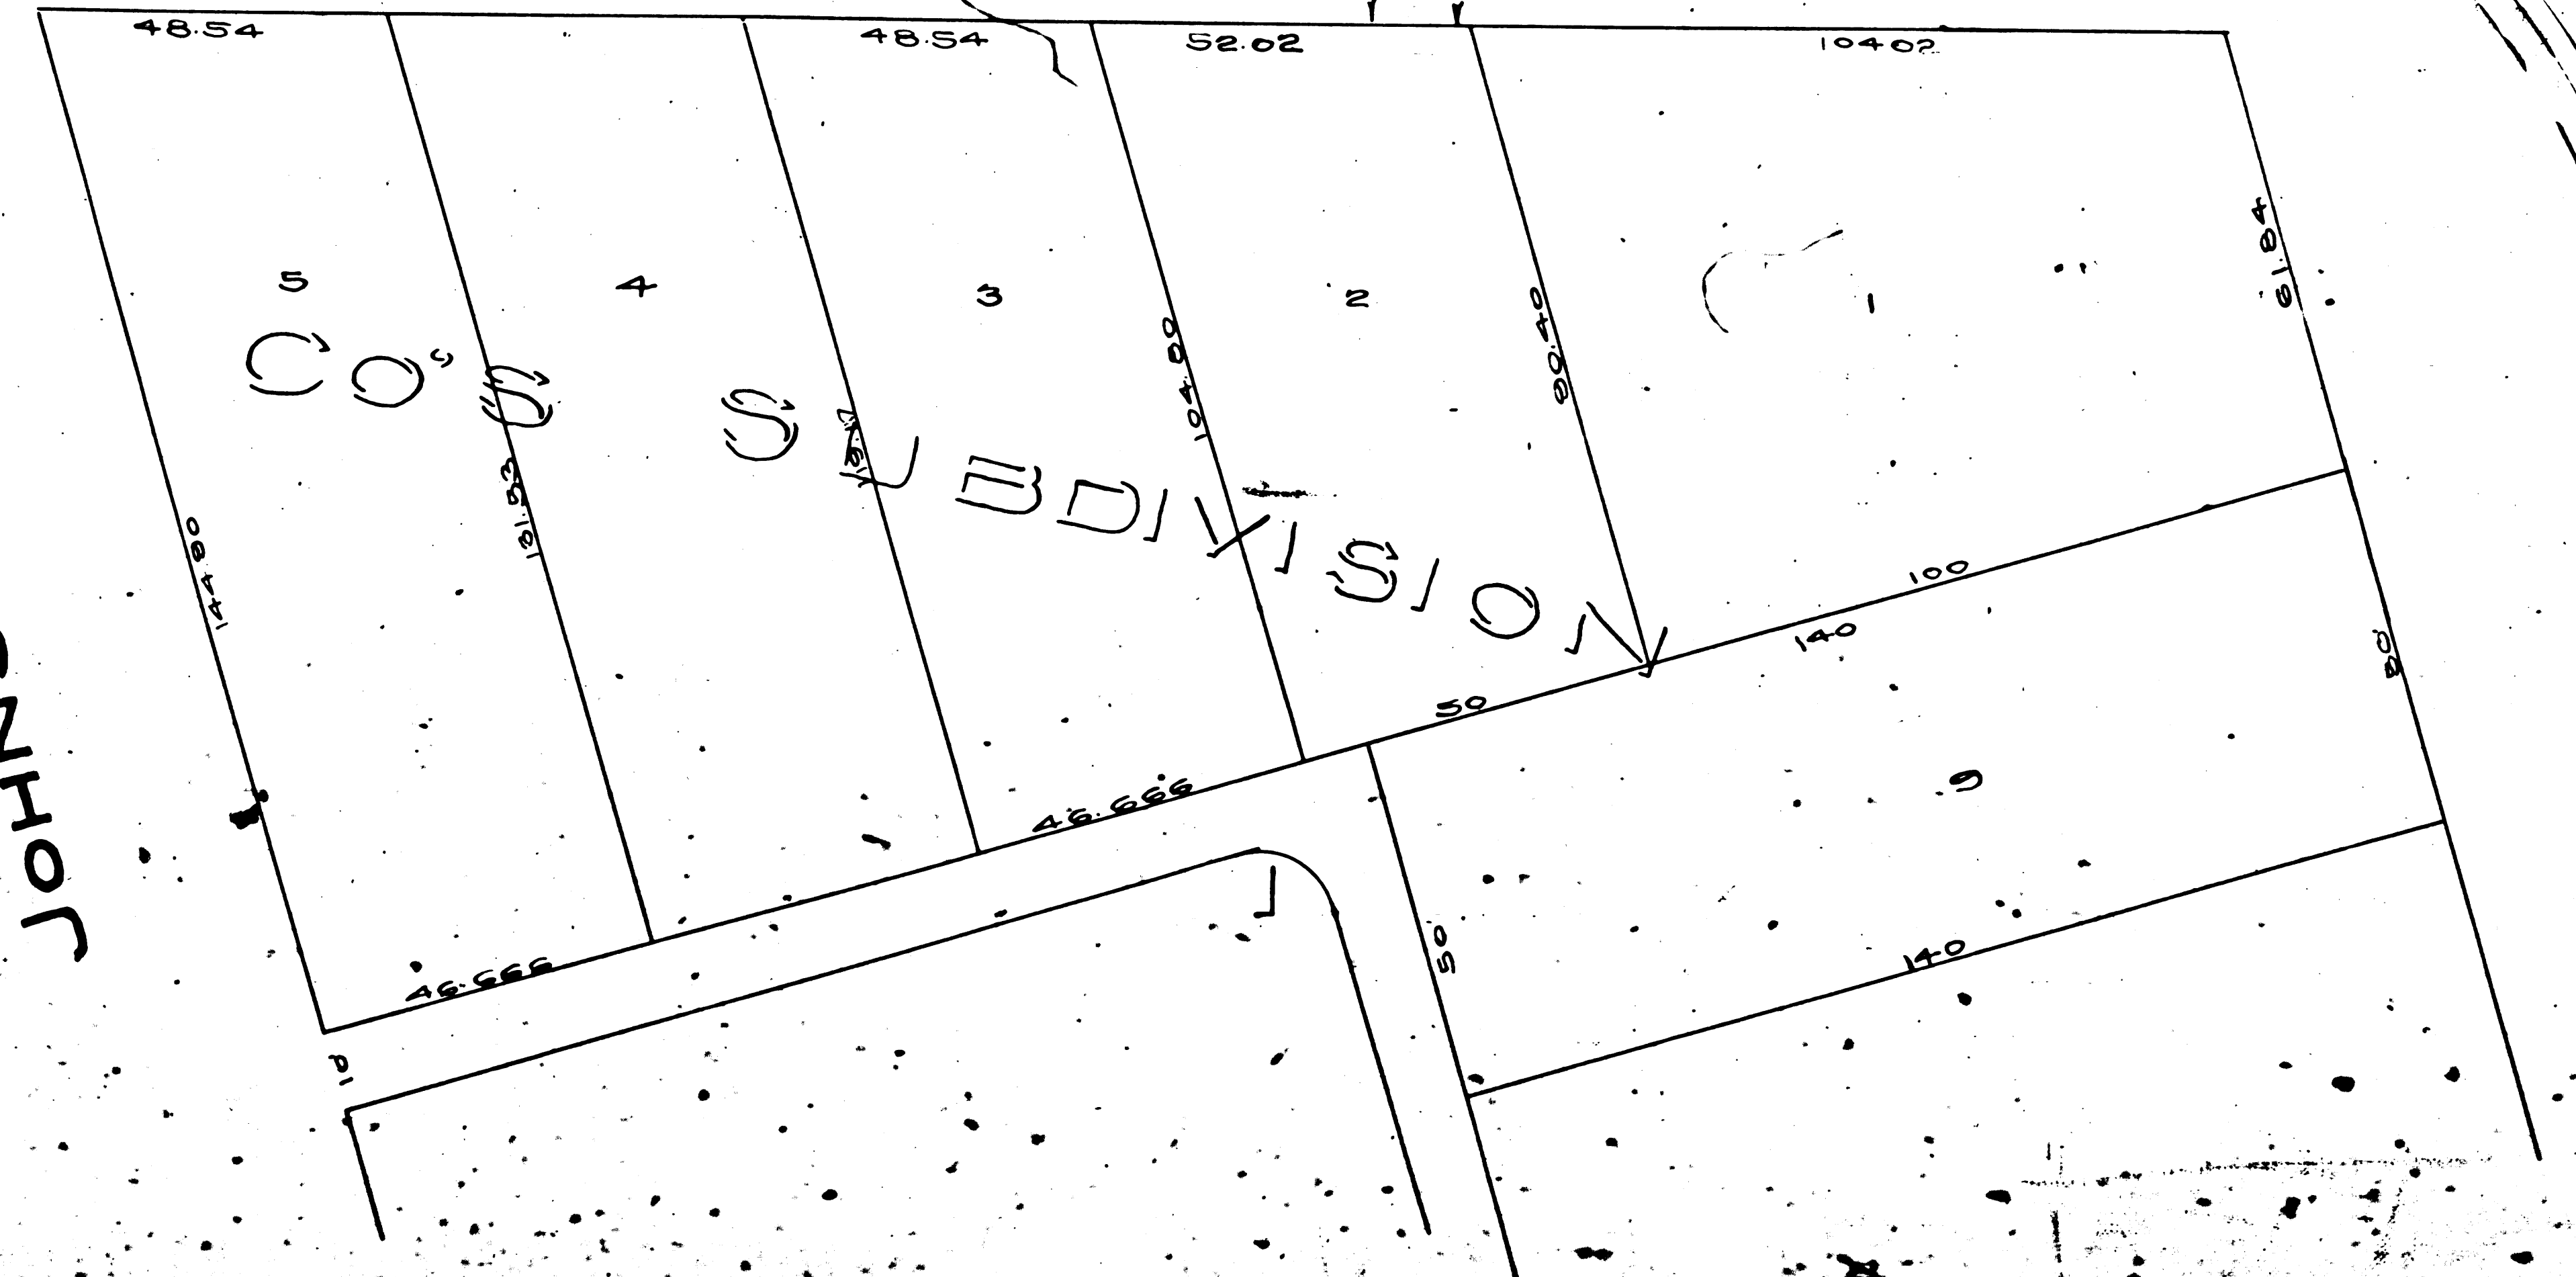

F.M. 11 7 31 8 8

4 9 17 24 31

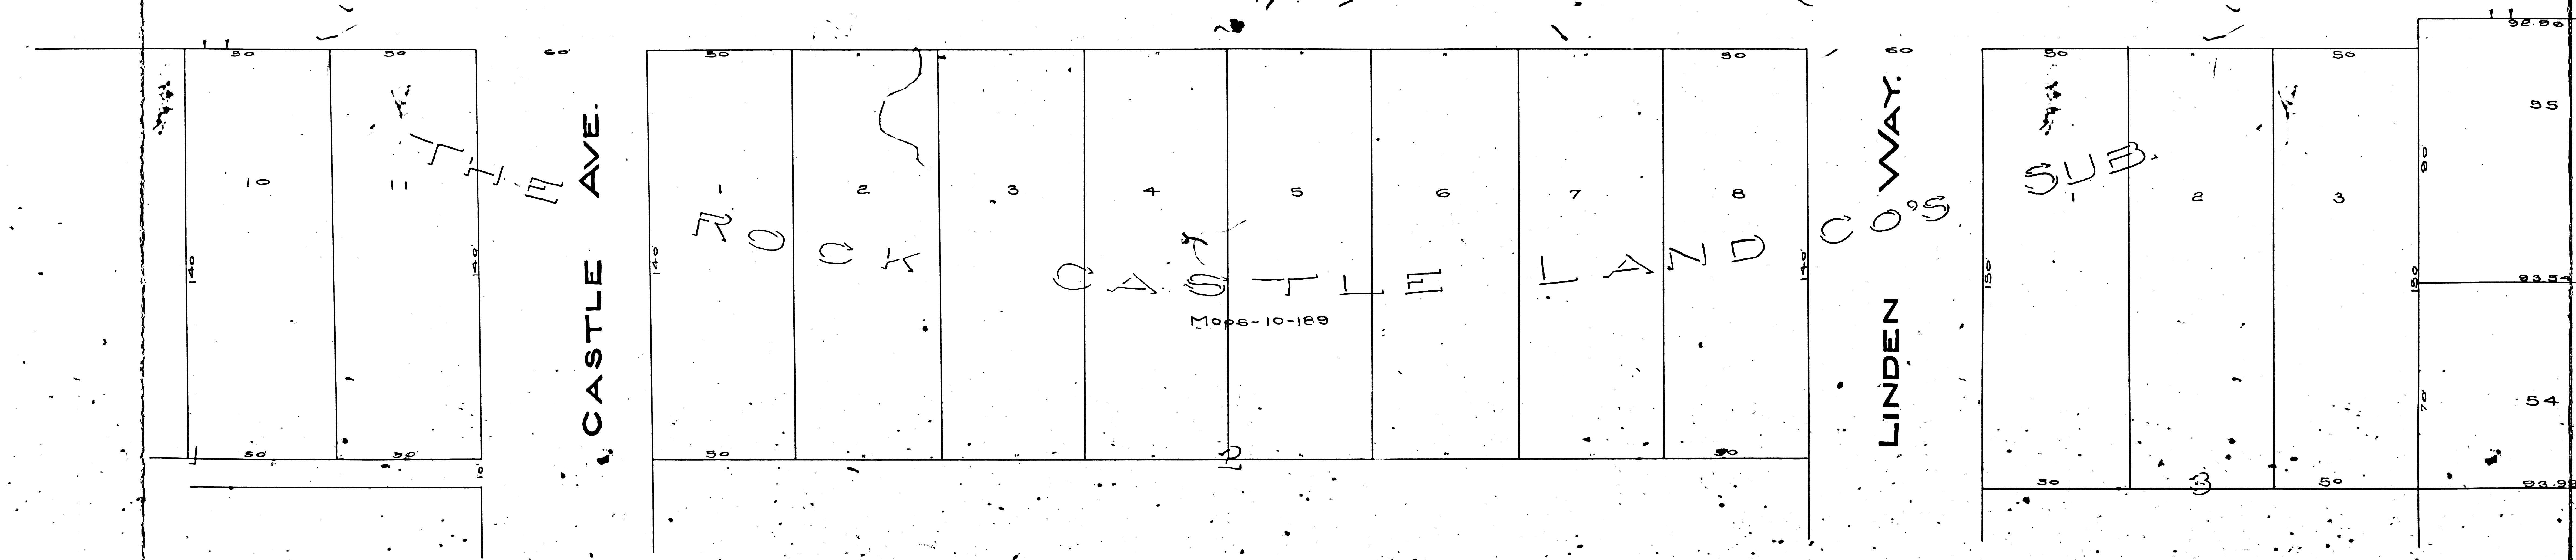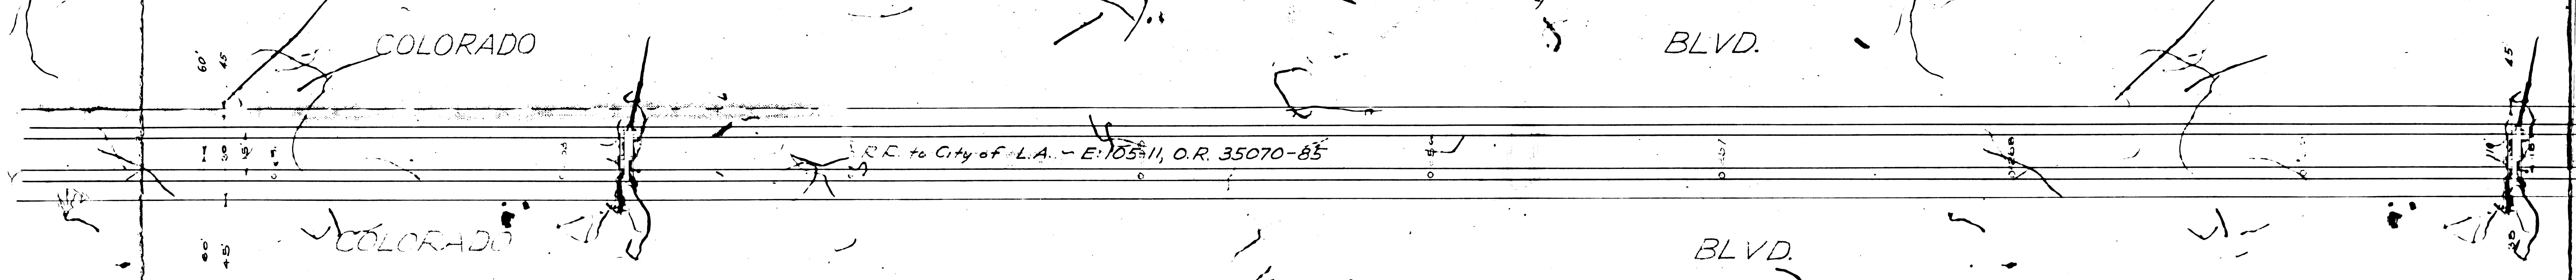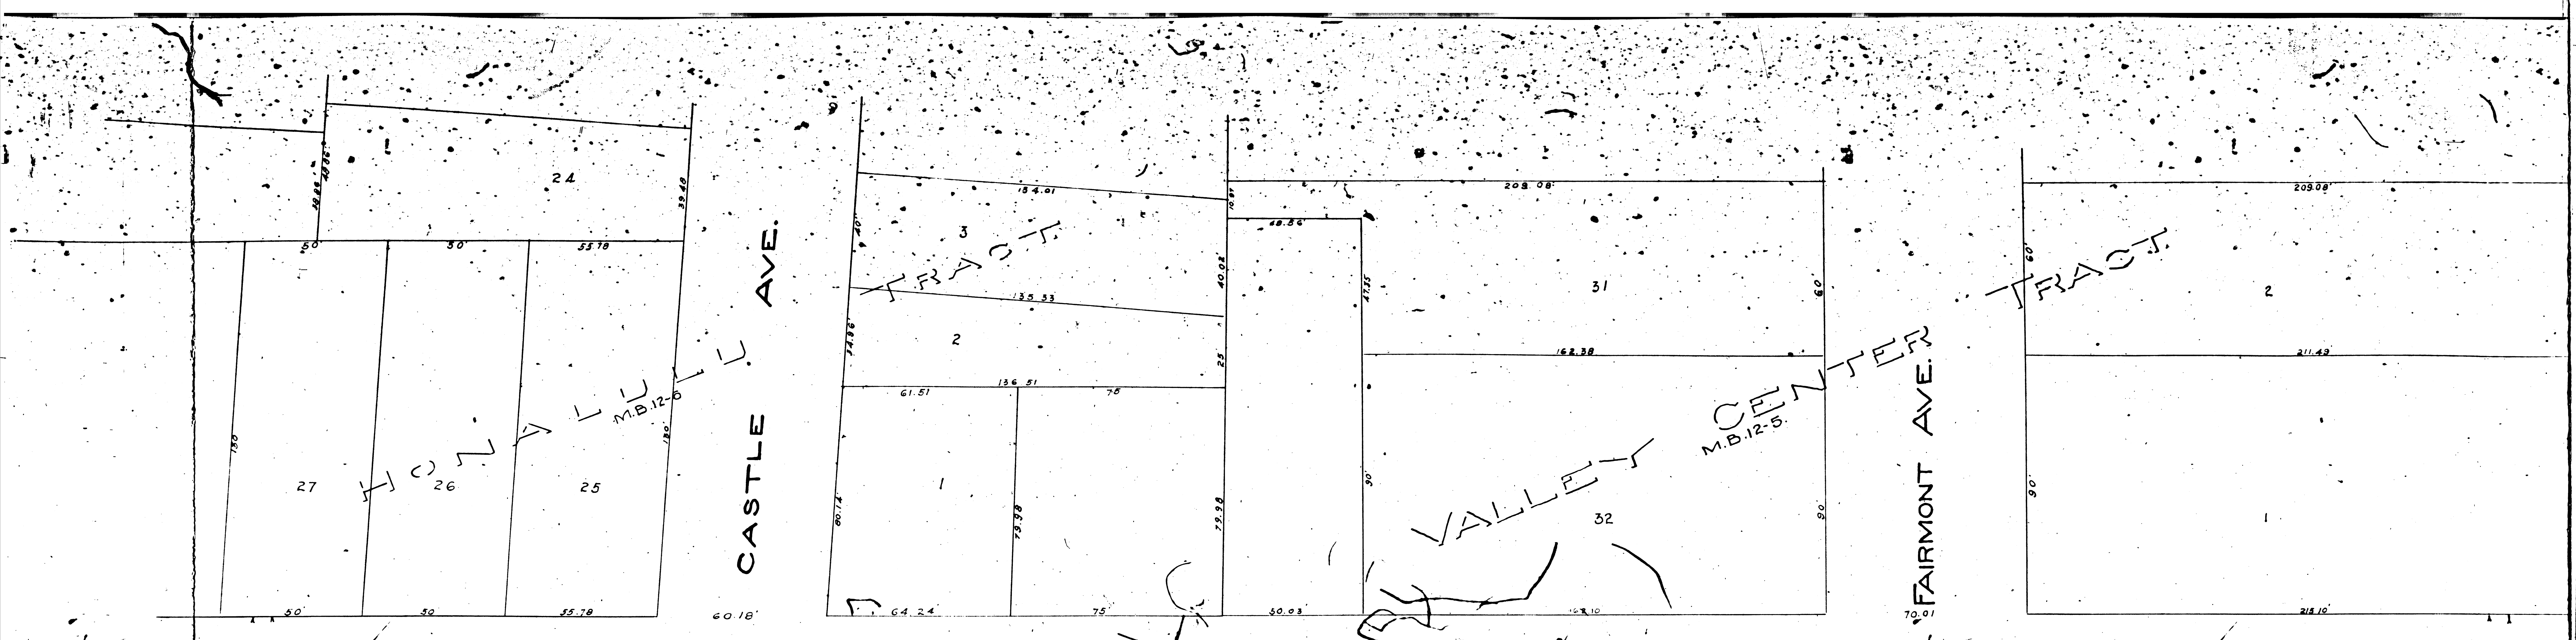

FAX 11 7 318 8
 10

LOS OLIVOS

PALOMA AVE.

TRACT No 2

HIGHLANDS AVE.

KENILWORTH

EAGLE ROCK COLORADO ROAD

R.R. to City of L.A. - B.P. 11, C.R. 35070-85

COLORADO

EAGLE ROCK


PEARL ST.


GLEN EYRIE AVE.

HIGHLAND AVE.

FM 1173188


ALL OF A 4

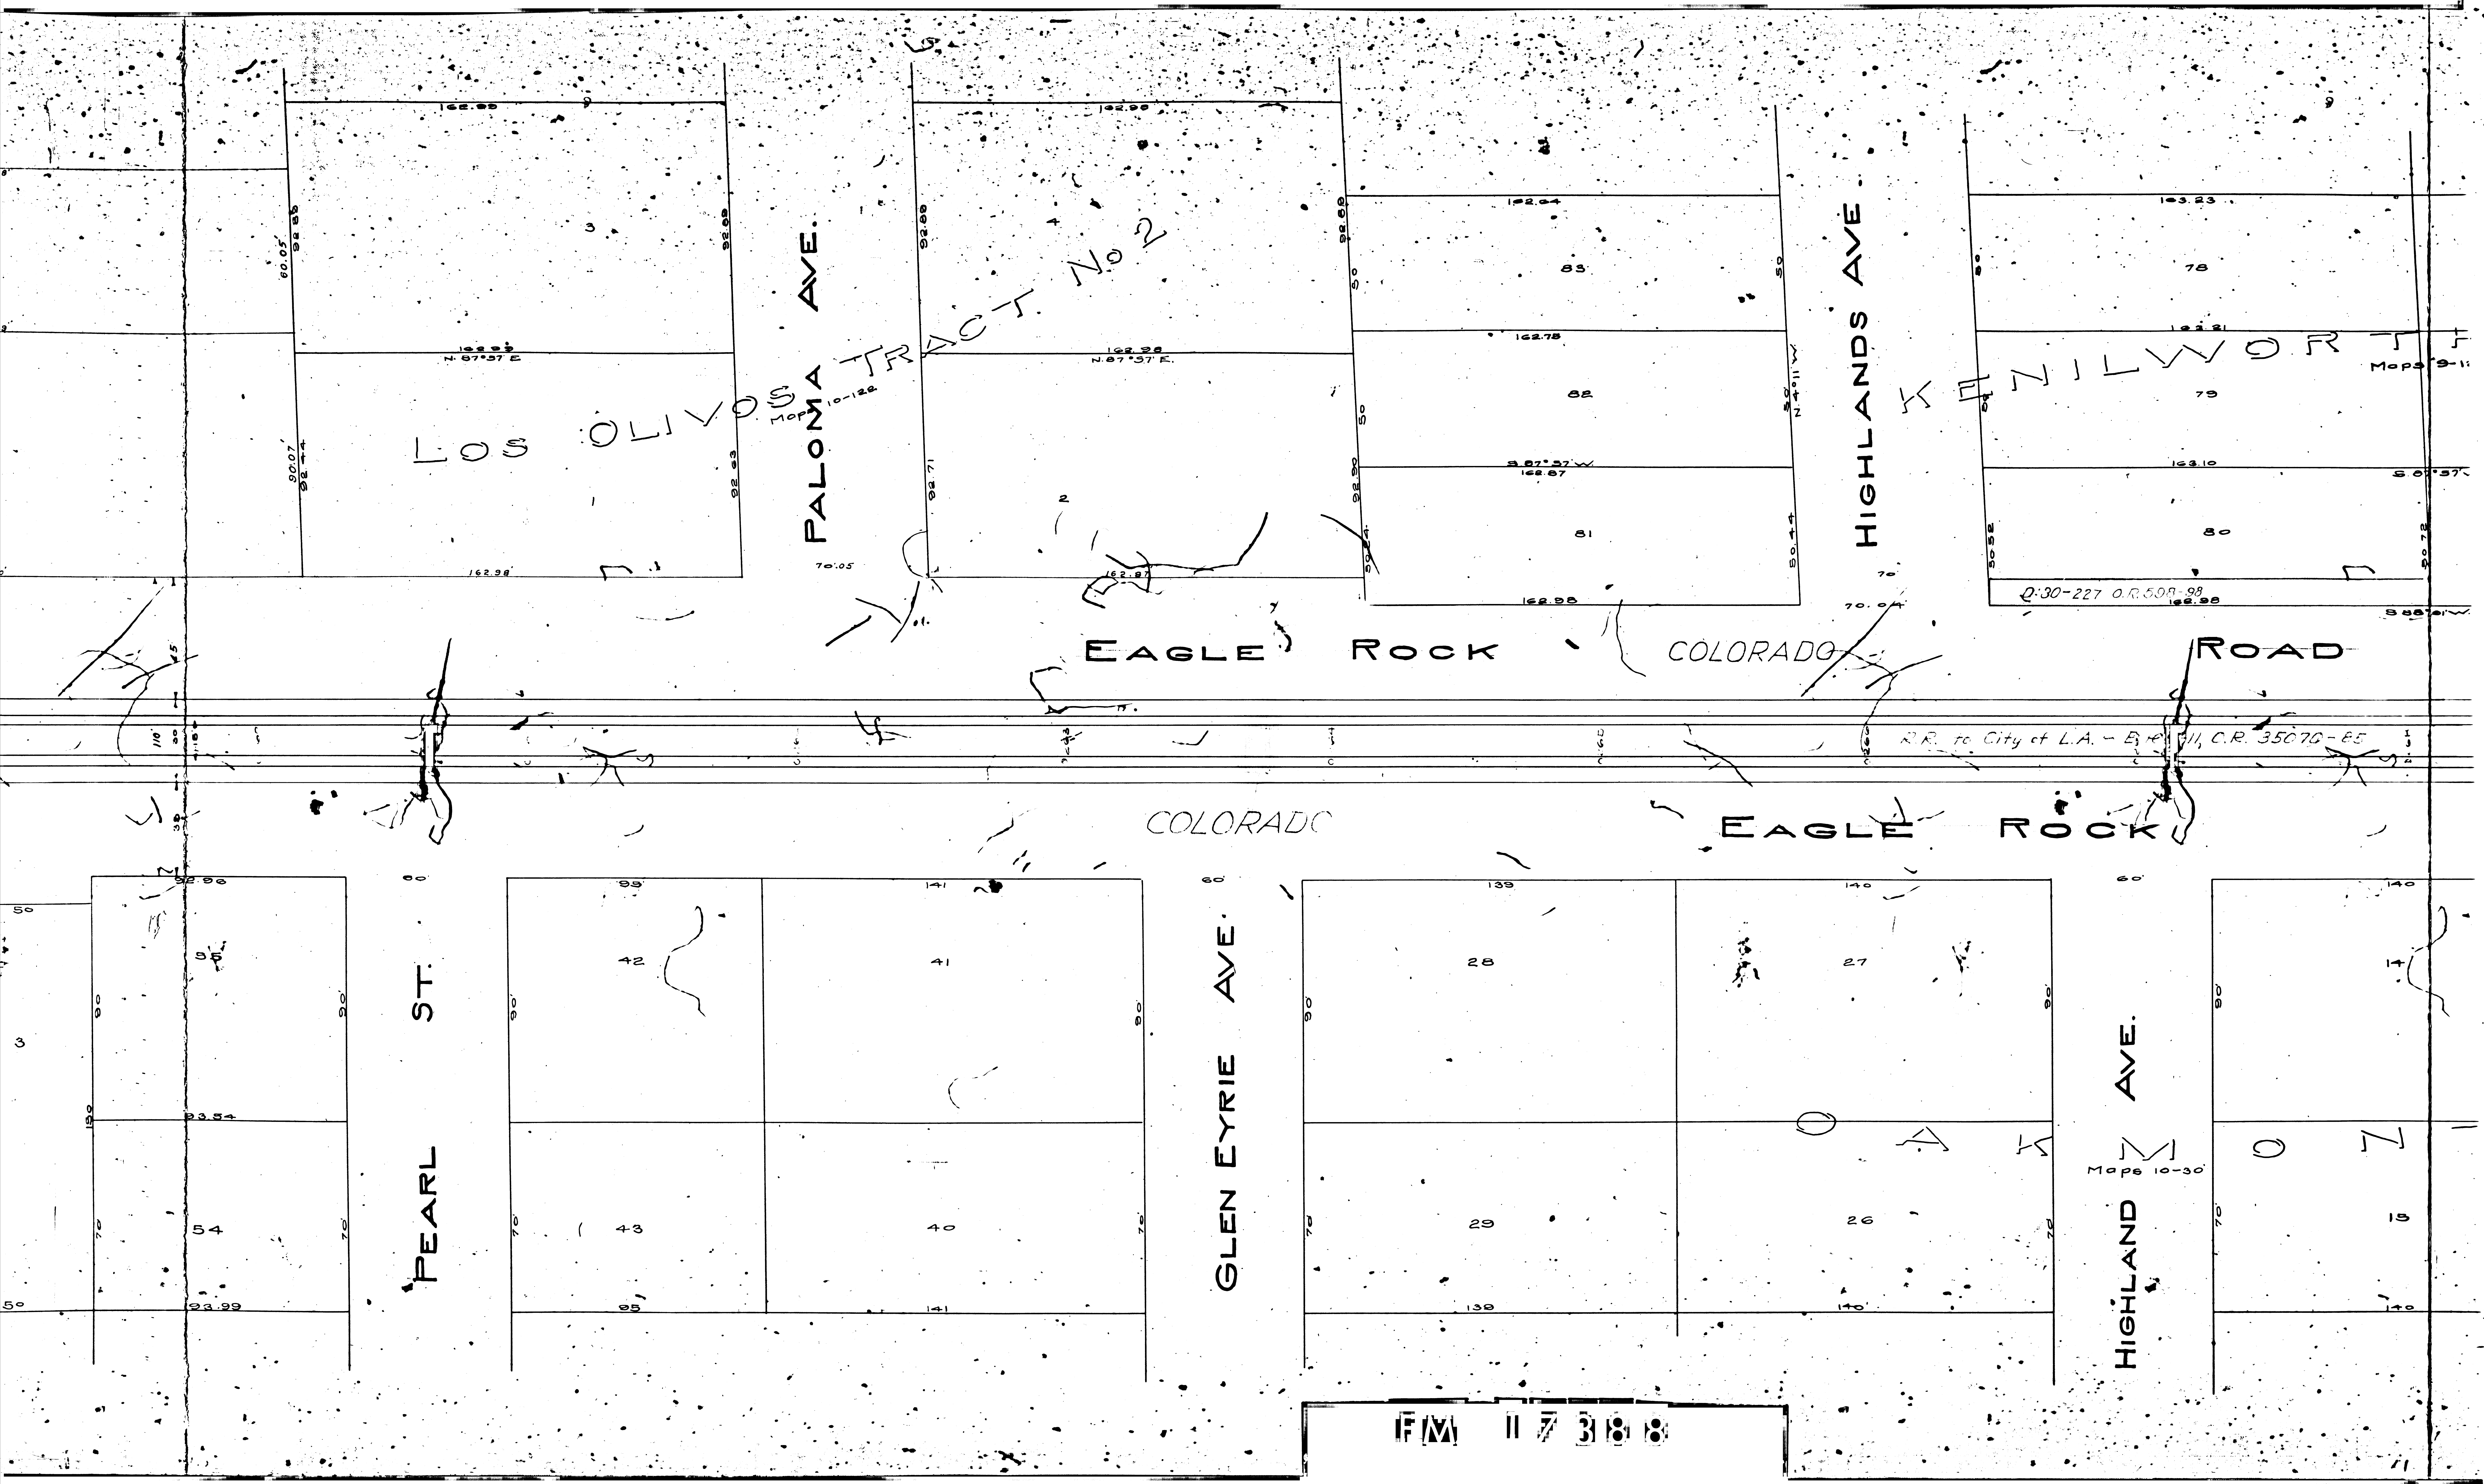

 


No. 3
2.


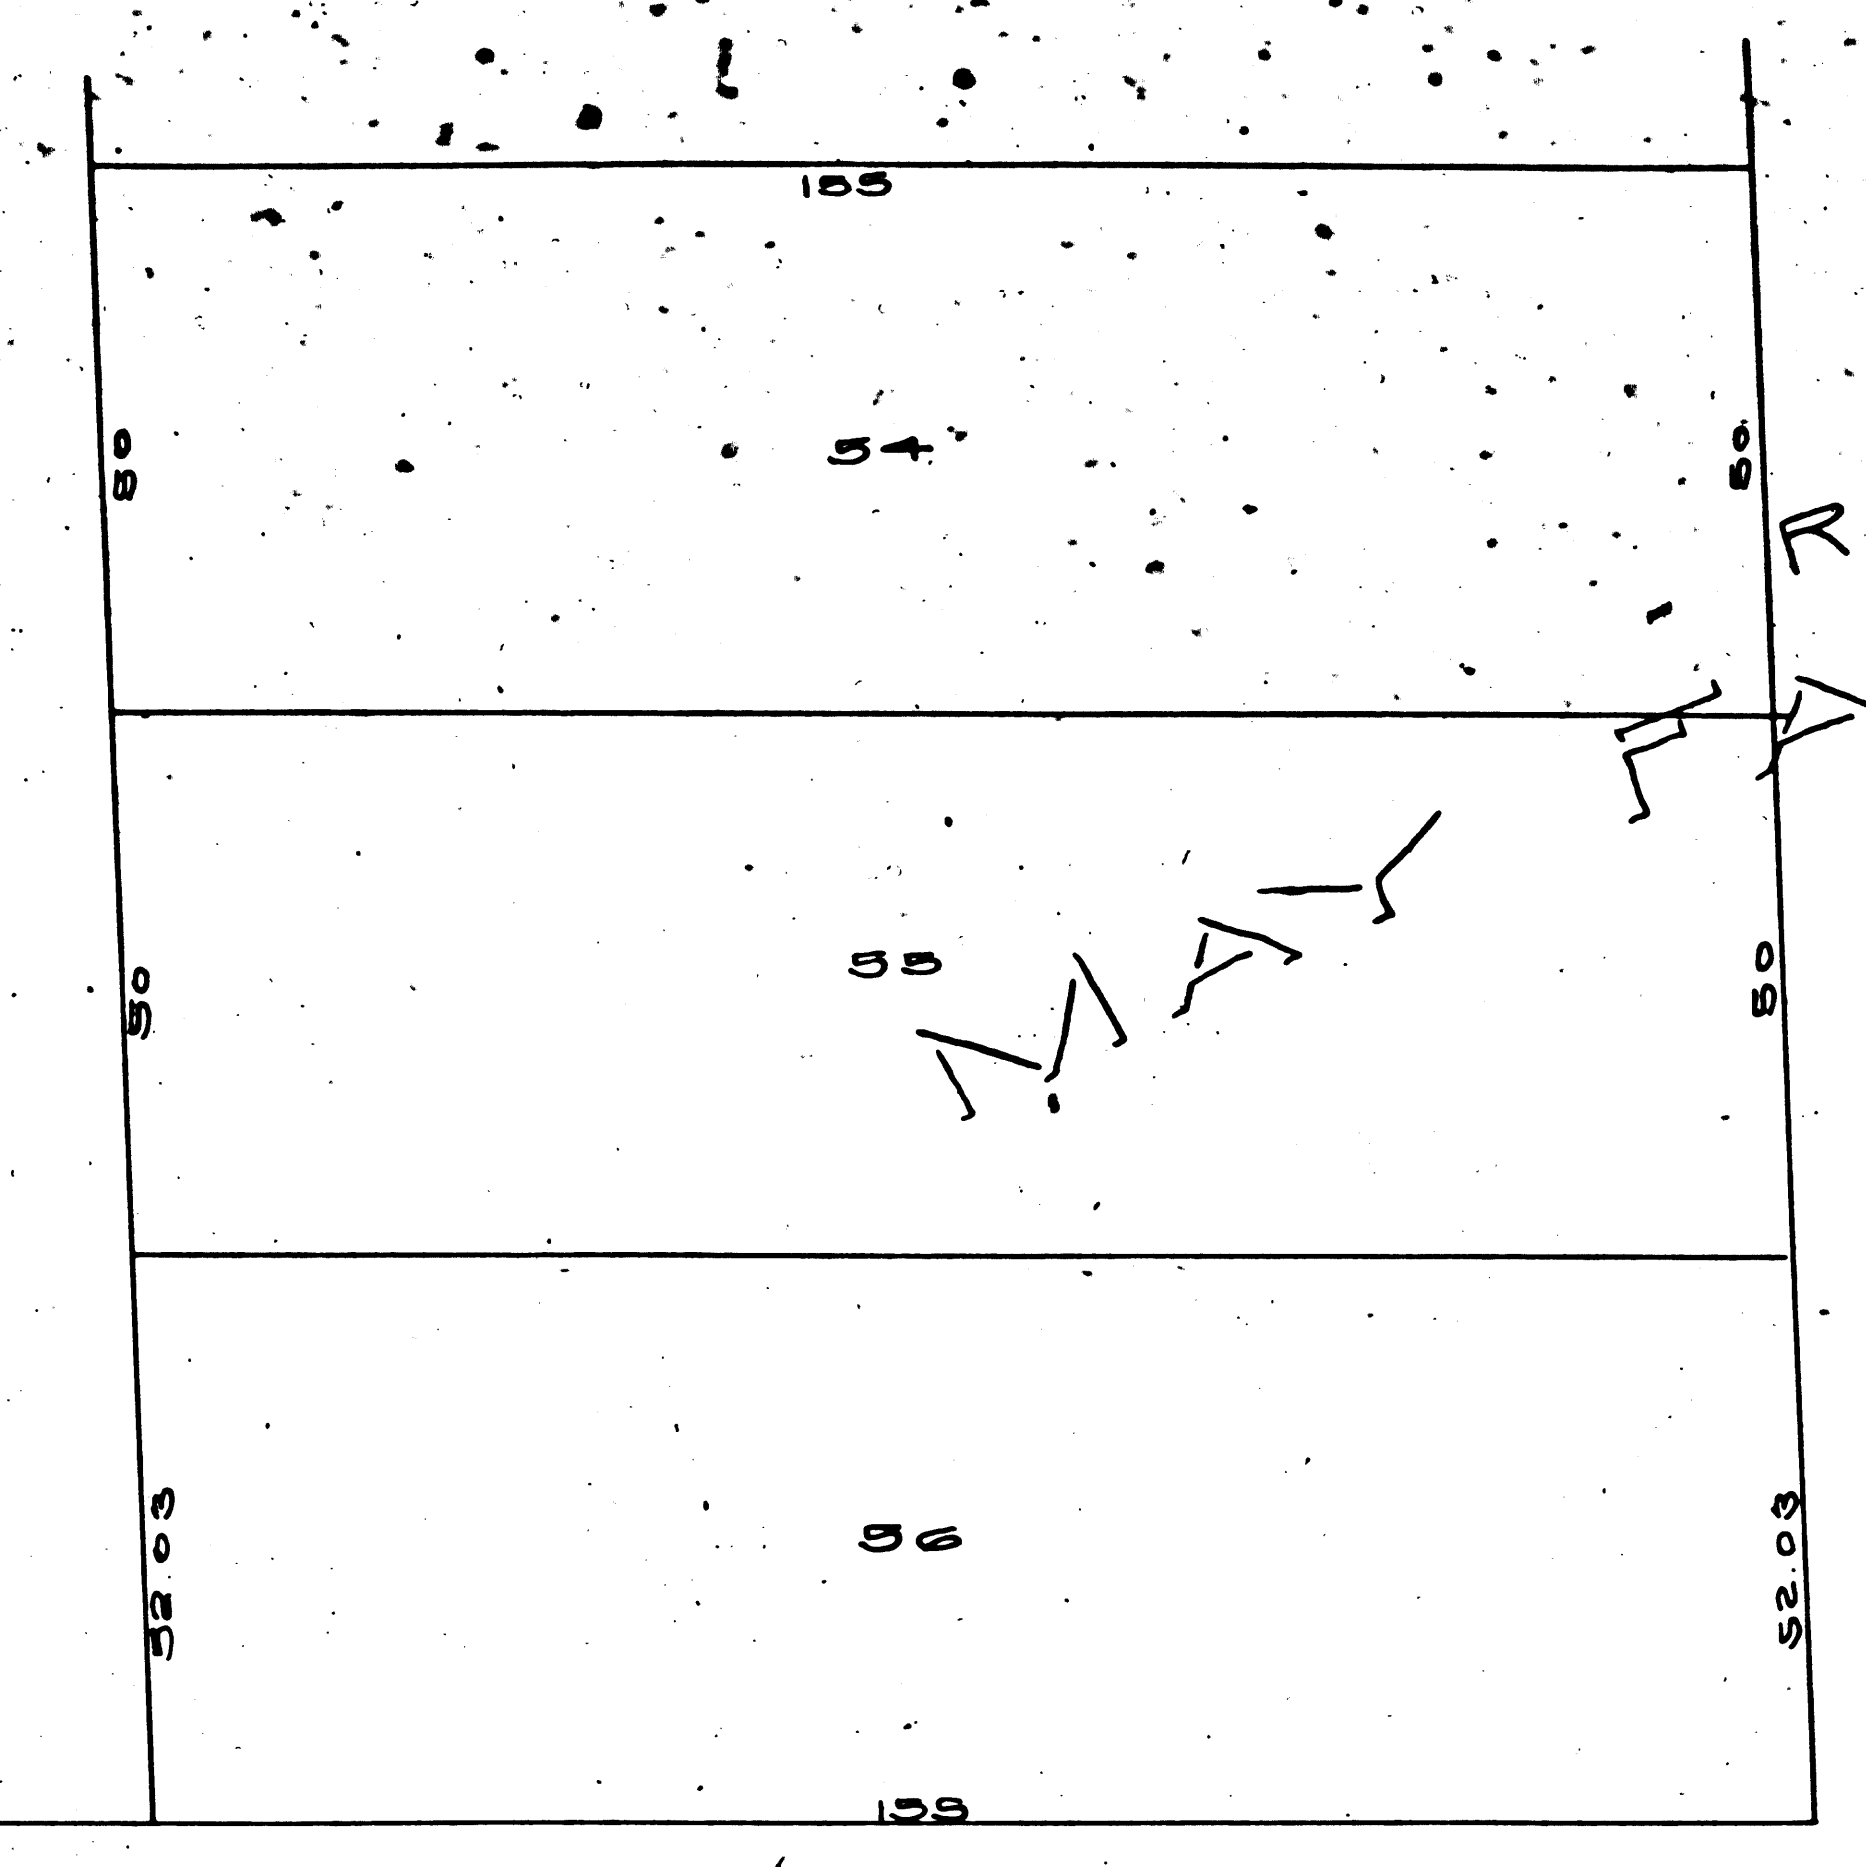


RE. SUB OF
FAIR PARK TRACT
Map 11-1

DRIVE.

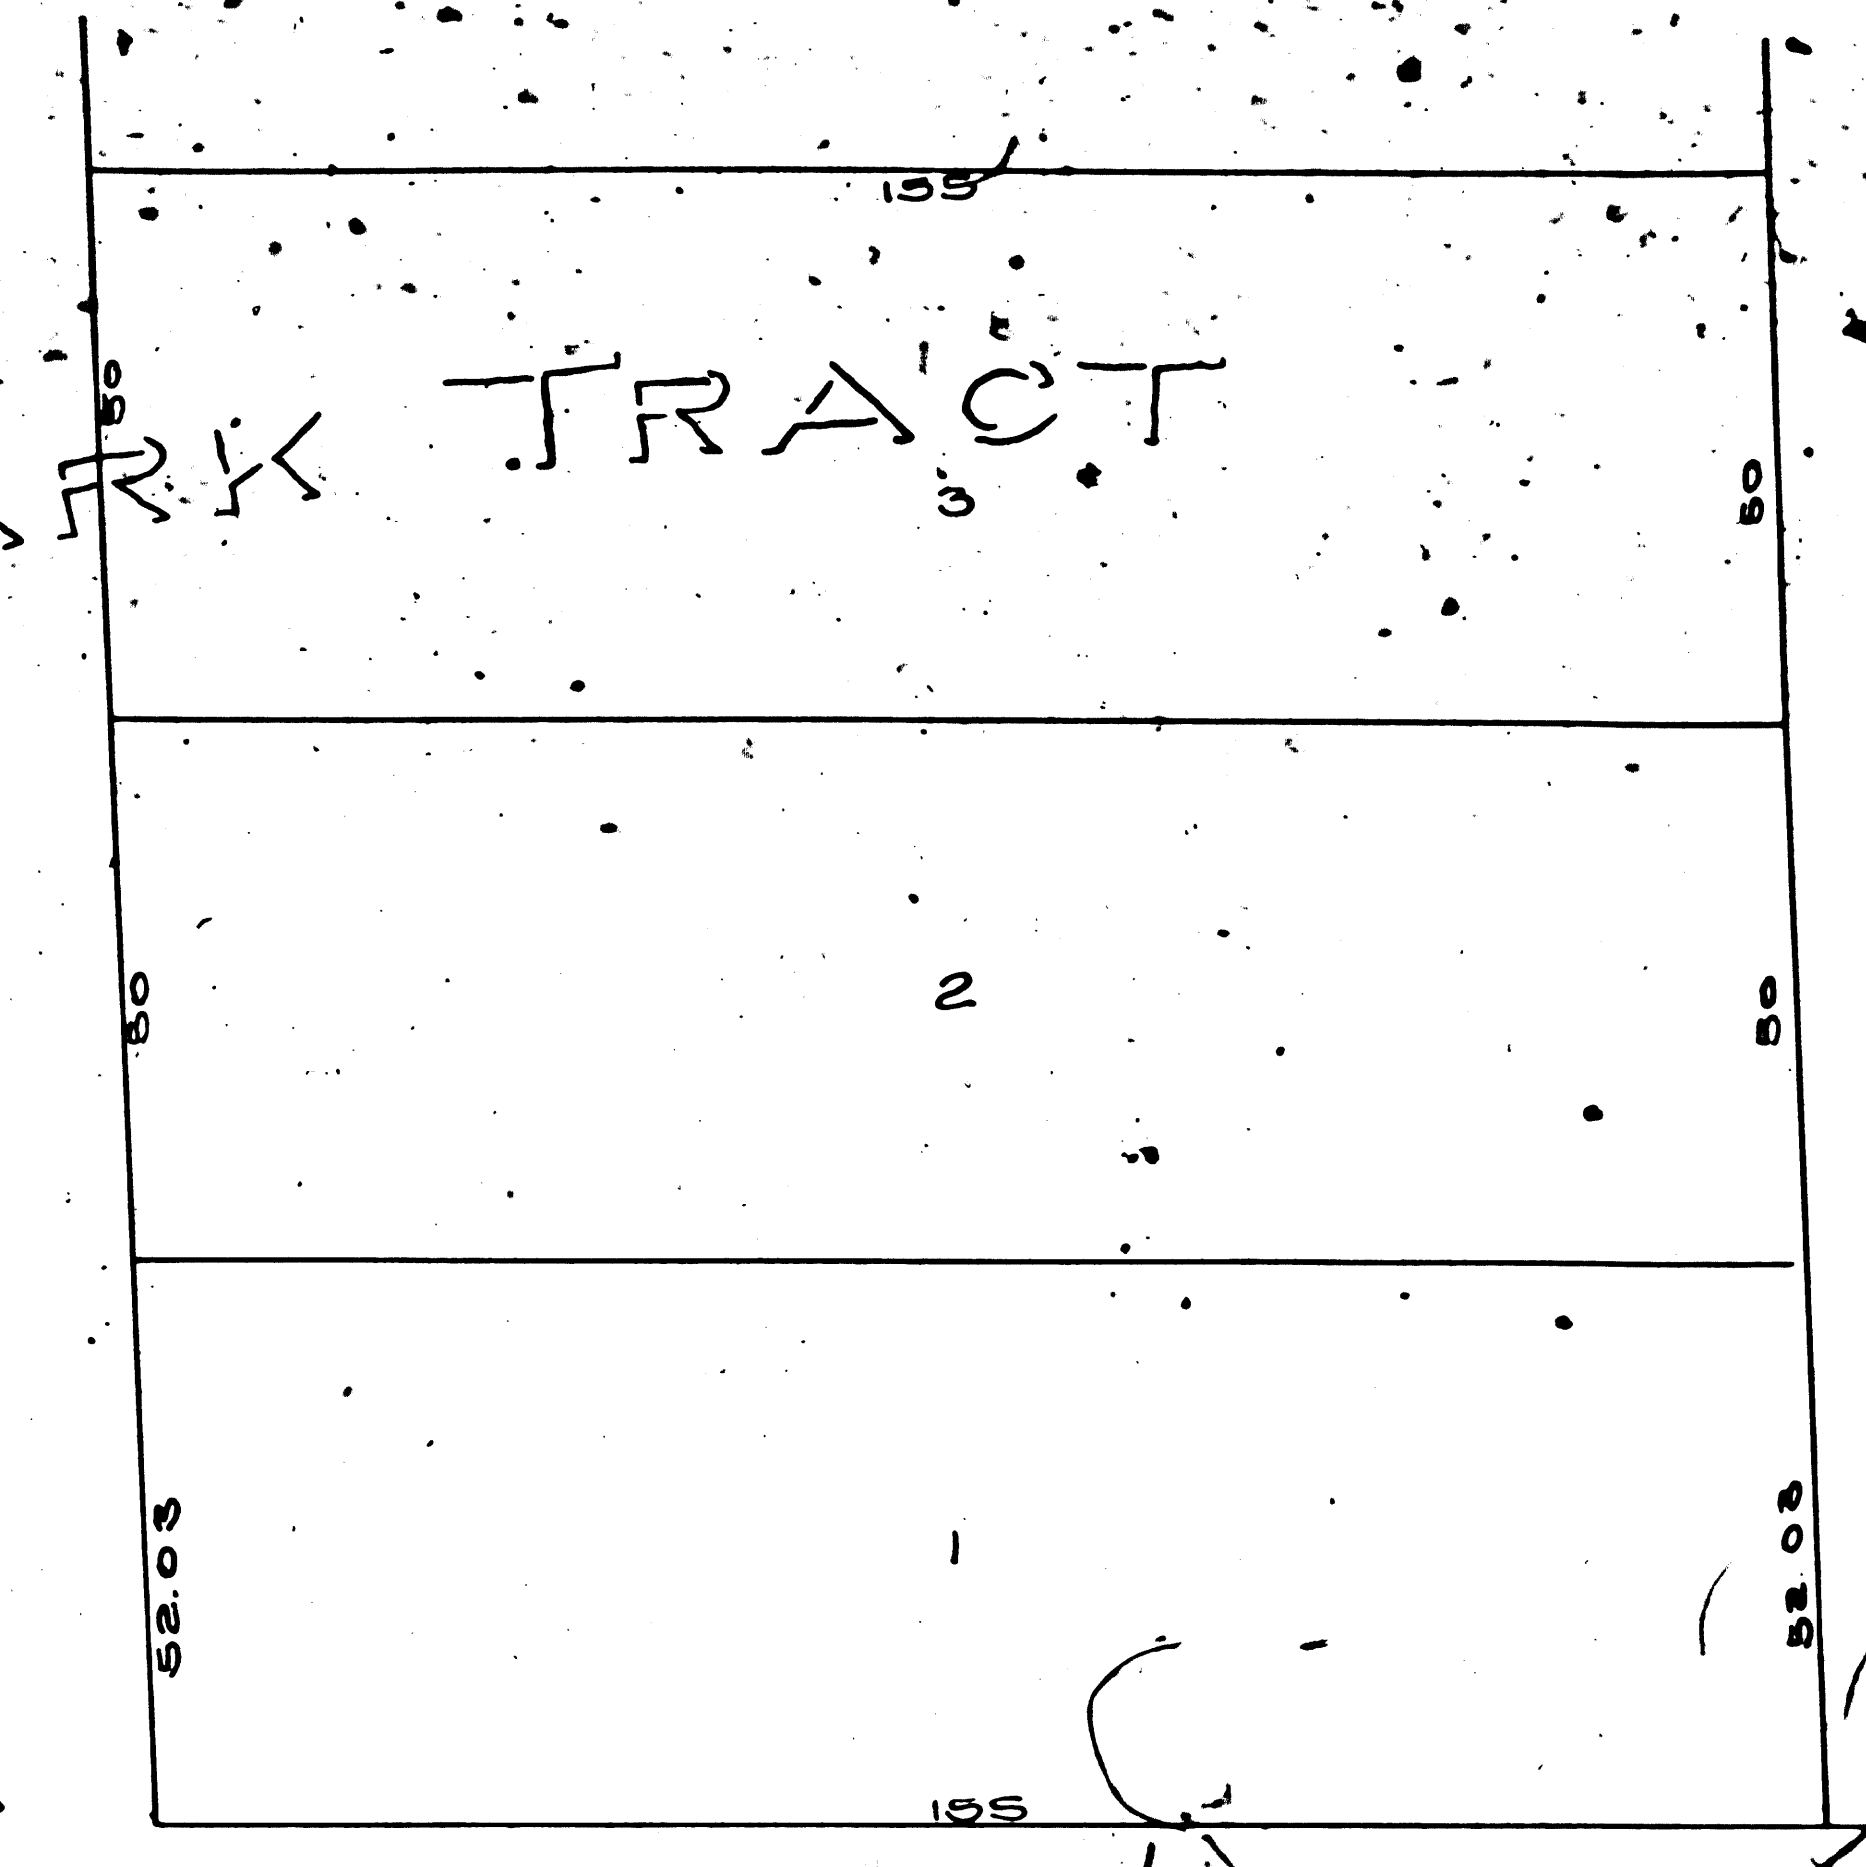


F.L.A. 105-11, DP 35070-PS

SATSUMA AVE.

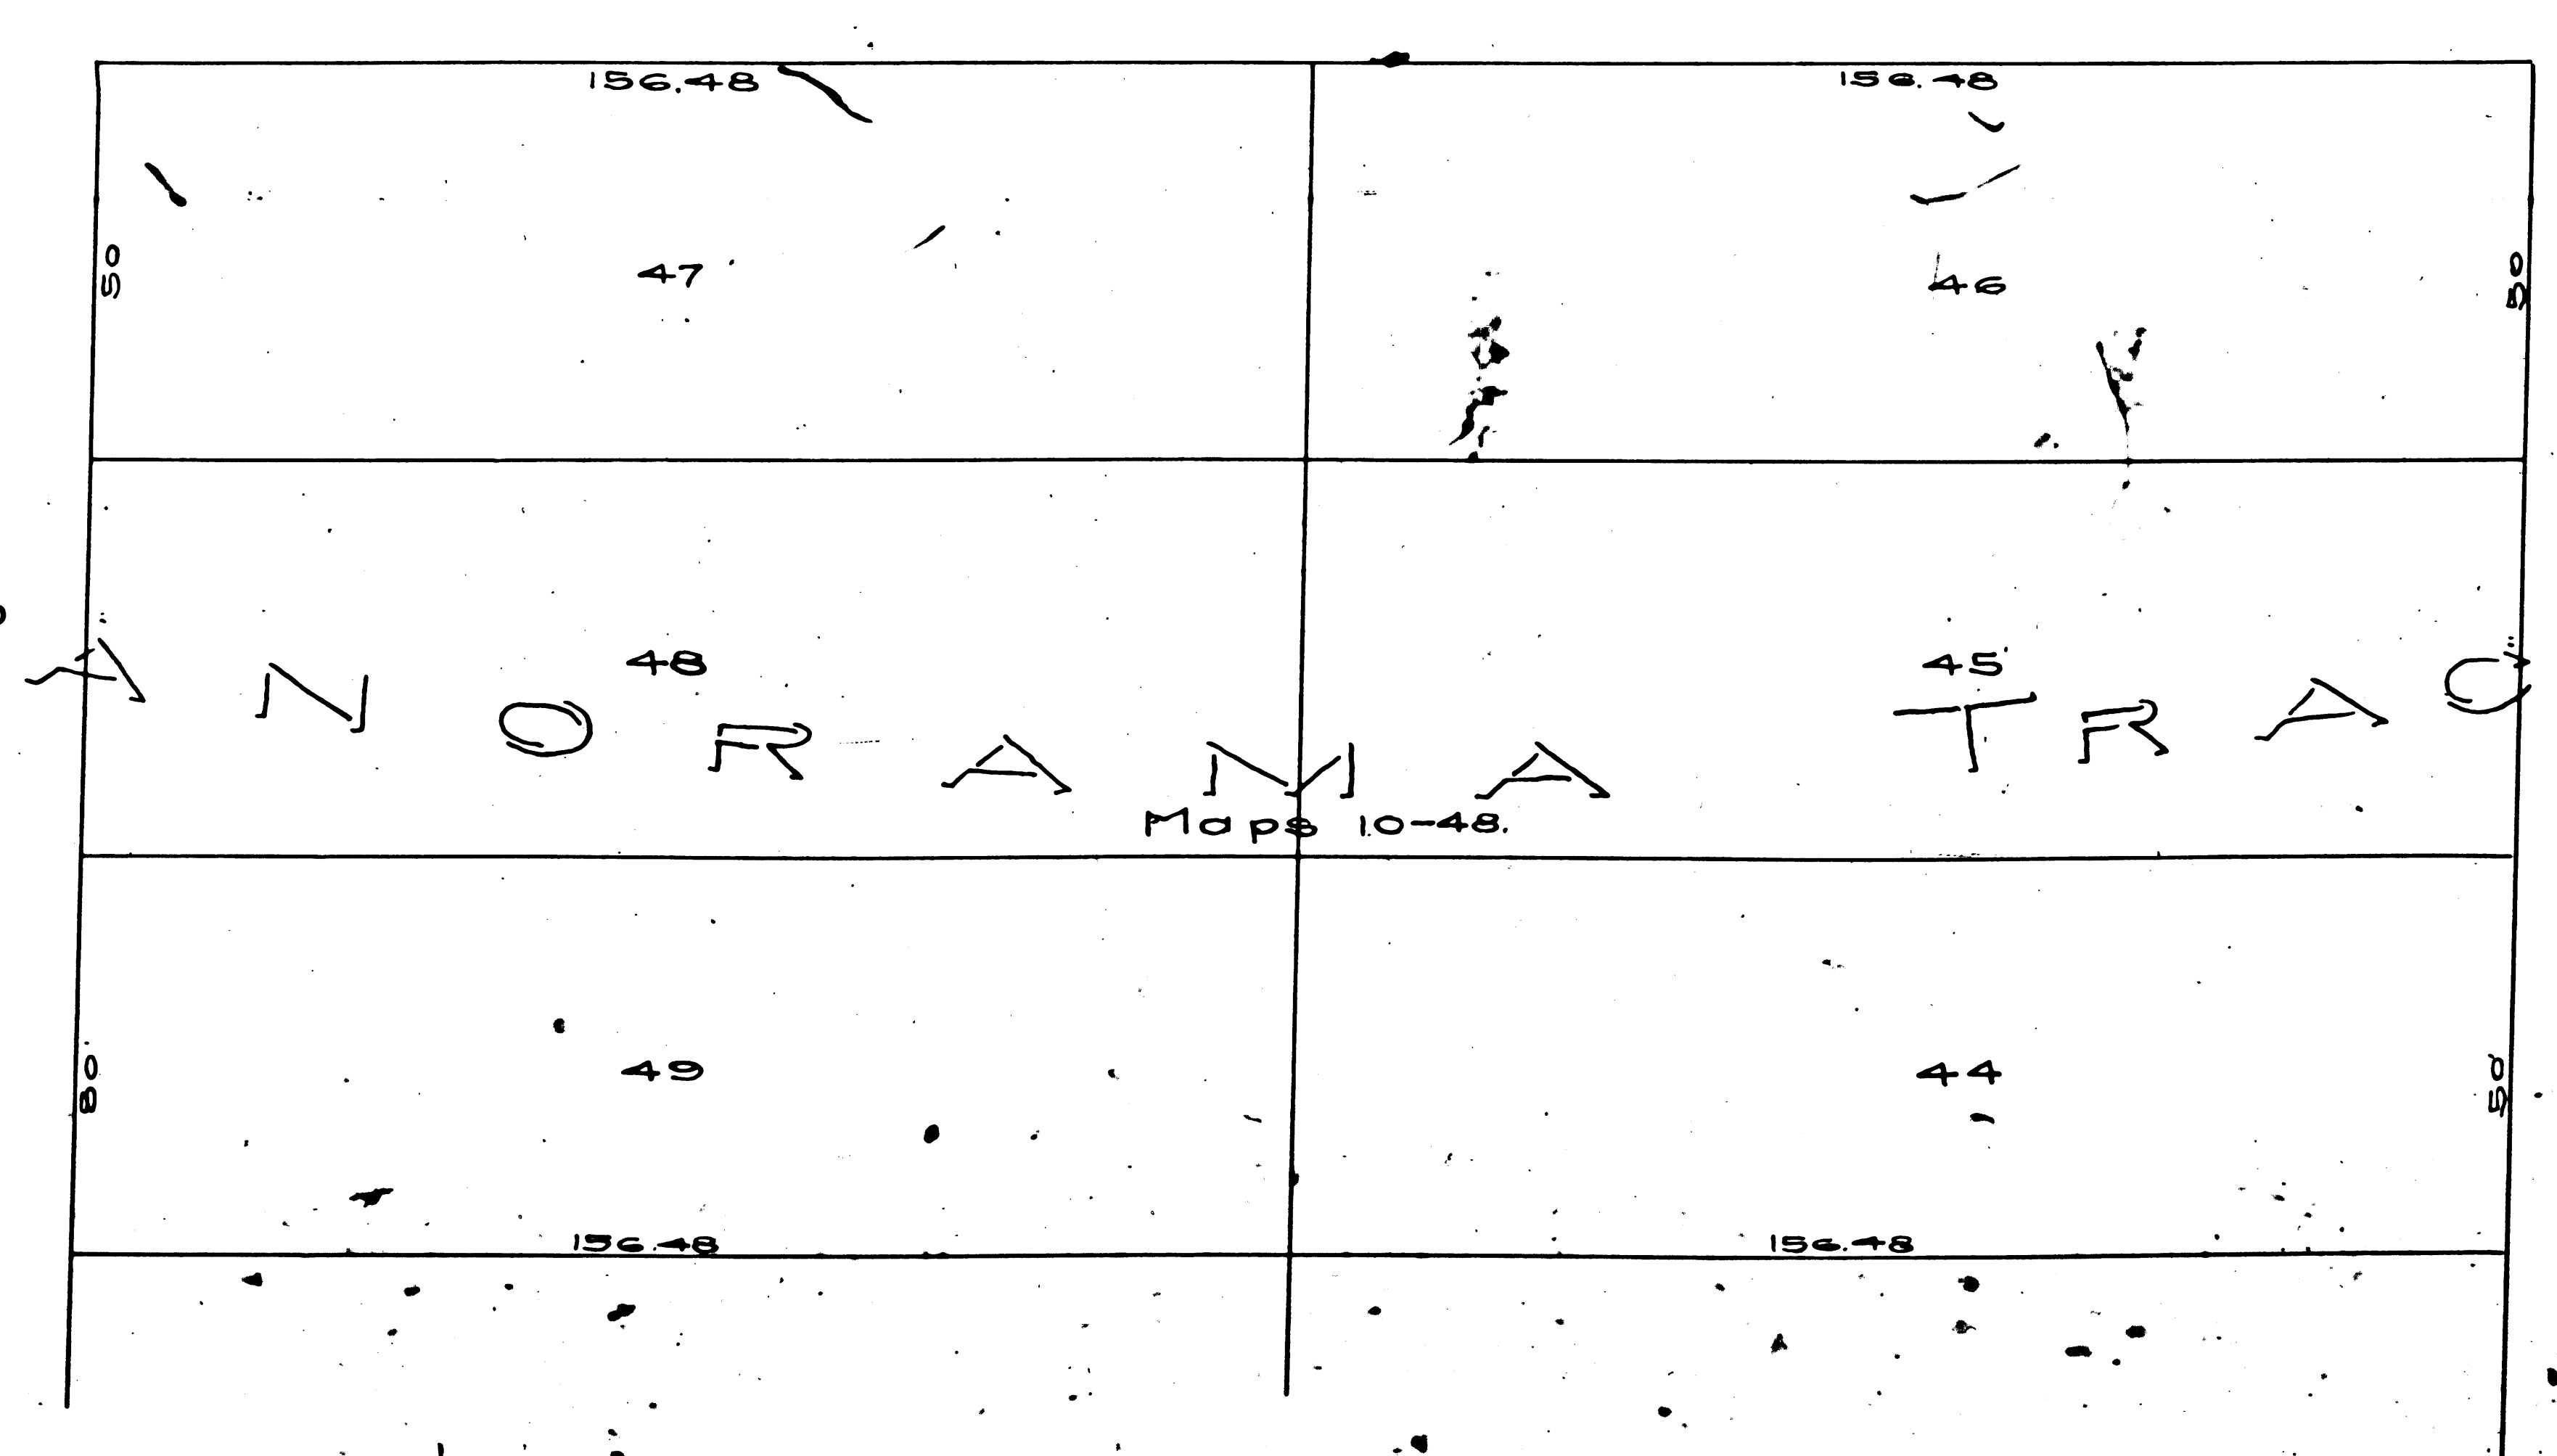


Map 10-48

ROYAL

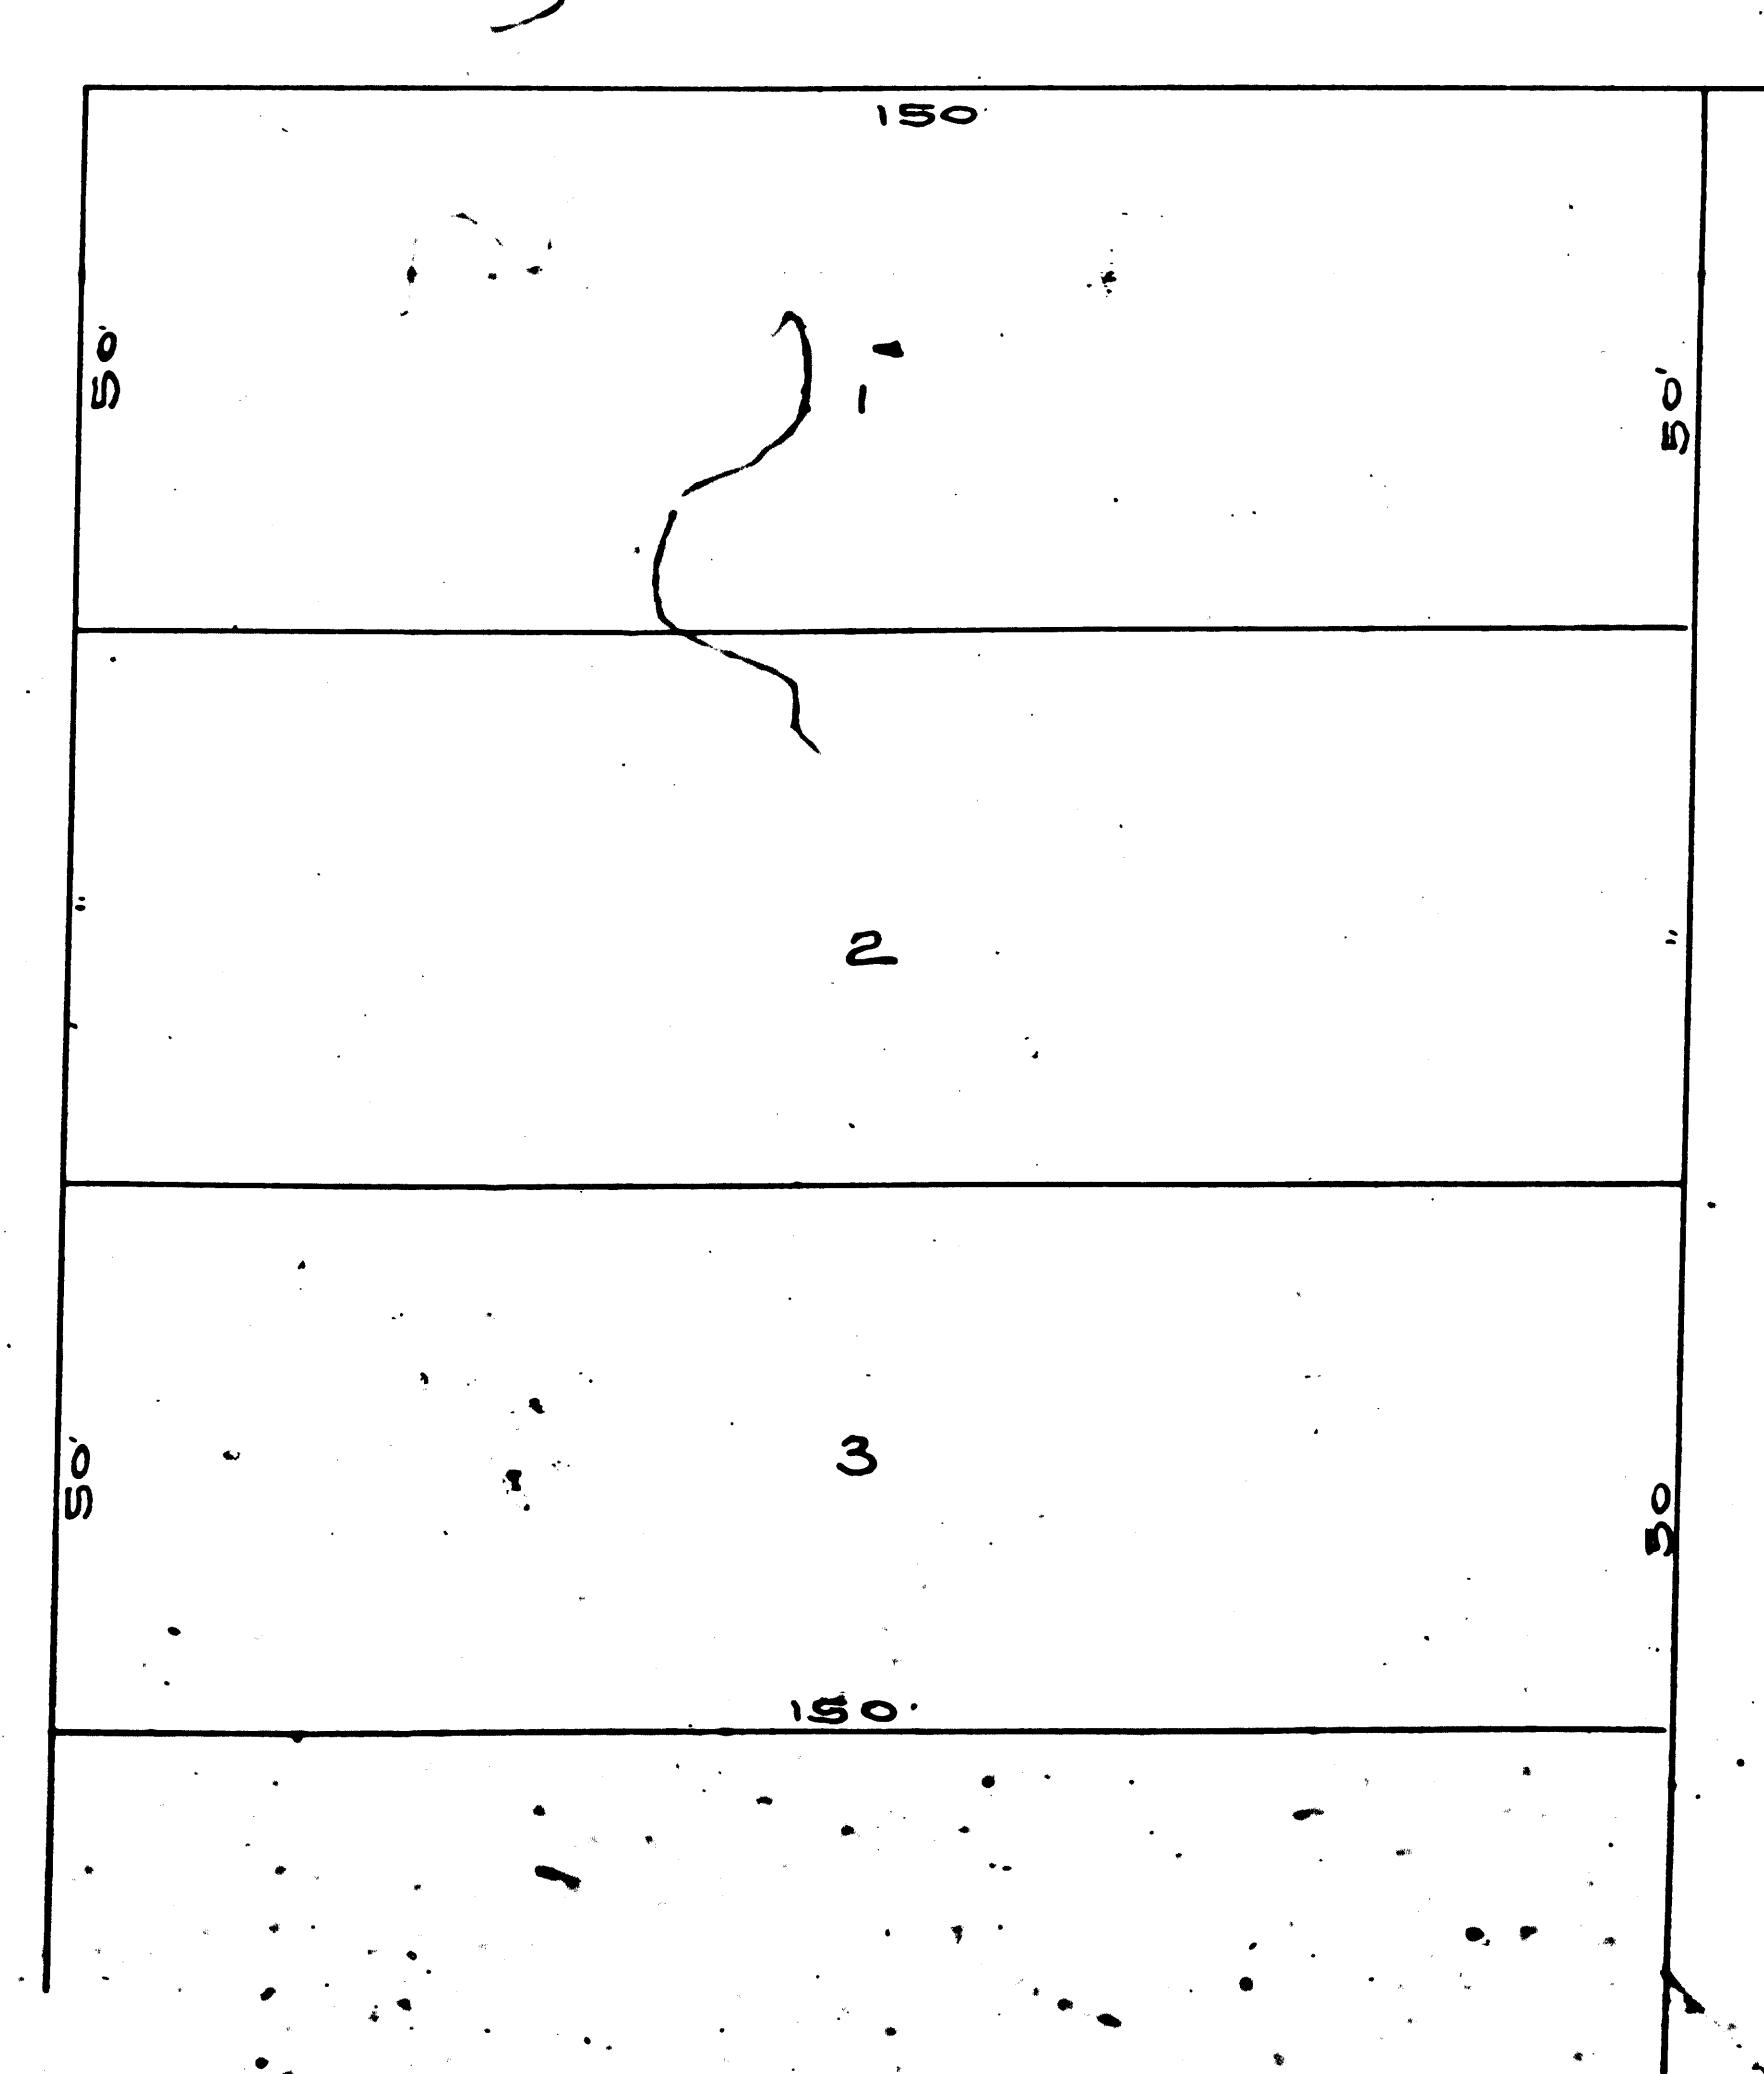

F/M 11 7 318 8

A 1 1 1 1 1 1

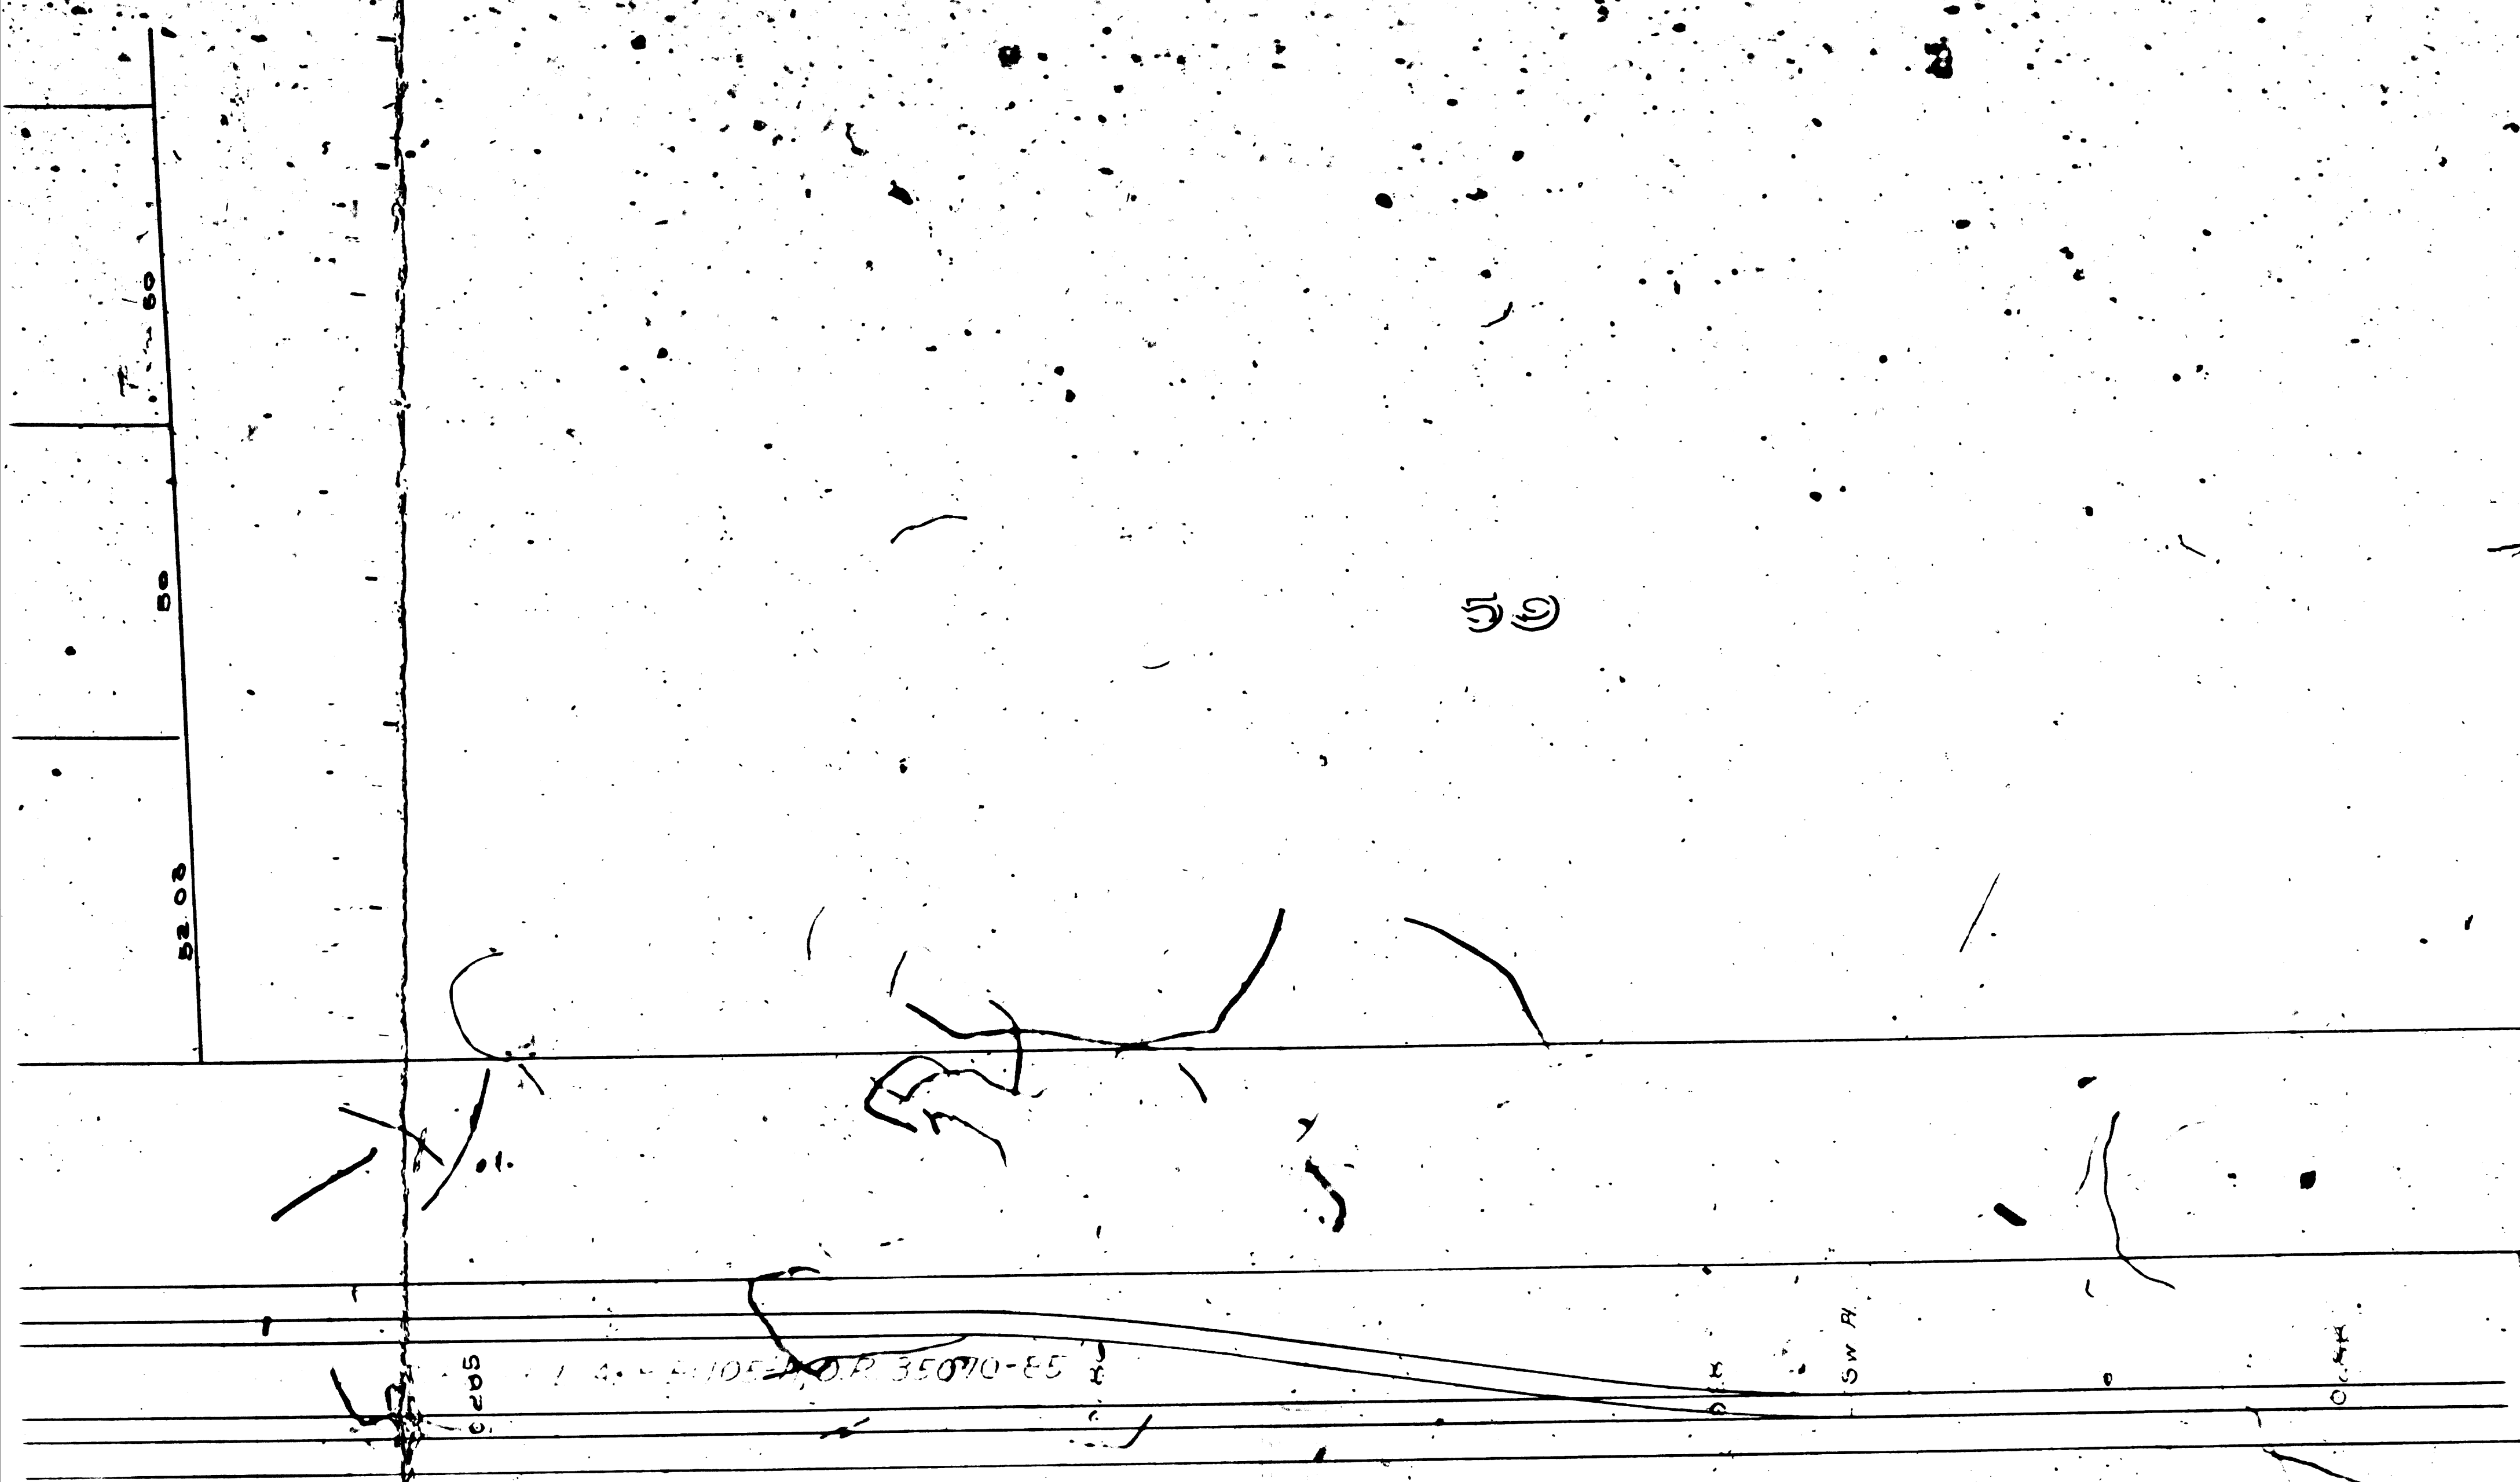

LOS ANGELES RAILWAY COMPANY
EAGLE ROCK DIVISION
TRACK MAP No 3
From Sta 185+00 to Townsend Ave.
Scale: 1"=30' Field Book 131 pp 18-28 Jan. 26th 1907.

431.53

TOWNSEND AVE.

F 11 7 3 8 8
A 11 4 OF A 11 4