


POMONA CITY LINES  
**TRACK MAP OF GAREY AVE.**  
 LOS ANGELES INTER-URBAN RY CO.


Scale 1" = 50' April 11, 1910

WEST TRACK (S. Bound)						EAST TRACK (N. Bound)					
Date Laid	Lin. Ft.	Sta.	To Sta.	Rail Sec.	Ties	Date Laid	Lin. Ft.	Sta.	To Sta.	Rail Sec.	Ties
Nov. 25-07	657	3+00	9+57	70&ASCE		Nov. 27-07	432	17+48	28+00	70&ASCE	
" 26 "	287	0+33	3+00			" 28 "	1418	22+00	36+18		
Dec. 2 "	1185	18+72	30+60			" 29 "	1121	36+18	47+39		
" 3 "	693	30+60	37+33			" 30 "	1694	47+39	64+33		
" 4 "	264	16+08	18+72			Dec. 2 "	638	64+33	71+38		
" 5 "	3269	37+33	70+1773			" 3 "	564	3+93	9+57		
July 1-09	Standard Crossover 24+03.7 to 24+24.70					" 9-09	33	3+60	3+93		
Nov. 16-09	248	10+40	12+88	72&6 T.	6&8 R.W.M.H.	" 10-09	1100	72+00	83+00		
" 17 "	269	12+88	14+88	72&6 T.	6&8 R.W.M.H.	" 11-09	62	71+33	72+00		
Feb 27-Mar 1-10	38	Crossing		Man. Sec.	Special Timbers	March 25-10	59	83+00	83+59		
April 10-1910	08	Turnout from W. to S. E. Tr. (North of Willow St.)		70&ASCE		" 30 "	100	0+46	1+46		
" 20 "	89	Standard Crossover North of Ellen St.		70&ASCE		April 1 "	100	9+57	10+57	72&6 T.	6+8+7 R.W.
" 22 "	89	Standard Crossover South of Ellen St.		70&ASCE		" Dec. 13-09	25	64+33	64+99	70&ASCE	
Aug 9 "	33	0+33	0+00	70&ASCE	6+8 R.W.M.H.						

Note: Construction Notes & Stationing shown in red.  
 Stations on preliminary line shown in black.

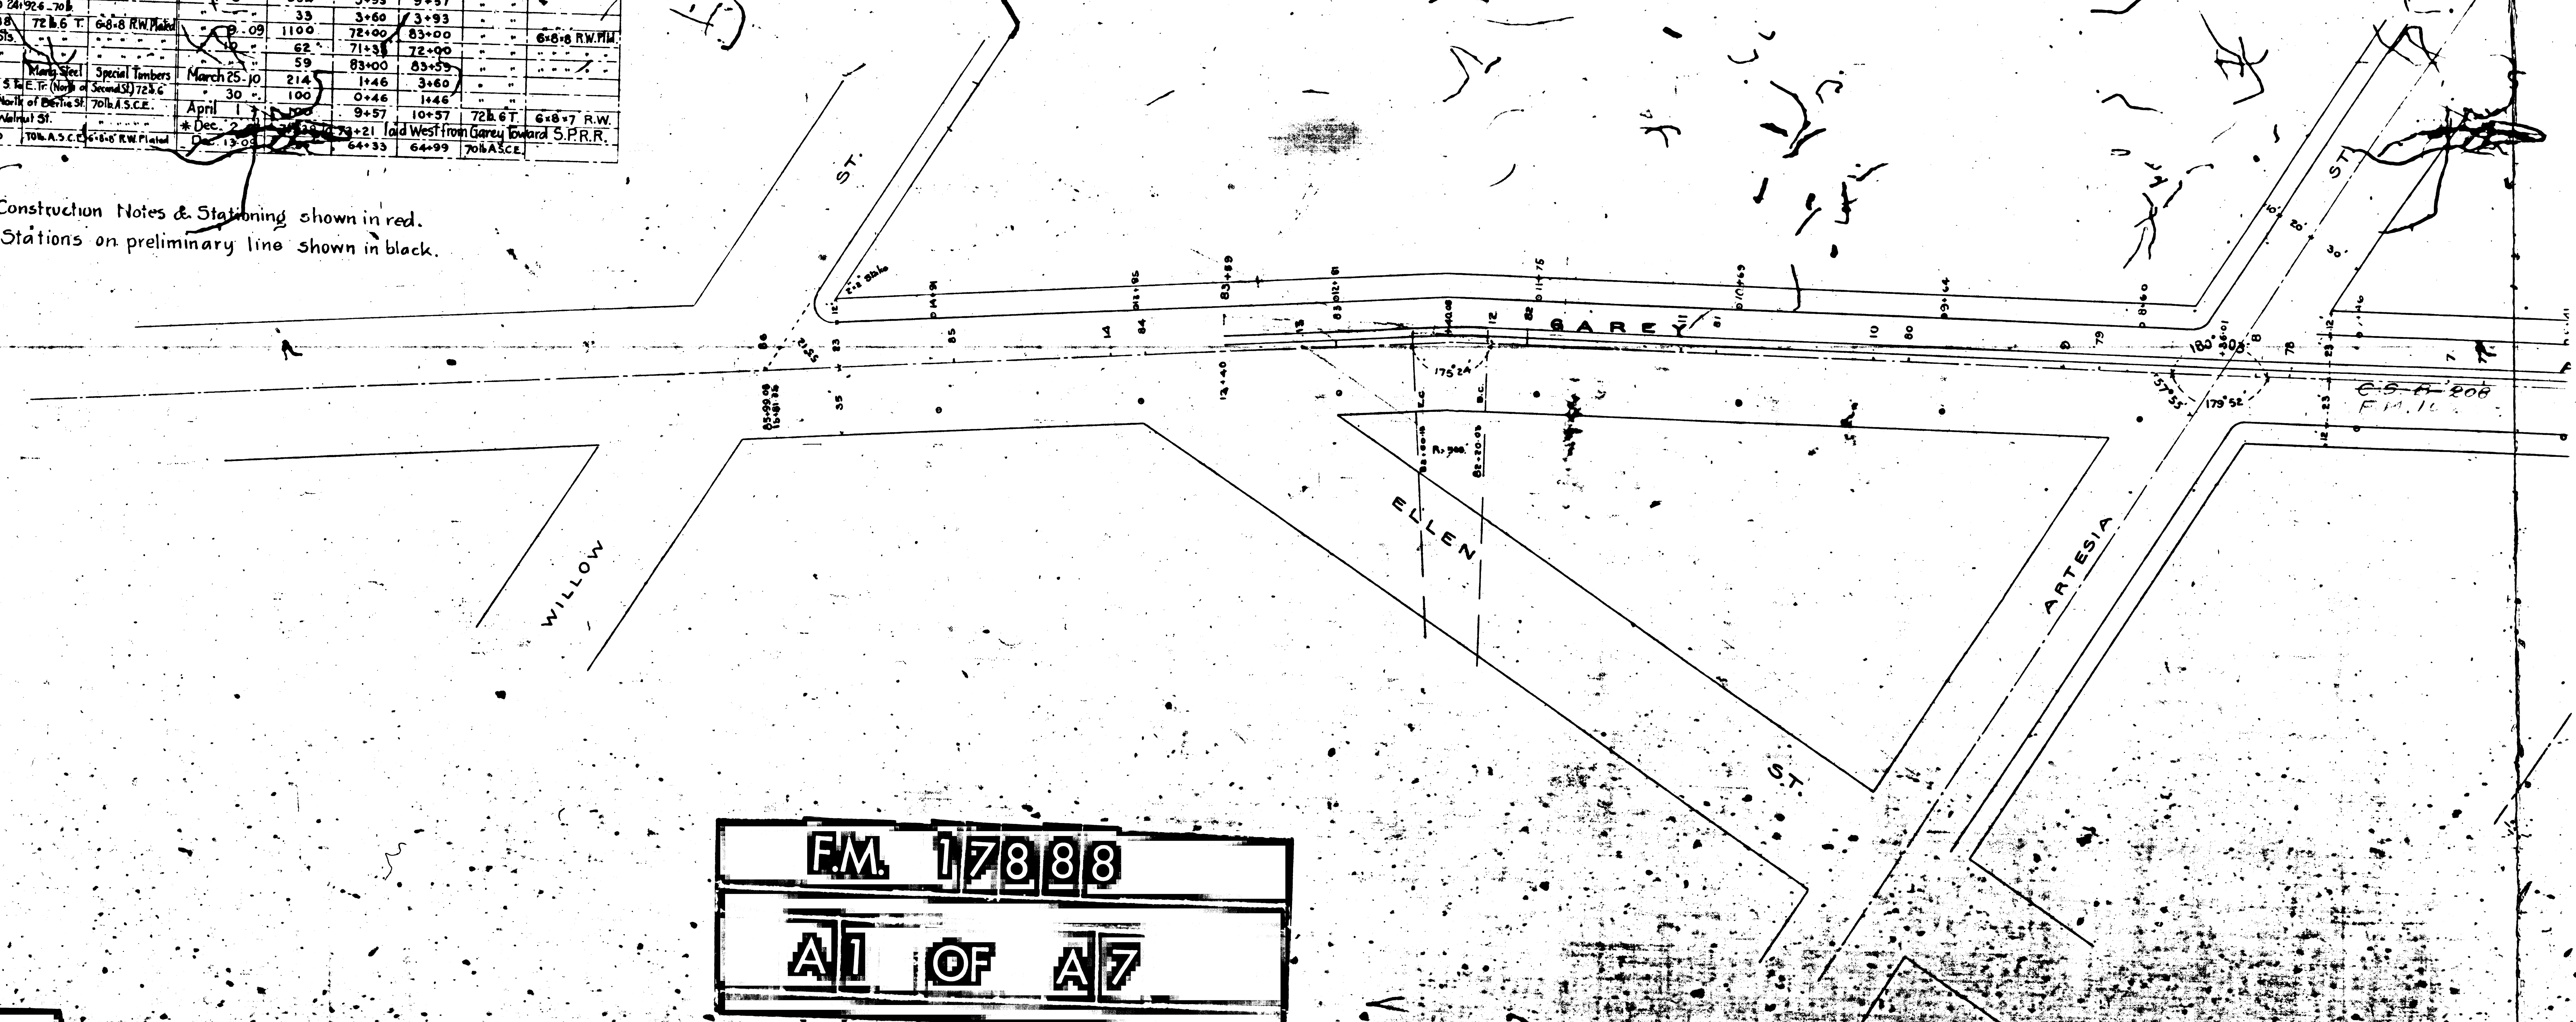

FM 17888  
 A1 OF A7

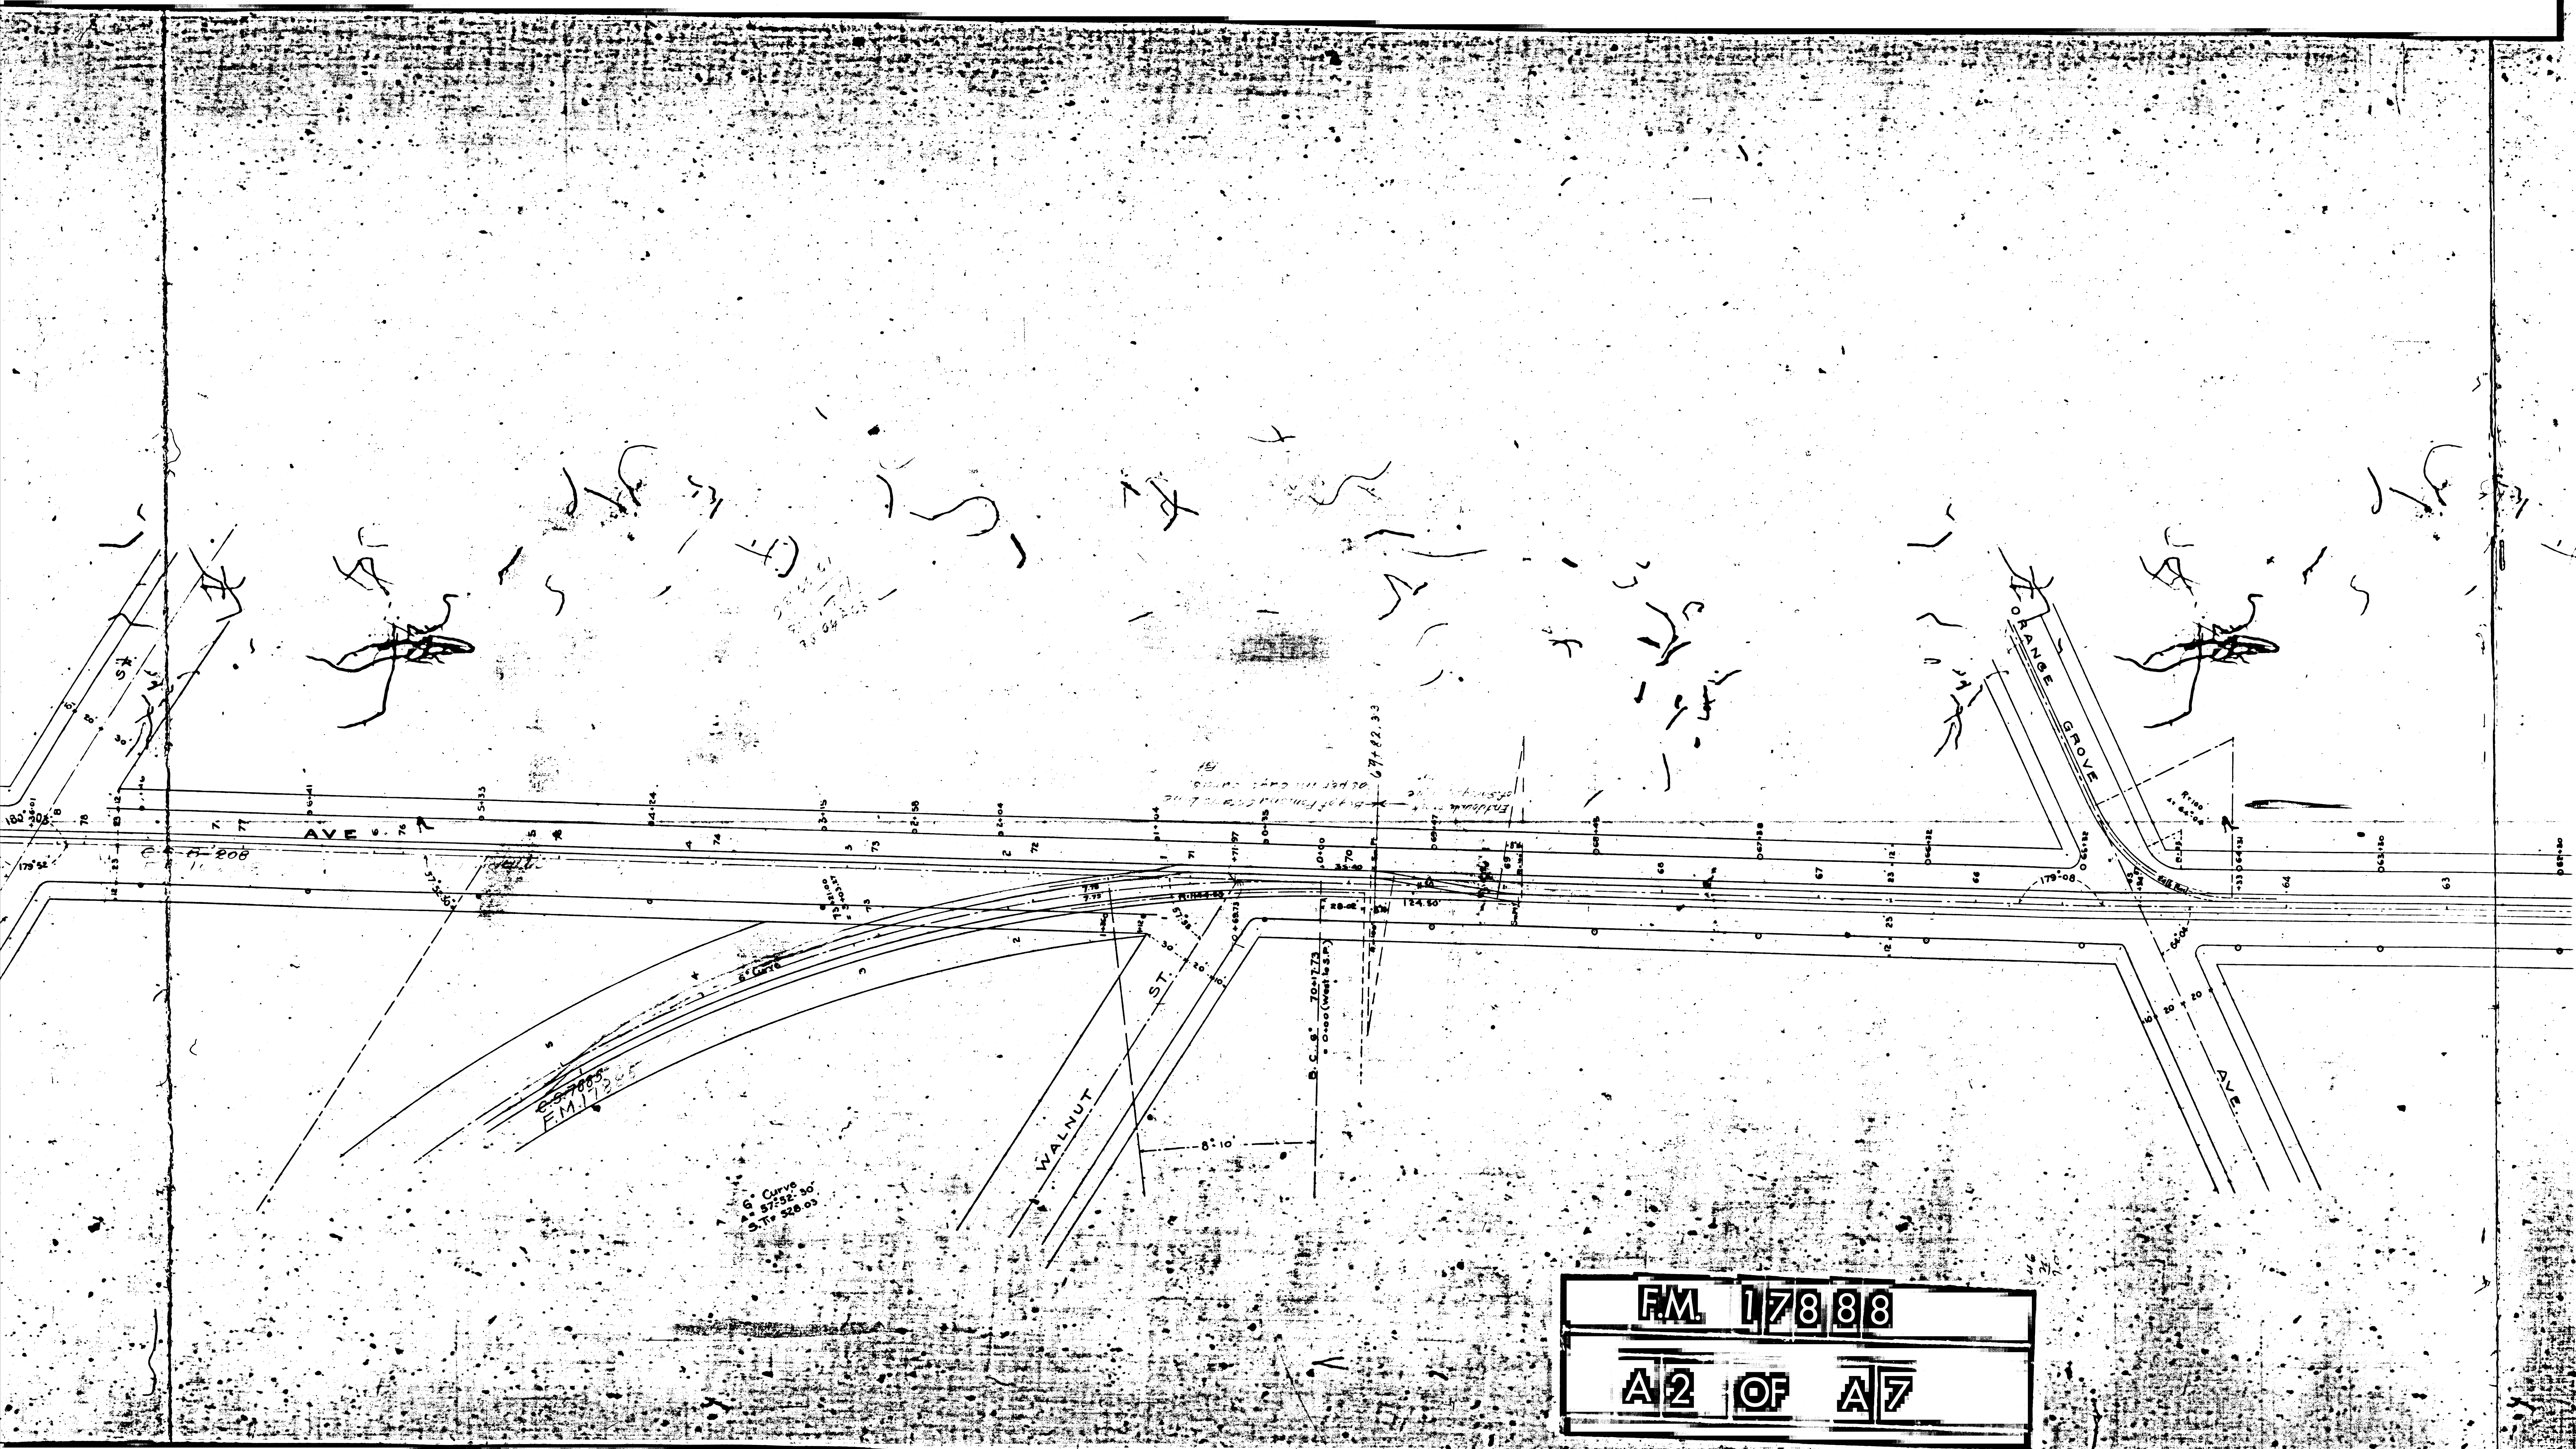

6570.95  
F.M. 17888

6° Curve  
5753.30  
S. Tr. 528.05

WALNUT  
ST.


ORANGE  
GROVE

FM 17888  
A2 OF A7


*Handwritten notes and scribbles, including the word "S" and various illegible marks.*

064140 064141 064142 

FM 17888  
A3 OF A7

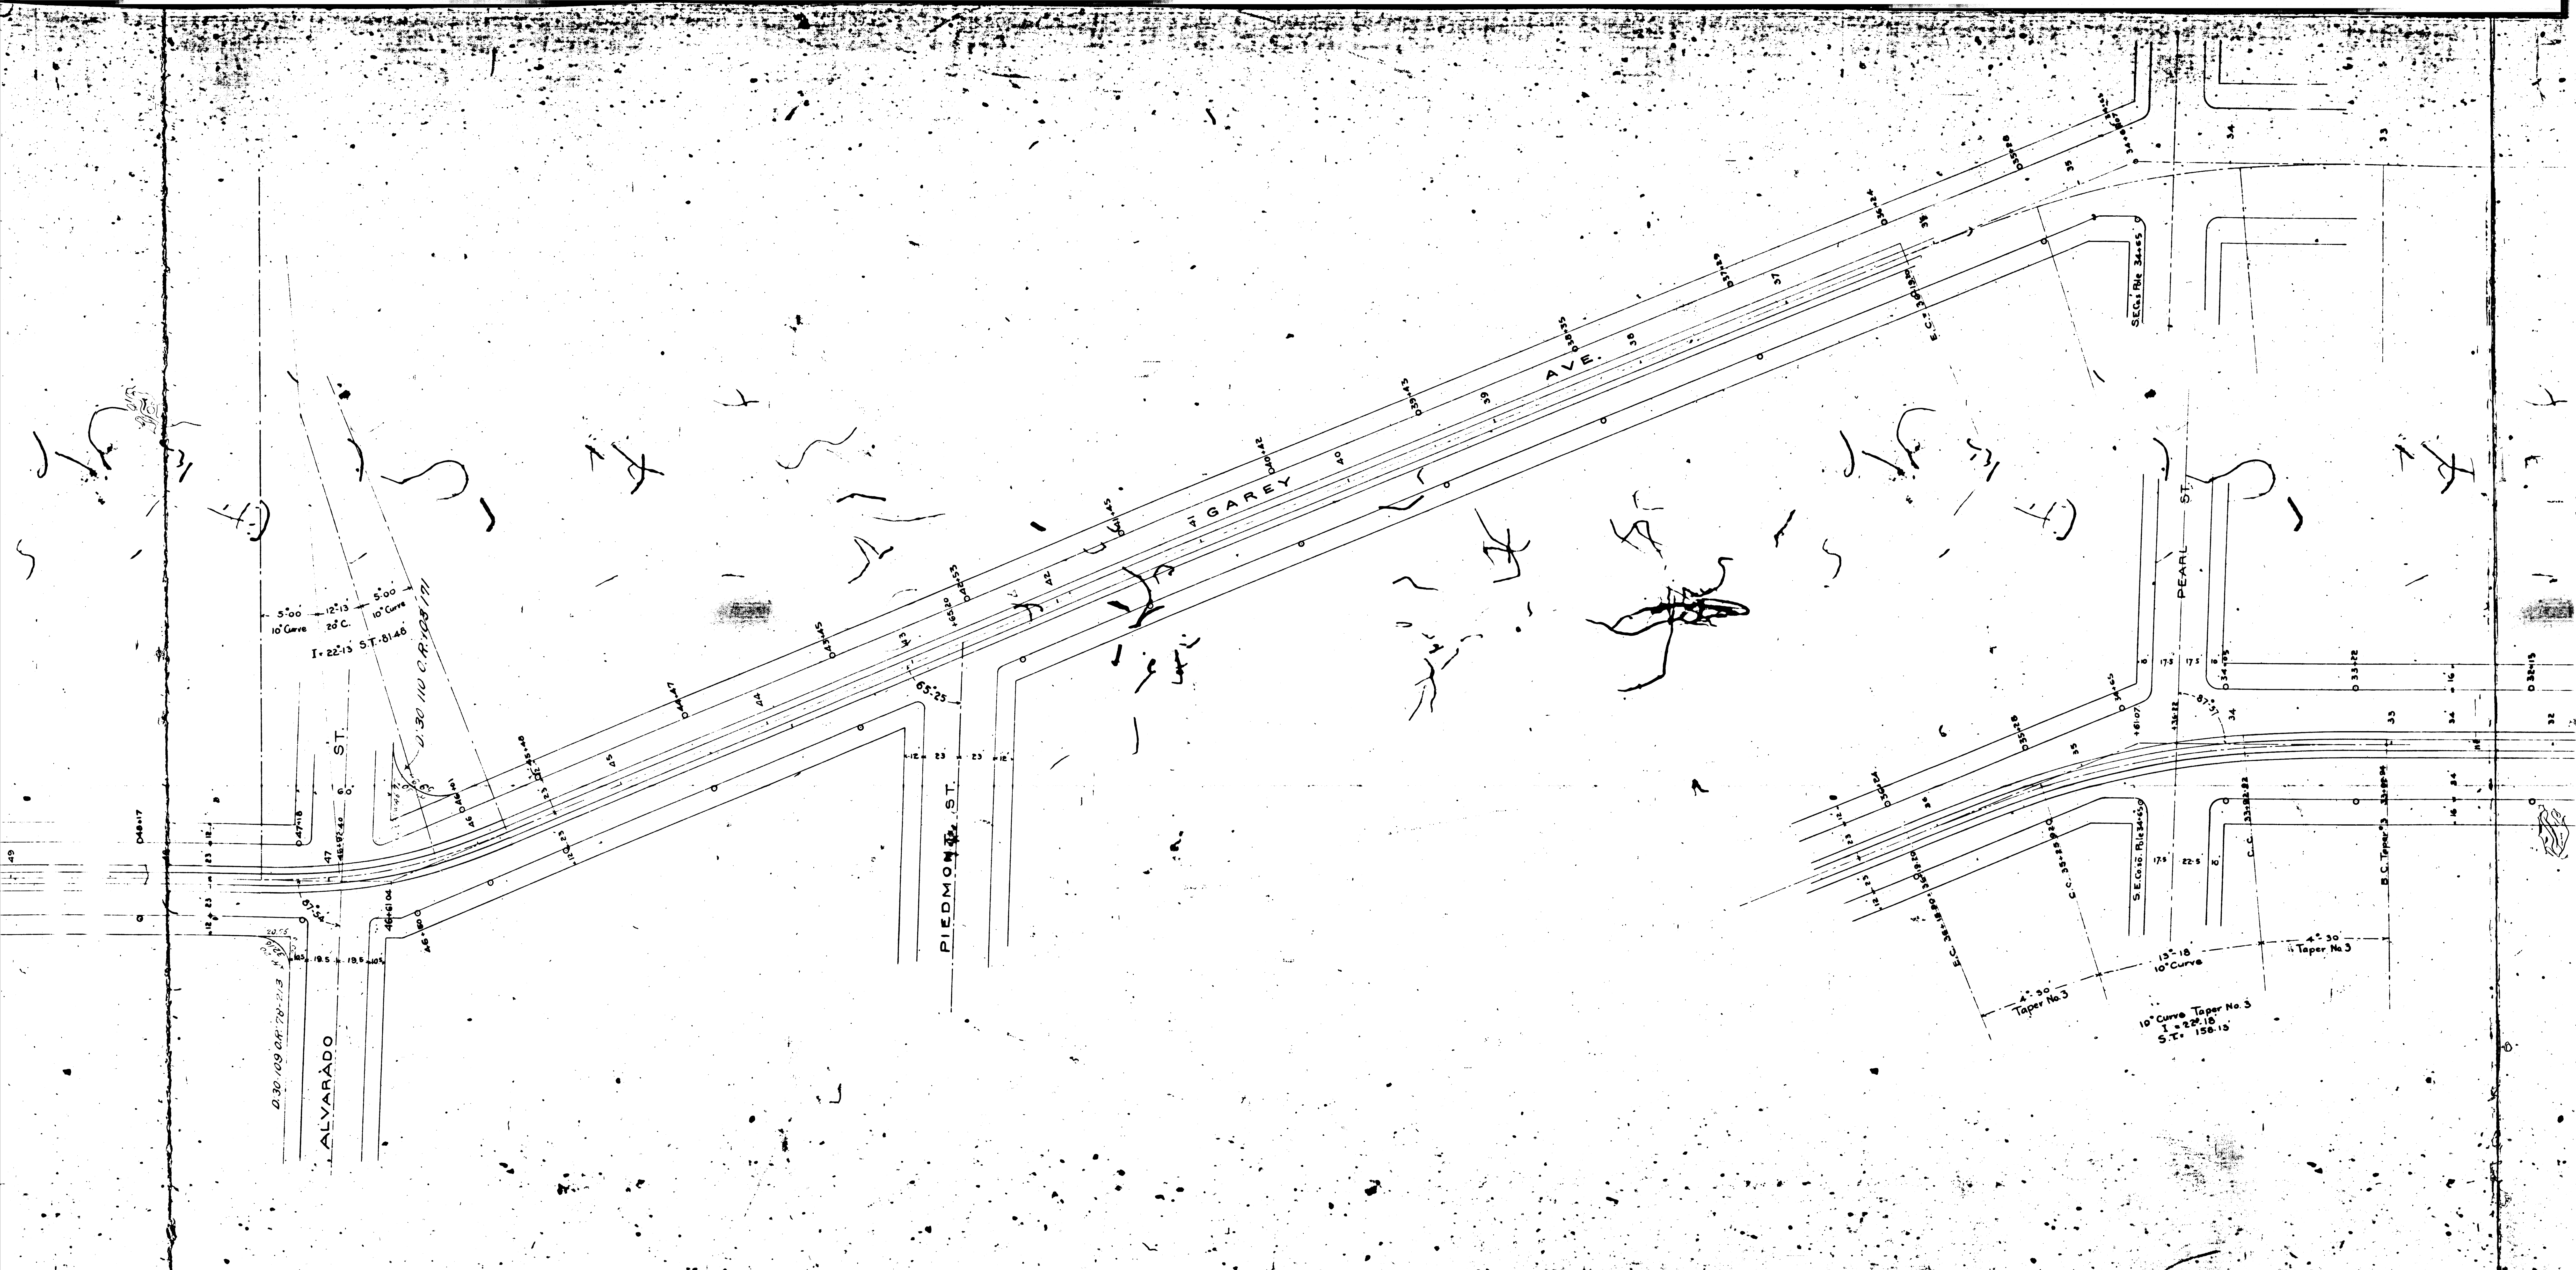

FM 17888  
 A4 OF A7

 

PASADENA AVE.


HOLT AVE.

CENTER ST.


LIBBY ST.

FM 17888

A5 OF A7

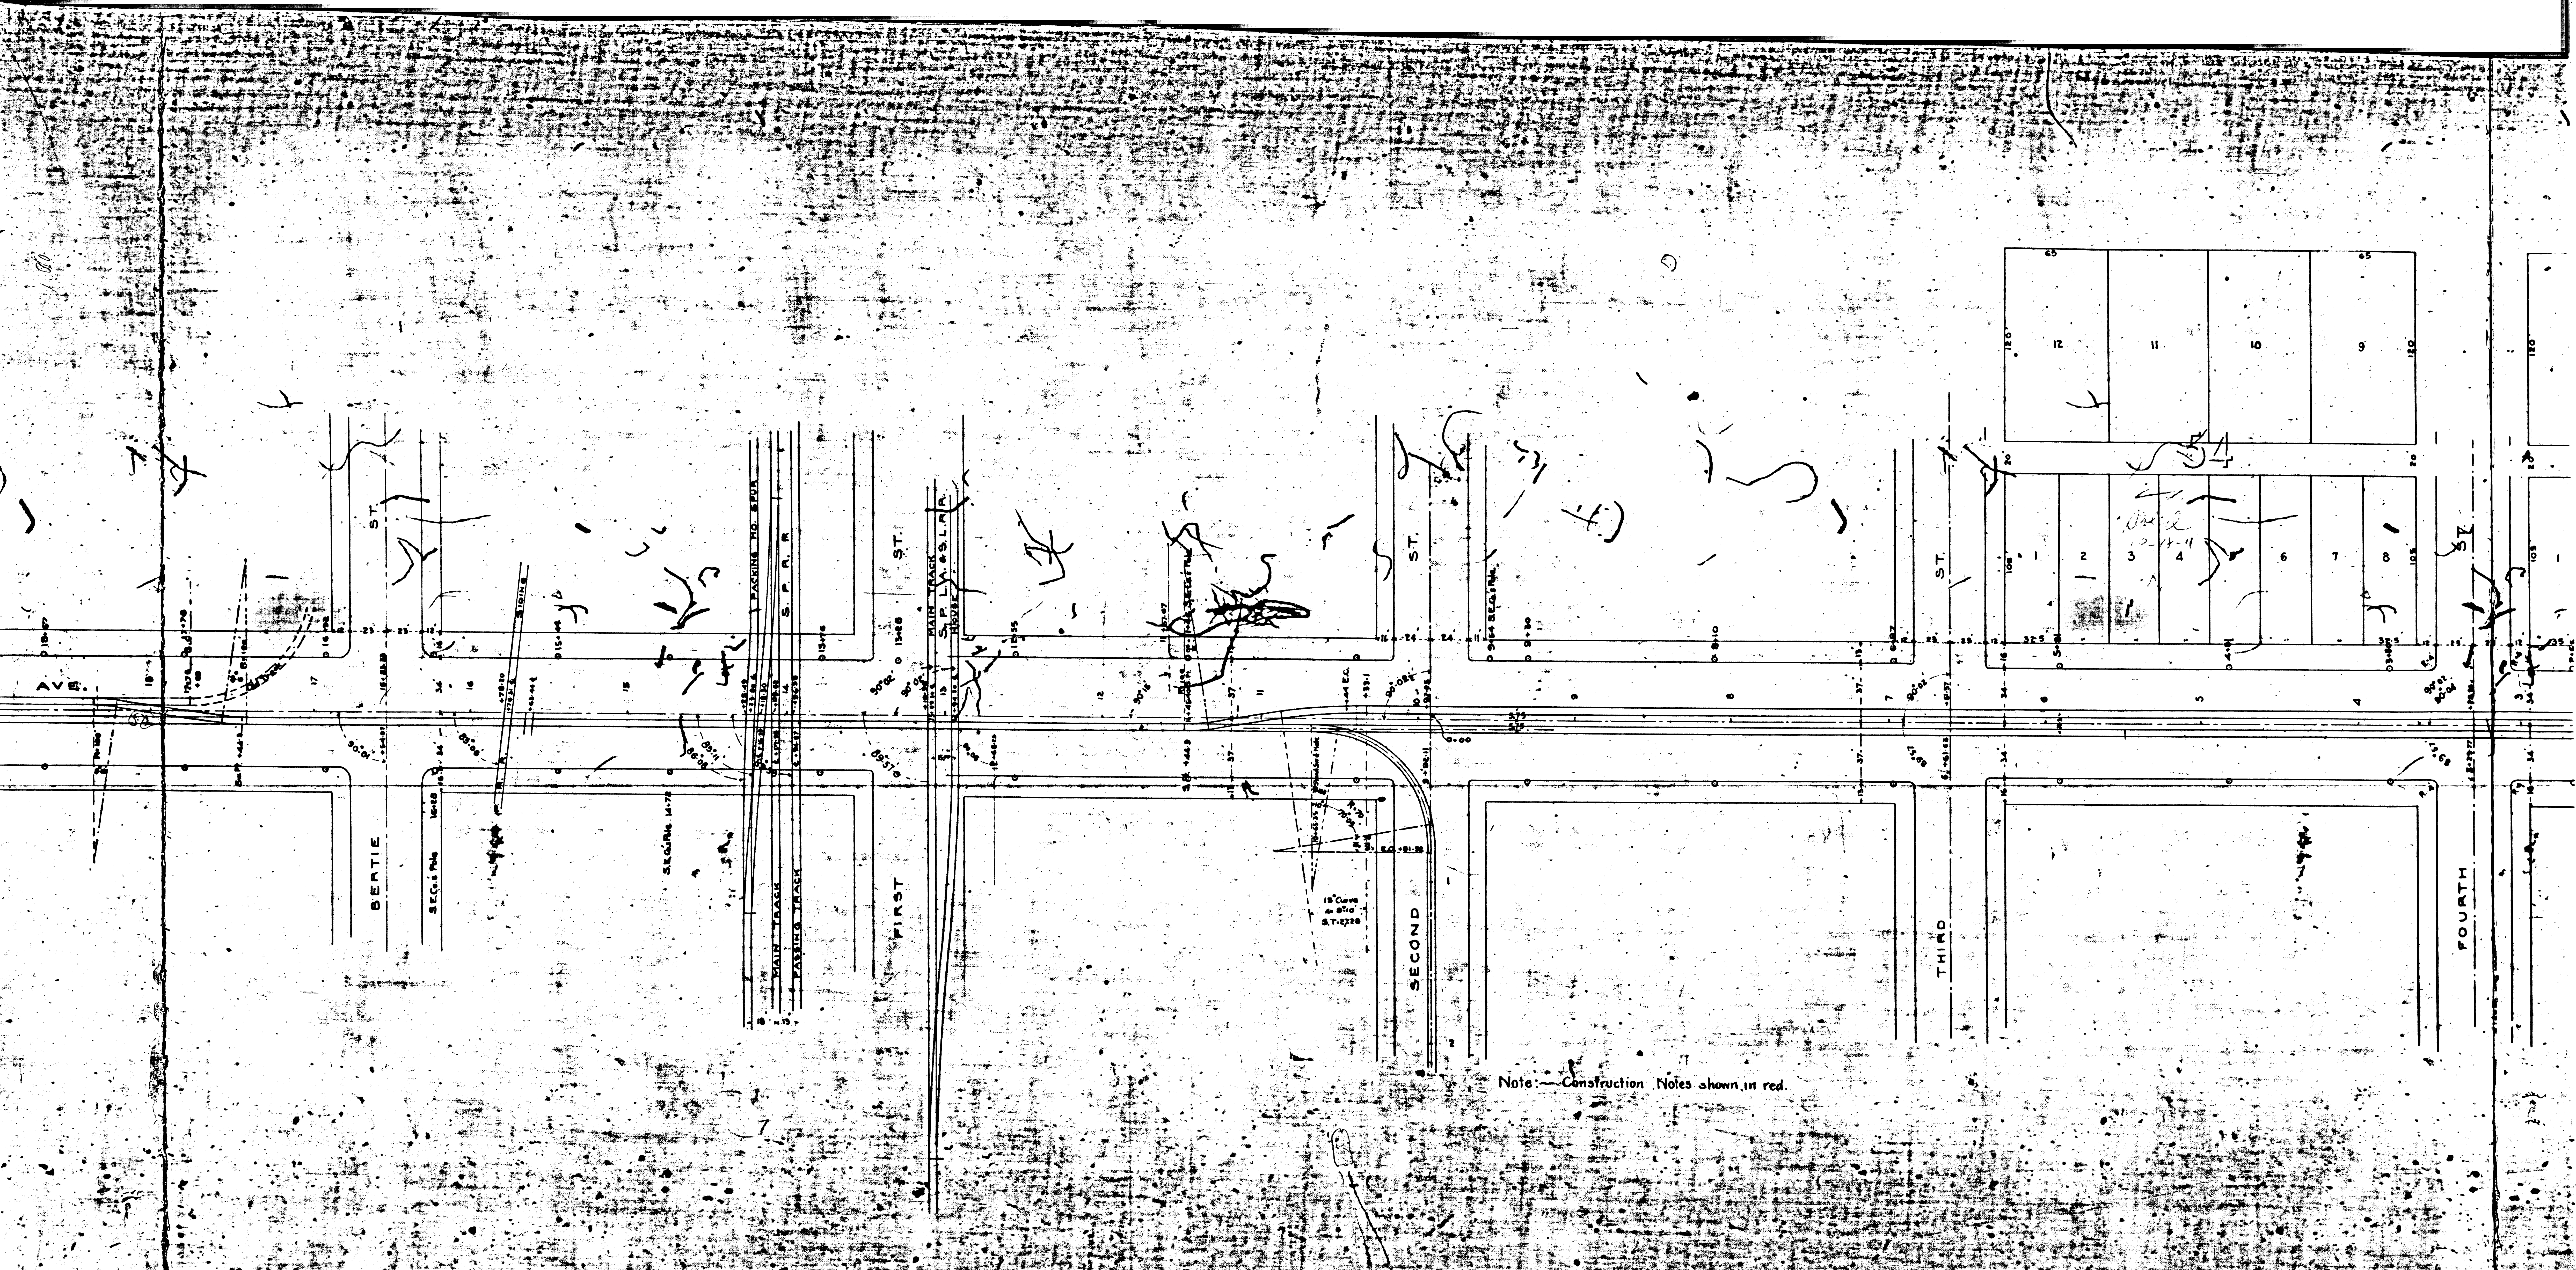

Note: Construction Notes shown in red.

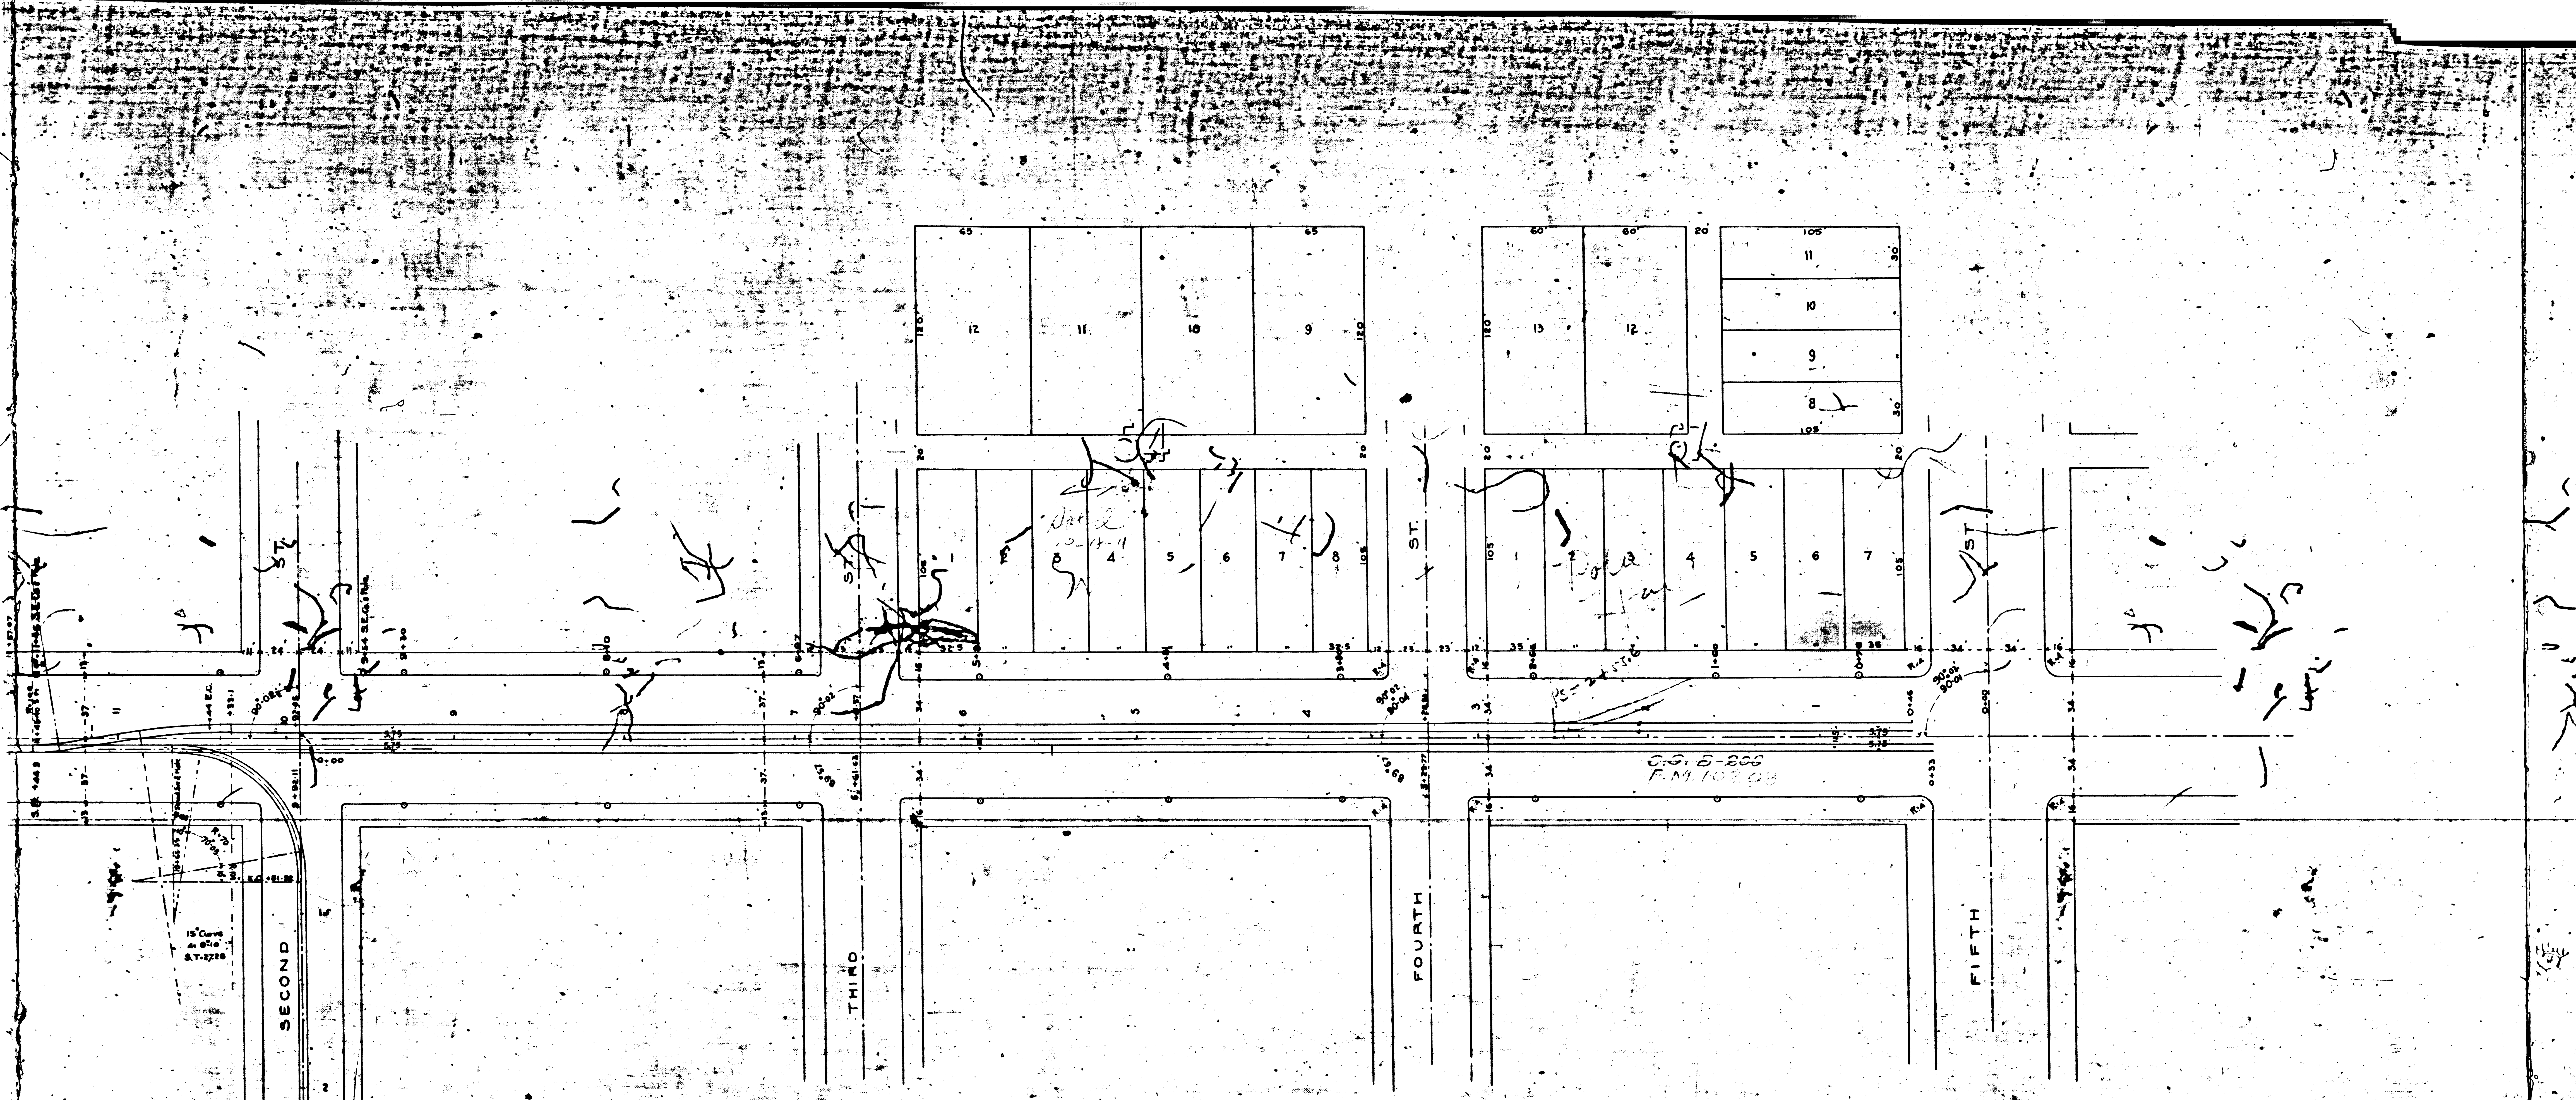

Note: Construction Notes shown in red.