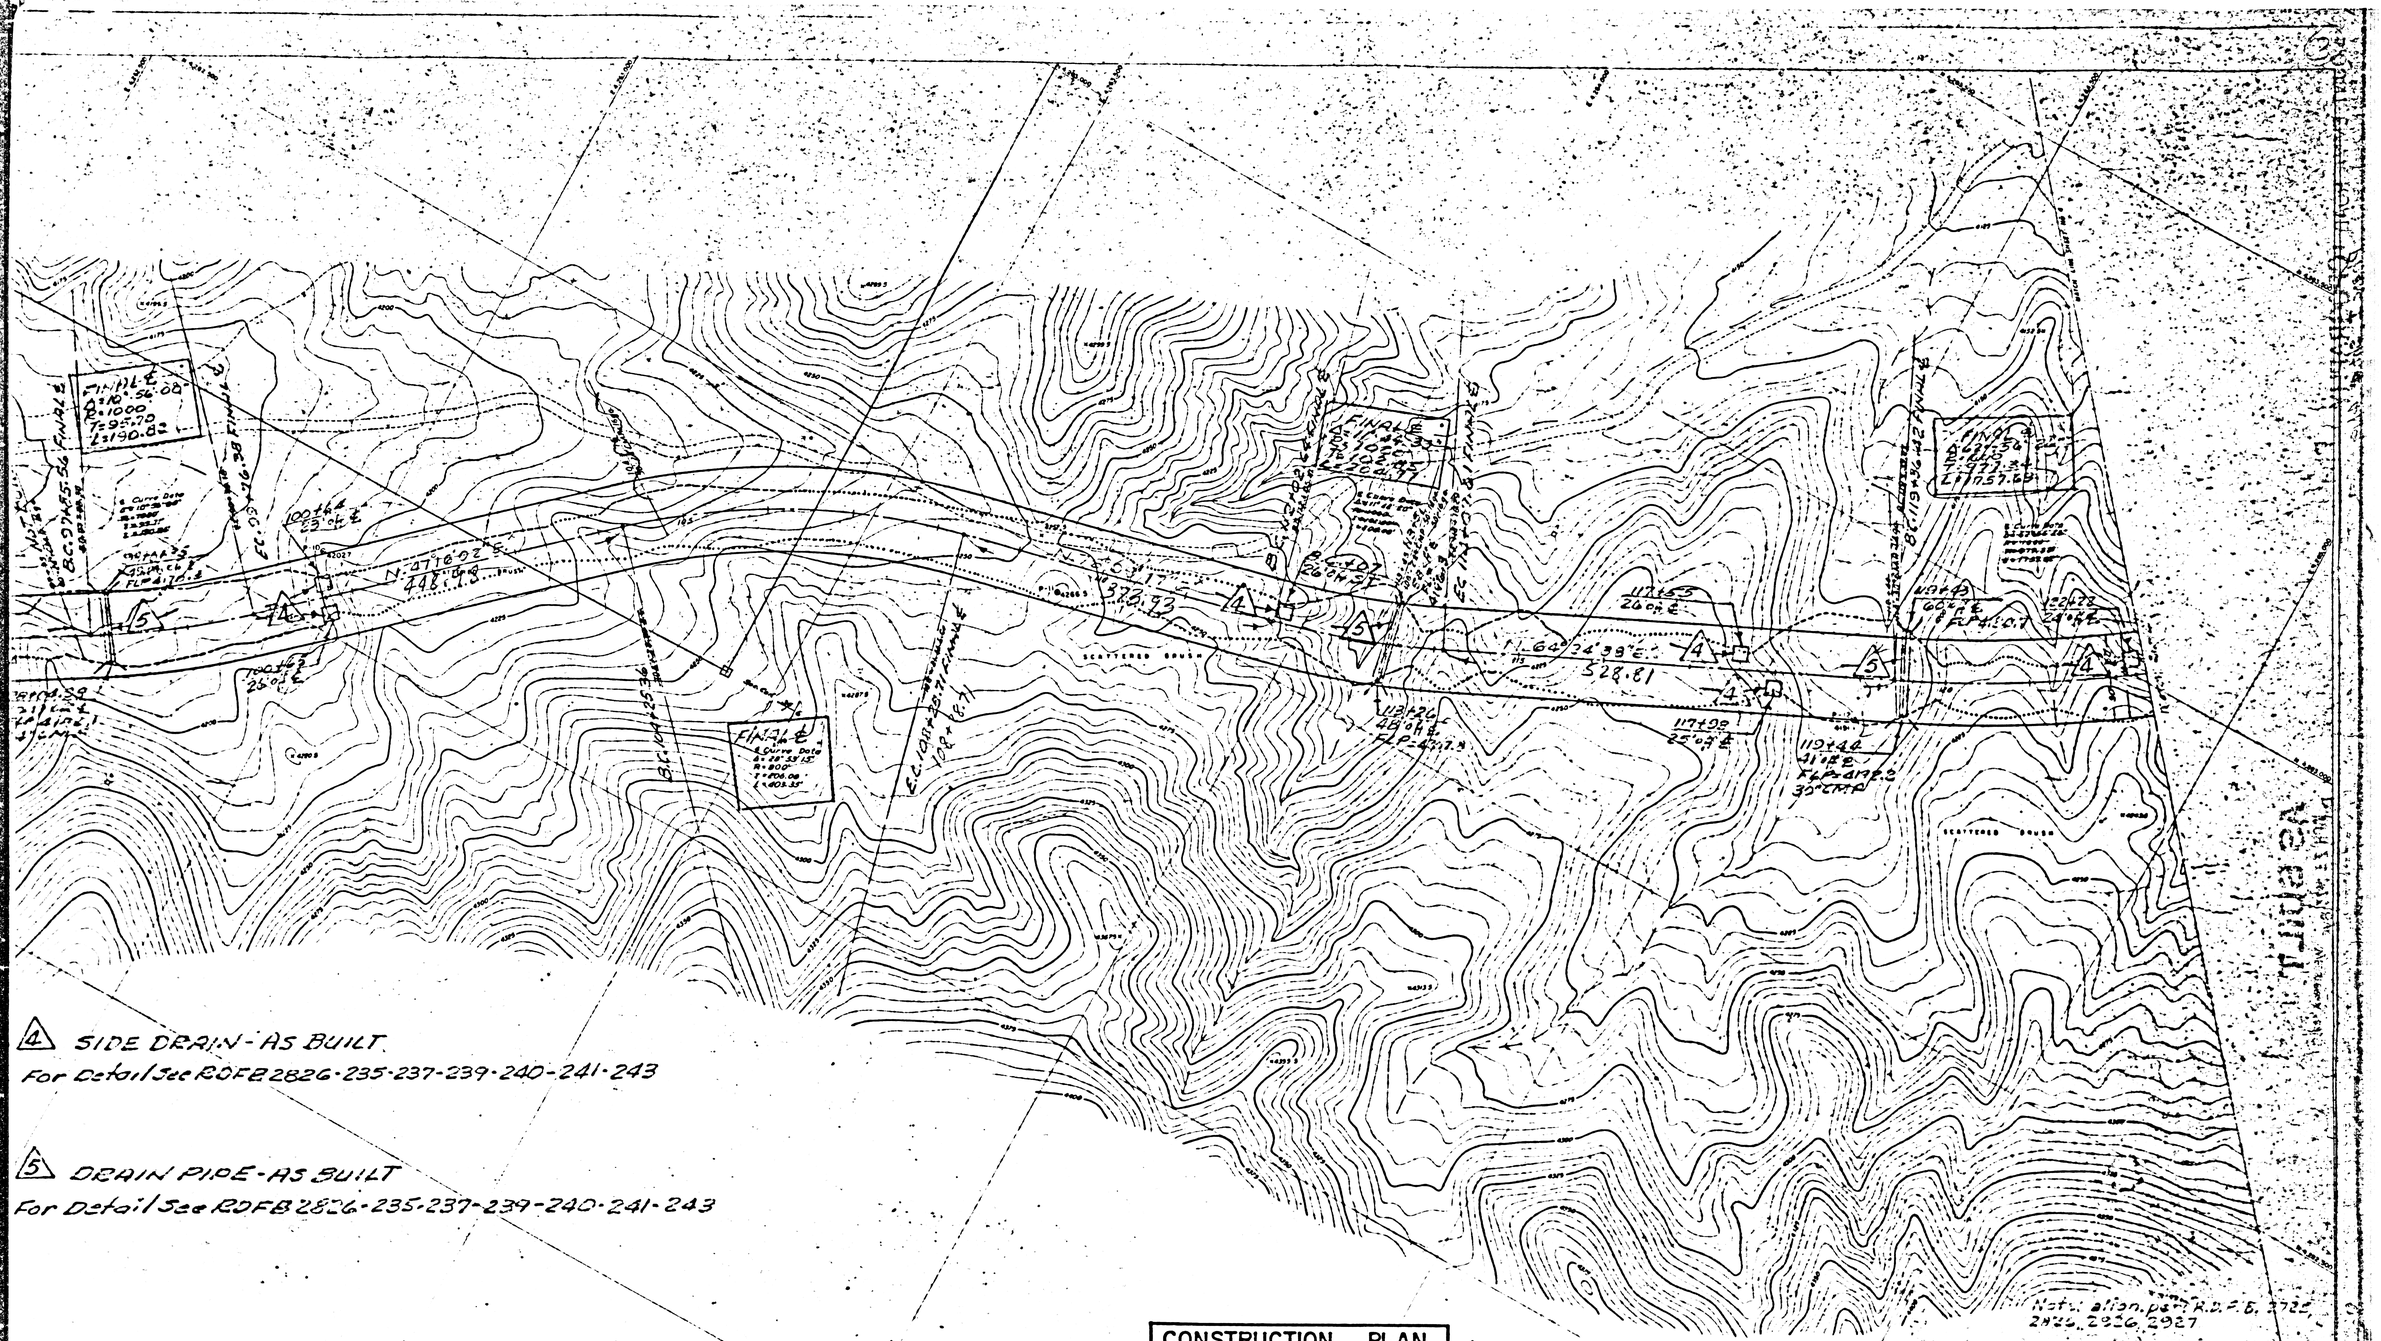
4 SIDE DRAIN - AS BUILT
For Detail See ROFB 2826-235-237-239-240-241-243
5 DRAIN PIPE - AS BUILT
For Detail See ROFB 2826-235-237-239-240-241-243
CONSTRUCTION PLAN
MOUNT EMMA RD. PHASE I
Angeles Forest Hwy. to Cheseboro Rd.
Proj. No. 016 I
Sht. 4 of 19
SCALE
0 50 100 150 200
Proposed
AS BUILT
LOS ANGELES COUNTY ROAD DEPT.
TOPOGRAPHIC MAP
MT. EMMA ROAD
FROM
ANGELES FOREST HIGHWAY
TO
3 MILES NORTHEAST
#03649
FM 21837-3 (A1 OF A2

4 SIDE DRAIN - AS BUILT
For Detail See ROFB 2826-235-237-239-240-241-243

5 DRAIN PIPE - AS BUILT
For Detail See ROFB 2826-235-237-239-240-241-243

CONSTRU
MOUNT E
Angeles Fo

FM 21837-3 (A2 OF A2)