

USE STANDARD STRENGTH PIPE
 USE CEMENT MORTAR FOR ALL VITRIFIED CLAY PIPE JOINTS
 ENCASE FOUR FEET OF SEWER AT POINTS OF INTERFERENCE WITH POLES AS PER S-8-115

ALL STRUCTURES SHALL BE BRICK SEWER STRUCTURES AS PER PLAN NO. S-8-104
 USE STANDARD MANHOLE FRAMES AND COVERS AS PER PLAN NO. S-8-117

RESURFACE ALL TRENCHES WITHIN PAVED AREA TO MEET LOS ANGELES COUNTY ROAD DEPT REQUIREMENTS

NO REVISIONS SHALL BE MADE IN THESE PLANS WITHOUT APPROVAL OF THE COUNTY ENGINEER
 NO REPRESENTATIVE OF THE COUNTY ENGINEER WILL SURVEY OR LAY OUT ANY PORTION OF THE WORK
 THE OWNER OR HIS AUTHORIZED REPRESENTATIVE SHALL FURNISH THE COUNTY ENGINEER WITH GRADE SHEETS AND STATIONS OF ALL HOUSE CONNECTIONS AND Y BRANCHES, AND SHALL PROVIDE STAKES FOR THEM AT THEIR PROPER LOCATIONS WITH STATIONING PLAINLY MARKED
 ANY CHANGE OF LOCATION SHALL BE REQUESTED IN WRITING BY THE OWNER OR HIS REPRESENTATIVE

NOTE
 BEFORE ANY CONNECTIONS FOR THE DISPOSAL OF LIQUID INDUSTRIAL WASTE IS TO BE MADE TO THIS SEWER, DETAILED PLANS MUST BE SUBMITTED TO AND A PERMIT SECURED FROM THE COUNTY ENGINEER.

NOTE
 SANITATION DISTRICT MUST BE NOTIFIED BEFORE WORK CAN START

PROFILE, ALIGNMENT AND GRADE OF
SANITARY SEWERS
 TO BE CONSTRUCTED IN

MALT AVENUE
 (A PRIVATE STREET)

10 INCH V.C.P. FROM SLAUSON AVE. 600 FT NORTH


PRIVATE CONTRACT NO. 930
 W. S. 36

SCALE: VERT. 1"=4'
 HORIZ. 1"=40'
 NOVEMBER 1948
 PREPARED IN THE OFFICES OF
CENTRAL MANUFACTURING DISTRICT, INC.

BY *[Signature]*
 REC. & NO. 1022
 RECEIVED
 NOV 18 1948
 FOR LEGEND
 SEE PLAN NO. S-8-88

NOTE:
 GRADES TO WHICH THIS IMPROVEMENT IS TO BE CONSTRUCTED ARE SHOWN ON PLANS AND PROFILES
 GRADE POINTS FOR TOP OF CURB, CENTER LINE OF STREET OR CENTER LINE OF ALLEY ARE SHOWN BY
 CIRCLES ON PROFILES AT ALL POINTS BETWEEN DESIGNATED POINTS THE GRADE SHALL BE ESTABLISHED
 SO AS TO CONFORM TO A STRAIGHT LINE DRAWN BETWEEN SAID DESIGNATED POINTS
 ELEVATIONS ARE IN FEET ABOVE U. S. G. S. DATUM OR MEAN SEA LEVEL
 THIS DRAWING AND THE DATA HEREON ARE HEREBY MADE A PART OF THE SPECIFICATIONS
 WORK SHALL BE CONSTRUCTED ACCORDING TO SPECIFICATIONS ON FILE IN THE OFFICE OF THE
 COUNTY ENGINEER AND SHALL BE PROSECUTED ONLY IN THE PRESENCE OF THE COUNTY ENGINEER
 BEFORE WORK CAN BE STARTED, THE CONTRACTOR MUST OBTAIN A PERMIT TO EXCAVATE IN
 COUNTY STREETS FROM THE L. A. COUNTY ROAD DEPT. 211 SOUTH MAIN STREET AND MAKE A DEPOSIT
 WITH THE COUNTY ENGINEER, 700 UNION LEAGUE BUILDING, SUFFICIENT TO COVER THE COST OF
 CONSTRUCTION INSPECTION AND RECORD PLANS

COUNTY OF LOS ANGELES, CALIFORNIA
 APPROVED: *[Signature]* COUNTY ENGINEER
 APPROVED: *[Signature]* COUNTY ENGINEER
 C.E. ARNOLD COUNTY ENGINEER
 CHECKED BY: *[Signature]* Nov 16, 1948
 OFFICE OF COUNTY ENGINEER, 622 S. E. 100 S. 1322

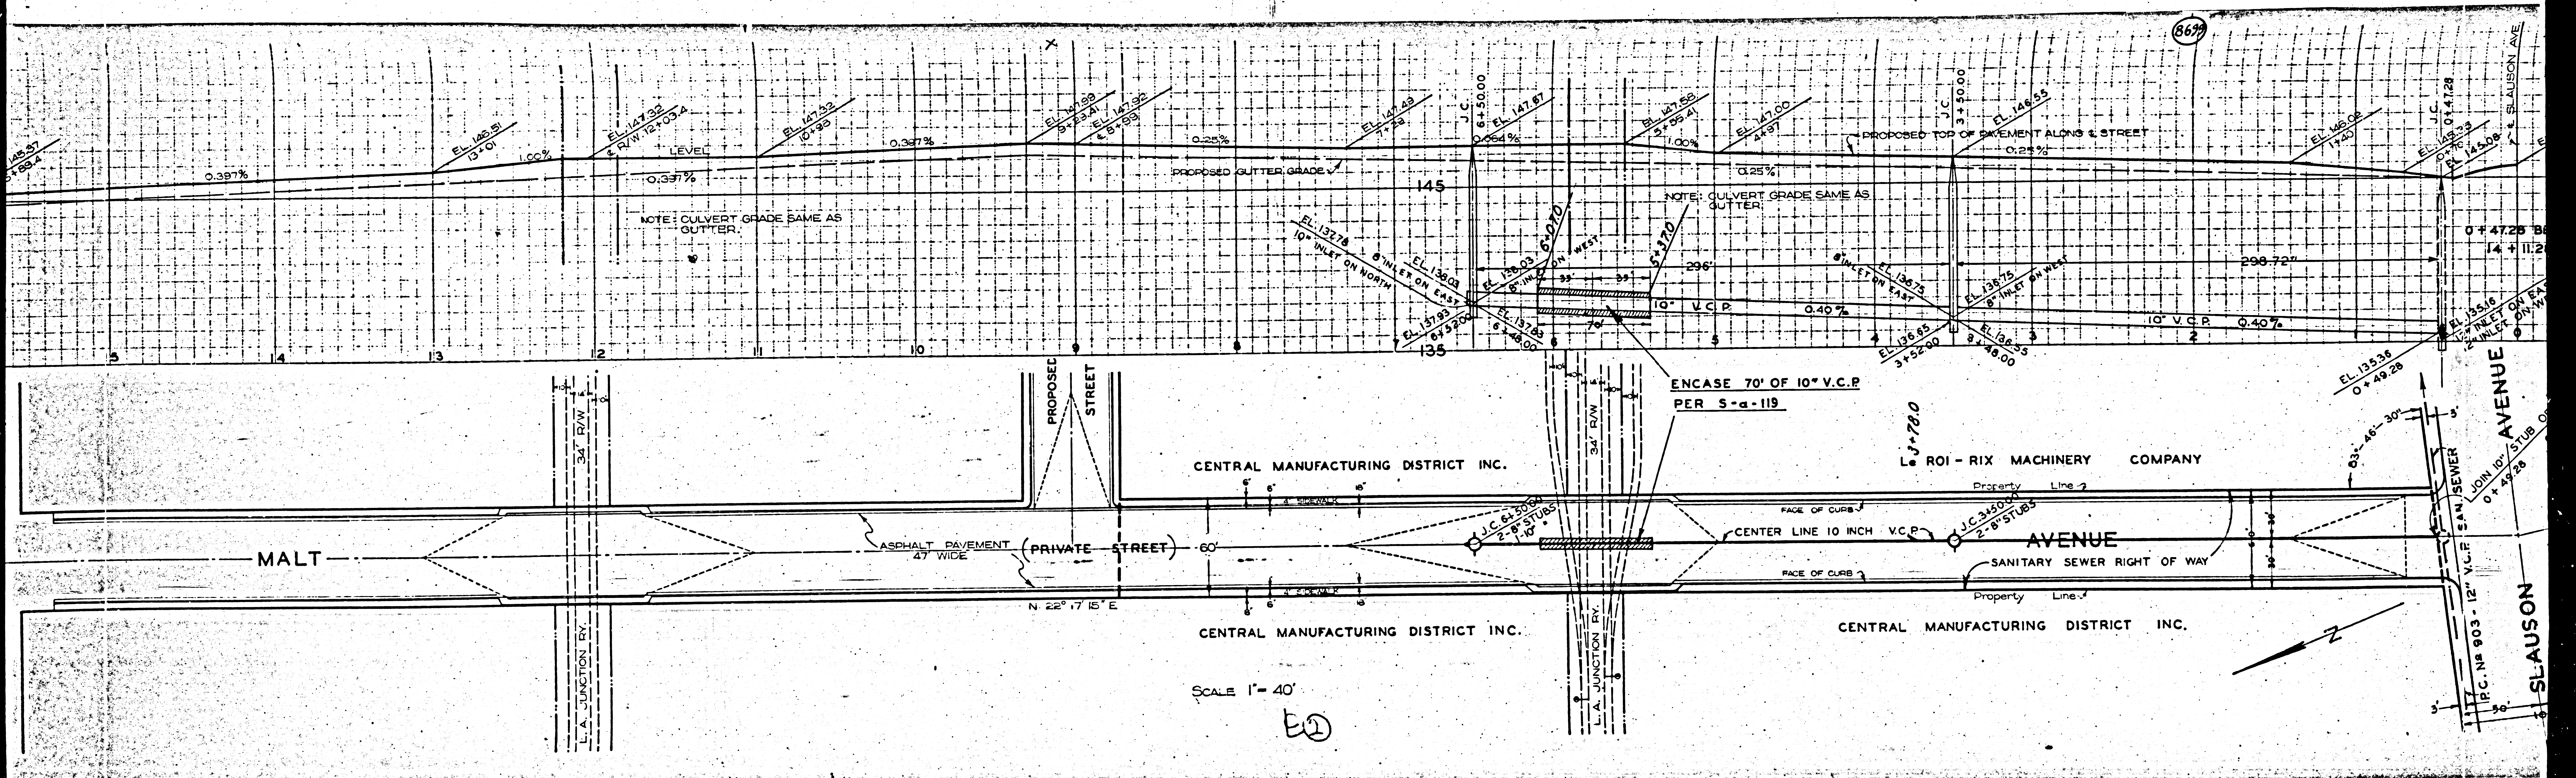

SCALE 1" = 40'

EO

867

