

B.M. #29 - Elev. 38.725
 Dolores St. & Sepulveda Blvd.
 Lead & Tack in N.E. Curb Return 1.5' So. of No. End.

- (1) USE STANDARD MANHOLE FRAME AND COVER, S-a-117, (EXCEPT AS NOTED).
- (2) USE STANDARD STRENGTH PIPE, (EXCEPT AS NOTED).
- (3) USE CEMENT MORTAR FOR ALL VITRIFIED CLAY PIPE JOINTS.
- (4) RESURFACE ALL TRENCH WITHIN PAVED AREA TO MEET LOS ANGELES COUNTY ROAD DEPT. OR CALIFORNIA STATE HIGHWAY REQUIREMENTS IN ACCORDANCE WITH PERMIT.
- (5) CONSTRUCT HOUSE CONNECTIONS WITH INVERT AT PROPERTY LINE 5 FEET BELOW CURB, (EXCEPT AS NOTED).
- (6) ENCASE FOUR FEET OF SEWER AT POINTS OF INTERFERENCE WITH POLES AS PER S-a-119.
- (7) ALL STRUCTURES SHALL BE BRICK SEWER STRUCTURES, S-a-104, (EXCEPT AS NOTED).



NOTE:
 NO REPRESENTATIVE OF THE COUNTY ENGINEER WILL SURVEY OR LAY OUT ANY PORTION OF THE WORK.
 THE OWNER OR HIS AUTHORIZED REPRESENTATIVE SHALL FURNISH THE COUNTY ENGINEER WITH GRADE SHEETS AND STATIONS OF ALL HOUSE CONNECTIONS AND Y BRANCHES AND SHALL PROVIDE STAKES FOR THEM AT THEIR PROPER LOCATIONS WITH STATIONING, PLAINLY MARKED. ANY CHANGE OF LOCATION SHALL BE REQUESTED IN WRITING BY THE OWNER OR HIS REPRESENTATIVE.
 NO REVISIONS SHALL BE MADE IN THESE PLANS WITHOUT APPROVAL OF THE COUNTY ENGINEER.
 PROVIDE STAKES ON THE PROPERTY LINES OR PROPERTY LINES PRODUCED AT RIGHT ANGLES TO THE SEWER LINE AT THE CENTER LINE OF EACH MANHOLE.
 SEWERS TO BE INSTALLED WITH VENT COPIEDS BY MANUFACTURER AT HIS PLANT. SPEC. SEC. 35, 38, CONCRETE PAVEMENT TO BE CUT NOT LESS THAN 8" IN DEPTH WITH CONCRETE SAW. SPEC. SEC. 66.

PROFILE, ALIGNMENT AND GRADE OF
SANITARY SEWERS
 TO BE CONSTRUCTED IN
MAIN STREET
 BETWEEN OCEAN AVE. AND 235TH ST.
234TH STREET
 BETWEEN MAIN ST. AND 234TH ST. (NORTH)
235TH STREET
 BETWEEN MAIN ST. AND 234TH PL. (SOUTH)
234TH PLACE
 BETWEEN MAIN ST. AND 234TH PL. (SOUTH)
PRIVATE CONTRACT NO. 1708
 W. S. 28
 SHEET 1 OF 3 SHEETS

PREPARED IN THE OFFICE OF
LEONARD H. GOWDY
 BY: *Leonard H. Gowdy*
 REG. C.E. #91853

FOR LEGEND
 SEE PLAN NO. 3-9-64


NOTE:
 GRADES TO WHICH THIS IMPROVEMENT IS TO BE CONSTRUCTED ARE SHOWN ON PLANS AND PROFILE. GRADE POINTS FOR TOP OF CURB, CENTER LINE OF STREET OR CENTER LINE OF ALLEY ARE SHOWN BY CIRCLES ON PROFILES. AT ALL POINTS BETWEEN DESIGNATED POINTS THE GRADE SHALL BE ESTABLISHED SO AS TO CONFORM TO A STRAIGHT LINE DRAWN BETWEEN SAID DESIGNATED POINTS.
 ELEVATIONS ARE IN FEET ABOVE U.S.G.S. DATUM OR MEAN SEA LEVEL.
 THIS DRAWING AND THE DATA HEREON ARE HEREBY MADE A PART OF THE SPECIFICATIONS. WORK SHALL BE CONSTRUCTED ACCORDING TO SPECIFICATIONS ON FILE IN THE OFFICE OF THE COUNTY ENGINEER AND SHALL BE PROSECUTED ONLY IN THE PRESENCE OF THE COUNTY ENGINEER. BEFORE WORK CAN BE STARTED, THE CONTRACTOR MUST OBTAIN A PERMIT TO EXCAVATE IN COUNTY STREETS FROM THE L.A. COUNTY ROAD DEPT. JOB NO. 235 STREET AND MAKE A DEPOSIT WITH THE COUNTY ENGINEER, 228 L. A. COUNTY ENGINEERING BLDG., SUFFICIENT TO COVER THE COST OF CONSTRUCTION INSPECTION AND RECORD PLANS.
 APPROVAL OF THIS PLAN BY THE COUNTY OF LOS ANGELES DOES NOT CONSTITUTE A REPRESENTATION AS TO THE ACCURACY OF THE LOCATION OF, OR THE EXISTENCE OR NON-EXISTENCE OF, ANY UNDERGROUND UTILITY, PIPE, OR STRUCTURE WITHIN THE LIMITS OF THIS PROJECT. (THIS NOTE APPLIES TO ALL SHEETS.)

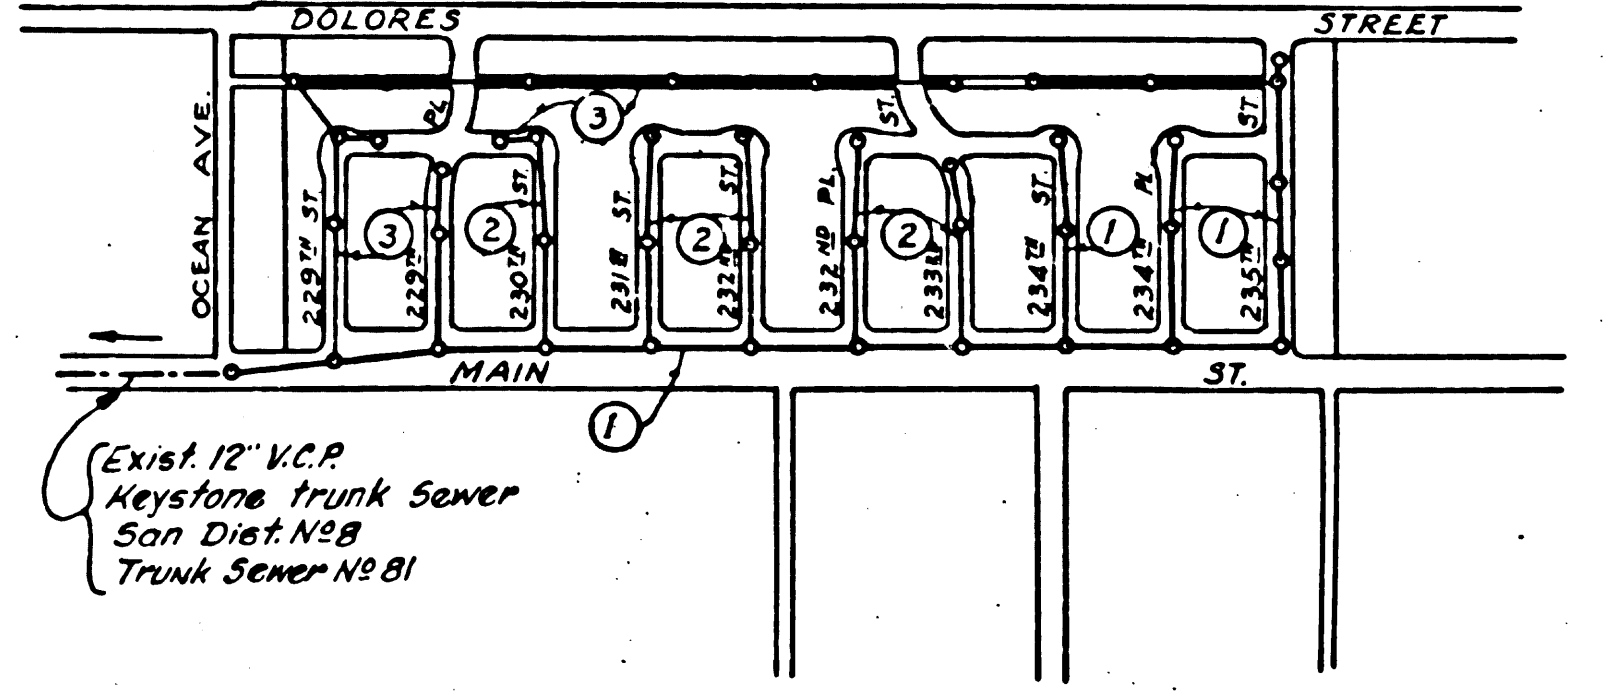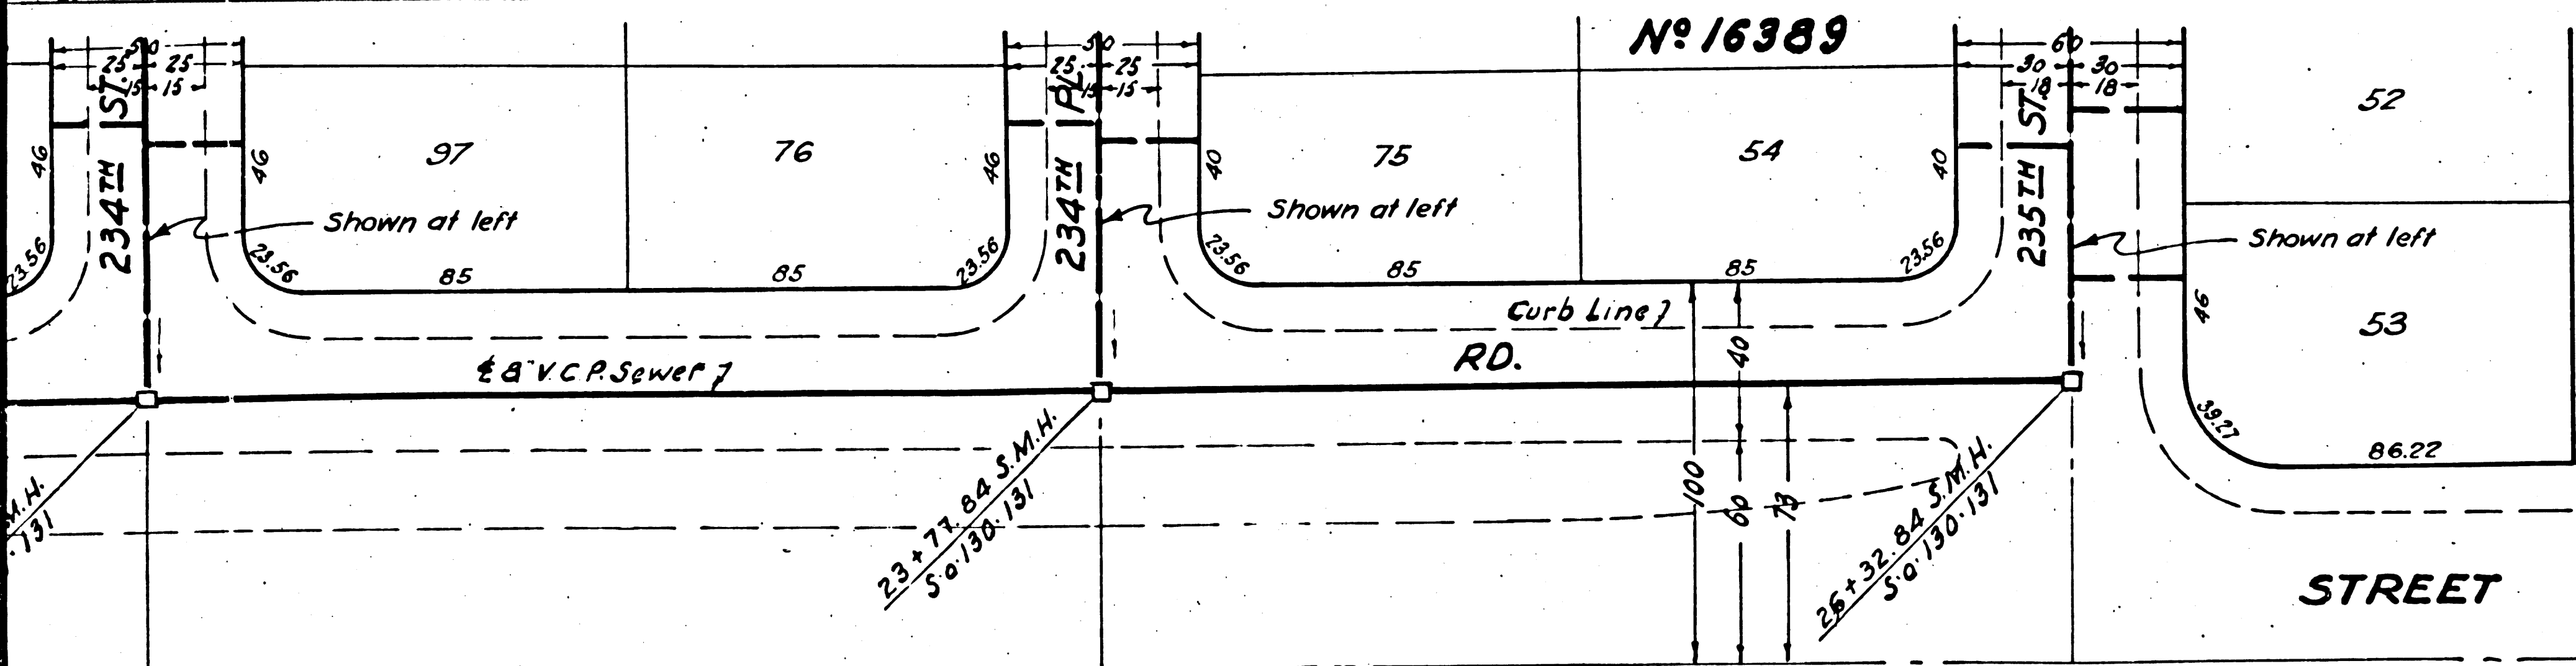


INDEX MAP
 P.C. 1708 J.N. 3814
 SCALE: 1" = 600'

COUNTY OF LOS ANGELES, CALIFORNIA.
 APPROVED: *[Signature]* COUNTY ENGINEER
 APPROVED BY: *[Signature]* OFFICE ENGINEER
 SANITATION DISTRICT NO. 8

CHECKED BY: *Richard E. Kahan*
 OFFICE OF COUNTY ENGINEER, REG. C.E. NO. 7860

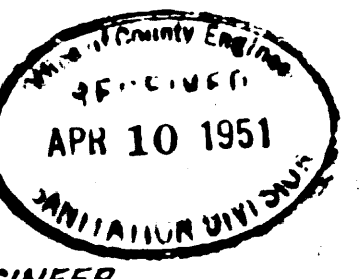


SHEET 1 OF 3 SHEETS
 SANITARY SEWER 234TH ST
 CIVIL ENGINEER
 W. S. 28 & LAY OUT NO. 16389

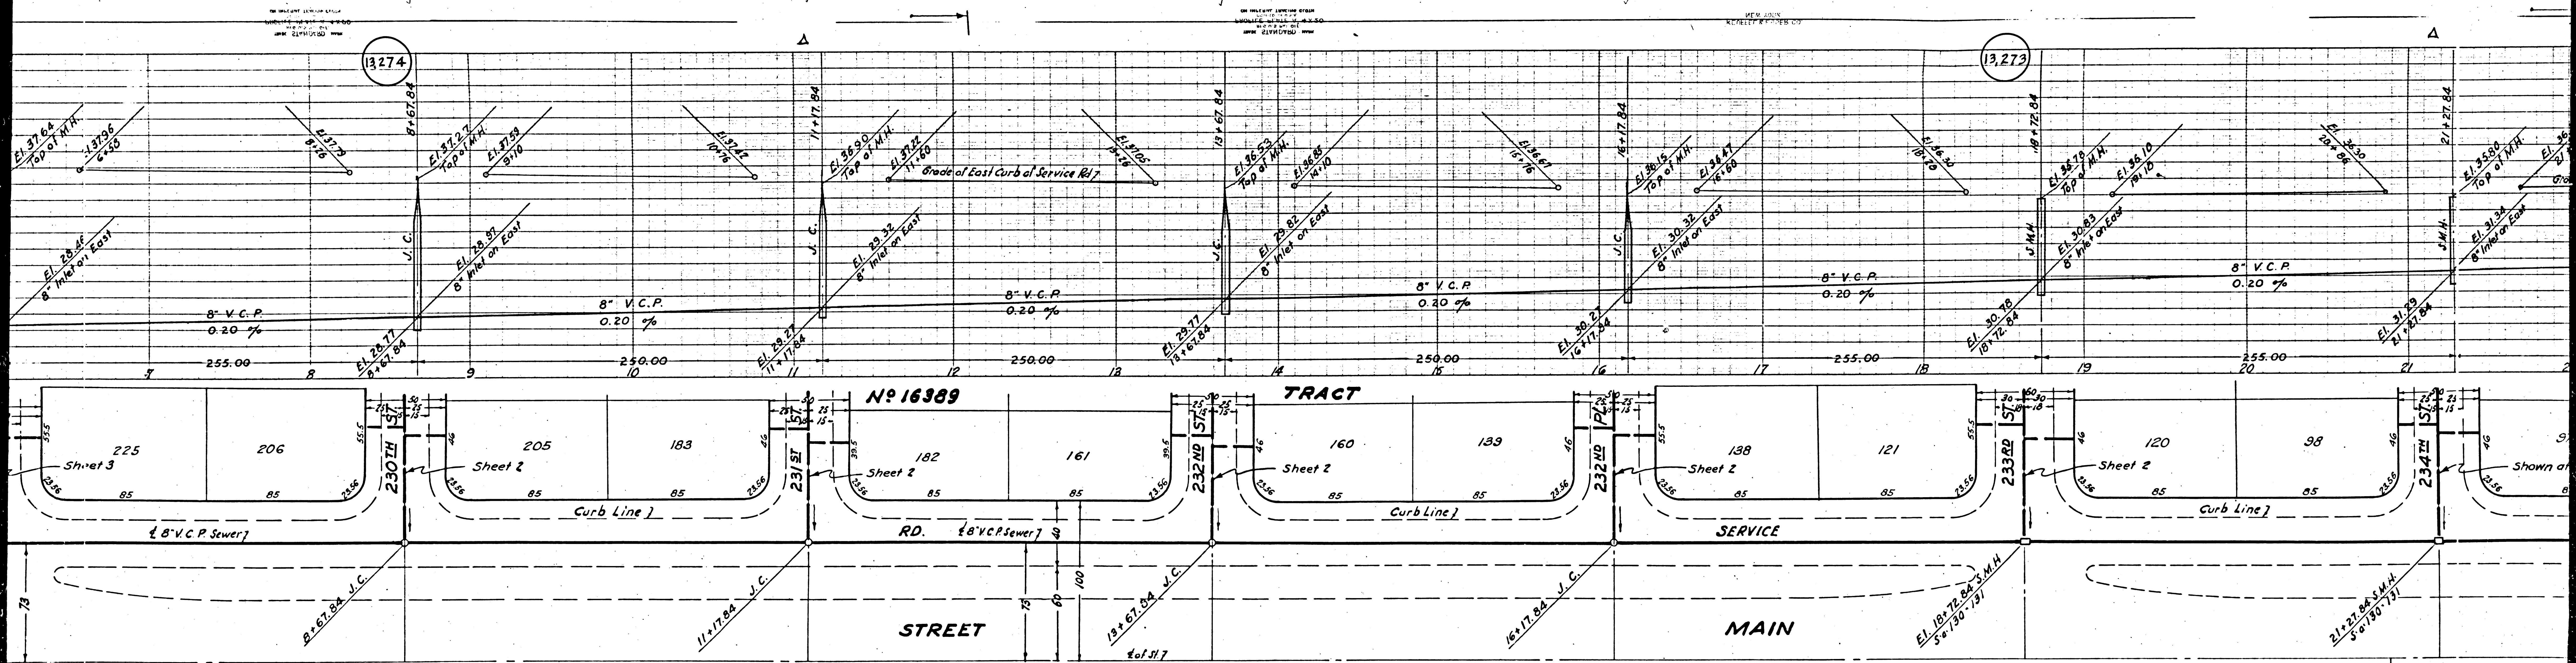

No. 16389 TRACT


STREET MAIN


(2)

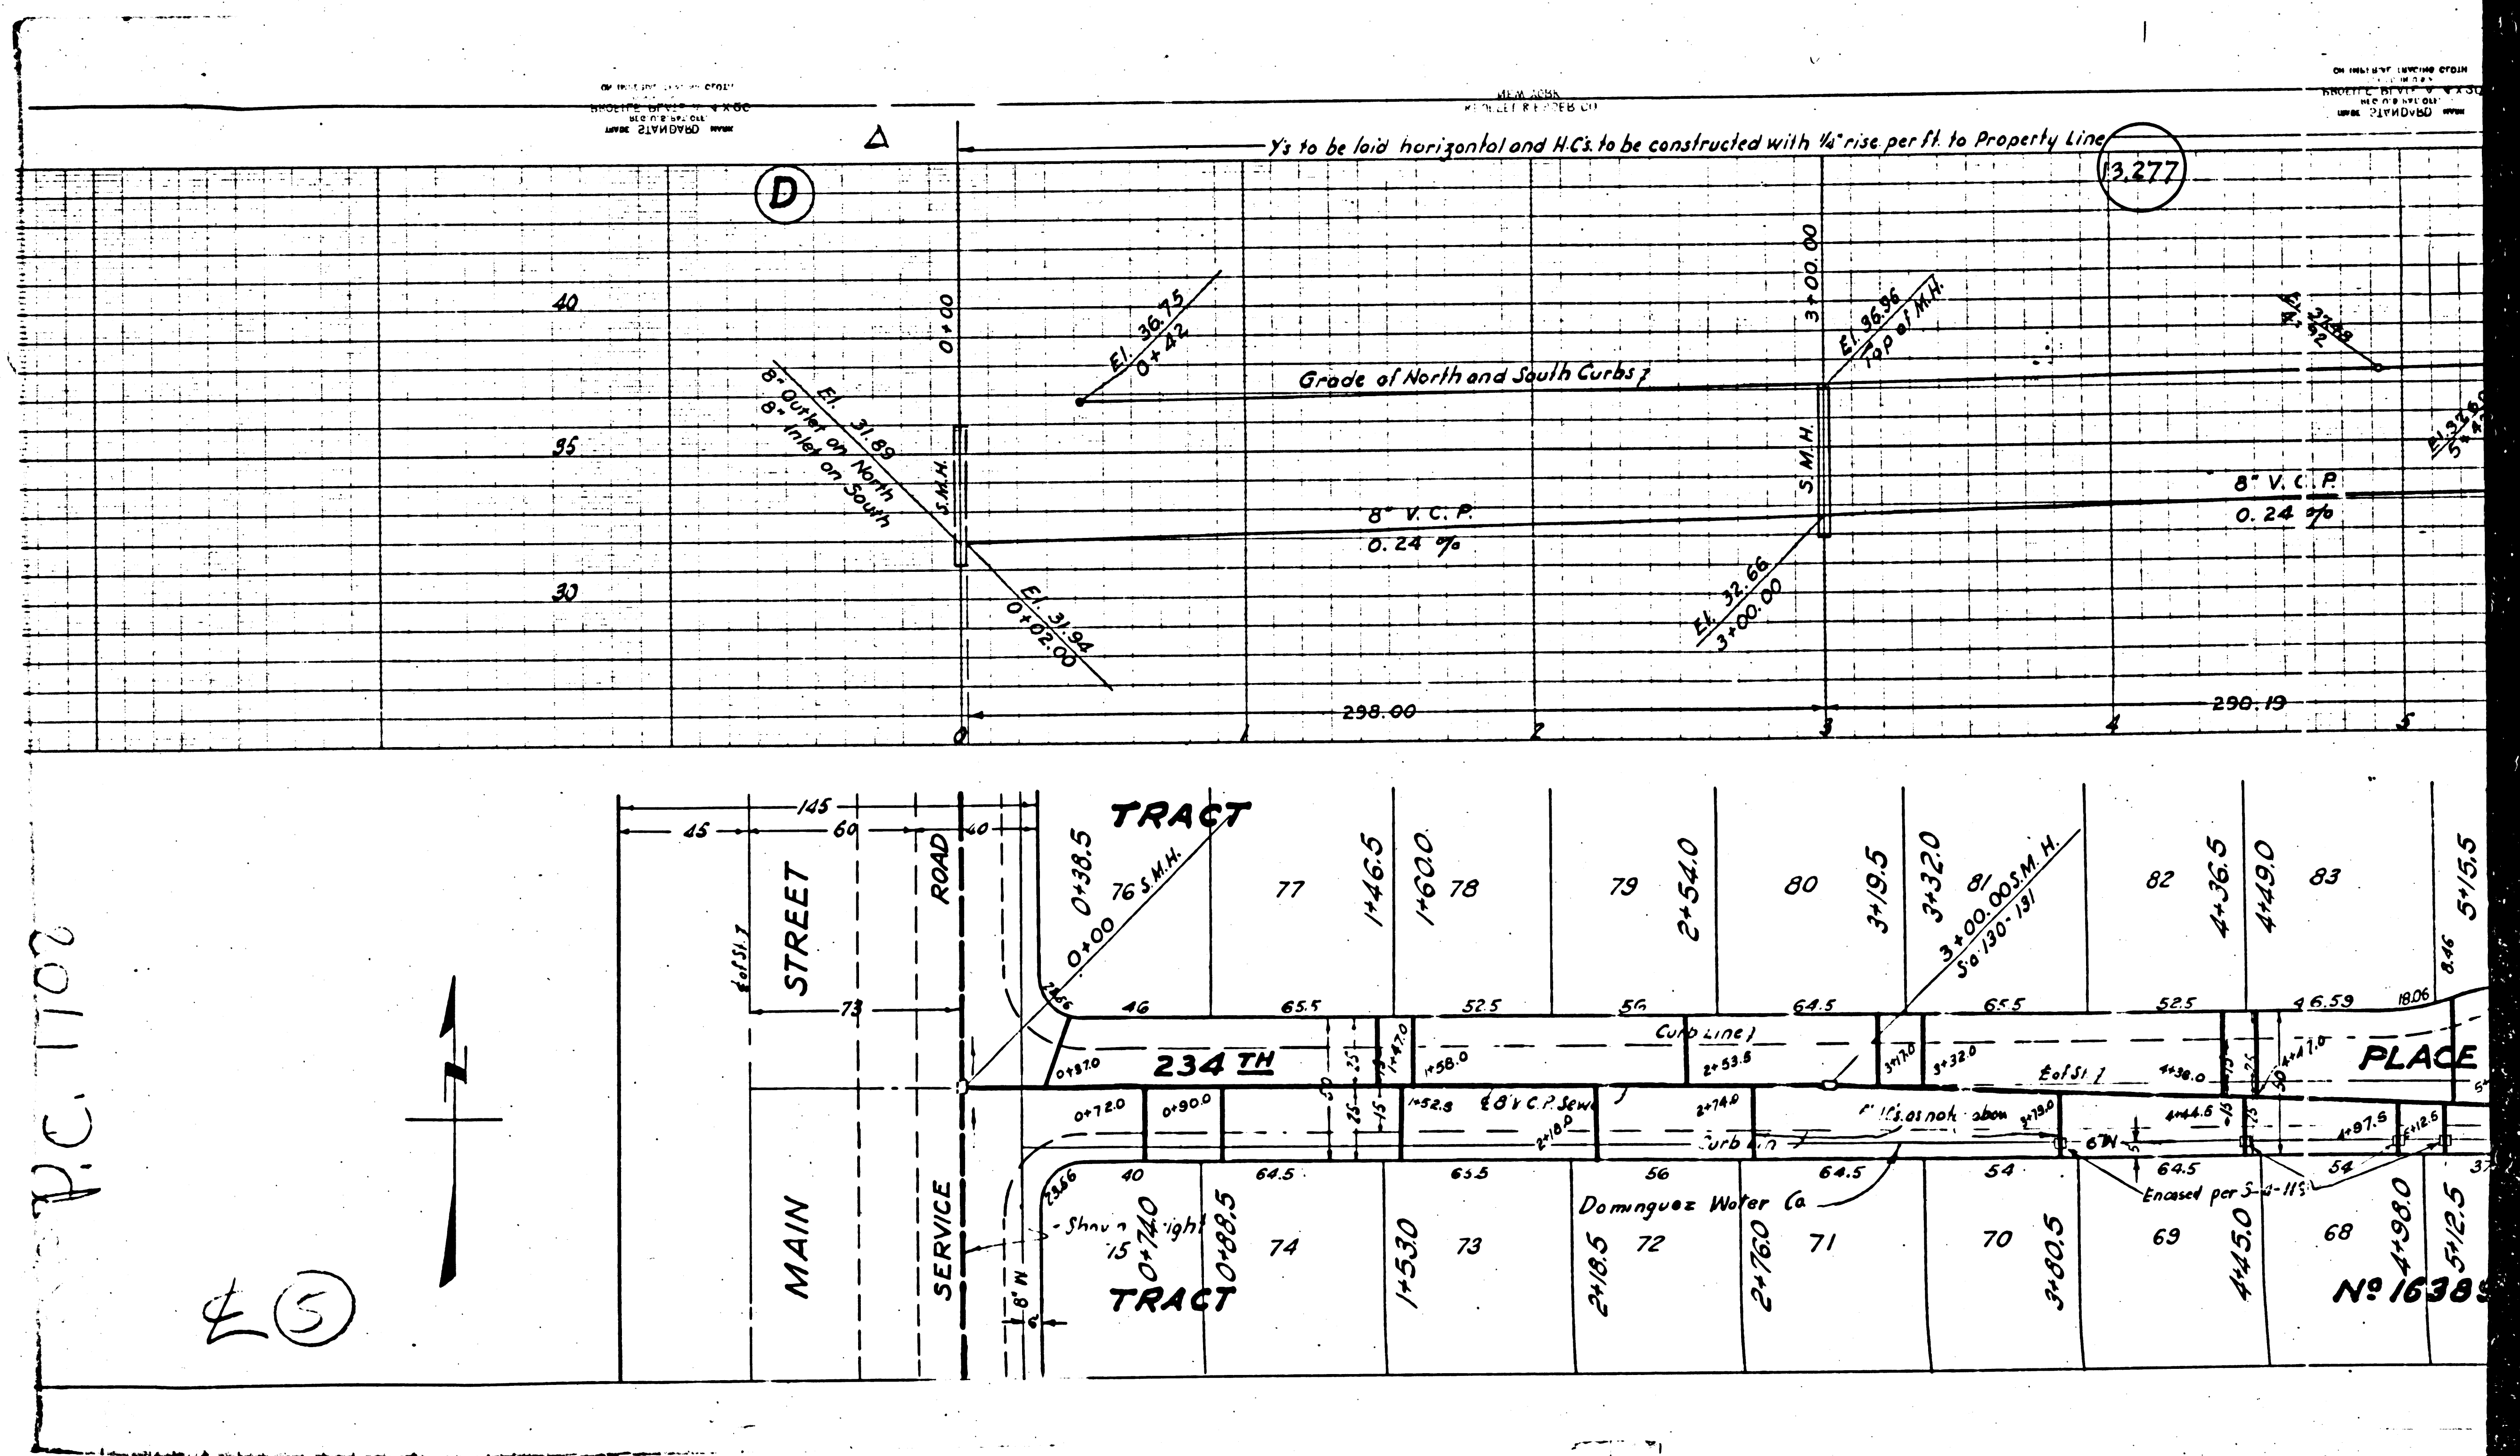

P.C. 1702

⊕ (5)

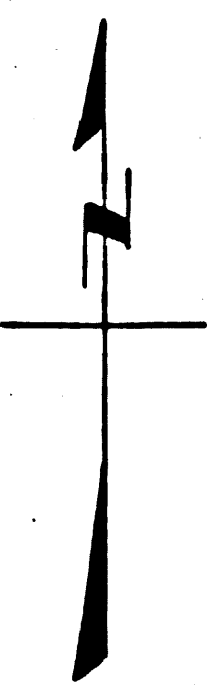

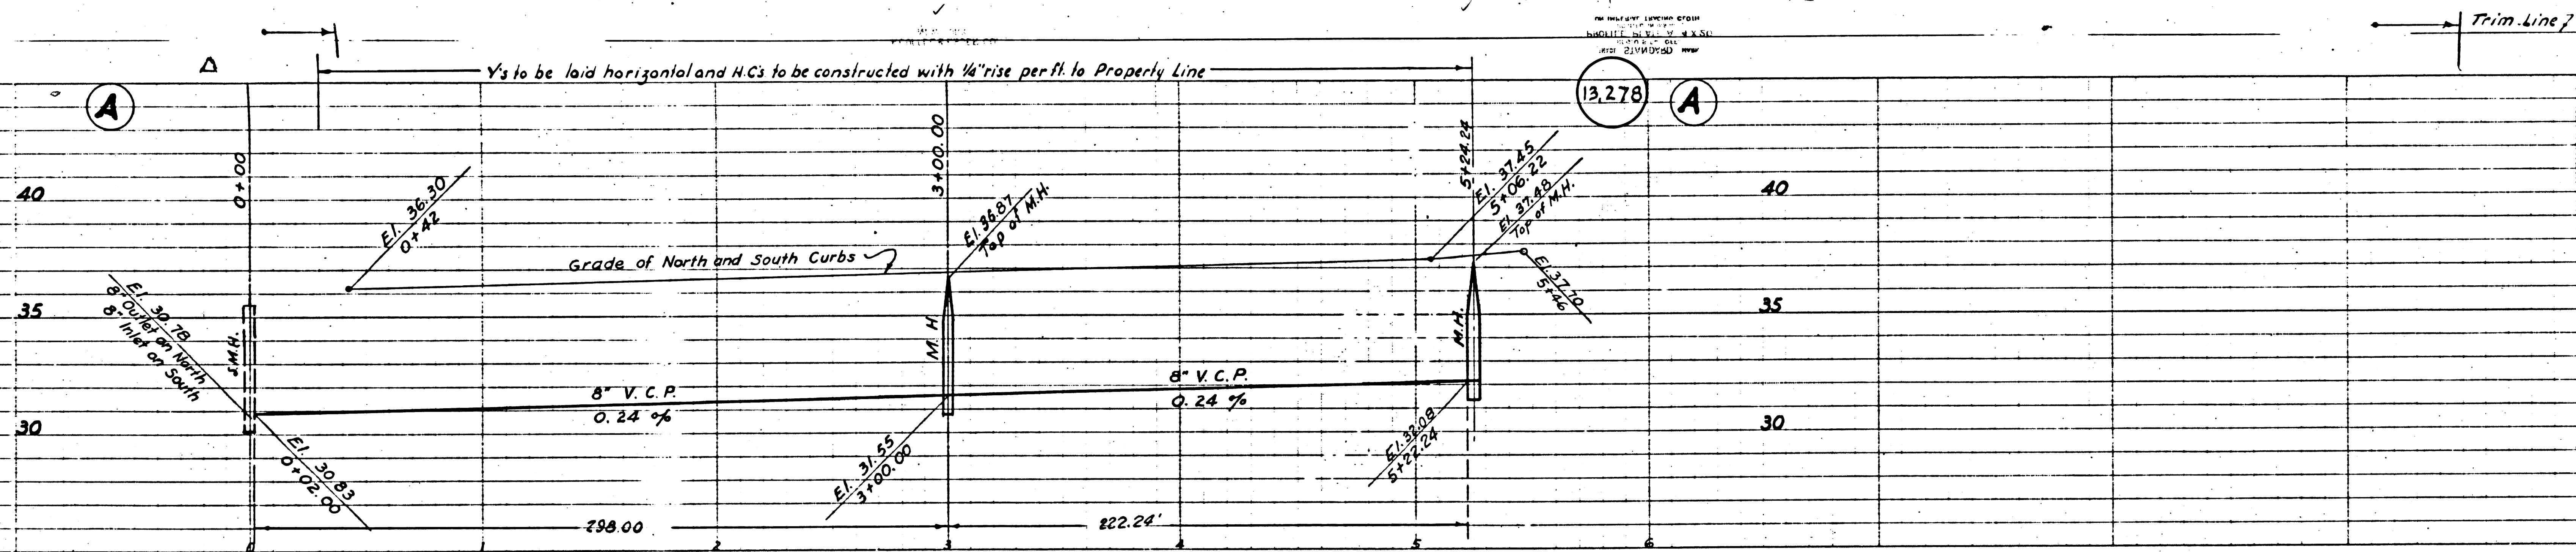

PLAN PROFILE AND GRADE OF **2**

SANITARY SEWERS

TO BE CONSTRUCTED IN

233RD STREET

BETWEEN MAIN ST. AND 234TH ST. (SOUTH)

232ND PLACE

BETWEEN MAIN ST. AND 232ND PL. (SOUTH)

231ST STREET

BETWEEN MAIN ST. AND 232ND ST. (NORTH)

230TH STREET

BETWEEN MAIN ST. AND 231ST ST. (SOUTH)

BETWEEN MAIN ST. AND 230TH ST. (NORTH)

PRIVATE CONTRACT NO 1708


M.S. 28 MARCH 1951

SHEET 2 OF 3 SHEETS

PREPARED IN THE OFFICE OF

LEONARD H. GOWDY

BY Leonard H. Gowdy REG. C.E. NO. 4813

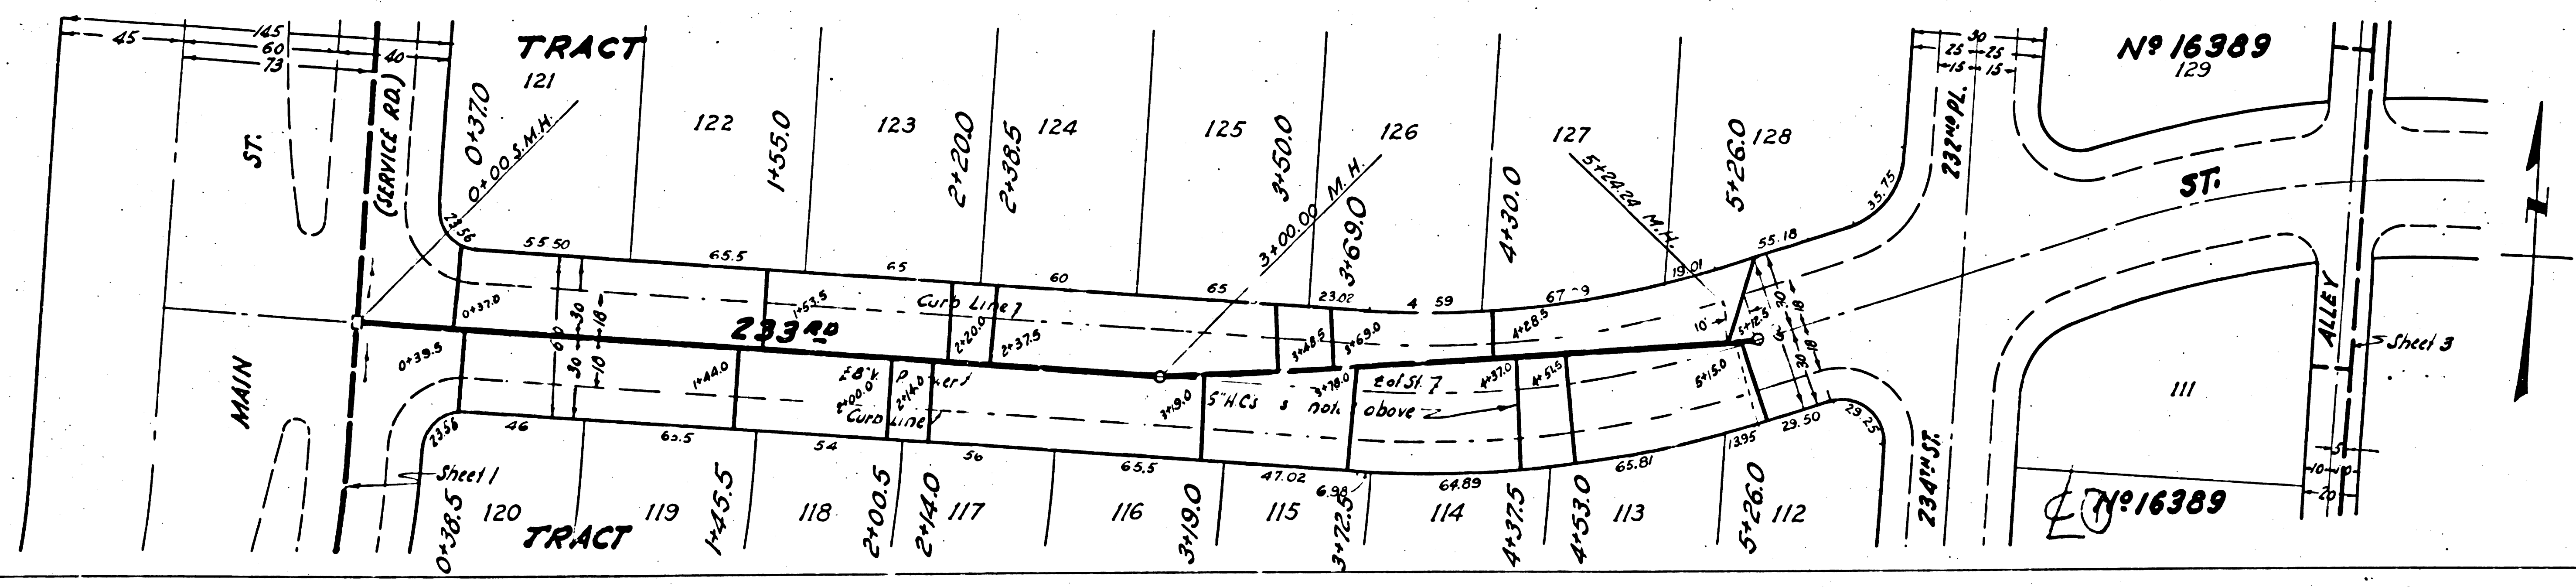

FOR LEGEND SEE PLAN N^o 3064

FOR CONSTRUCTION NOTES SEE SHEET 1

COUNTY OF LOS ANGELES CALIFORNIA

APPROVED BY [Signature] COUNTY ENGINEER



APPROVED BY [Signature] OFFICE ENGINEER



CHECKED BY Richard E. Kuhn 9-4-1951 OFFICE OF COUNTY ENGINEER, REG. C.E. NO. 7860



APR 10 1951

SHEET 2 OF 3 SHEETS

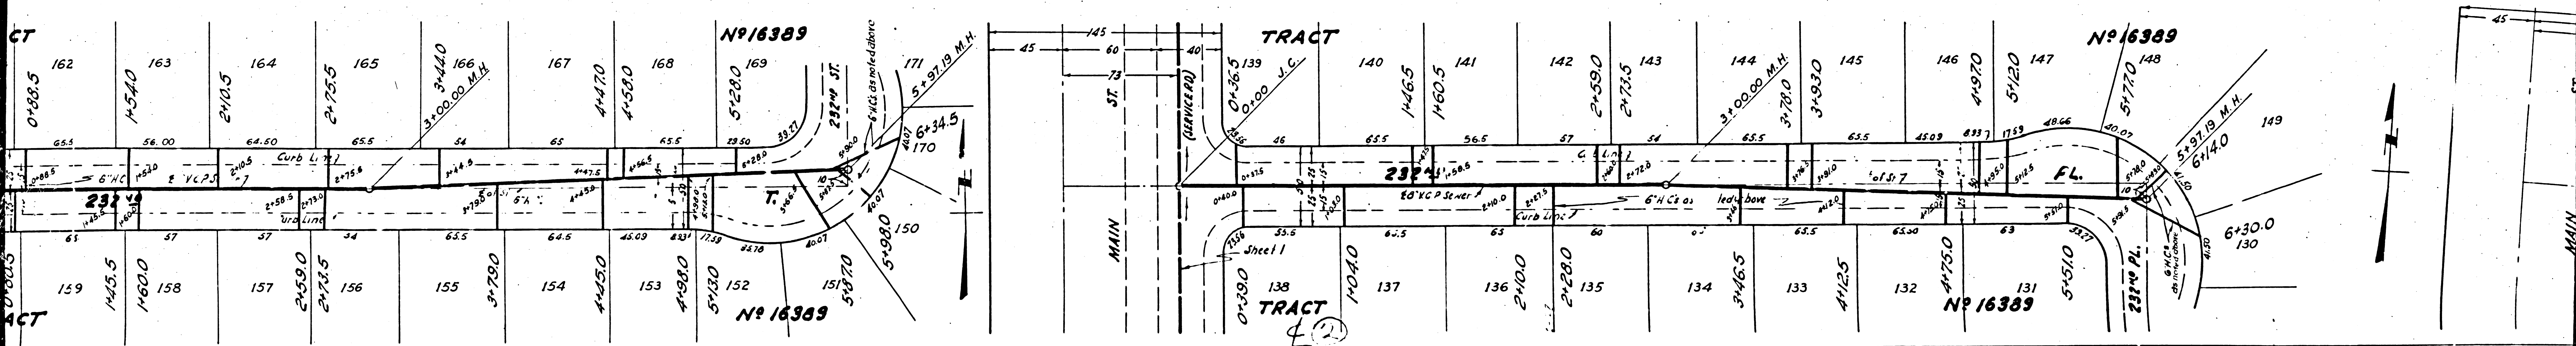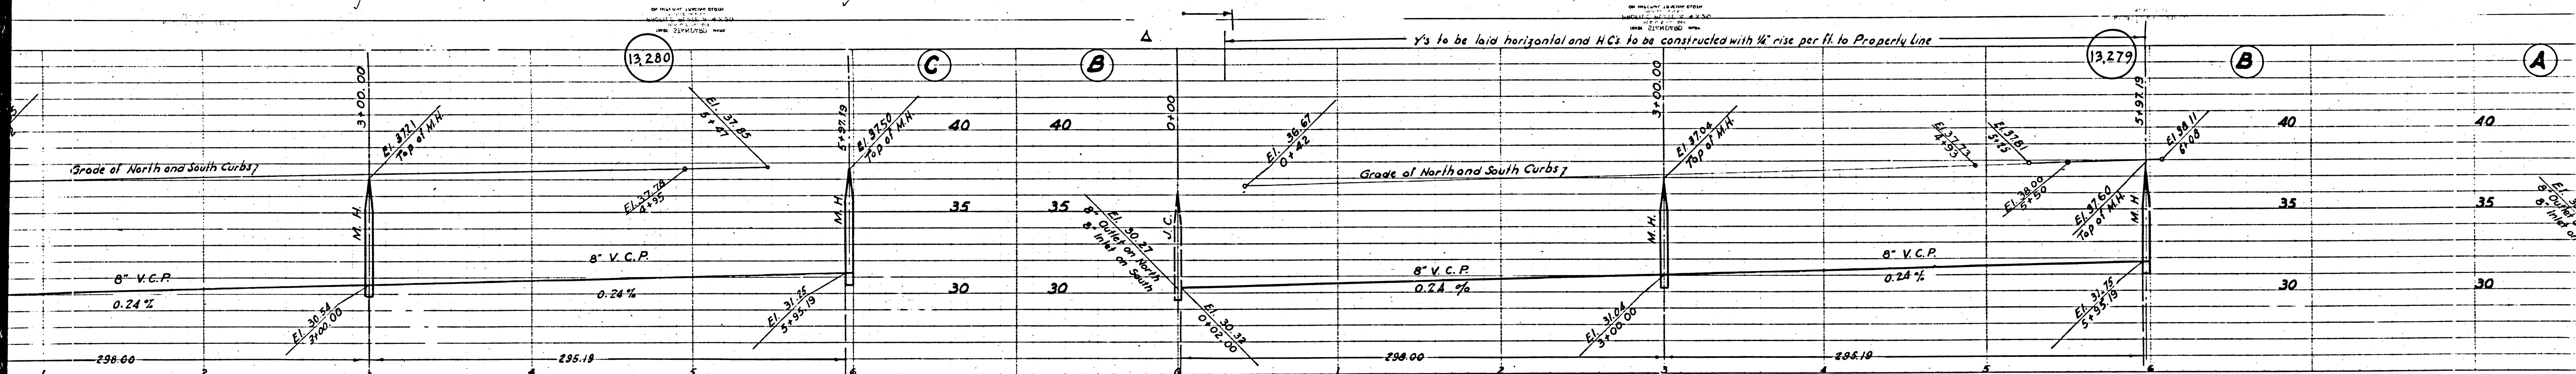


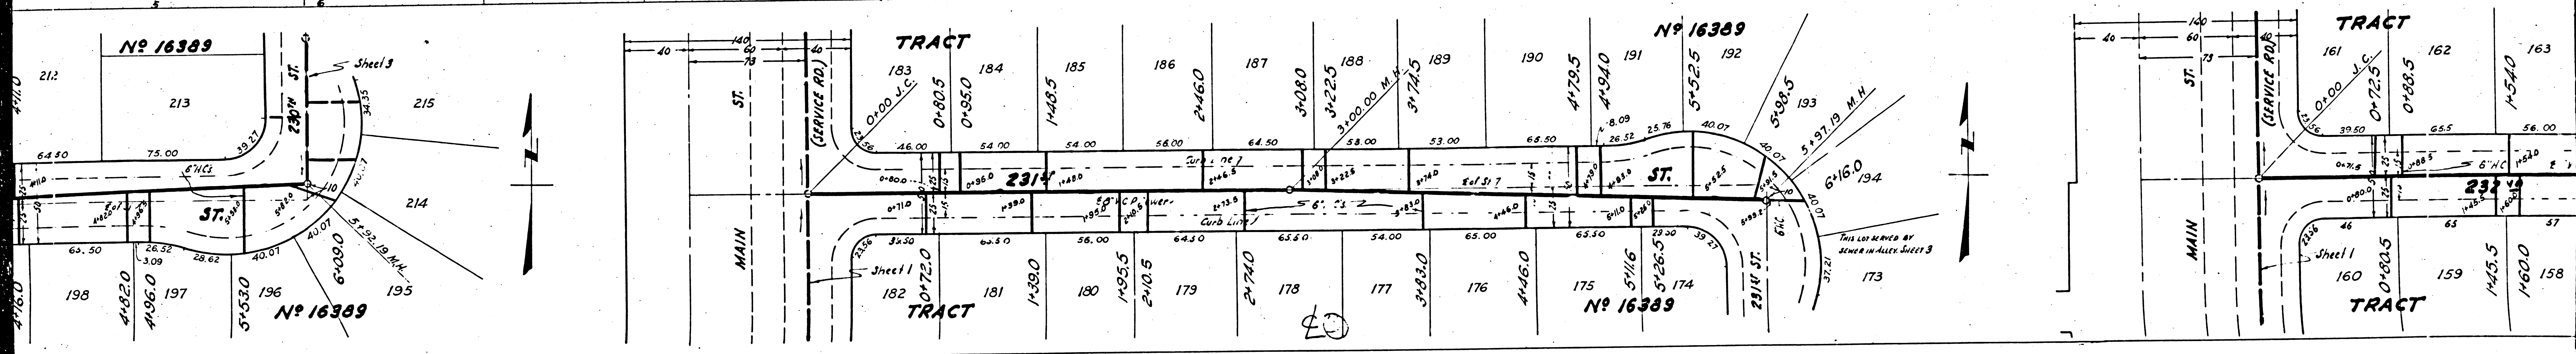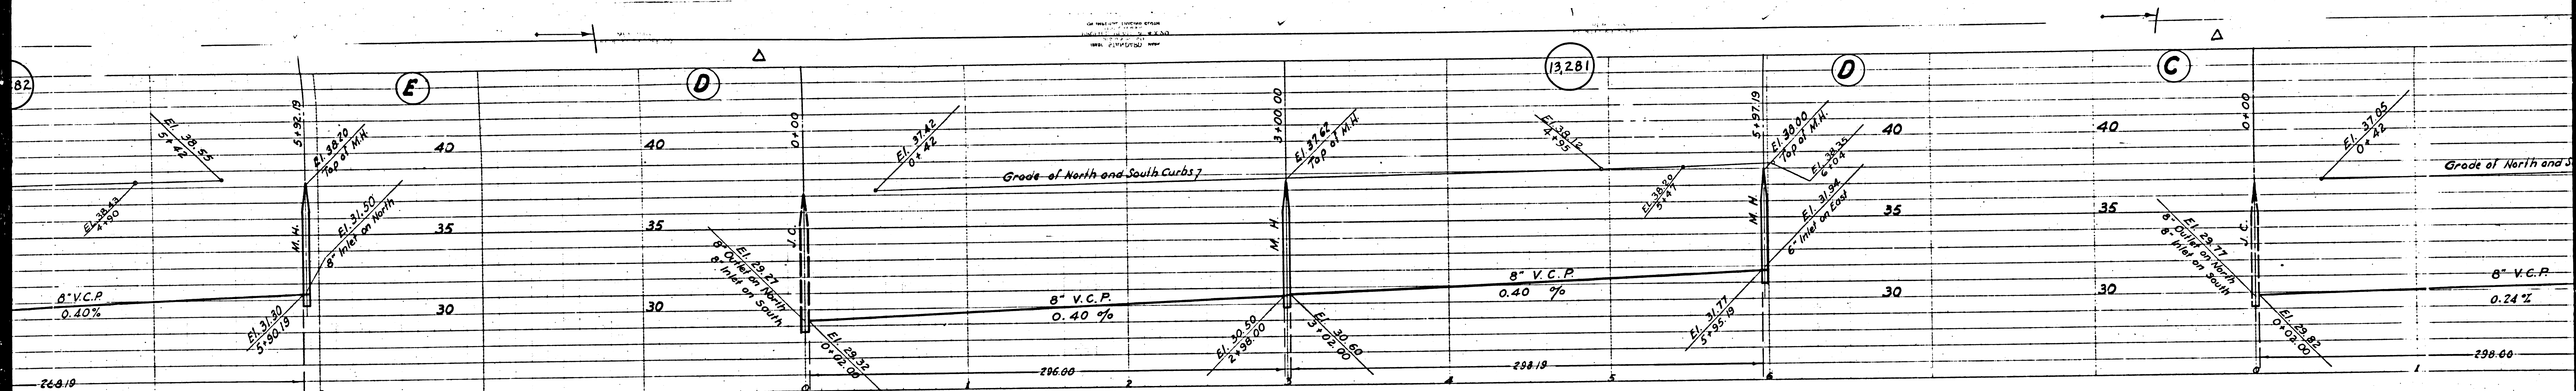

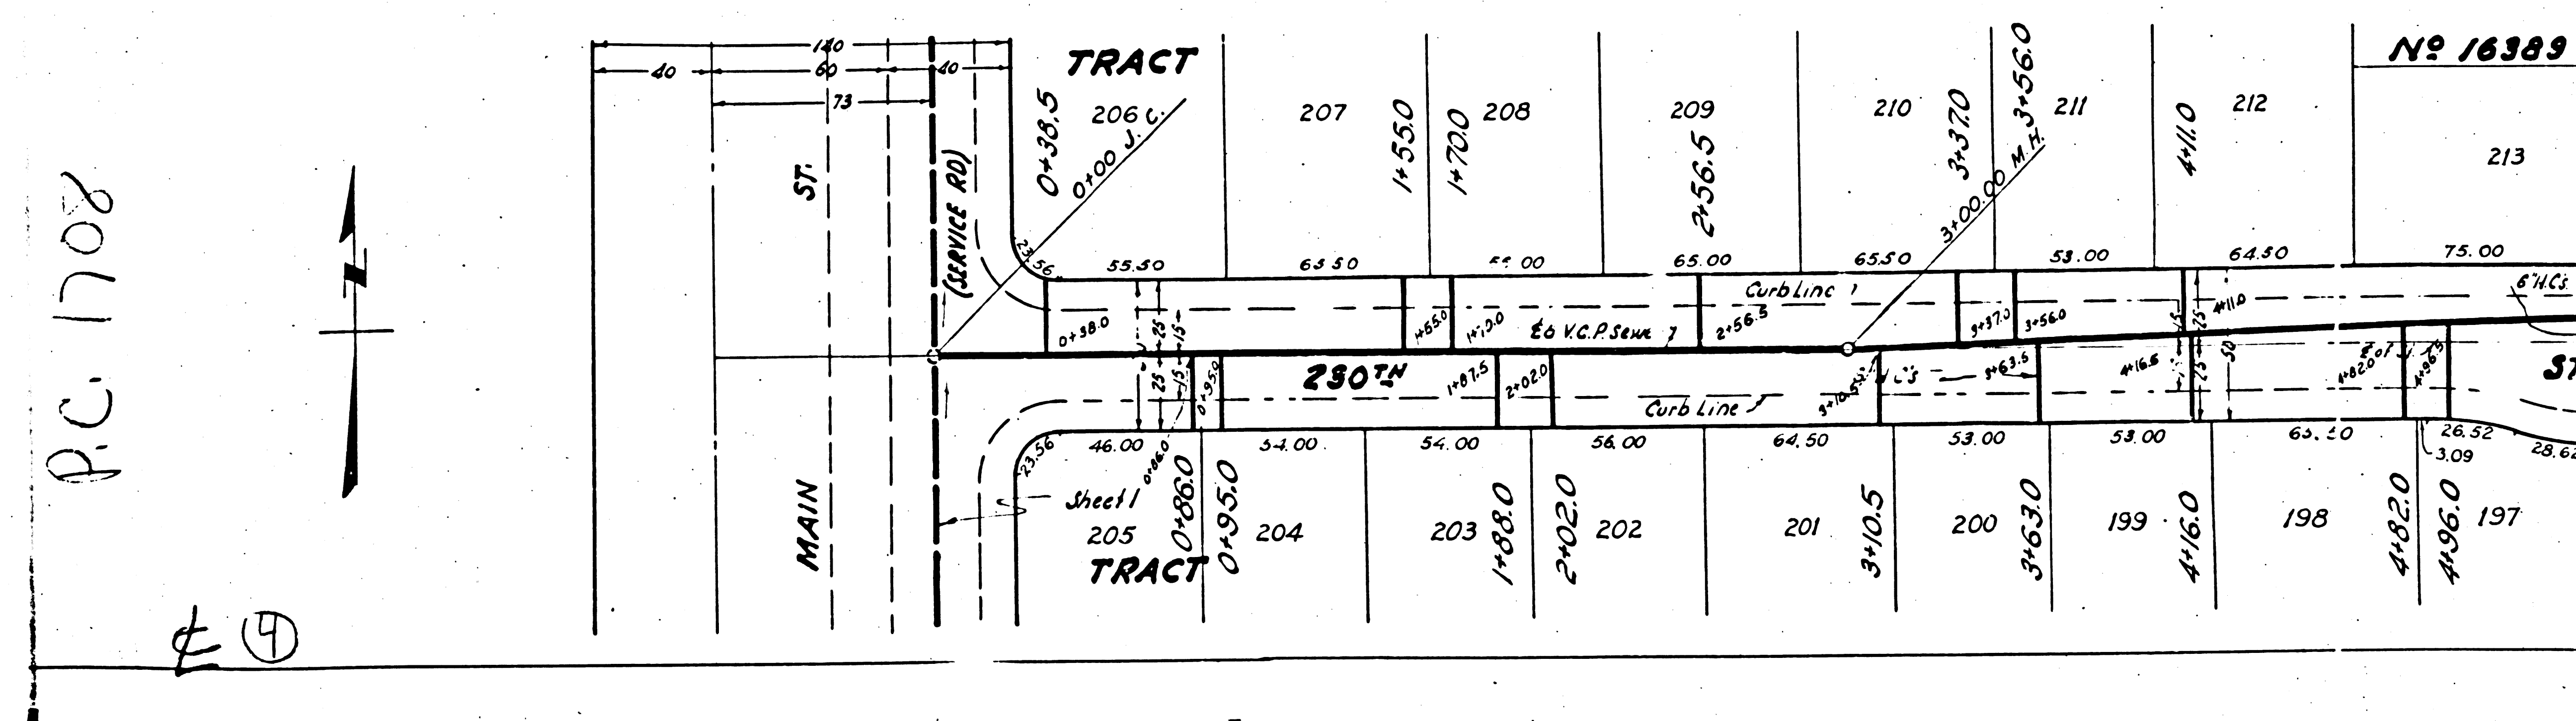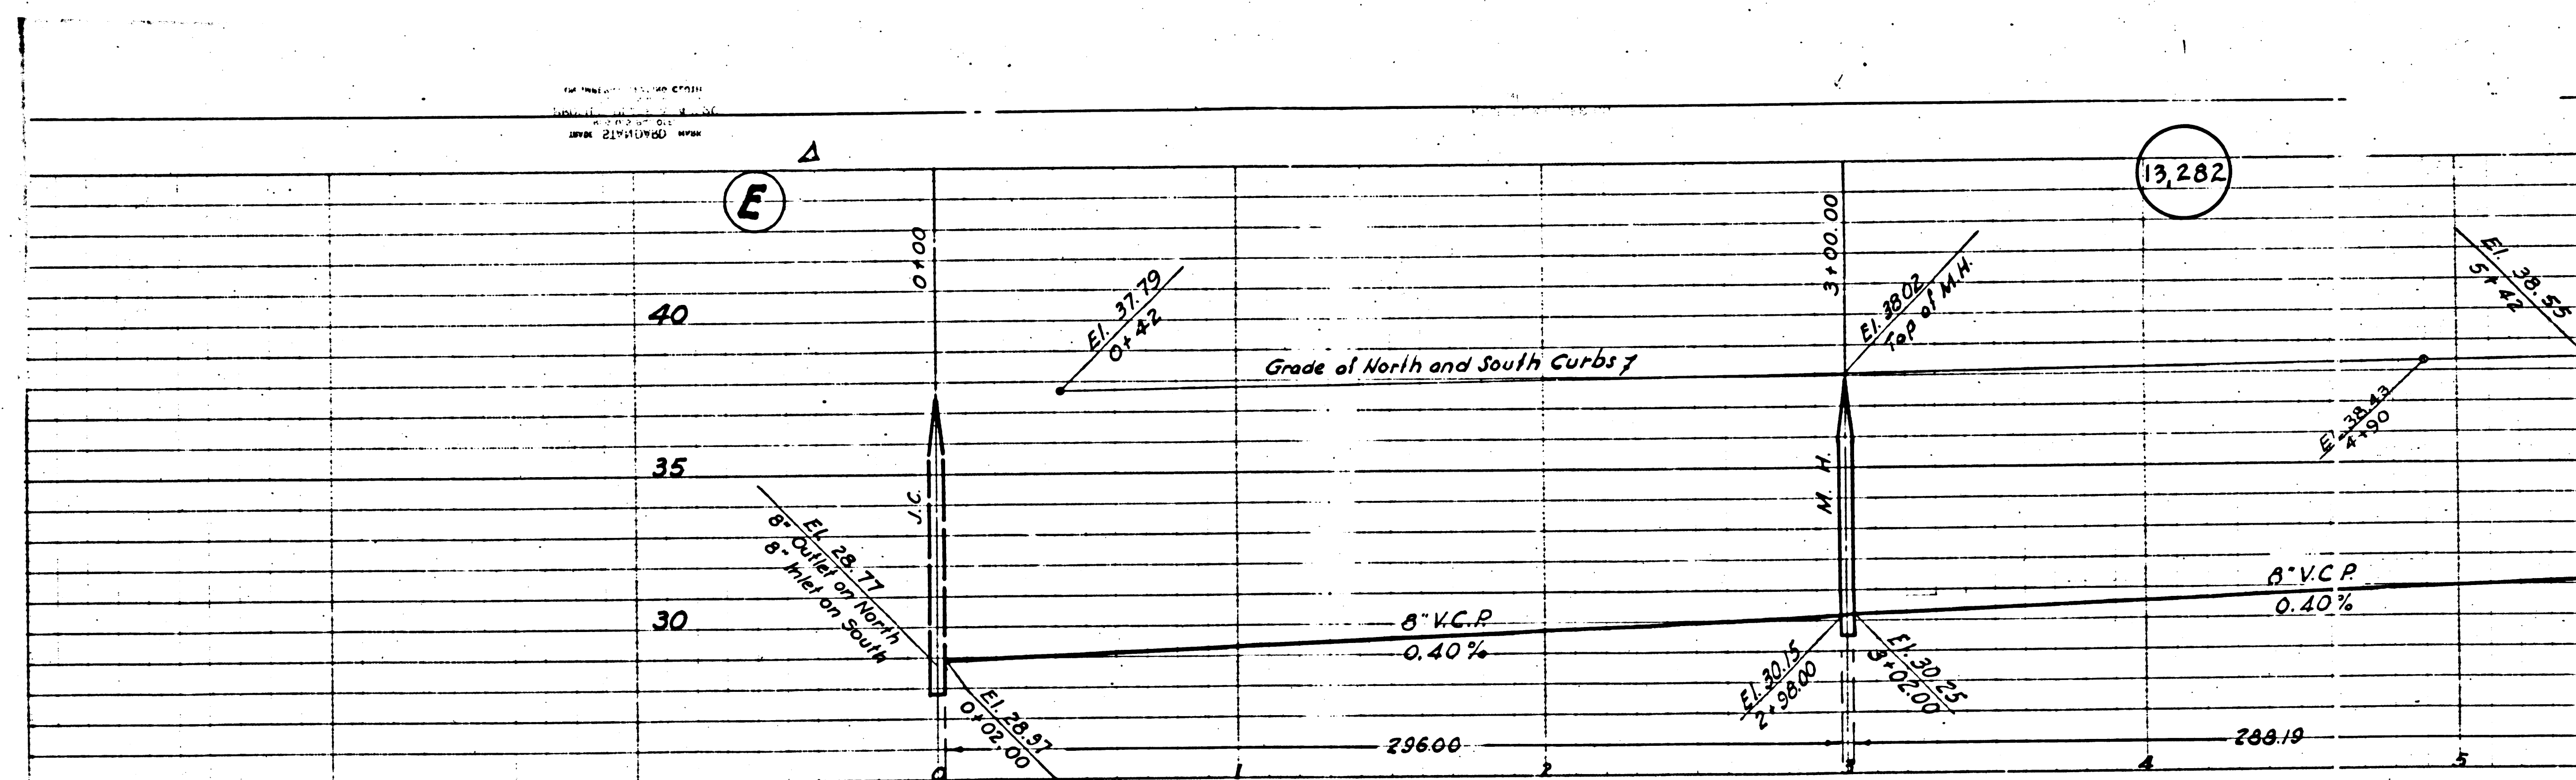


P.C. 1708

⊕

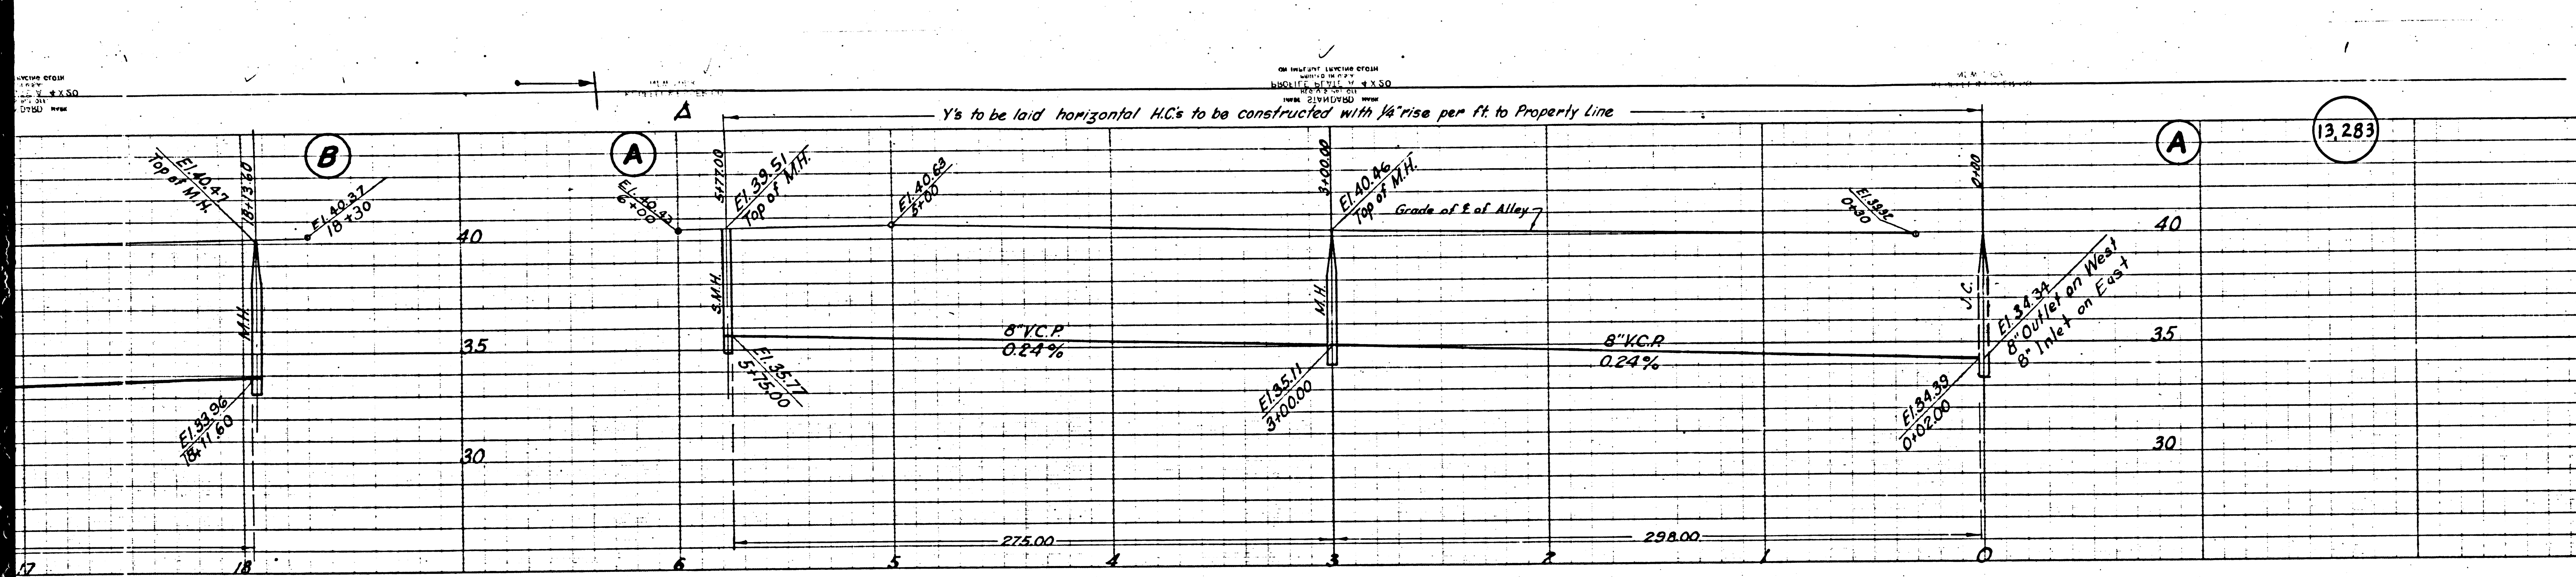

PLAN PROFILE AND GRADE OF **3**
SANITARY SEWERS
 TO BE CONSTRUCTED IN
FIRST ALLEY WEST OF DOLORES STREET
 BETWEEN NORTHERLY LINE OF TRACT NO. 18302 AND 229TH ST.
229TH STREET
 BETWEEN MAIN ST. AND 229TH ST. (SOUTH)
 BETWEEN 229TH ST. (WEST) AND A POINT 30 FT. SOUTHWEST
229TH PLACE
 BETWEEN MAIN ST. AND 229TH ST.
230TH STREET
 BETWEEN 230TH ST. (SOUTH) AND A POINT 60 FT. NORTHERLY
SANITARY SEWER RIGHT OF WAY
 IN LOT 252 TRACT NO. 18302
 PRIVATE CONTRACT NO. 1708
 W.S. 28 MARCH 1951
 SCALE VERT. 1" = 4'
 HORIZ. 1" = 40'
SHEET 3 OF 3 SHEETS


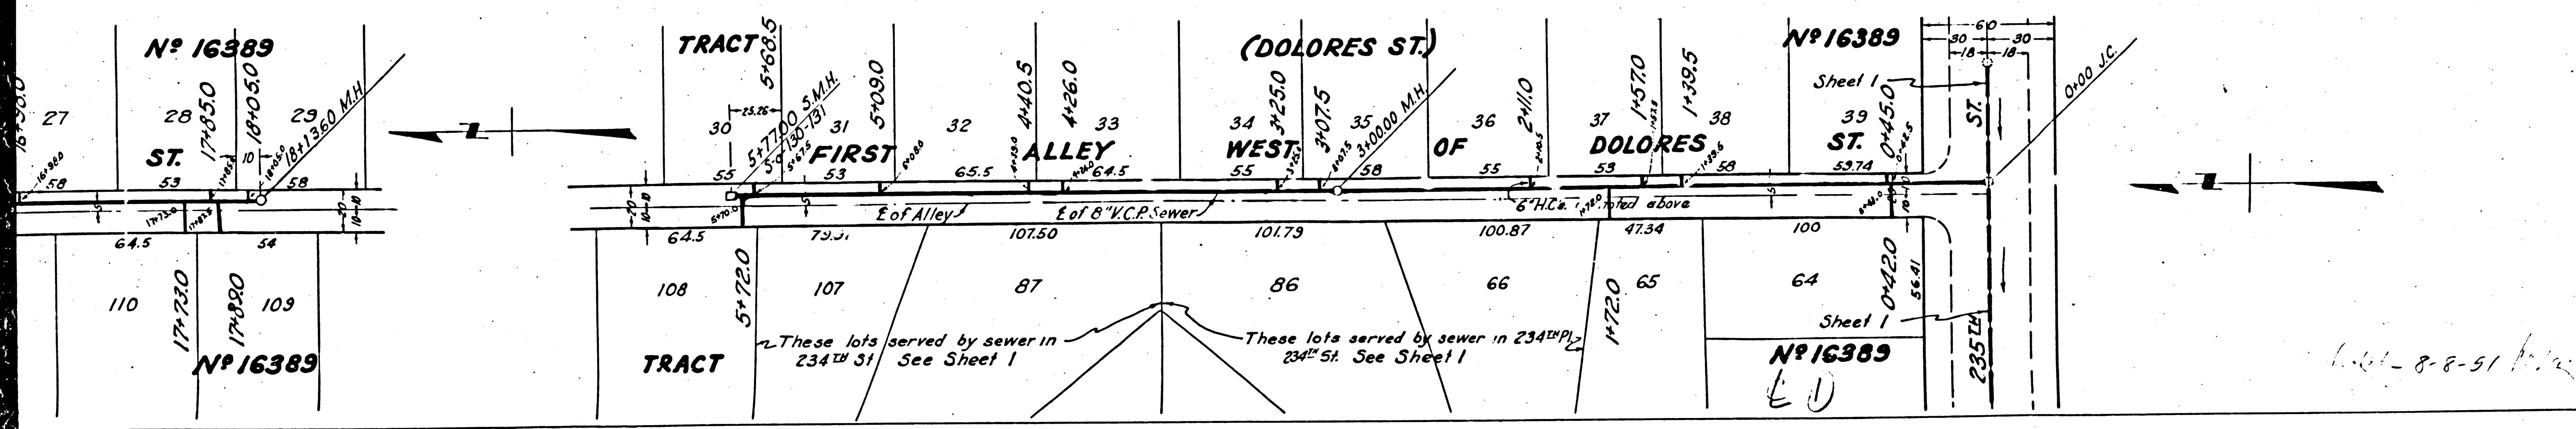


PREPARED IN THE OFFICE OF
LEONARD H. GOWDY
Leonard H. Gowdy
 416 C.E. NO. 4815
 FOR LEGEND
 SEE PLAN NO. 2-64
 RECEIVED
 APR 10 1951
 COUNTY ENGINEER
 COUNTY OF LOS ANGELES
 OFFICE ENGINEER
 APPROVED BY *[Signature]*
 CHECKED BY *[Signature]* 4-2-1951
 OFFICE OF COUNTY ENGINEER, 416 C.E. NO. 7860
 SHEET 3 OF 3 SHEETS

BY MUTUAL SERVICE CROSS
 SQUARES SET TO 1" = 4.130'
 DATE: 11/11/20
 SHEET: 13,284







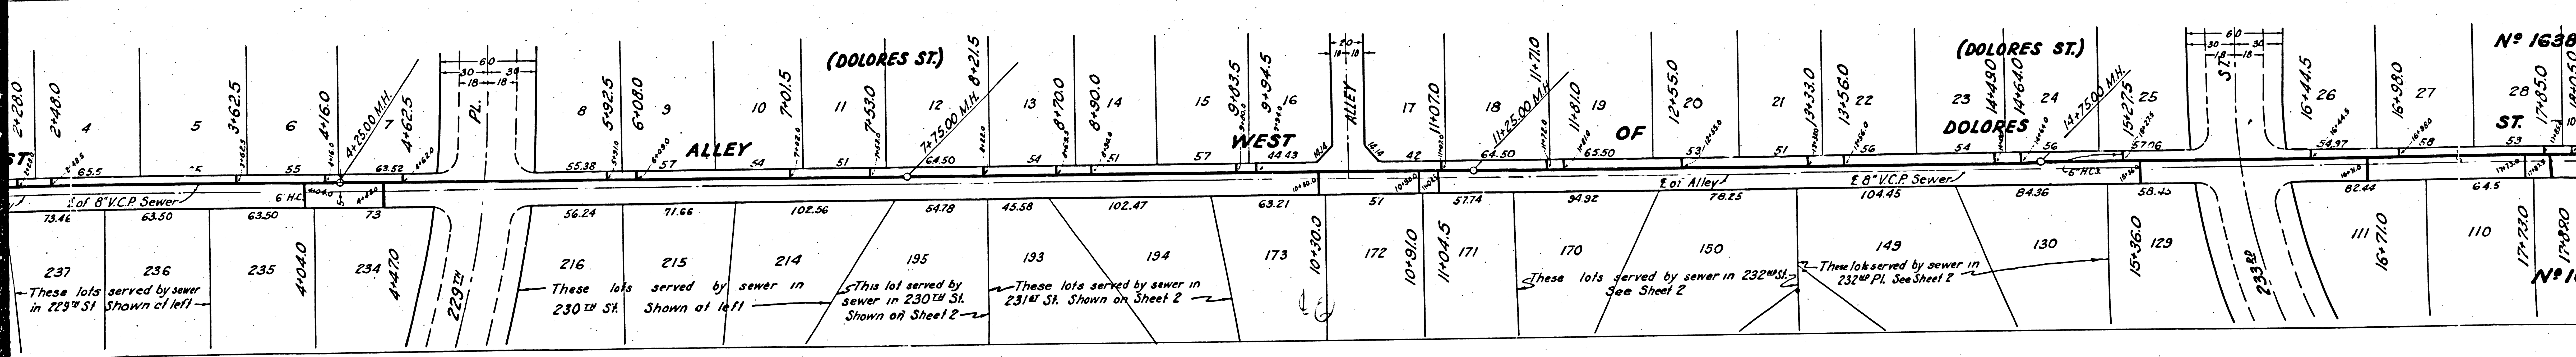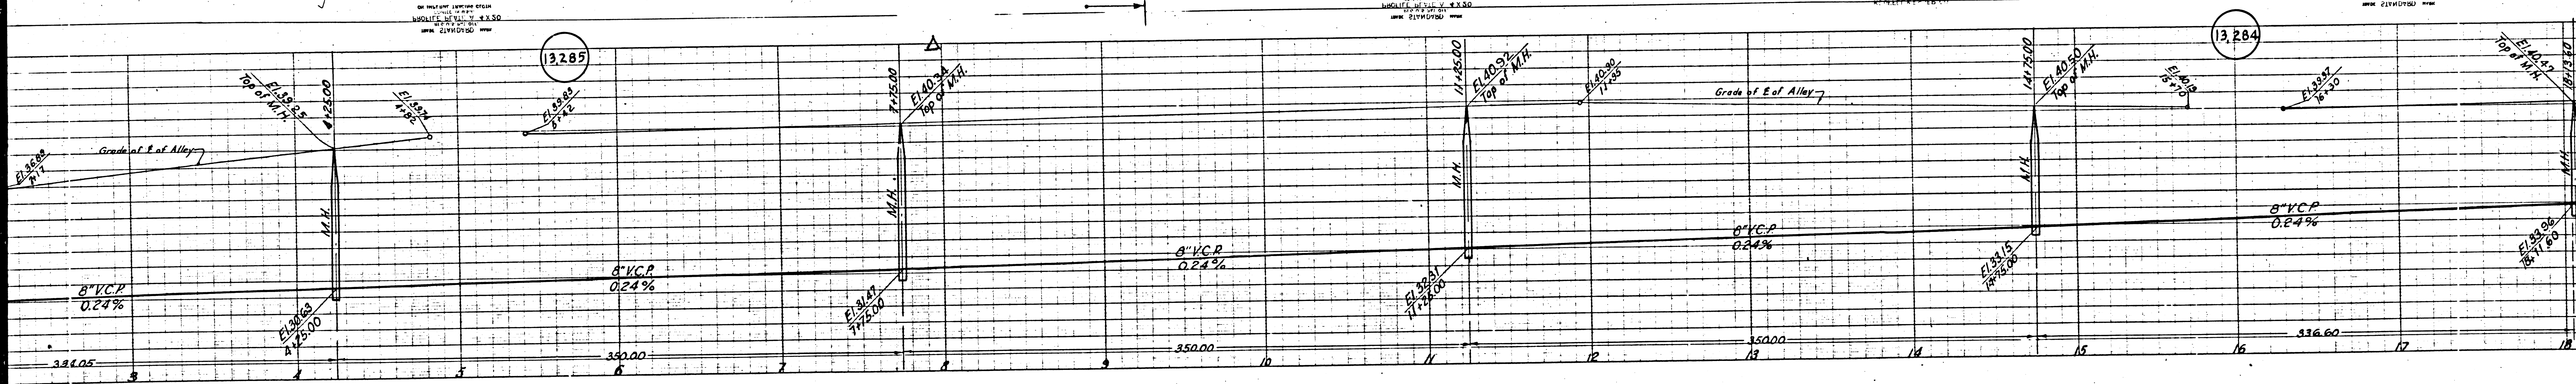

N^o 16385
 ST.
 53

N^o 16380

EXTRA STRENGTH PIPE IN MAIN LINE AND HOUSE CONNECTIONS

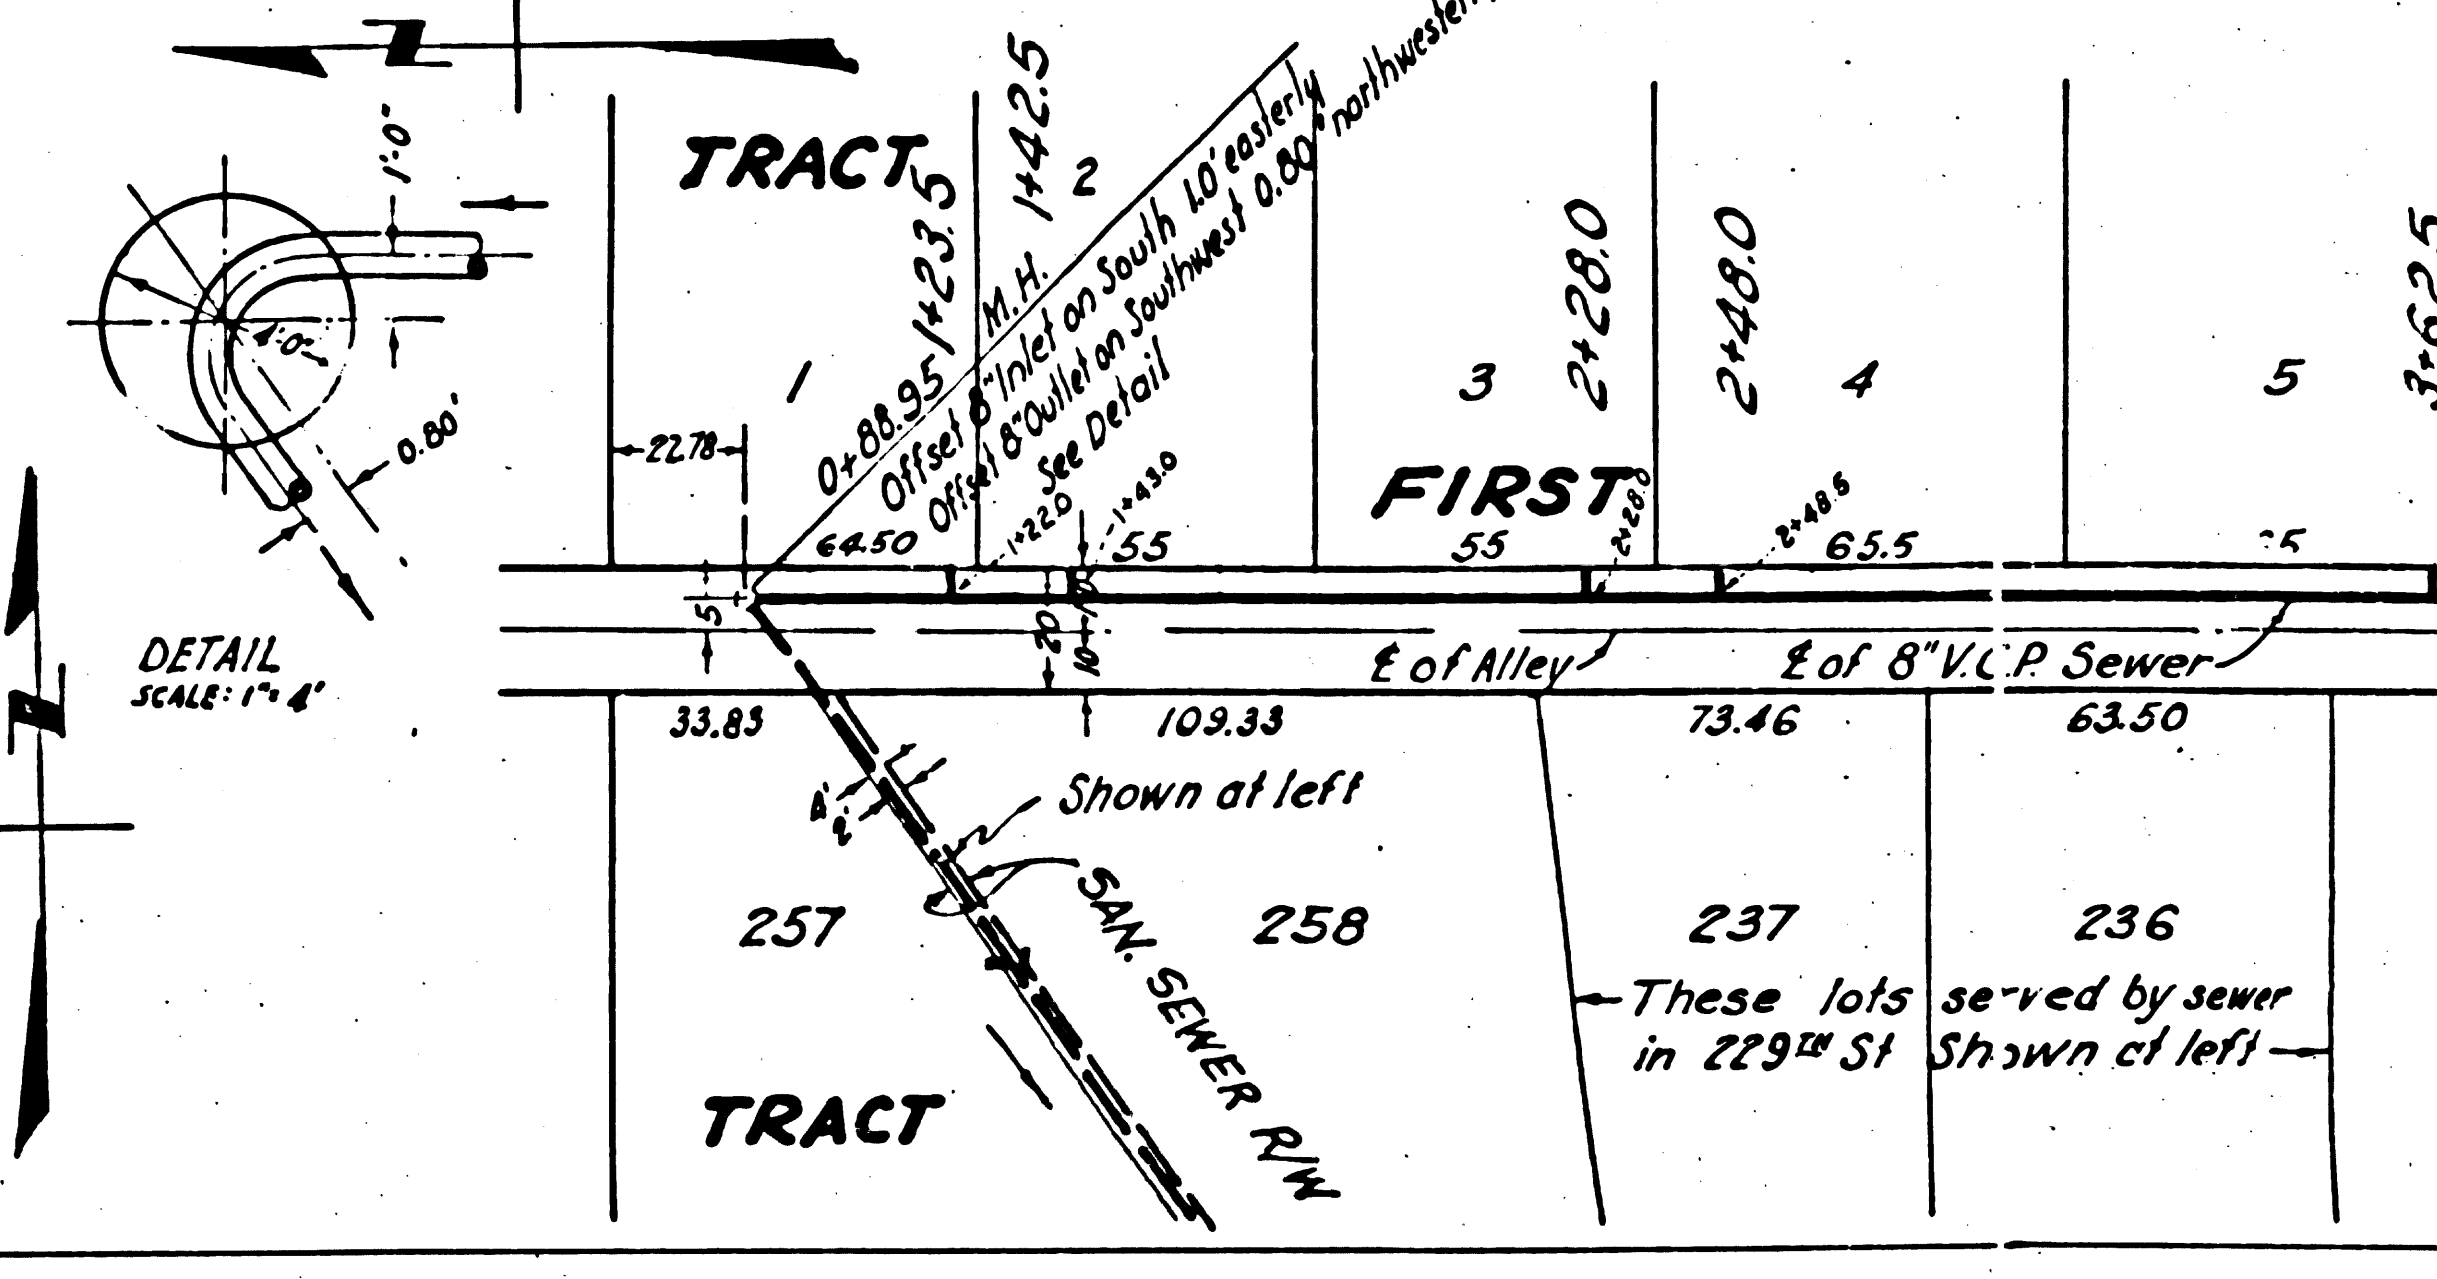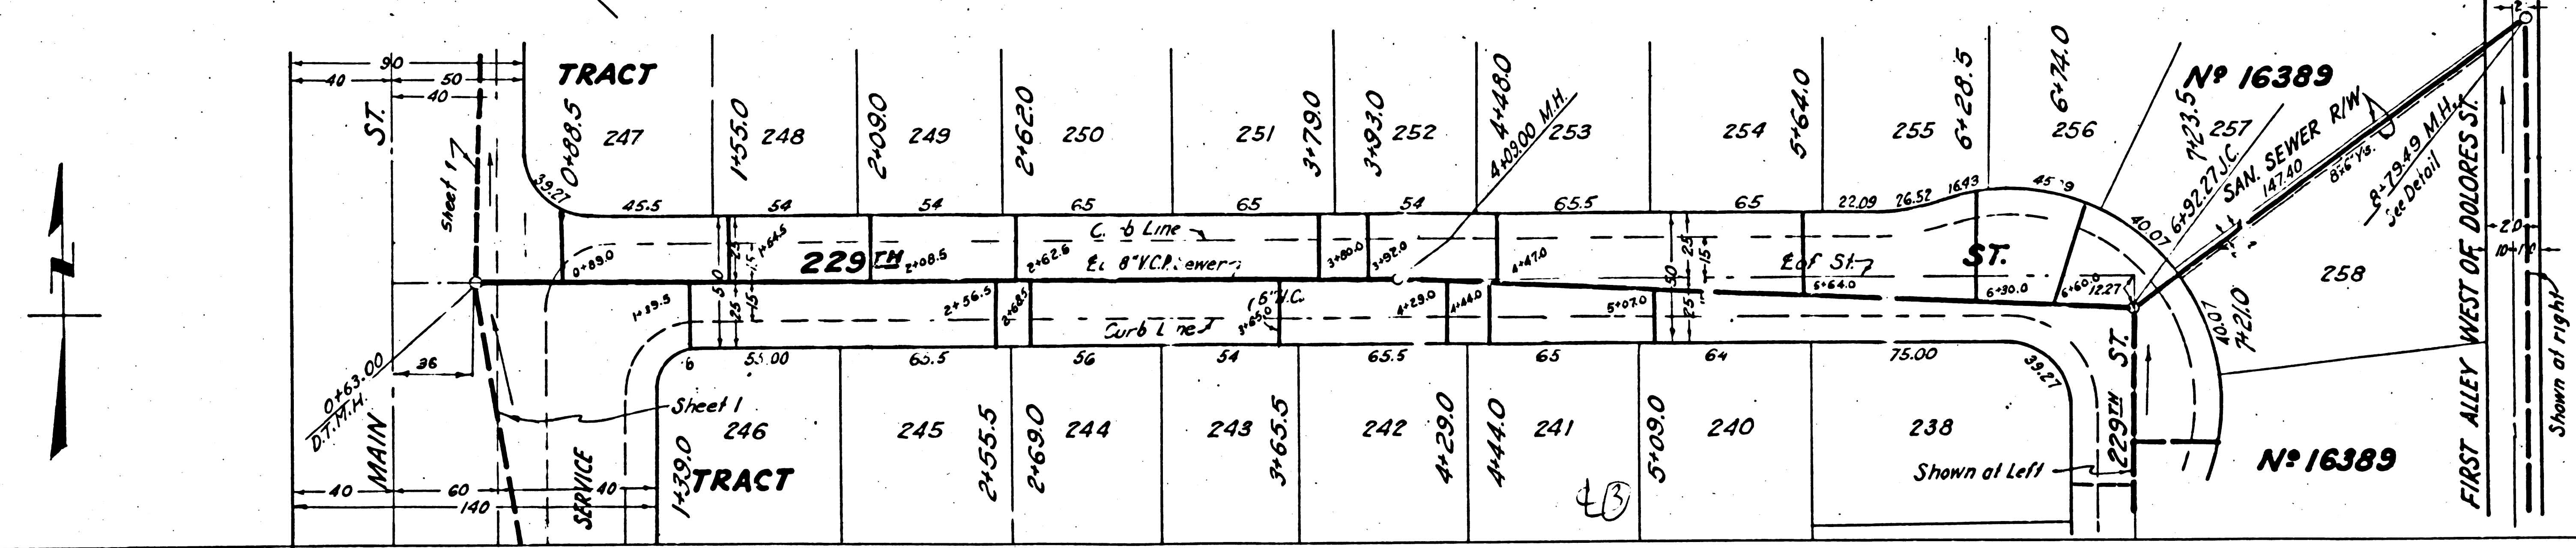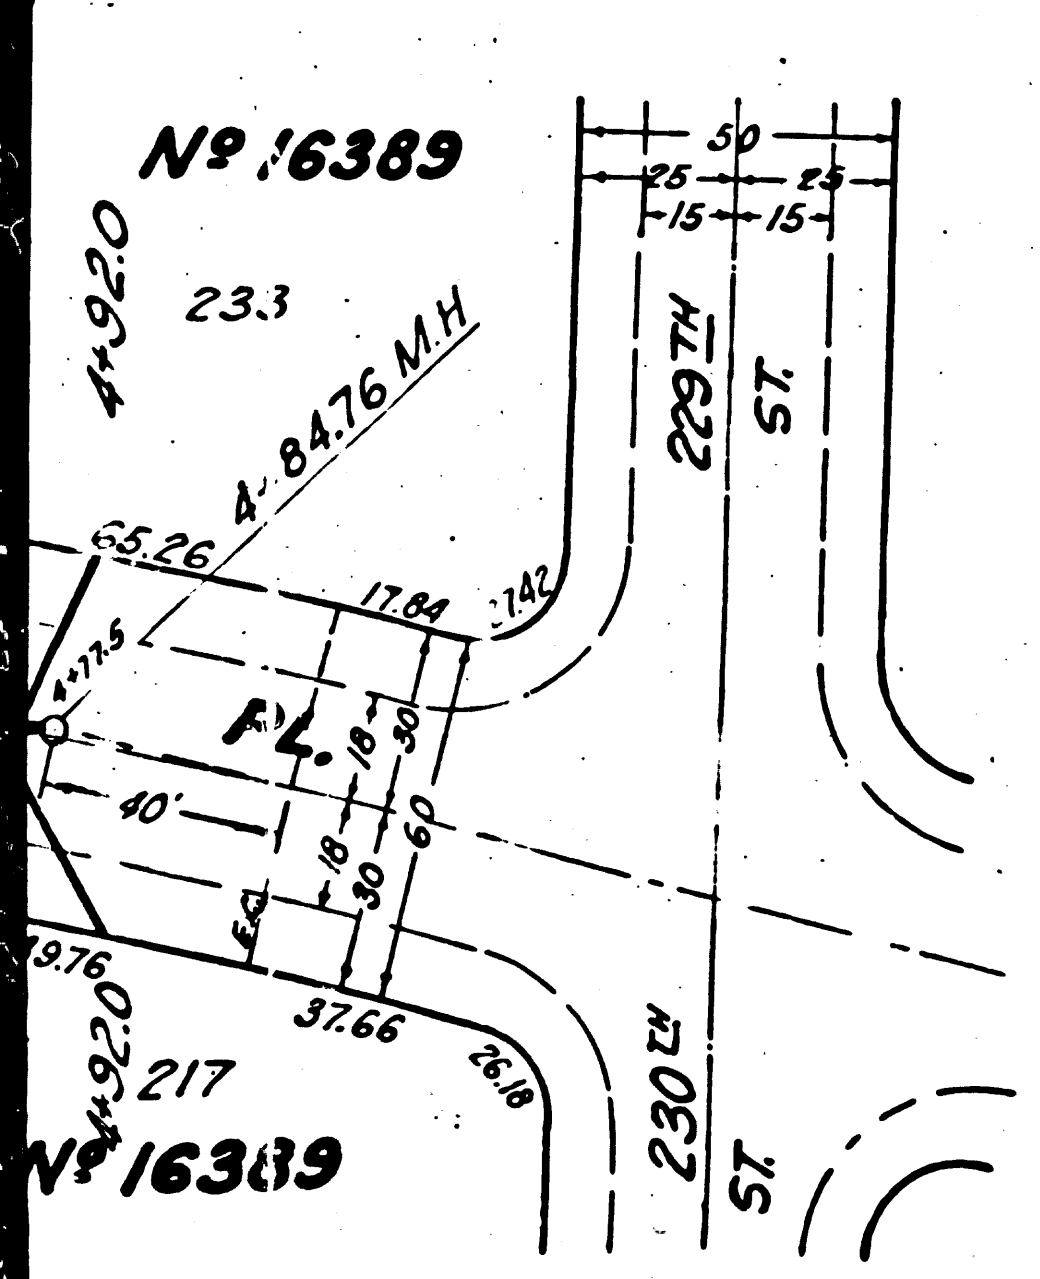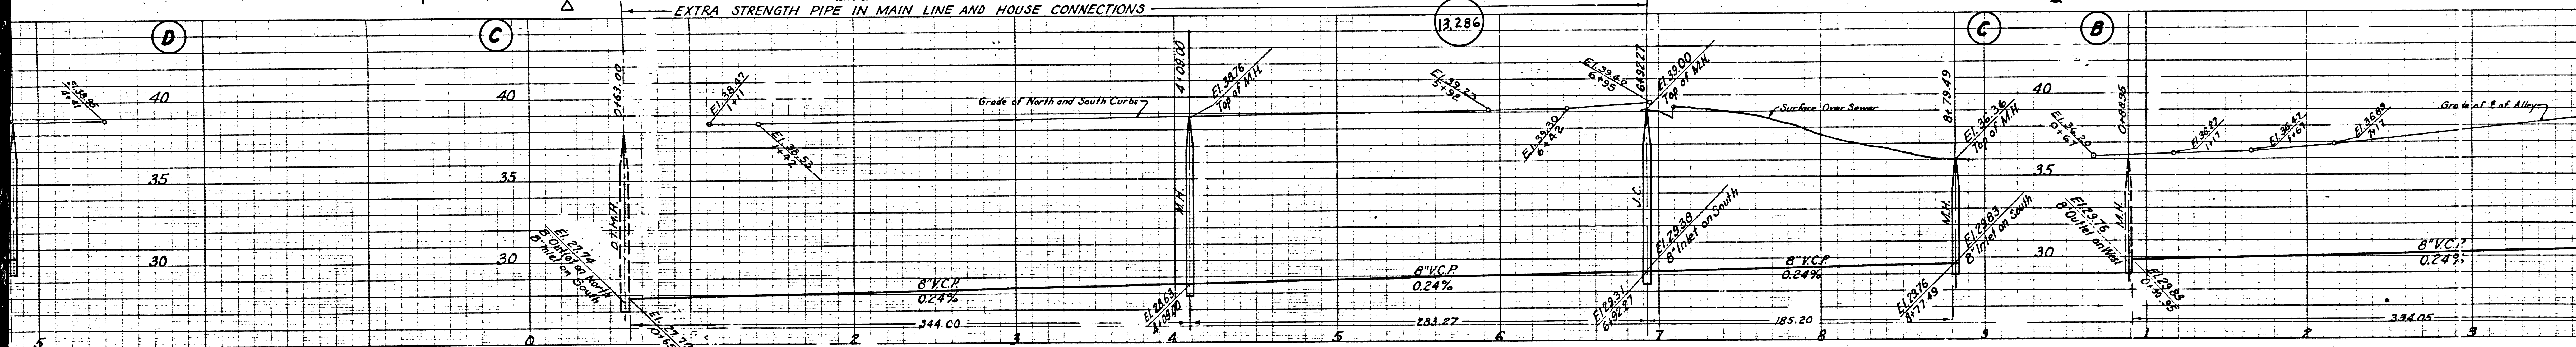

ON PLANNED LAYOUT FROM
ASBUILT RECORDS
REVISIONS
DATE


