

BM 56 1091 USGS. Mon. brass nail  
 SE. Cor. weir box 1536 22' E/E  
 Puente Ave 186' S/S Francisco Ave.  
 Elev. 337.588

**PUENTE BLDG. DIST. No 2**

- NOTE:**
1. Provide stakes on the property lines or property lines produced at right angles to the sewer line at the center line of each manhole.
  2. The owner or his authorized representative shall furnish the County Engineer with grade sheets and stations for all house laterals and Y branches and shall provide stakes for them at their proper locations with stationing plainly marked. Any change in location shall be requested in writing by the owner or his representative.
  3. No revisions shall be made in these plans without the approval of the County Engineer.
  4. Use standard manhole frames and covers, S-a-117.
  5. Use standard strength pipe except as noted.
  6. Use cement mortar for all vitrified clay pipe joints.
  7. Resurface all trench within paved area to meet L.A. County Road Dept. or California State Highway Dept. requirements in accordance with permit.
  8. Encase four feet of sewer at points of interference with poles, S-a-119.
  9. House laterals to be constructed with inverts at property line 6 feet below curb grade except as noted.
  10. All structures shall be brick sewer structures, Sta-104.
  11. For allowable leakage test, use Formula No. 1, Spec's., Sec. 51.
  12. Manhole tops in unimproved Rights-Of-Way to be 6" above finish grade.

PROFILE, ALIGNMENT AND GRADE OF  
**SANITARY SEWERS**  
 TO BE CONSTRUCTED IN

**TRACT No 21521**

PRIVATE CONTRACT NO. 3532  
 W. S. 46  
 2 SHEETS

Scale: VERT. 1" = 4'  
 HORIZ. 1" = 40'  
 JUNE 1955  
 PREPARED IN THE OFFICES OF  
**TREADWELL ENGINEERING CORPORATION**  
 W. G. Treadwell, Inc.  
 Reg. C. E. No. 410

21,593

FOR LEGEND SEE PLAN NO. S-a-64

**NOTE:**

Grades to which this improvement is to be constructed are shown on plans and profiles. Grade points for top of curb, center line of streets, or center line of alleys are shown by circles on profiles. At all points between designated points the grade shall be established so as to conform to a straight line drawn between said designated points.

Elevations are in feet above U.S.G.S. datum or mean sea level.

This drawing and the data hereon are hereby made a part of the specifications.


Work shall be constructed according to specifications on file in the office of the County Engineer and shall be prosecuted only in the presence of the County Engineer.

Before work can be started, the contractor must obtain a permit to work on County streets from the L.A. County Road Dept., 108 W. 2nd St. and make a deposit with the County Engineer, Room 324, 253 So. Broadway, sufficient to cover the cost of construction inspection and record plans.

Approval of this plan by the County of Los Angeles does not constitute representation as to the accuracy of the location of or the existence or non-existence of any underground utility, pipe, or structure within the limits of this project. This note applies to all sheets.

If work is to be done in a State Highway, a permit must be obtained from the State of California, Division of Highways, 120 South Spring Street.

SHEET No	PAGES
1	1-3
2	4-6

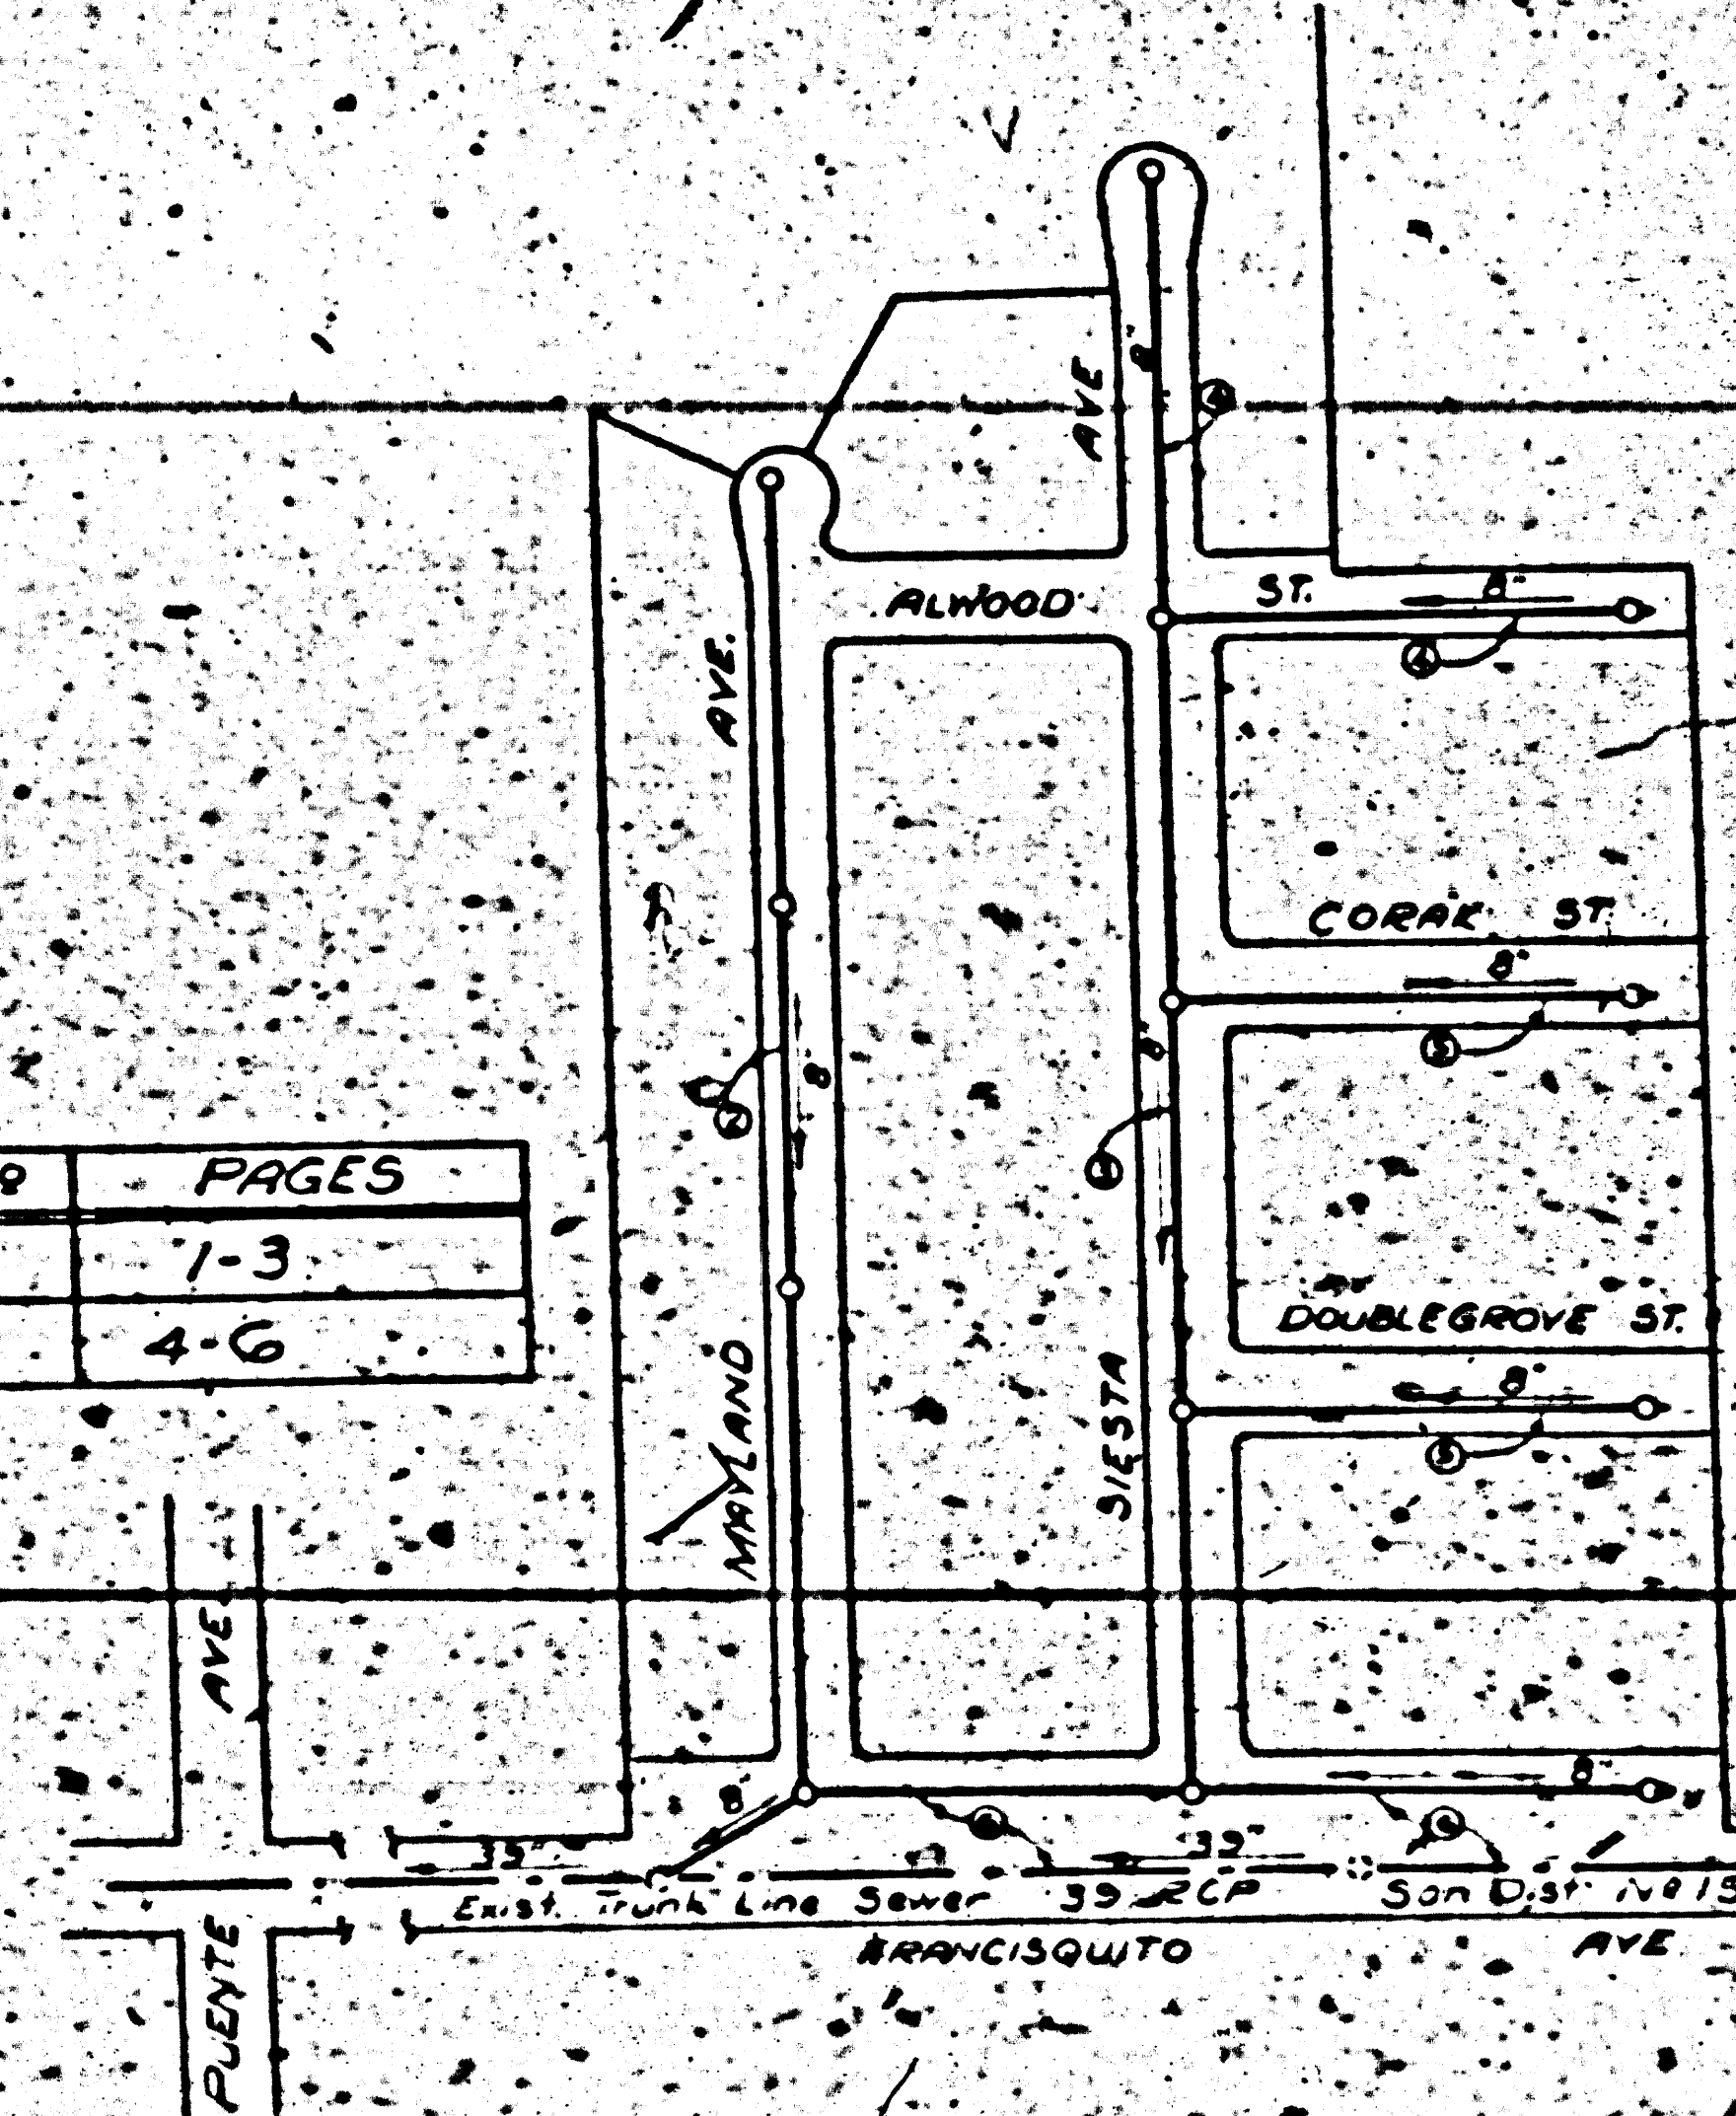


COLLECT CHARGES AS INDICATED  
 8-10-55

COUNTY OF LOS ANGELES, CALIFORNIA  
 APPROVED: William J. Fox, County Engineer  
 Chief Engr. CO SAN DIST NO 15  
 W. G. Treadwell, Inc.  
 Checked by: J. E. Suda 8-11-55  
 Office of County Engineer, Reg. C. E. No. 3406


NO CHARGE  
FOR CONNECTIONS

21594

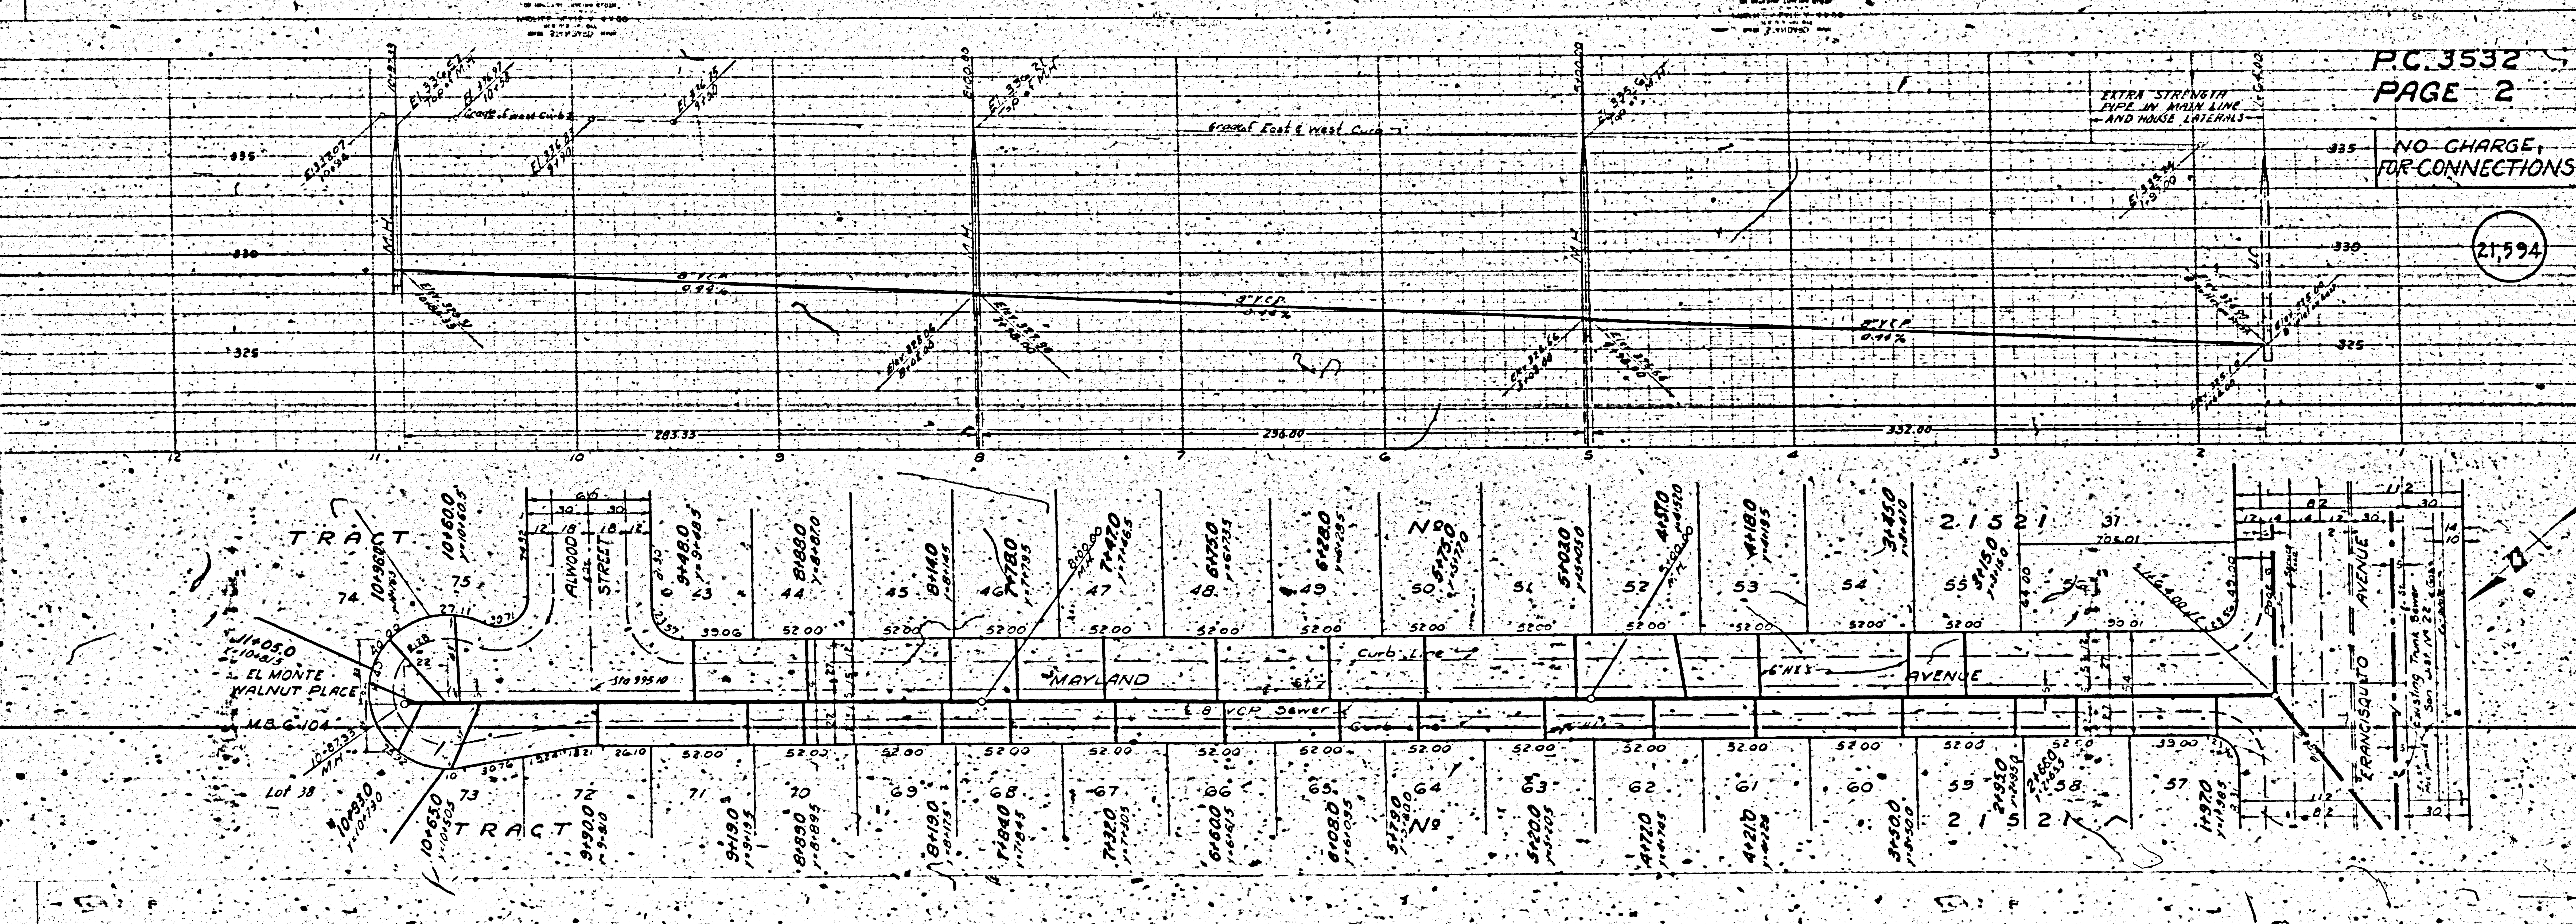

NO CHARGE  
FOR CONNECTIONS

21,595

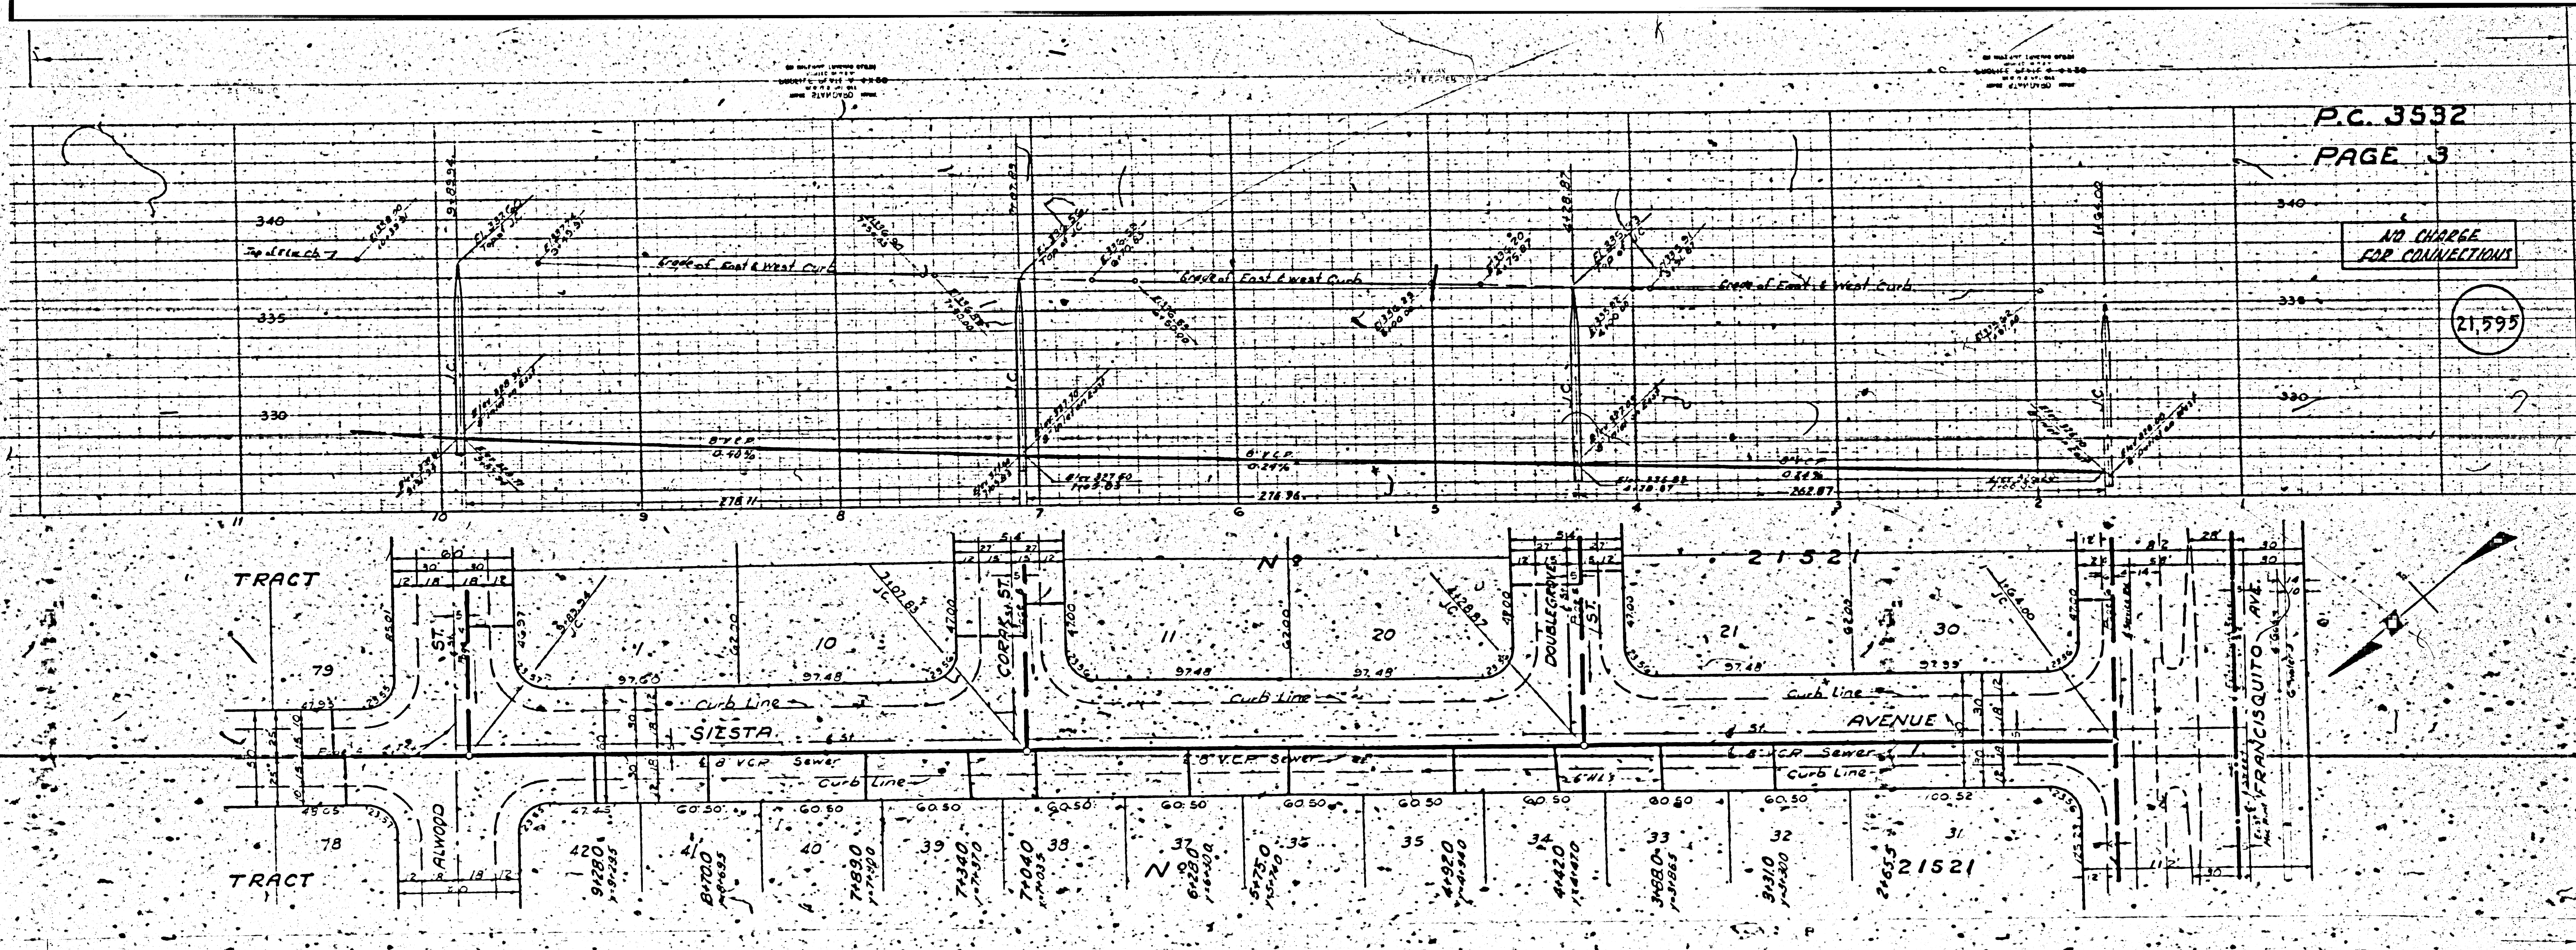


Trim Line 7

PC 3532  
PAGE 4

COLLECT CHARGES  
AS INDICATED

21596

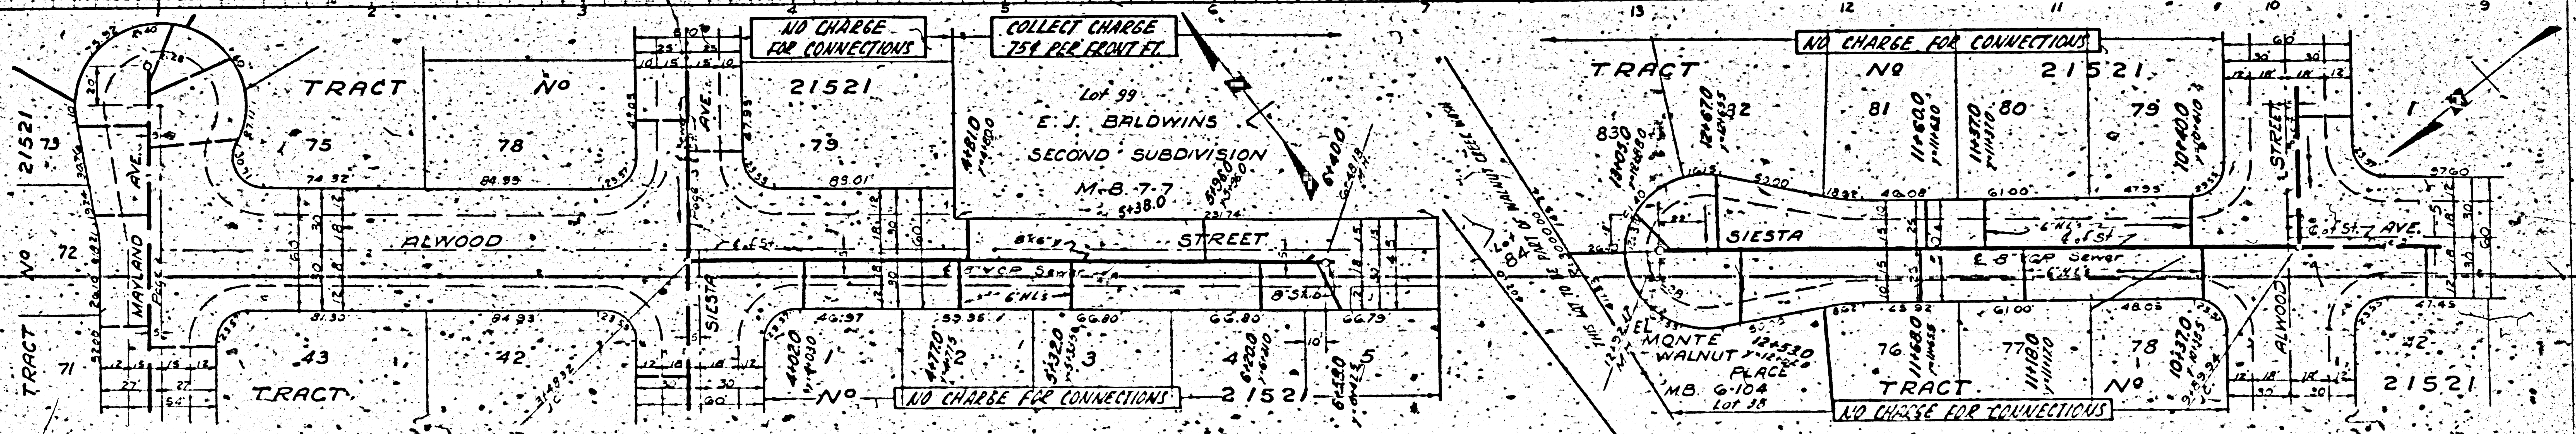


NO CHARGE FOR CONNECTIONS  
COLLECT CHARGE  
75¢ PER FRONT FT.

NO CHARGE FOR CONNECTIONS  
COLLECT CHARGE  
75¢ PER FRONT FT.

P.C. 3532  
PAGE 4


COLLECT CHARGES  
AS INDICATED

21596

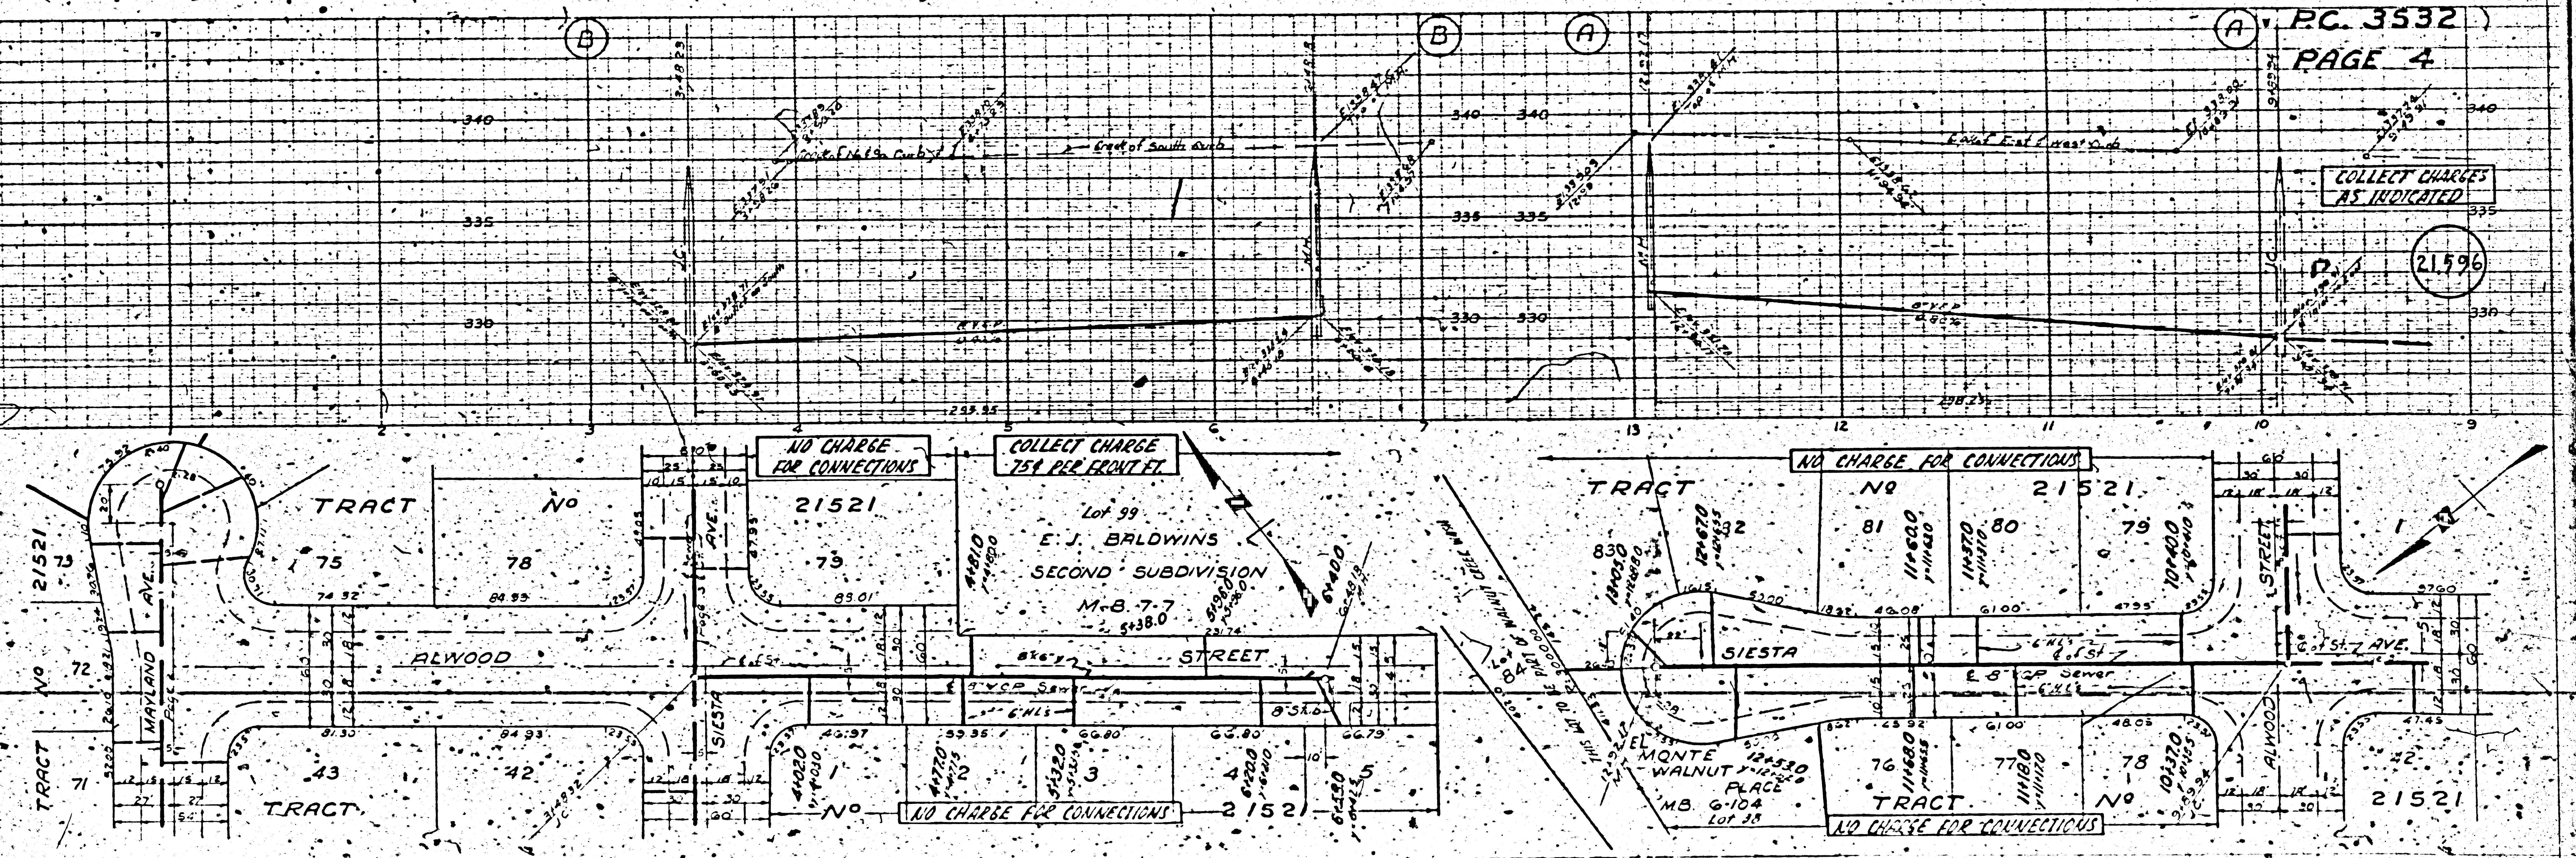

NO CHARGE  

21597

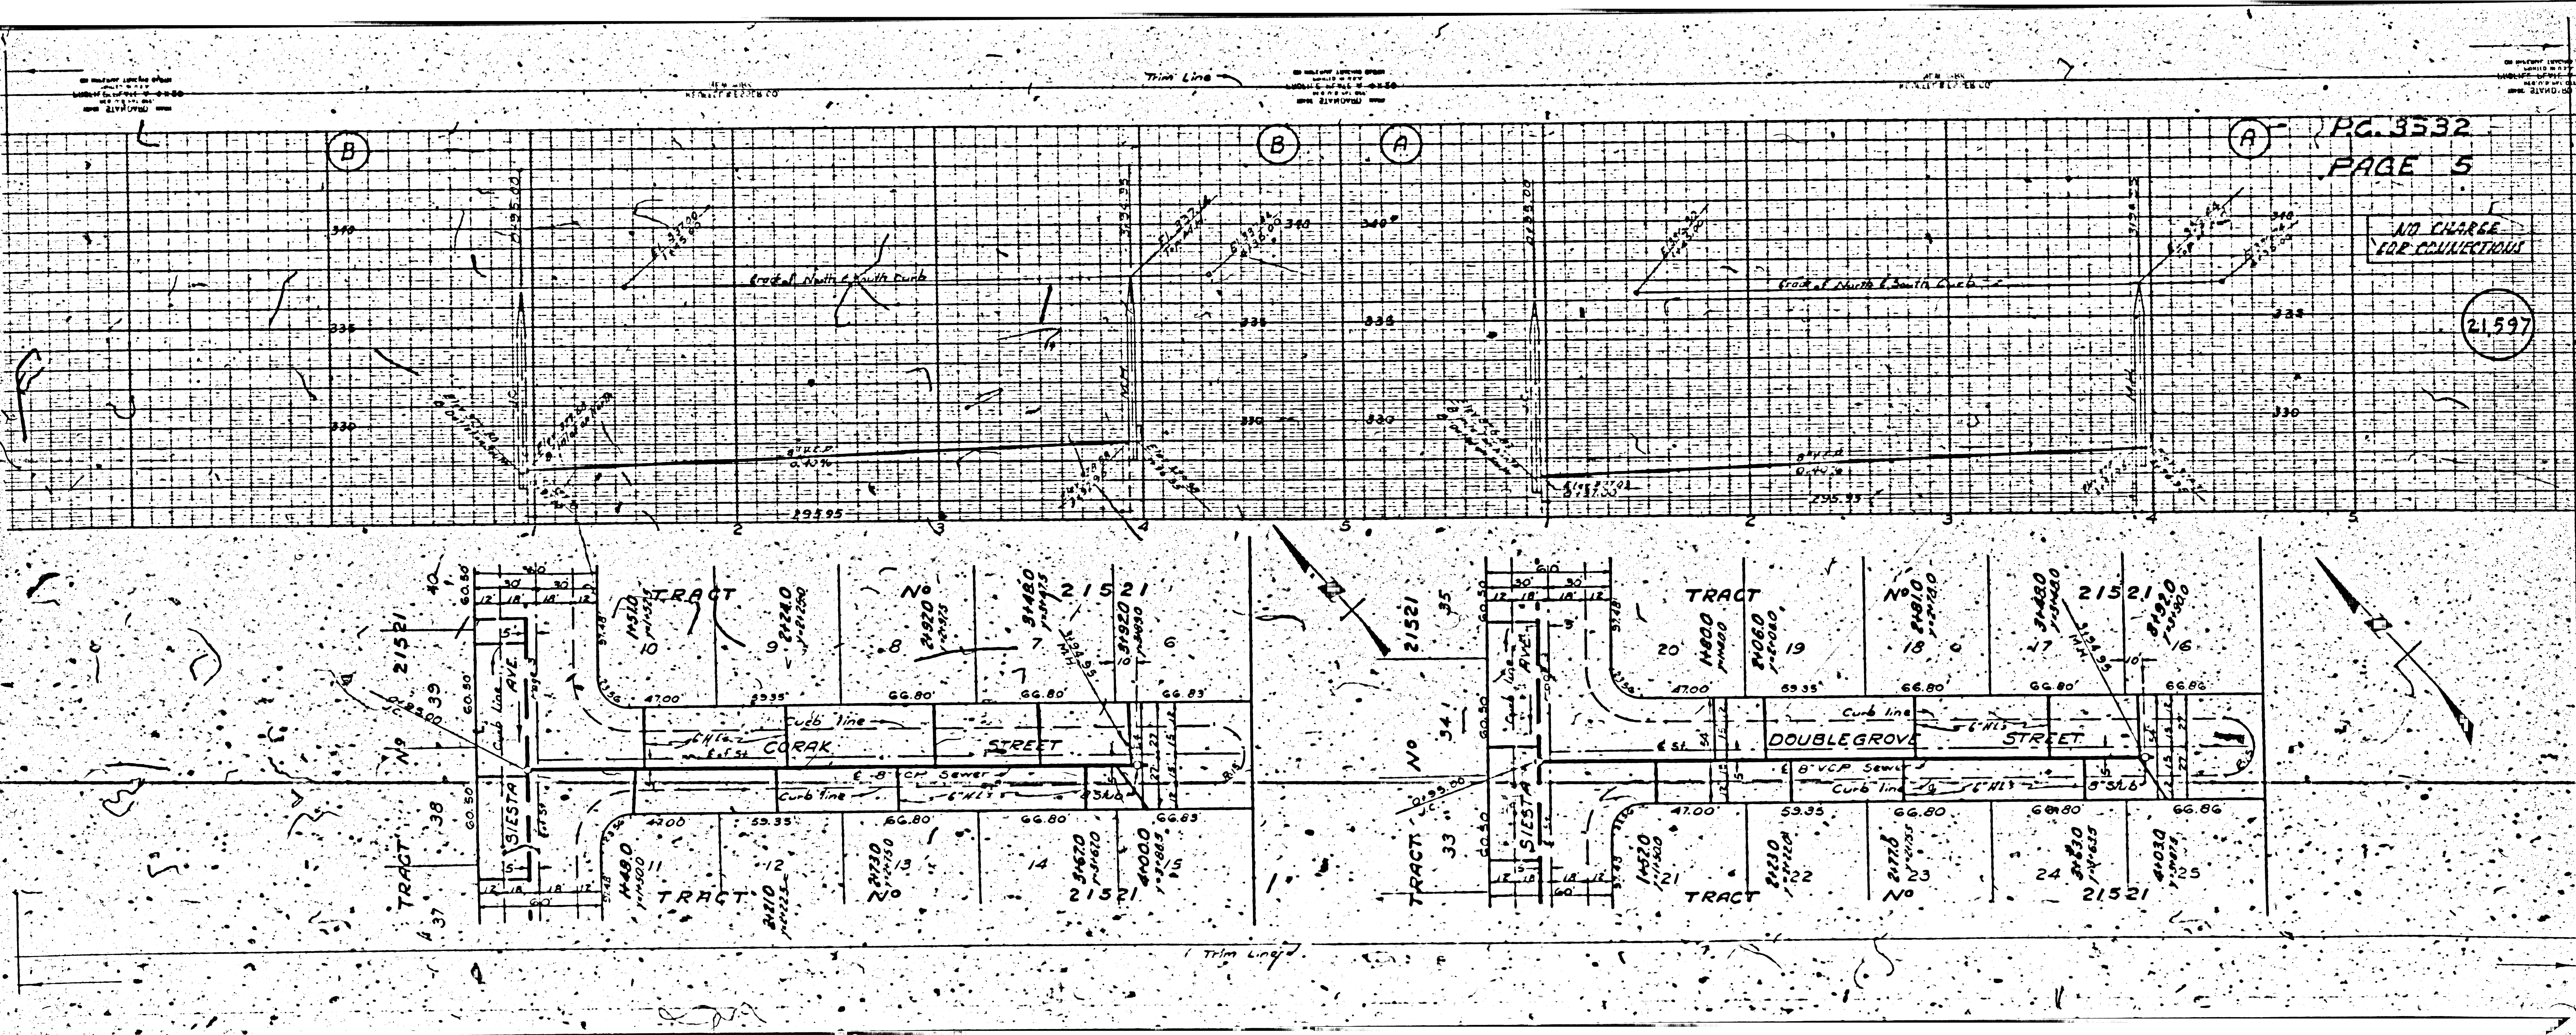






PG. 3532  
PAGE 6

NO CHARGE  
FOR CONNECTIONS

21598

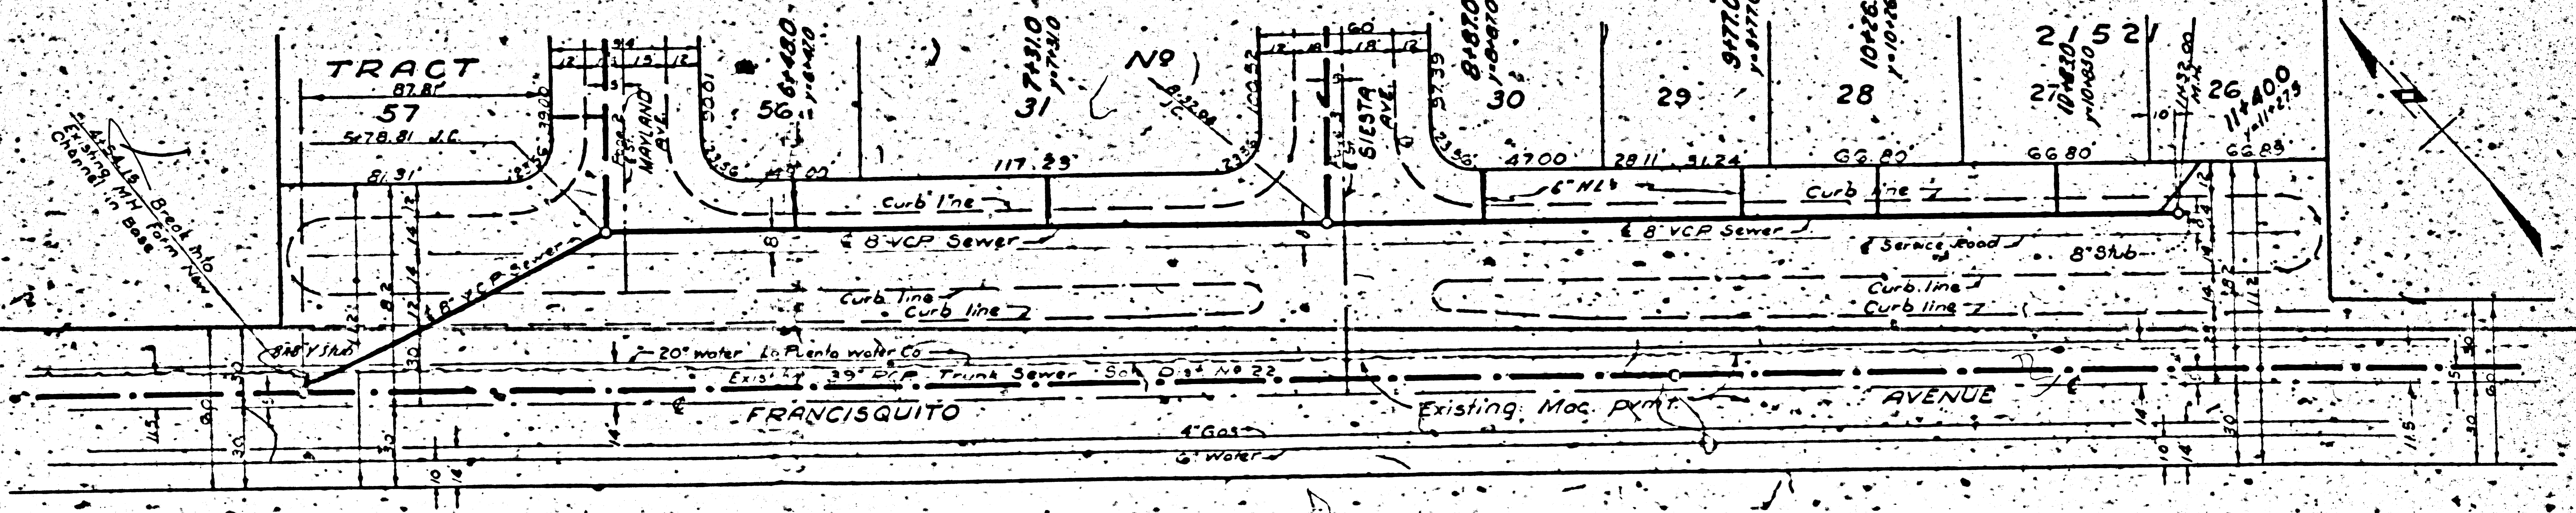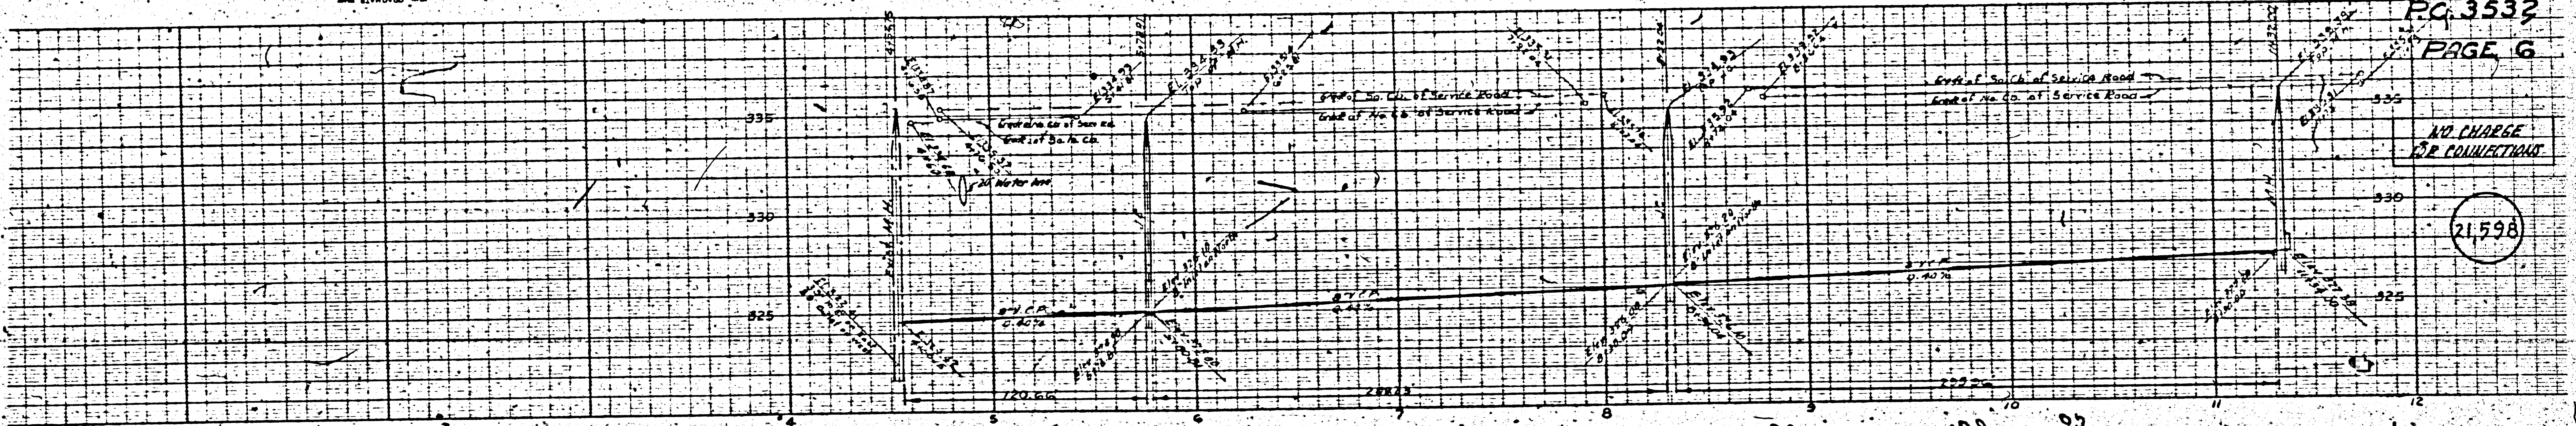

Trim Line