


Trim Line

BELFLOWER BLDG. DIST. N^o 4

- NOTE:**
Provide stakes on the property lines or property lines produced at right angles to the sewer line at the center line of each manhole.
- No representative of the County Engineer will survey or layout any portion of the work.
- The owner or his authorized representative shall furnish the County Engineer with grade sheets and stations for all house laterals and T branches and shall provide stakes for them at their proper locations with stationing plainly marked. Any change in location shall be requested in writing by the owner or his representative.
- No revisions shall be made in these plans without the approval of the County Engineer.
1. Use standard manhole frames and covers, S-a-117.
 2. Use standard strength pipe except as noted.
 3. Use joint compound for all vitrified clay pipe joints.
 4. Resurface all trench within paved area to meet L. A. County Road Dept. or California State Highway Dept. requirements in accordance with permit.
 5. Encase four feet of sewer at points of interference with poles, S-a-119.
 6. House laterals to be constructed with inverts of property line $\text{---} \text{---} \text{---}$ feet below curb grade except as noted.
 7. All structures shall be brick sewer structures, S-a-104.
 8. For allowable leakage test, use Formula No. E --- Spc's, Sec. 81.
 9. Manhole tops in unimproved Rights-Of-Way to be 6" above finish grade.

NOTE :
ISSUE NO PERMITS
UNTIL STREET IS DEDICATED
AND ACCEPTED BY BOARD
OF SUPERVISORS. CALL MR.
KULINS, MA. 9-4747 Ext. 464
FOR CLEARANCE. (SAN. DIV.)

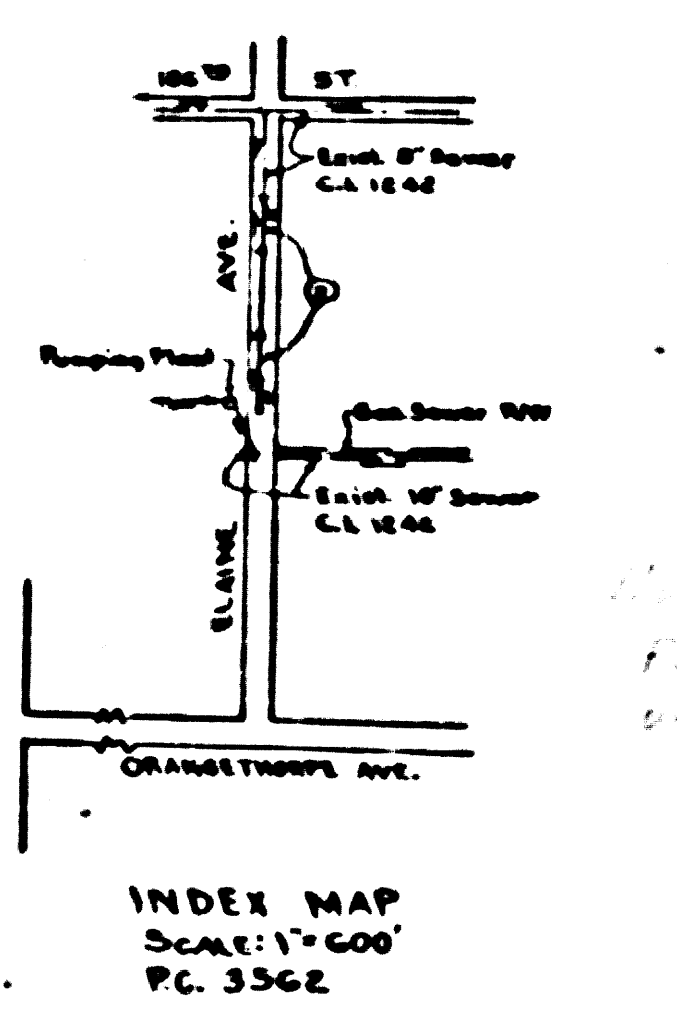

B.M. Rd Dept. 5Y2257 Elev 50.200
L. & T. 21' West of curb return.

SHEET	PAGES
1	1-2

COLLECT CHARGES
As INDICATED
7-8-55

REVISION
CHECKED
J. K. [Signature] 7-11-55
Office of County Engineer, Reg. C.E. No. 5406

PROFILE, ALIGNMENT AND GRADE OF
SANITARY SEWERS
TO BE CONSTRUCTED IN

PC. 3562
PAGE 1

ELAINE AVENUE

PRIVATE CONTRACT NO. 3562
W. S. 33
1 SHEET

Scale: HORIZ. 1"=40' VERT. 1"=4'
JUNE, 1955
PREPARED IN THE OFFICES OF
MANNING & DETILLA

By *J. H. Manning* C.E. No. 7670
FOR LEGEND SEE PLAN NO. S-a-64

NOTE:
Grades to which this improvement is to be constructed are shown on plans and profiles. Grade points for top of curbs, center line of streets, or center line of alleys are shown by circles on profiles. At all points between designated points the grade shall be established so as to conform to a straight line drawn between said designated points.

Elevations are in feet above U.S.G.S. datum or mean sea level.

This drawing and the data hereon are hereby made a part of the specifications.

Work shall be constructed according to specifications on file in the office of the County Engineer and shall be prosecuted only in the presence of the County Engineer.

Before work can be started, the contractor must obtain a permit to excavate in County streets from the L.A. County Road Dept., 100 W. 2nd St. and make a deposit with the County Engineer, Rm. 324, 283 S. Broadway, sufficient to cover the cost of construction inspection and record plans.

Approval of this plan by the County of Los Angeles does not constitute a representation as to the accuracy of the location of or the existence or non-existence of any underground utility, pipe, or structure within the limits of this project. The contractor is to be held responsible for all shoring.

If work is to be done in a State Highway, a permit must be obtained from the State of California, Division of Highways, 120 South Spring Street.

COUNTY OF LOS ANGELES, CALIFORNIA

Approved, William J. Fox, County Engineer
Approved, A. M. Egan
CHIEF ENGINEER SAN. DIST. NO. 7-19
By *A. P. Collins* Office Engineer
By *J. H. Manning* Office Engineer

Checked by *7-8-55*
Office of County Engineer, Reg. C.E. No. 7860

Dec'd 9-8-55


Trim Line

PC. 3562
PAGE 2

COLLECT CHARGES
As INDICATED

21,276

PC 3562

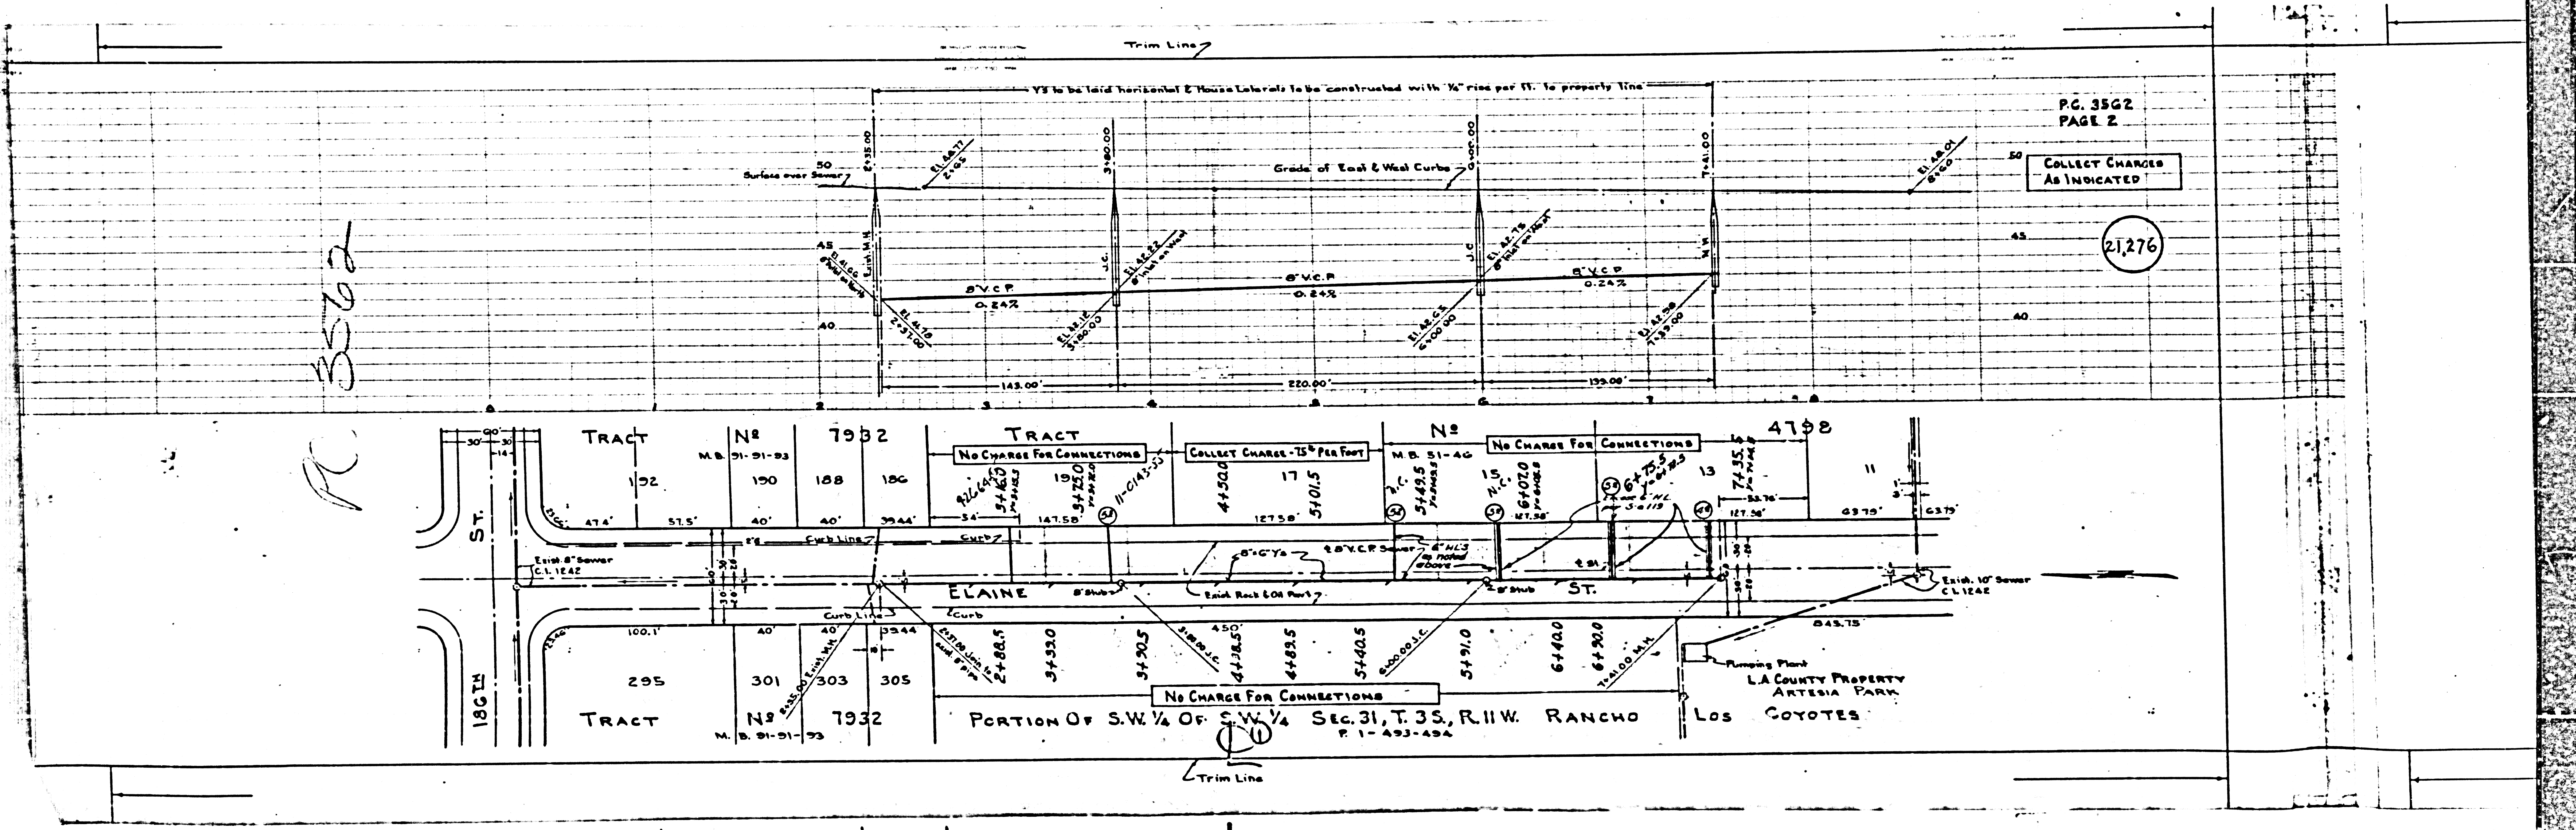

P.C. 3562
PAGE 2

COLLECT CHARGES
AS INDICATED

21,276

PORTION OF S.W. 1/4 OF S.W. 1/4 SEC. 31, T. 35, R. 11W. RANCHO
P. 1-493-494

Pumping Plant
L.A. COUNTY PROPERTY
ARTESIA PARK
LOS COYOTES