

B.M. Elev. 679.019 L&T. on South top of
Curb on Colorado St. on E. prod. of Halstead
St. C.B. 1588-74

NO CHARGE
FOR CONNECTIONS
Lester 7-30-56


SHEET	PAGES
1	2

ALTADENA BLDG. DIST. NO. 3

- NOTE:
1. PROVIDE STAKES ON THE PROPERTY LINE OR PROPERTY LINES PRODUCED AT RIGHT ANGLES TO THE SEW. LINE AT THE CENTER LINE OF EACH MANHOLE.
2. NO REPRESENTATIVE OF THE COUNTY ENGINEER WILL SURVEY OR LAYOUT ANY PORTION OF THE WORK.
3. THE OWNER OF THE AUTHORIZED REPRESENTATIVE SHALL FURNISH THE COUNTY ENGINEER WITH GRASS SHEETS AND STATIONING FOR ALL POLES LATERALS AND T BRANCHES AND SHALL PROVIDE STAKES FOR THESE AT THE PROPER LOCATIONS WITH STATIONING PLAINLY MARKED. ANY CHANGE IN LOCATION SHALL BE REQUESTED BY WRITING BY THE OWNER OR HIS REPRESENTATIVE. NO REVISIONS SHALL BE MADE IN THESE PLANS WITHOUT THE APPROVAL OF THE COUNTY ENGINEER.
4. USE STANDARD MANHOLE FRAMES AND COVERS, S.A. 117, EXCEPT AS NOTED.
5. USE STANDARD STRENGTH PIPE EXCEPT AS NOTED.
6. USE CEMENT MORTAR FOR ALL VITRIFIED CLAY PIPE JOINTS.
7. RESURFACE ALL TRENCH WITHIN PAVED AREA TO MEET L. A. COUNTY ROAD DEPT. OR CALIF. STATE HIGHWAY DEPT. REQUIREMENTS IN ACCORDANCE WITH REG. ...
8. ENCASE FOUR FEET OF SEWER AT POINTS OF INTERFERENCE WITH POLES, S.A. 117.
9. CURBS-GARBAGE-40-42-43-44-999-1000

PROFILE ALIGNMENT AND GRADE OF **P.C. 4055**
SANITARY SEWERS PAGE 1
TO BE CONSTRUCTED IN
GREEN STREET RIGHT OF WAY.
EXTENSION

PRIVATE CONTRACT NO. 4055
W.S. 44
- 1 SHEETS; - 2 PAGES (23,395)
SCALE: $1'' = 10'$ HORIZ. $1'' = 4'$ VERT. **JUNE, 1956**
PREPARED IN THE OFFICES OF
TREADWELL ENGINEERING CORPORATION (2)
By *W.A. Treadwell* C.E. NO. 410
FOR LEGEND SEE PLAN NO. S-A-64

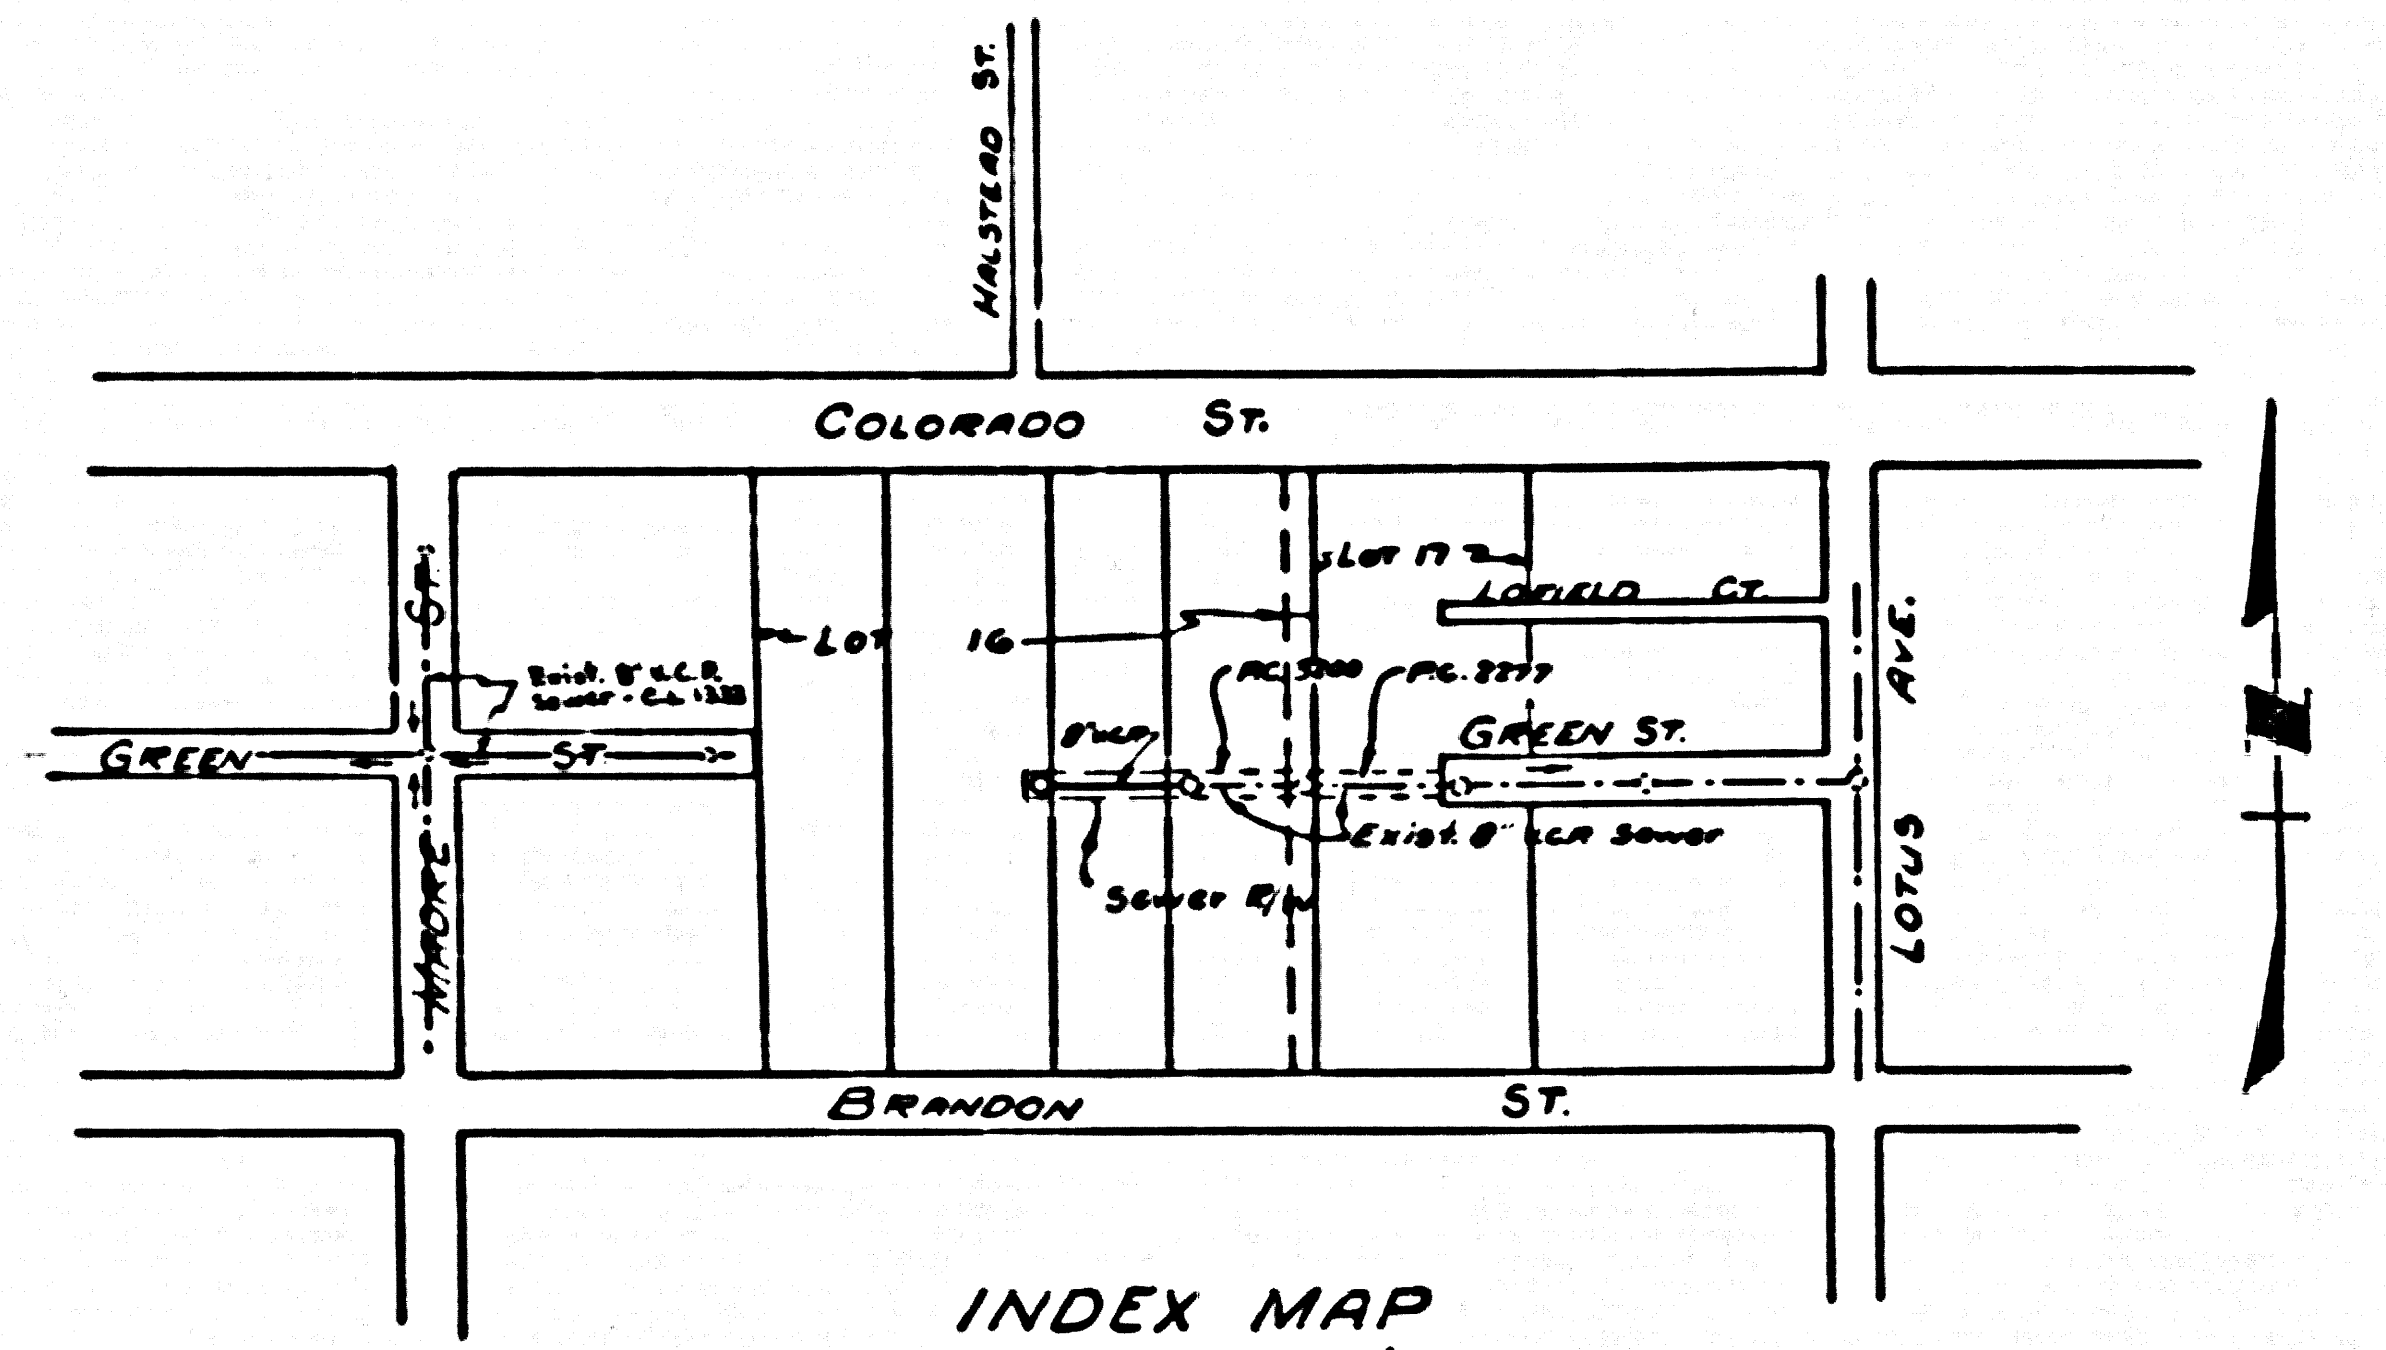

INDEX MAP
SCALE 1" = 300'
GREEN STREET EXTENSION
P.C. 4055


NOTE:
GRADES TO WHICH THIS IMPROVEMENT IS TO BE CONSTRUCTED ARE SHOWN ON PLANS AND PROFILES. GRADE POINTS FOR CURBS, CENTER LINE OF STREETS OR CENTER LINE OF ALLEYS ARE SHOWN BY CIRCLES ON PROFILES AT ALL POINTS BETWEEN DESIGNATED POINTS. THE GRADE SHALL BE ESTABLISHED SO AS TO CONFORM TO A STRAIGHT LINE DRAWN BETWEEN SAID DESIGNATED POINTS.
ELEVATIONS ARE IN FEET ABOVE U.S.C. & G.S. MEAN LEVEL. (PLAN OF 1955)
THIS DRAWING AND THE DATA HEREON ARE HEREBY MADE A PART OF THE SPECIFICATIONS.
WORK SHALL BE CONSTRUCTED ACCORDING TO SPECIFICATION NO. 1011 IN THE OFFICE OF THE COUNTY ENGINEER AND SHALL BE PROSECUTED IN THE PRESENCE OF THE COUNTY ENGINEER.
BEFORE WORK CAN BE STARTED, THE CONTRACTOR MUST OBTAIN A PERMIT TO EXCAVATE IN COUNTY STREETS FROM THE L. A. COUNTY ROAD DEPT., 128 W. 3RD ST., AND MAKE A DEPOSIT WITH THE COUNTY ENGINEER, ROOM 124 FARM ARCADE BLDG., 222 SO. BROADWAY SUFFICIENT TO COVER THE COST OF CONSTRUCTION INSPECTION AND RECORD PLANS.
APPROVAL OF THIS PLAN BY THE COUNTY OF LOS ANGELES DOES NOT CONSTITUTE A REPRESENTATION AS TO THE ACCURACY OF THE LOCATION OF OR THE EXISTENCE OR NON-EXISTENCE OF ANY UNRECORDED UTILITY PIPES OR STRUCTURES WITHIN THE LIMITS OF THIS PROJECT. THIS NOTE APPLIES TO ALL PAGES.
IF WORK IS TO BE DONE IN A STATE HIGHWAY, A PERMIT MUST BE OBTAINED FROM THE STATE OF CALIFORNIA, DIVISION OF HIGHWAYS, 128 SOUTH SPRING STREET.

COUNTY OF LOS ANGELES, CALIFORNIA
APPROVED, JOHN A. LAMME, COUNTY ENGINEER APPROVED, A. M. RAWNS, CHIEF ENGINEER
BY *A.P. Collins* SANITATION ENGINEER BY *L. J. ...* OFFICE ENGINEER
CHECKED BY *R.V. ...* 8-1-56
OFFICE OF COUNTY ENGINEER, REG. C. E. NO. 3406

Checked 8-31-56 M. W. ...

NO CHARGE FOR CONNECTIONS

(23,396)

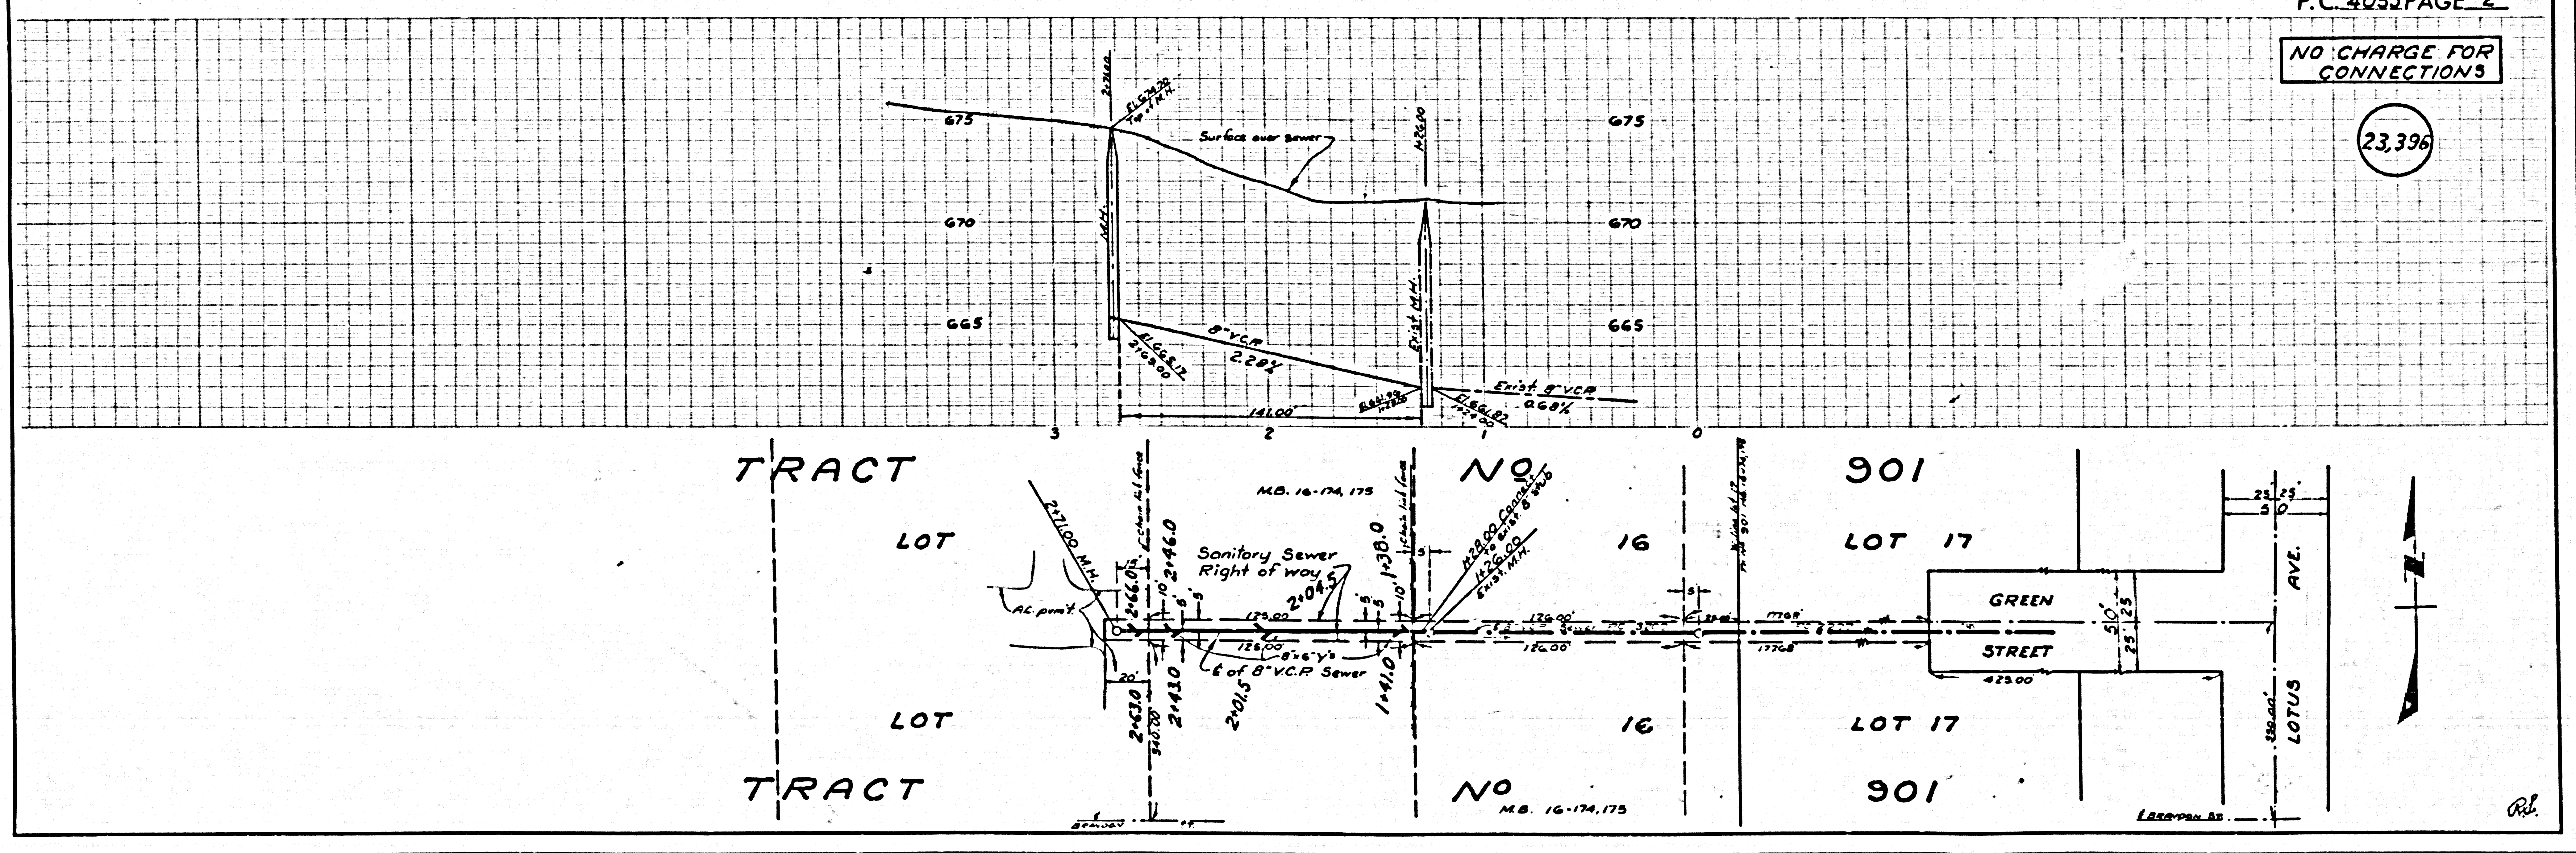

U. S. G. & G. CAL. BLUE PRINT SHEET NO. 1