


BM 3-2 County Precise Level No. 3
 Stage Road & Lullwiler Ave. Ast'd Co. Surveyor. Man
 marked 55.33' set in conc. 16" below the surface
 at the intersection of the E of Lullwiler Ave.
 and the E of Alonara Blvd. in a well cut through the
 pavement and protected by a cast iron cover marked
 County Surveyor Monument Co. Surv. FB 1204-G 1952 Elev 109.62
 Note: Lullwiler Ave. changed to Escalona Road

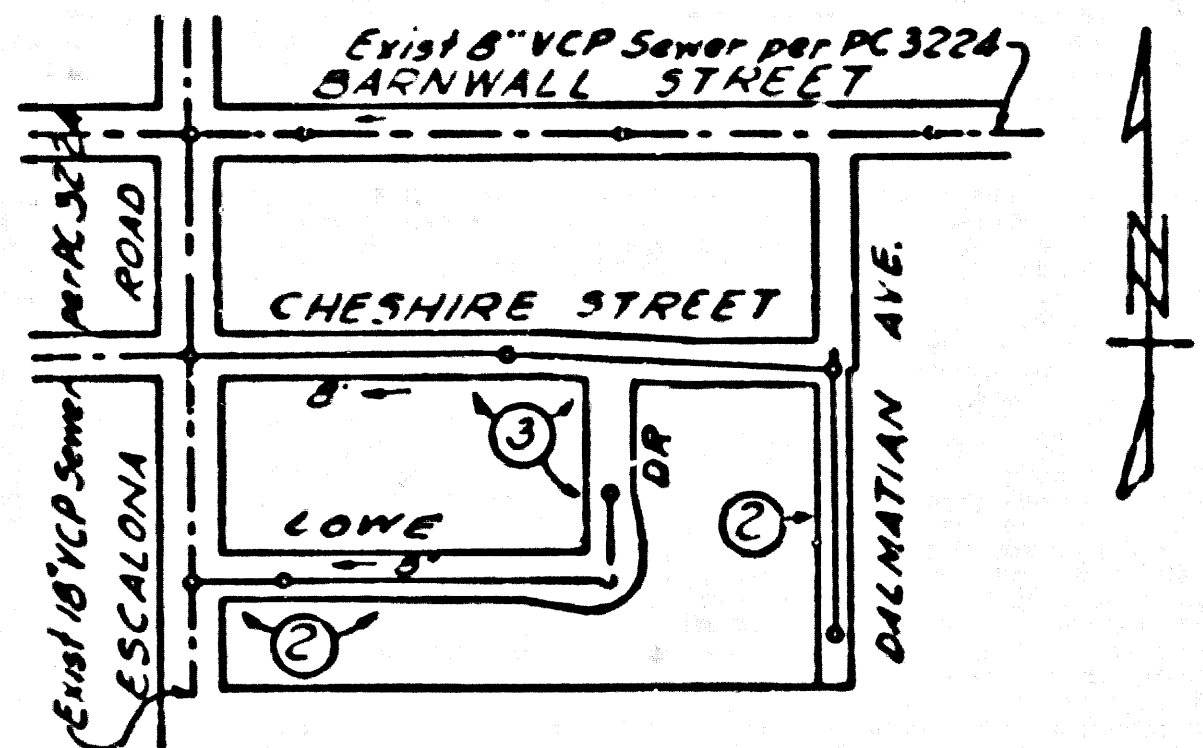

INDEX MAP
 SCALE 1"=300'
 TRACT NO. 22110
 P.C. 4108

Note:
 Lots 1 through 6 served by House Laterals
 constructed under P.C. 3224. House Sewer
 Permits may be obtained at Norwalk Bldg. Dist.

NORWALK BLDG. DIST. NO. 42

- NOTES
- PROVIDE STAKES ON THE PROPERTY LINE OR PROPERTY LINES PRODUCED AT RIGHT ANGLES TO THE SEWER LINE AT THE CENTER LINE OF EACH MANHOLE.
 - NO REPRESENTATIVE OF THE COUNTY ENGINEER WILL SURVEY OR LAYOUT ANY PORTION OF THE WORK.
 - THE OWNER OR HIS AUTHORIZED REPRESENTATIVE SHALL FURNISH THE COUNTY ENGINEER WITH GRADE SHEETS AND STATION FOR ALL HOUSE LATERALS AND Y BRANCHES AND SHALL PROVIDE STAKES FOR THEM AT THESE PROPOSED LOCATIONS WITH STATIONING. LATERALS MARKED ANY CHANGE IN LOCATION SHALL BE REQUESTED BY WRITING BY THE OWNER OR HIS REPRESENTATIVE.
 - NO REVISIONS SHALL BE MADE IN THESE PLANS WITHOUT THE APPROVAL OF THE COUNTY ENGINEER.
 - USE STANDARD MANHOLE FRAMES AND COVERS, S.A. 117, EXCEPT AS NOTED.
 - USE STANDARD STRENGTH PIPE EXCEPT AS NOTED.
 - USE CEMENT MORTAR FOR ALL VITRIFIED CLAY PIPE JOINTS.
 - RESURFACE ALL TRENCH WITHIN PAVED AREA TO MEET L. A. COUNTY ROAD DEPT. OR CALIF. STATE HIGHWAY DEPT. REQUIREMENTS IN ACCORDANCE WITH PERMITS.
 - ENCASE FOUR FEET OF SEWER AT POINTS OF INTERFERENCE WITH POLES, S.A. 119.
 - HOUSE LATERALS TO BE CONSTRUCTED WITHIN SERVICE AT PROPERTY LINE 6" FEET BELOW CURB GRADE EXCEPT AS NOTED.
 - ALL STRUCTURES SHALL BE BUILT TO THE SPECIFICATIONS, S.A. 194, EXCEPT AS NOTED.
 - FOR ALLOWING CHARGES SEE THE FORMULA NO. 1 SPEC. SEC. 64
 - THE PRIVATE ENGINEER SHALL FURNISH THE HOUSE LATERAL DEPTH AT THE PROPERTY LINE BELOW THE ELEVATION OF THE TOP OF CURB FOR EACH HOUSE LATERAL, ON THE GRADE SHEET.


COLLECT CHARGES
 AS INDICATED
 11-15-56

PROFILE ALIGNMENT AND GRADE OF P.C. 4108
 SANITARY SEWERS PAGE 1
 TO BE CONSTRUCTED IN
 TRACT NO. 22110 24.613 B

PRIVATE CONTRACT NO. 4108
 W.S. 34
 2 SHEETS, 3 PAGES
 SCALE: 1"=1'-0" HORIZ. 1"=1'-0" VERT.
 JULY, 1956
 PREPARED IN THE OFFICES OF
 ADAMS AND ELLS - ENGINEERS
 BY *John R. Selman* REG. C. E. NO. 4849
 FOR LEGEND SEE PLAN NO. S-A-64

NOTE:
 GRADES TO WHICH THIS IMPROVEMENT IS TO BE CONSTRUCTED ARE SHOWN ON PLANS AND PROFILES. GRADE POINTS FOR TOP OF CURB, CENTER LINE OF STREETS, OR CENTER LINE OF ALLEYS ARE SHOWN BY CIRCLES ON PROFILES AT ALL POINTS BETWEEN DESIGNATED POINTS. THE GRADE SHALL BE ESTABLISHED SO AS TO CONFORM TO A STRAIGHT LINE DRAWN BETWEEN SAID DESIGNATED POINTS.
 THIS DRAWING AND THE DATA HEREON ARE HEREBY MADE A PART OF THE SPECIFICATIONS.
 WORK SHALL BE CONSTRUCTED ACCORDING TO SPECIFICATIONS ON FILE IN THE OFFICE OF THE COUNTY ENGINEER AND SHALL BE PROSECUTED UNDER THE PRESENCE OF THE COUNTY ENGINEER.
 BEFORE WORK CAN BE STARTED THE CONTRACTOR MUST OBTAIN A PERMIT TO EXCAVATE IN COUNTY STREETS FROM THE L. A. COUNTY ROAD DEPT. FOR THE USE OF AND READ A REPORT WITH THE COUNTY ENGINEER, ROOM 324 PAN AMERICAN BUILDING 215 SO BROADWAY SUFFICIENT TO COVER THE COST OF CONSTRUCTION INSPECTION AND RECORD PLANS.
 APPROVAL OF THIS PLAN BY THE COUNTY OF LOS ANGELES DOES NOT CONSTITUTE A REPRESENTATION AS TO THE ACCURACY OF THE LOCATION OR OF THE EXISTENCE OR NON-EXISTENCE OF ANY UNDERGROUND UTILITY PIPE, OR STRUCTURE WITHIN THE LIMITS OF THIS PROJECT. THIS NOTE APPLIES TO ALL PAGES.
 IF WORK IS TO BE DONE IN A STATE HIGHWAY, A PERMIT MUST BE OBTAINED FROM THE STATE OF CALIFORNIA, DIVISION OF HIGHWAYS, 130 SOUTH SPRING STREET.

COUNTY OF LOS ANGELES, CALIFORNIA
 APPROVED, JOHN A. LAMME, COUNTY ENGINEER
 APPROVED, A. M. RAWN, CHIEF ENGINEER
 BY *A. P. Collins* SANITATION ENGINEER
 BY *H. P. Williams* OFFICE ENGINEER
 CHECKED BY *P. J. Kuhn* 11-15-56
 OFFICE OF COUNTY ENGINEER, REG. C. E. NO. 7860

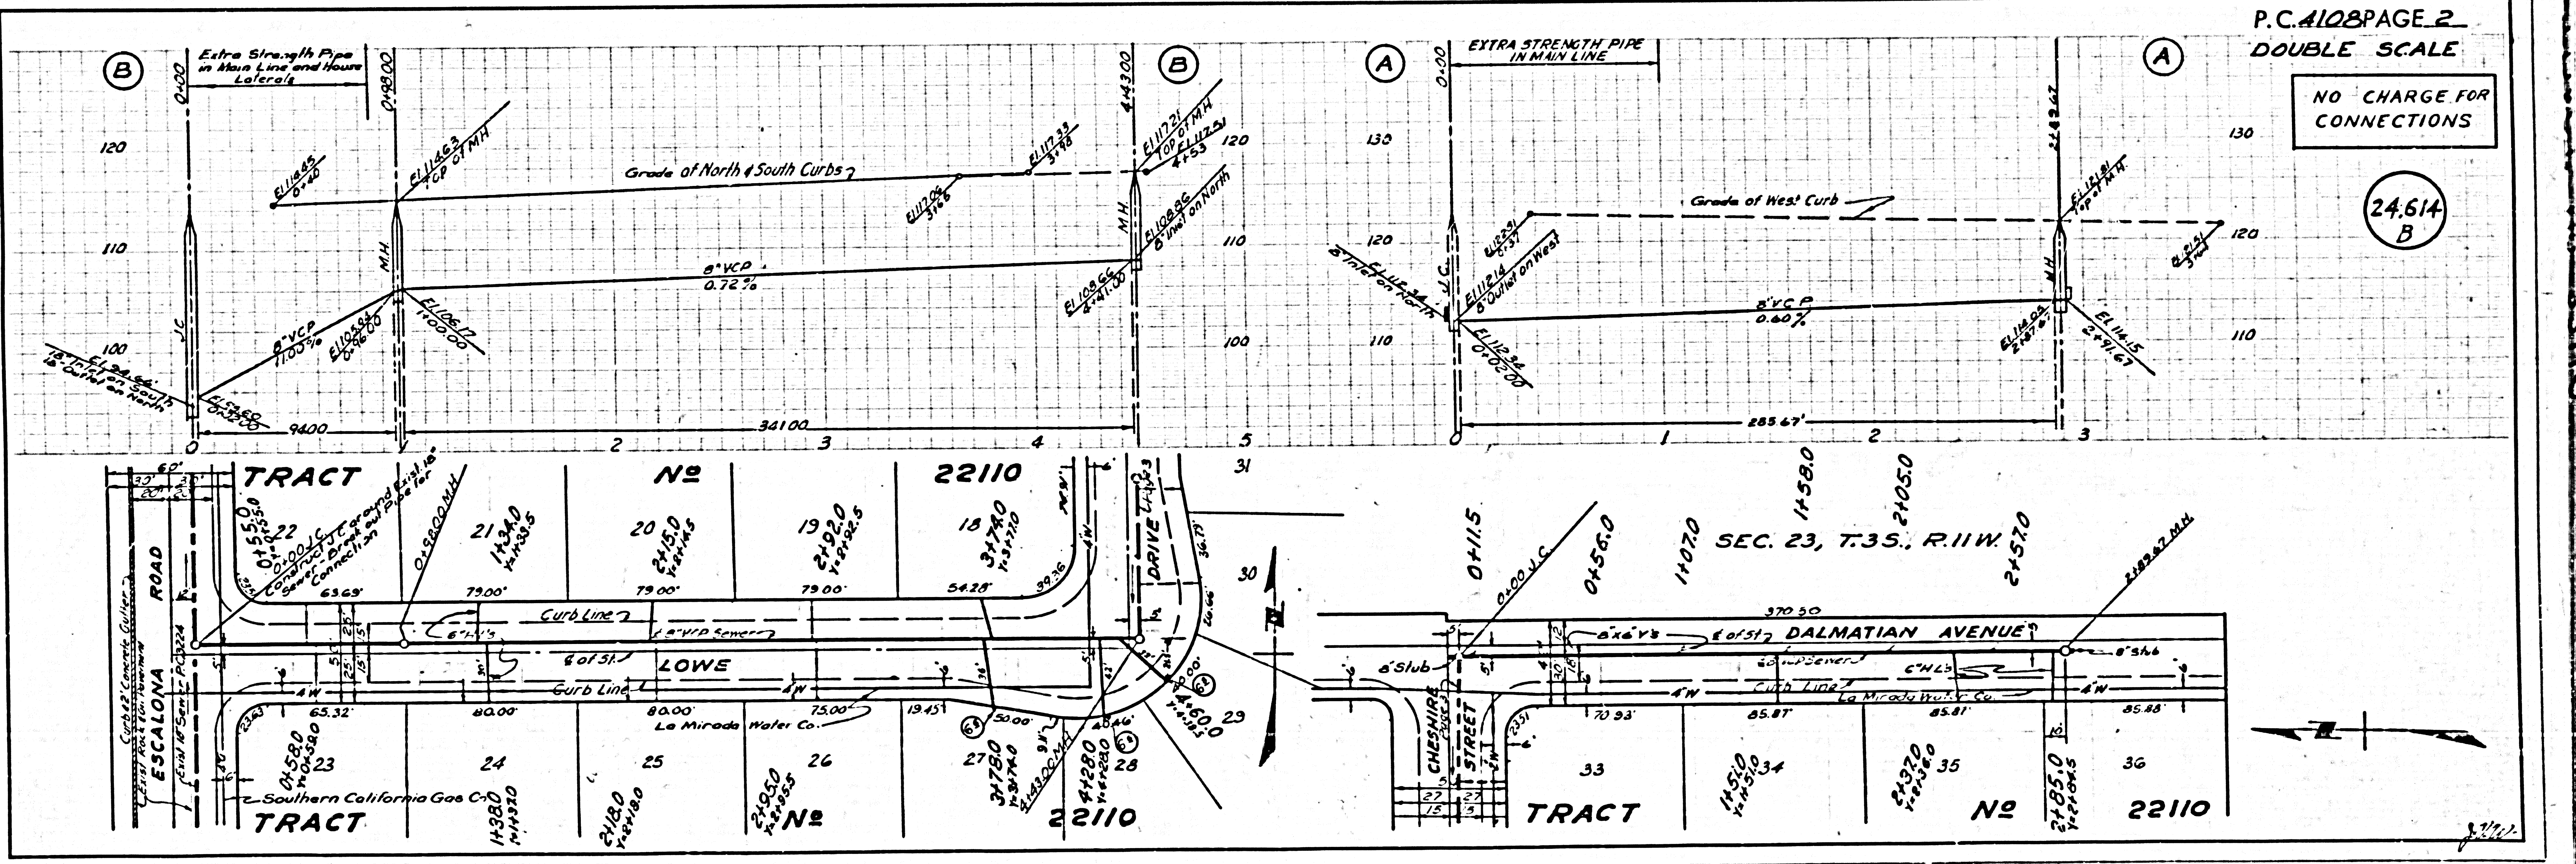

P.C. 4108 PAGE 2
 DOUBLE SCALE

NO CHARGE FOR CONNECTIONS

24.614 B

DOUBLE SCALE

COLLECT CHARGES FOR CONNECTIONS

24615 B

