


B.M. SL-7 EL. 2370.877  
Sta. C.S. Man @ S.E. Cor. Junc.  
Reginald's Park. Use S.E. 1/4 of  
Map.

NOTE: Subtract 0.324 from all  
elevations on this plan to arrive  
at above datum.

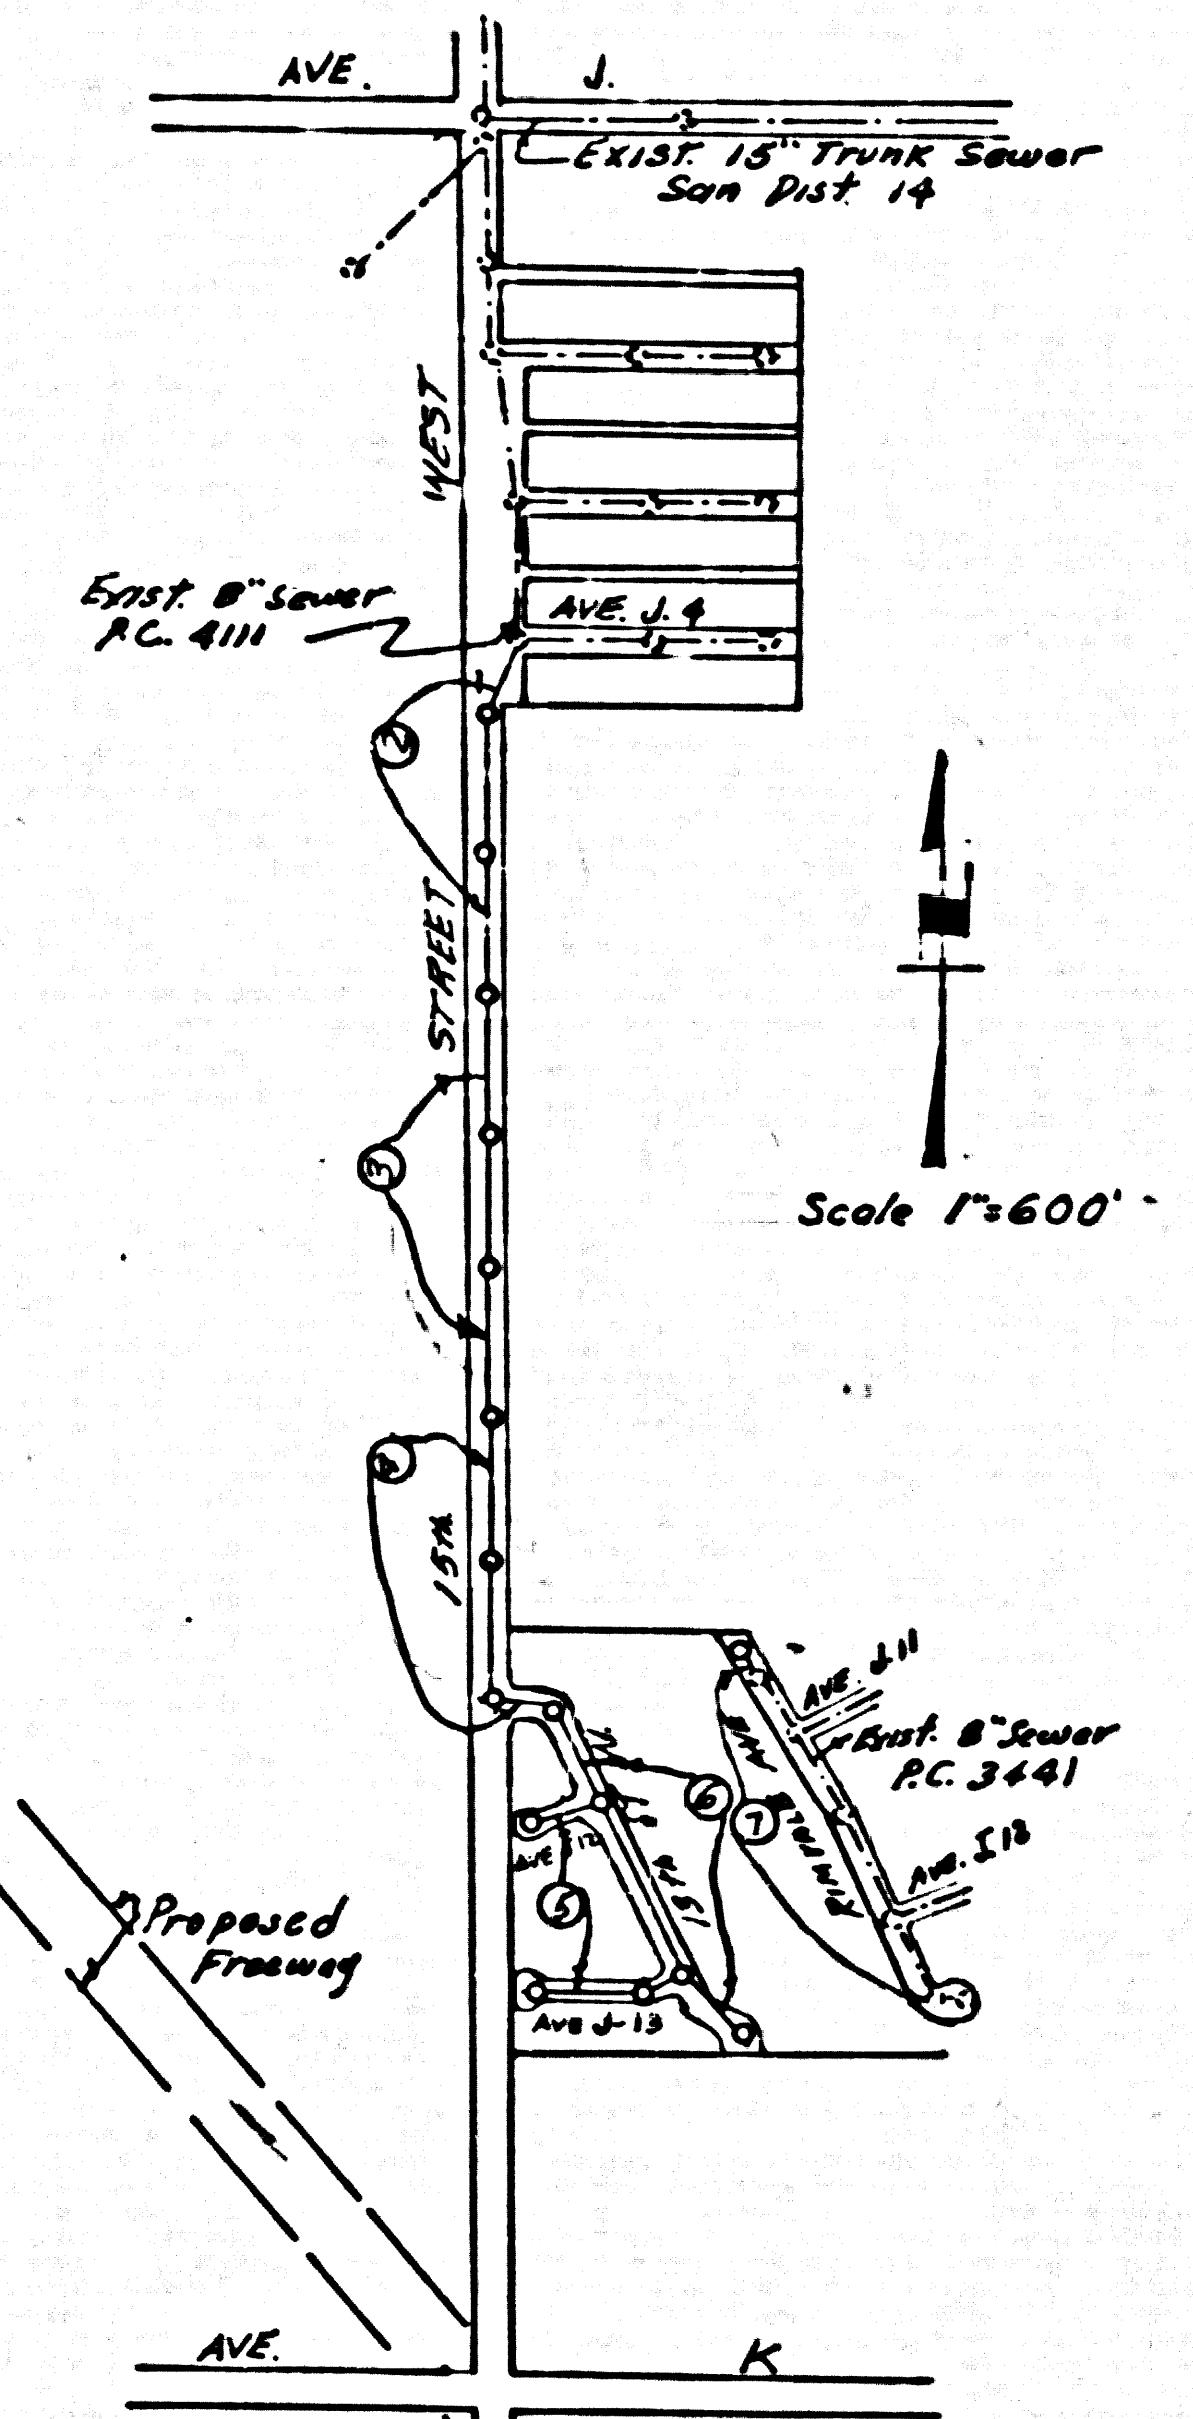

INDEX MAP  
TRACT NO 17819  
P.C. 4285

LANCASTER BLDG. DIST. NO. 8

- NOTES:
- PROVIDE STAKES ON THE PROPERTY LINE OR PROPERTY LINES PRODUCED AT RIGHT ANGLES TO THE SEWER LINE AT THE CENTER LINE OF EACH MANHOLE.
  - NO REPRESENTATIVE OF THE COUNTY ENGINEER WILL SURVEY OR LAYOUT ANY PORTION OF THE WORK.
  - THE OWNER OR HIS AUTHORIZED REPRESENTATIVE SHALL FURNISH THE COUNTY ENGINEER WITH GRAD SHEDS AND STATION FOR ALL HOUSE LATERALS AND Y BRANCHES AND SHALL PROVIDE STAKES FOR THEM AT THEIR PROPER LOCATIONS WITH STATIONING PLAINLY MARKED. ANY CHANGE IN LOCATION SHALL BE REQUESTED IN WRITING BY THE OWNER OR HIS REPRESENTATIVE. NO REVISIONS SHALL BE MADE IN THESE PLANS WITHOUT THE APPROVAL OF THE COUNTY ENGINEER.
  - USE STANDARD MANHOLE FRAMES AND COVERS, S.A. 117, EXCEPT AS NOTED.
  - USE STANDARD STRENGTH PIPE EXCEPT AS NOTED.
  - USE CEMENT MORTAR FOR ALL VITRIFIED CLAY PIPE JOINTS.
  - REINFORCE ALL TRENCH WITHIN PAVED AREA TO MEET L. A. COUNTY ROAD DEPT., OR CALIF. STATE HIGHWAY DEPT. REQUIREMENTS IN ACCORDANCE WITH PERMITS.
  - ENCASE FOUR FEET OF SEWER AT POINTS OF INTERFERENCE WITH POLES, S.A. 119.
  - HOUSE LATERALS TO BE CONSTRUCTED WITH INVERTS AT PROPERTY LINE 6 FEET BELOW CURB GRADE EXCEPT AS NOTED.
  - ALL STRUCTURES SHALL BE BRICK SEWER STRUCTURES, S.A. 104, EXCEPT AS NOTED.
  - FOR ALLOWABLE LEAKAGE TEST USE FORMULA NO. 1 SPEC'S, SEC. II.
  - MANHOLE TOPS IN UNIMPROVED RIGHTS-OF-WAY TO BE 6 ABOVE FINISHED GRADE.
  - The Private Engineer is to furnish the house lateral depth at the Property Line below the top of Curb Elevation for each house lateral on the Grade Sheet.
  - Ball all joints with 4" of Cement Mortar that are within 20' of all Property Line or in Sewer Right.

COLLECT CHARGES  
AS INDICATED  
As per Contract 3747

NOTE: Allow no connections  
must annex to San. Dist. 14


PROFILE ALIGNMENT AND GRADE OF P.C. 4285  
SANITARY SEWERS PAGE 1  
TO BE CONSTRUCTED IN  
TRACT NO 17819

PRIVATE CONTRACT NO. 4285

W.S. 71  
4 SHEETS, 7 PAGES  
SCALE: VERT. 1"=6'  
HORIZ. 1"=20'  
JANUARY, 1957  
PREPARED IN THE OFFICES OF  
SURVEY BY GANN  
By Edward H. Plocher  
REG. C.E. NO. 9234

NOTE:  
GRADES TO WHICH THIS IMPROVEMENT IS TO BE CONSTRUCTED ARE SHOWN ON PLANS AND PROFILE. GRADE POINTS FOR TOP OF CURB, CENTER LINE OF ALLEY, OR CENTER LINE OF ALLEYS ARE SHOWN BY DASHES ON PROFILE. AT ALL POINTS BETWEEN DESIGNATED POINTS THE GRADE SHALL BE ESTABLISHED SO AS TO CONFORM TO A STRAIGHT LINE DRAWN BETWEEN SAID DESIGNATED POINTS.  
ELEVATIONS ARE IN FEET ABOVE U.S.C. & G.S. MEAN SEA LEVEL OF 1929.  
THE DRAWINGS AND THE DATA HEREON ARE HEREBY MADE A PART OF THE SPECIFICATIONS.  
WORK SHALL BE CONSTRUCTED ACCORDING TO SPECIFICATIONS ON FILE IN THE OFFICE OF THE COUNTY ENGINEER AND SHALL BE PROSECUTED ONLY IN THE PRESENCE OF THE COUNTY ENGINEER.  
BEFORE WORK CAN BE STARTED, THE CONTRACTOR MUST OBTAIN A PERMIT TO EXCAVATE IN COUNTY STREETS FROM THE L. A. COUNTY ROAD DEPT., 108 W. 5TH ST. AND MAKE A DEPOSIT WITH THE COUNTY ENGINEER, ROOM 324 PAM. AMERICAN BUILDING, 255 SO. BROADWAY SUBJECT TO COVER THE COST OF CONSTRUCTION INSPECTION AND RECORD PLANS.  
APPROVAL OF THIS PLAN BY THE COUNTY OF LOS ANGELES DOES NOT CONSTITUTE A REPRESENTATION AS TO THE ACCURACY OF THE LOCATION OF OR THE EXISTENCE OR NON-EXISTENCE OF ANY UNDERGROUND UTILITY PIPE, OR STRUCTURE WITHIN THE LIMITS OF THIS PROJECT. THIS NOTE APPLIES TO ALL PAGES.  
IF WORK IS TO BE DONE IN A STATE HIGHWAY, A PERMIT MUST BE OBTAINED FROM THE STATE OF CALIFORNIA, DIVISION OF HIGHWAYS, 126 SOUTH SPRING STREET.

COUNTY OF LOS ANGELES, CALIFORNIA  
APPROVED, JOHN A. LAMBE, COUNTY ENGINEER  
APPROVED, A. M. LAWN, CHIEF ENGINEER  
By B. H. Hughes (Sanitary Engineer) By E. J. ... (Chief Engineer)  
CHECKED BY W. D. ...  
OFFICE OF COUNTY ENGINEER, REG. C.E. NO. 9486

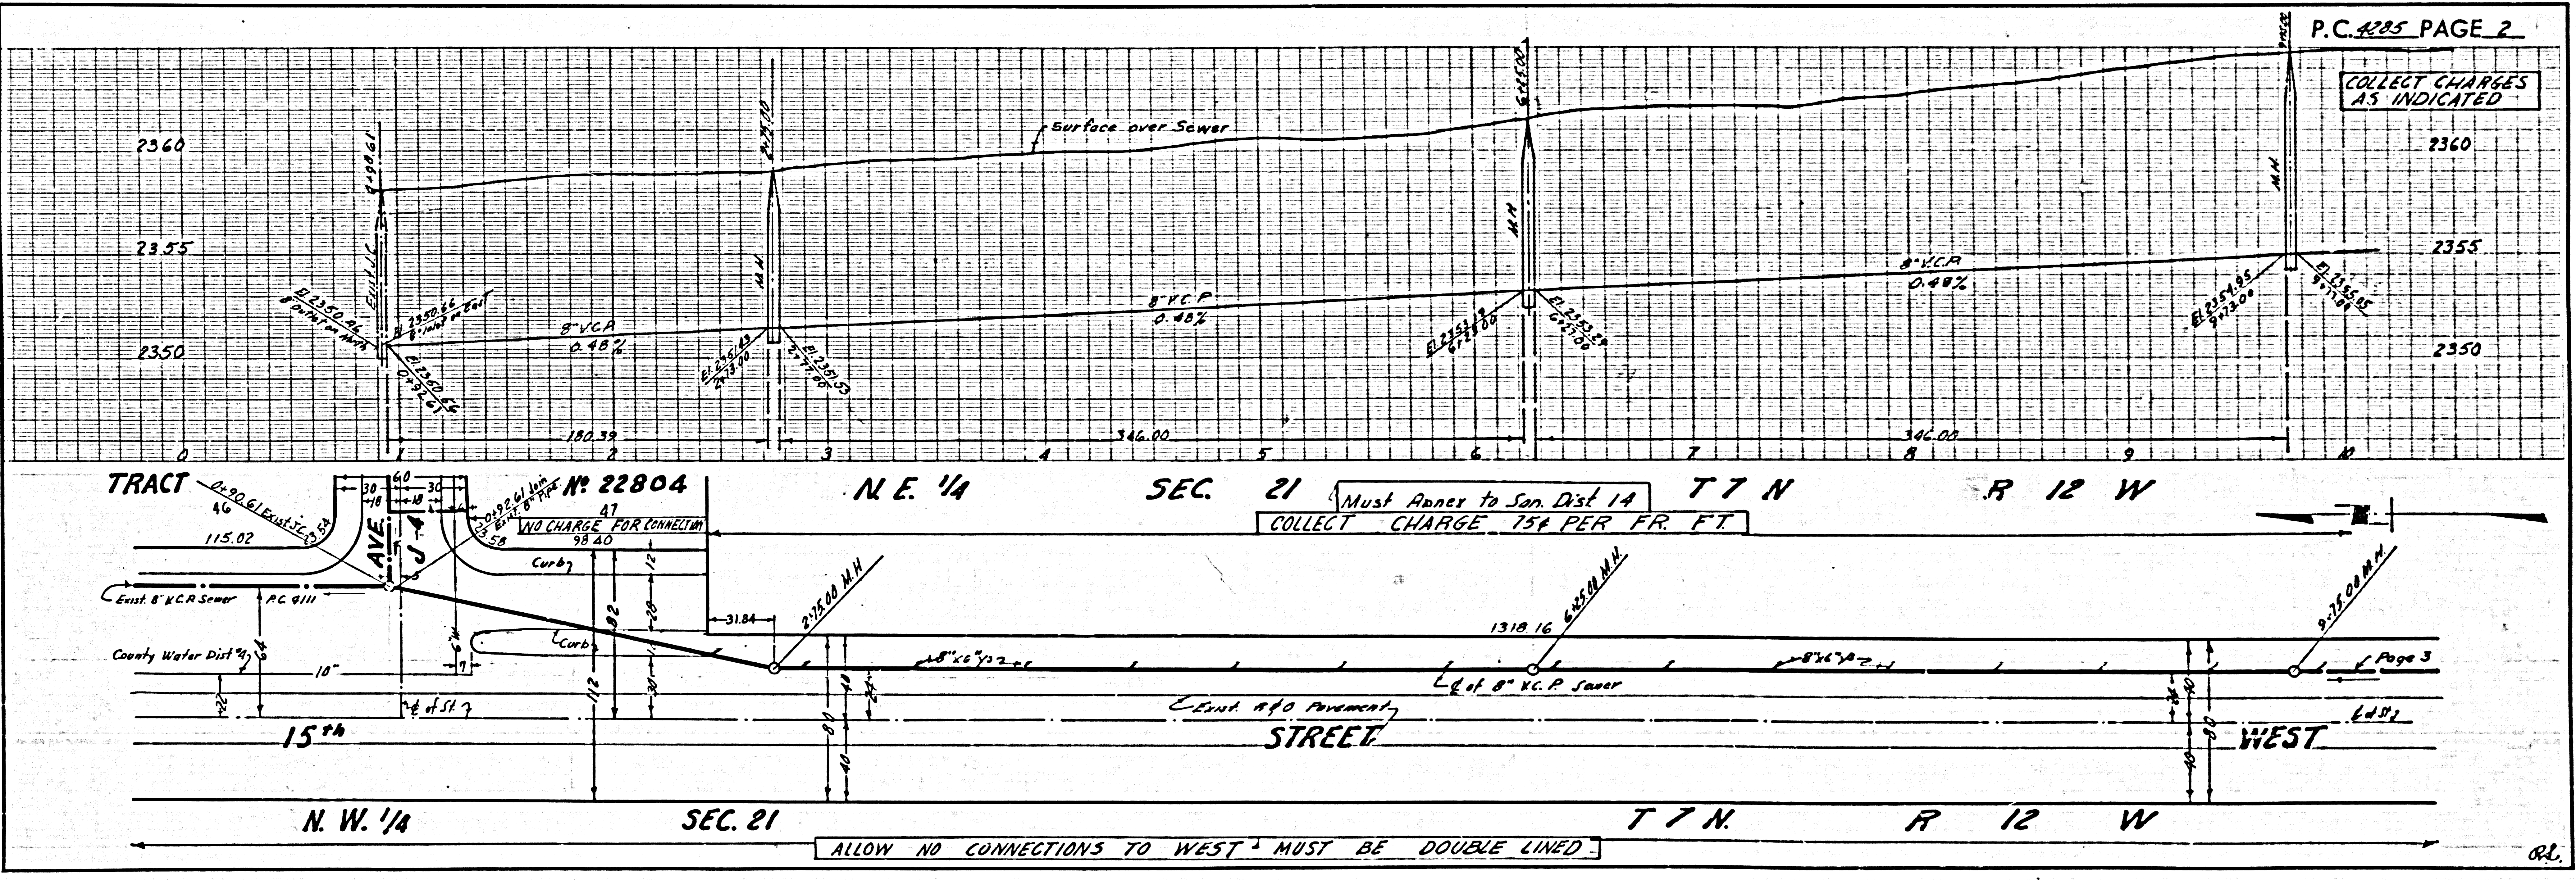



P.C. 4285 PAGE 2

COLLECT CHARGES  
AS INDICATED

Must Annex to San. Dist. 14  
COLLECT CHARGE 75¢ PER FR. FT.





ALLOW NO CONNECTIONS TO WEST MUST BE DOUBLE LINED

REL

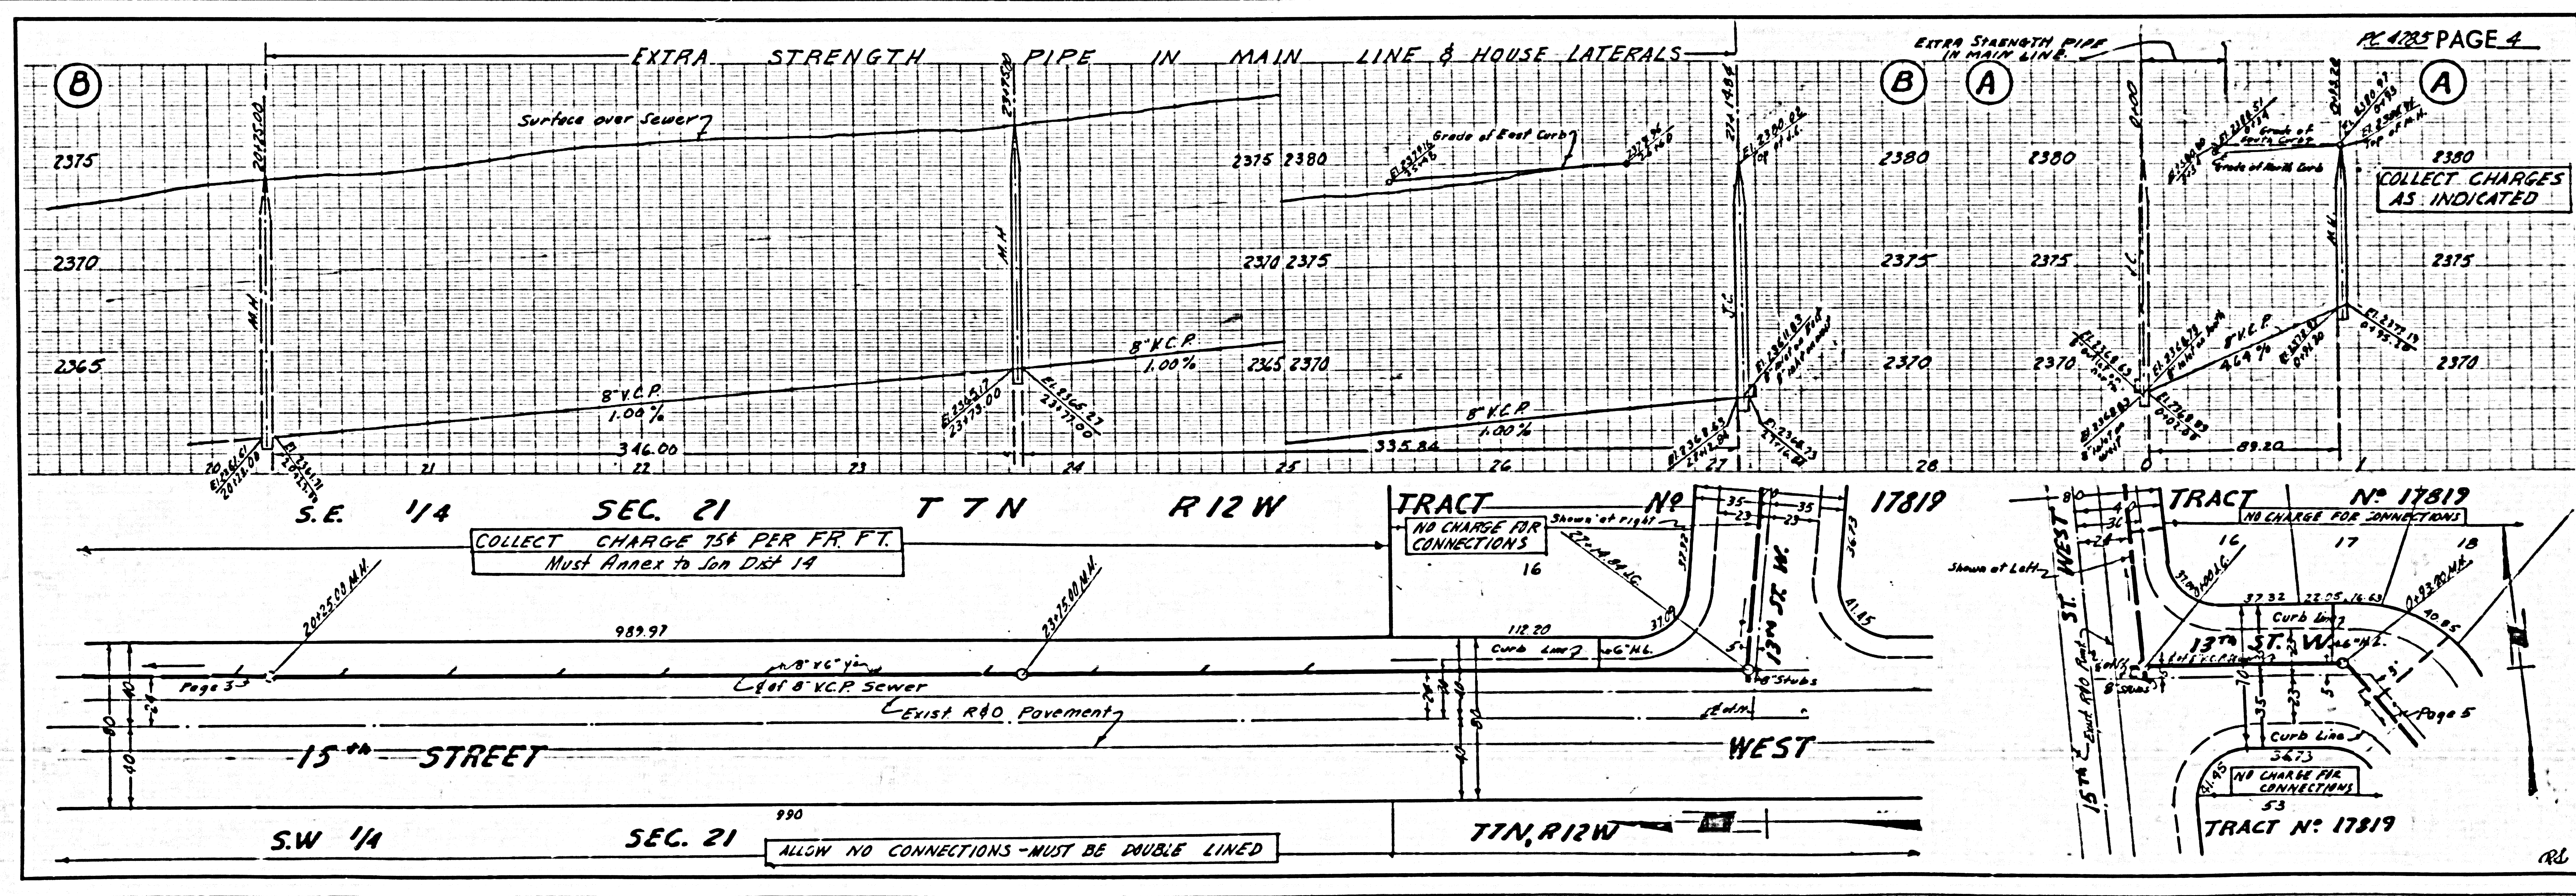
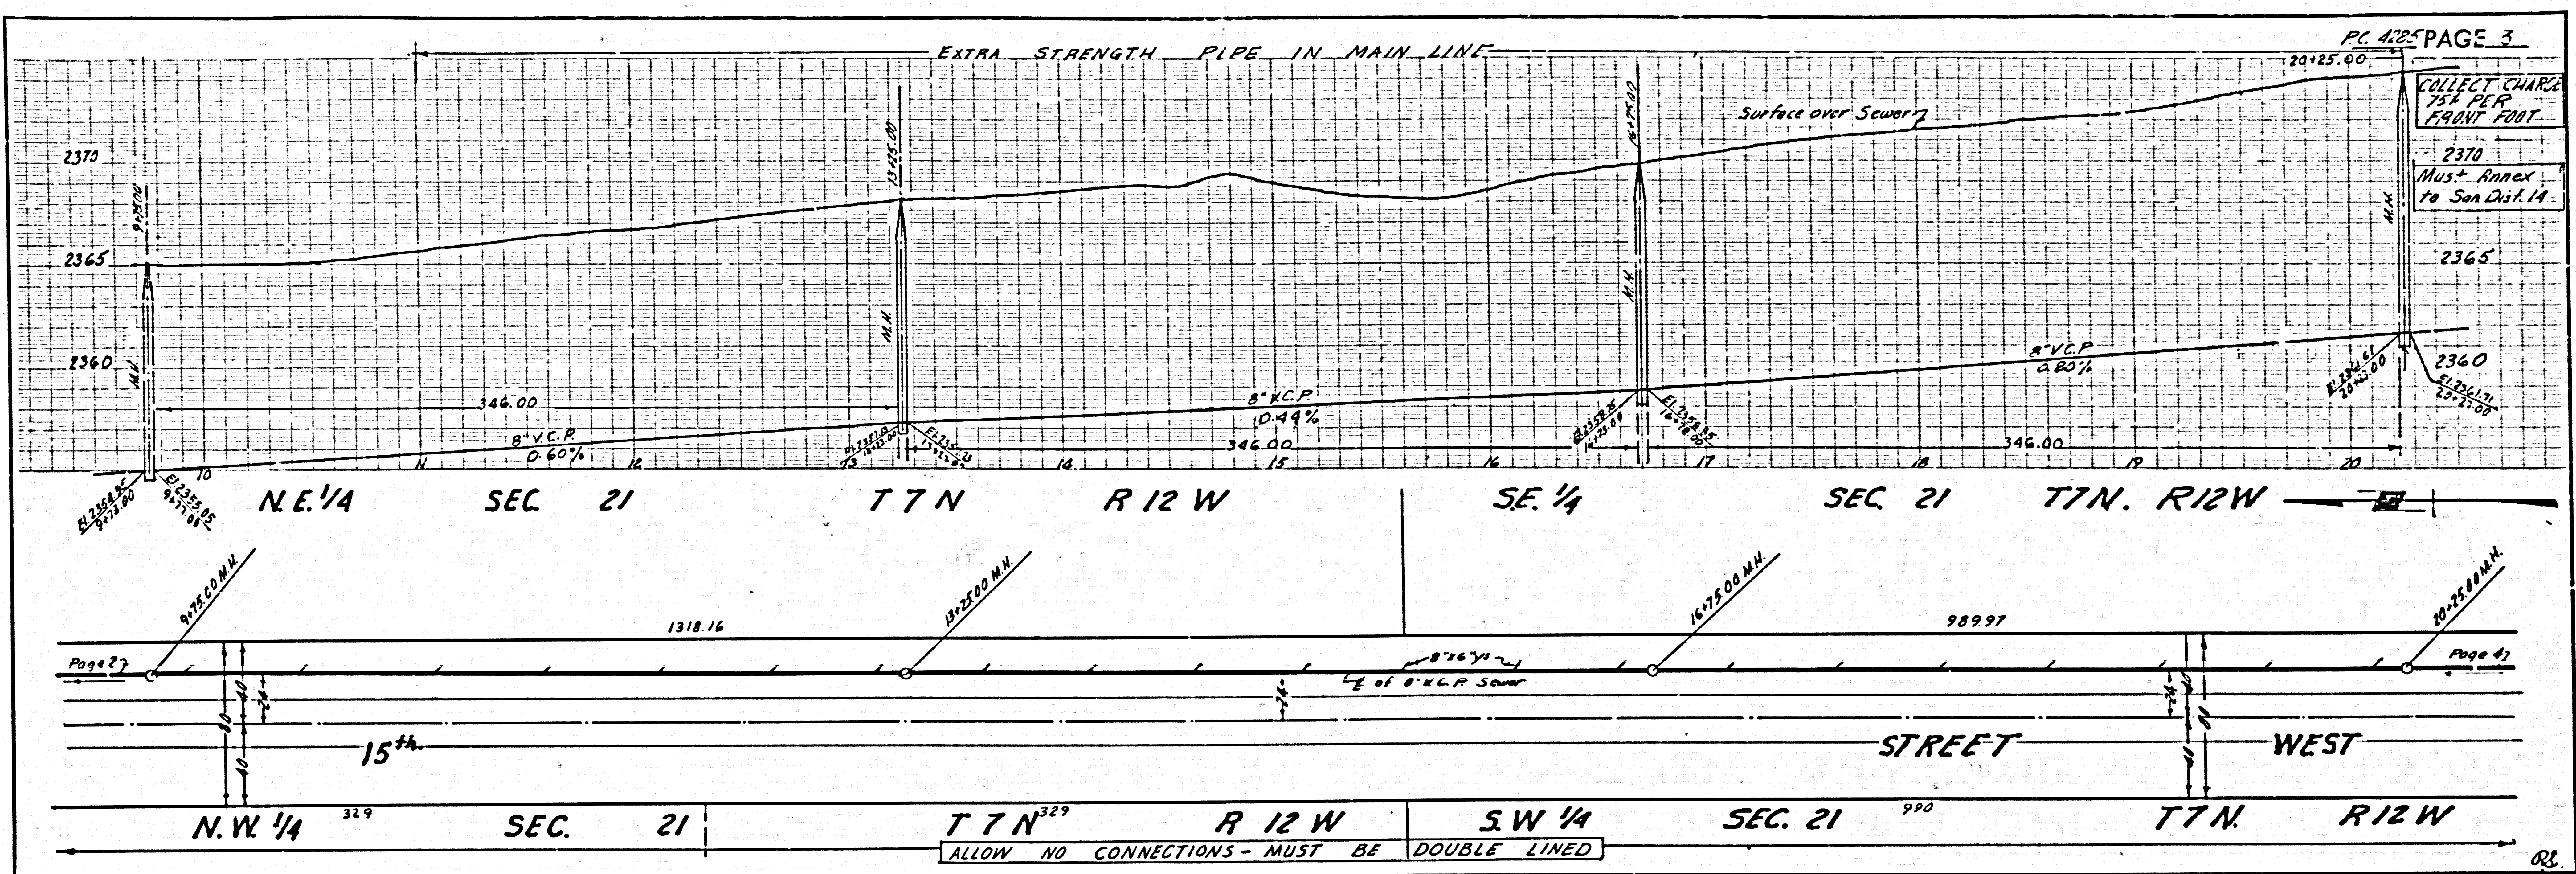


TRACT NO. 17819

NO CHARGE FOR CONNECTIONS

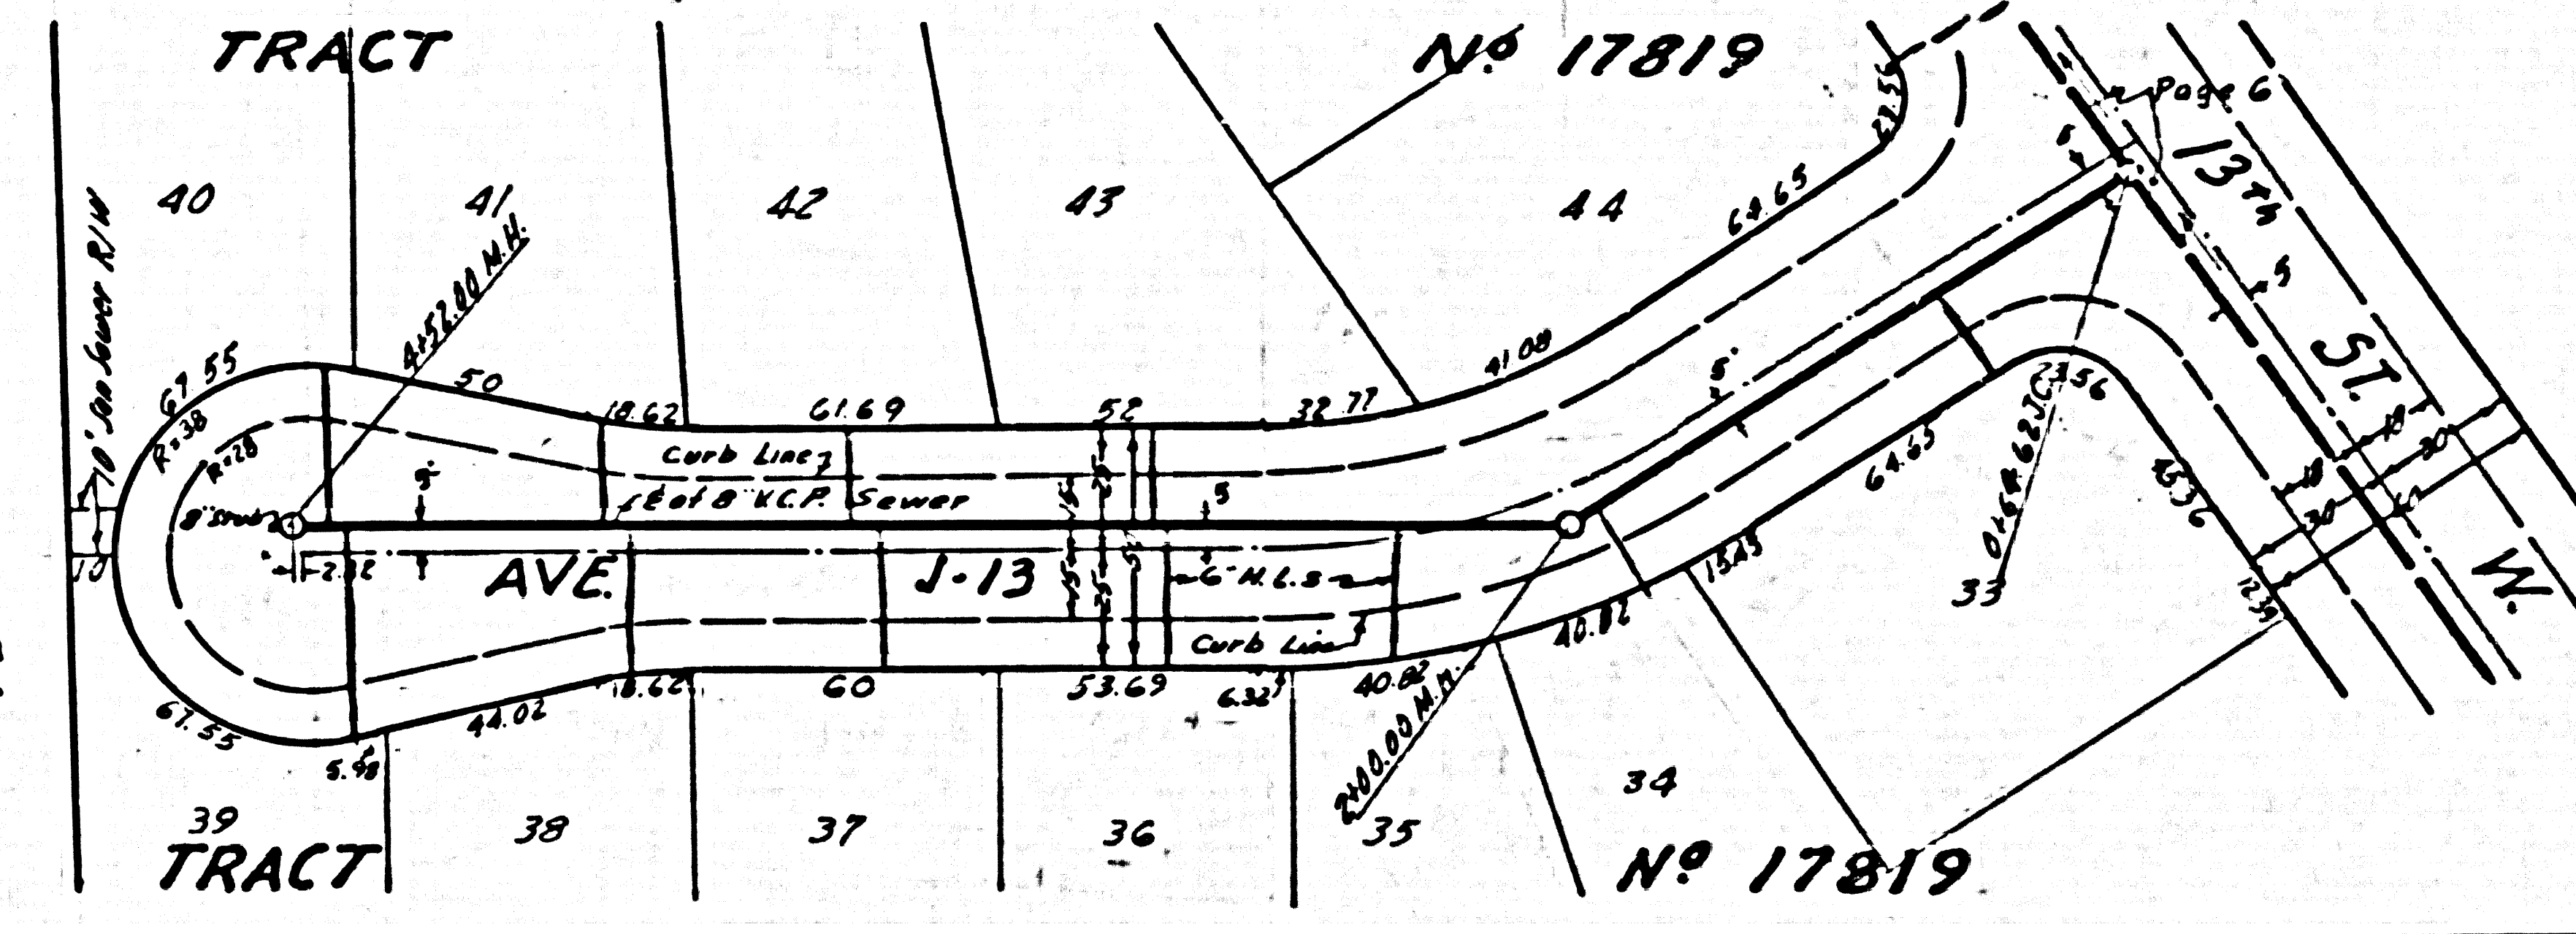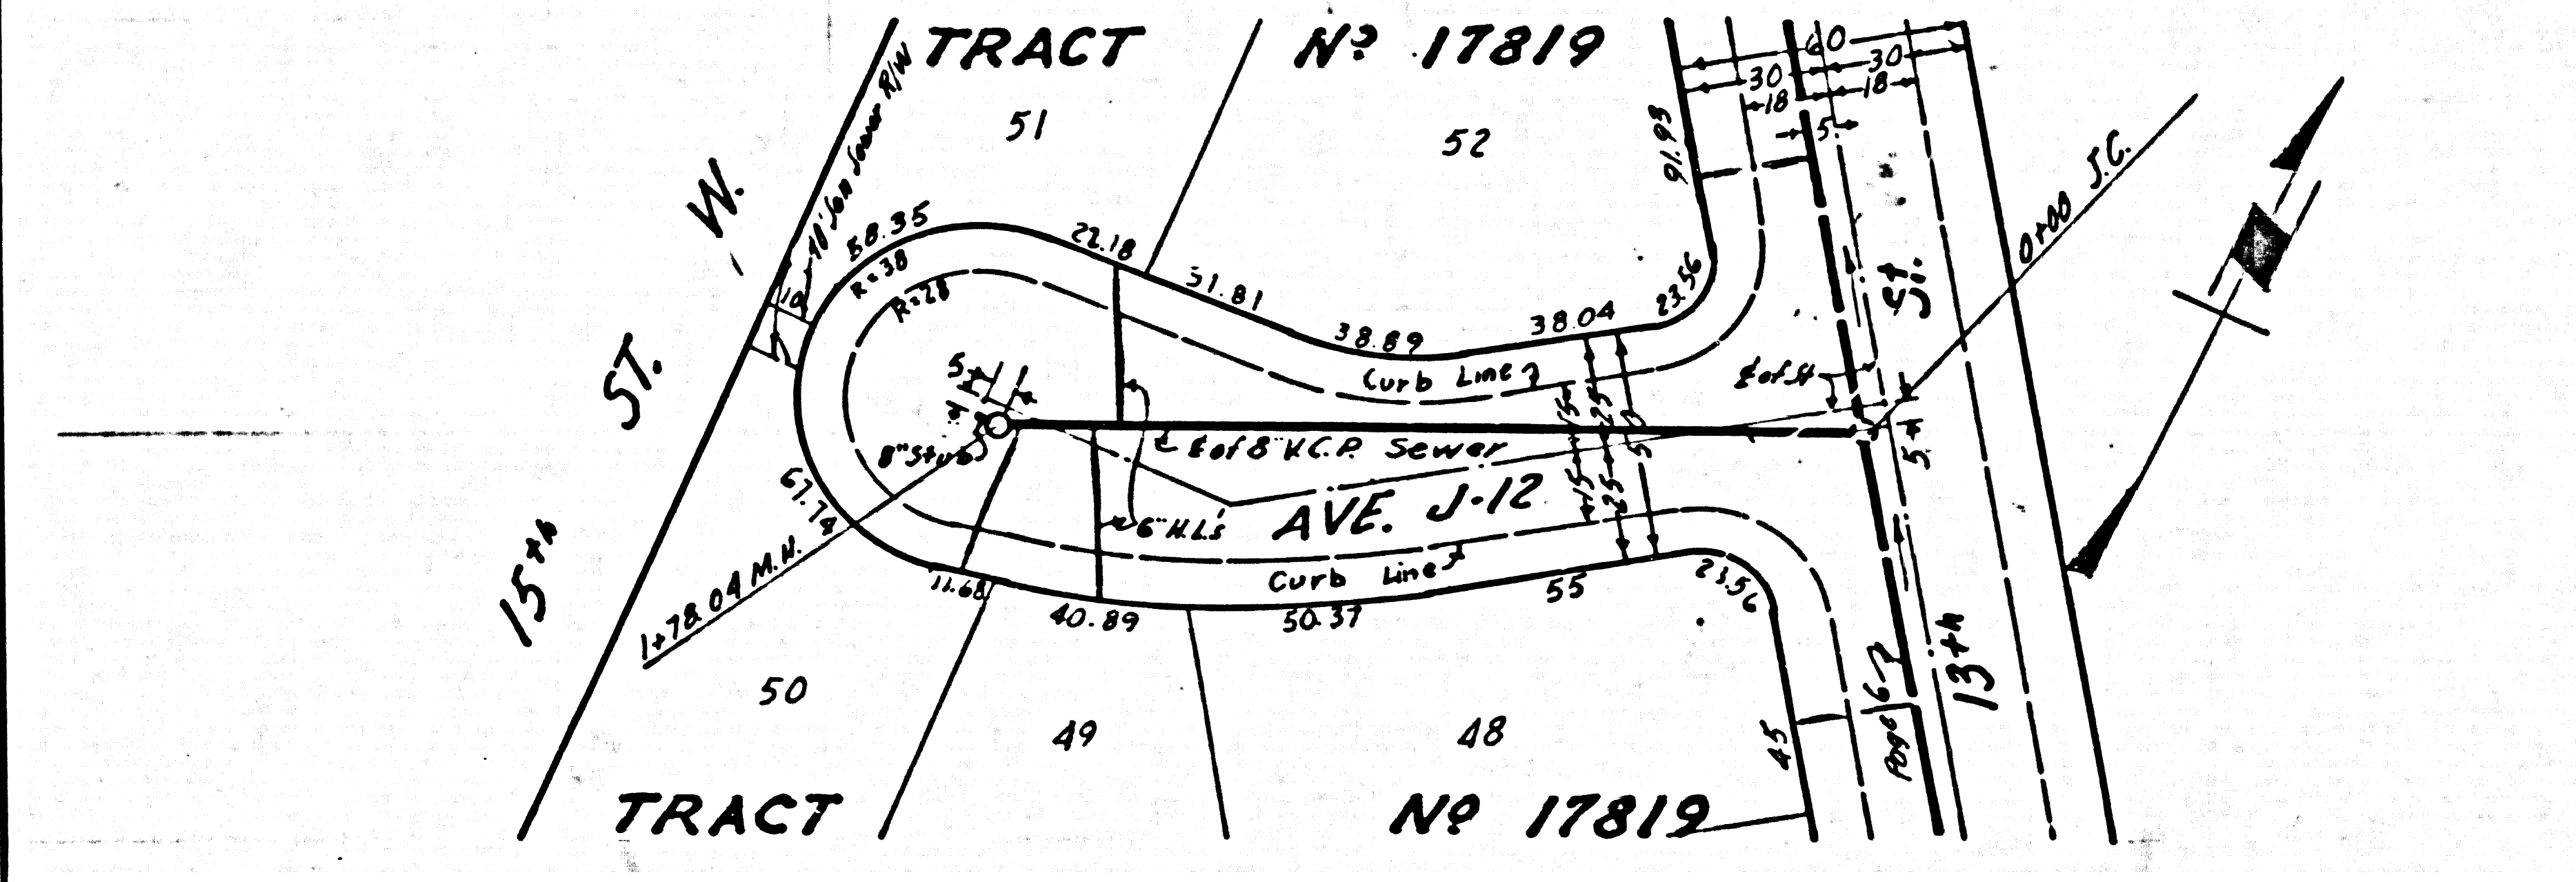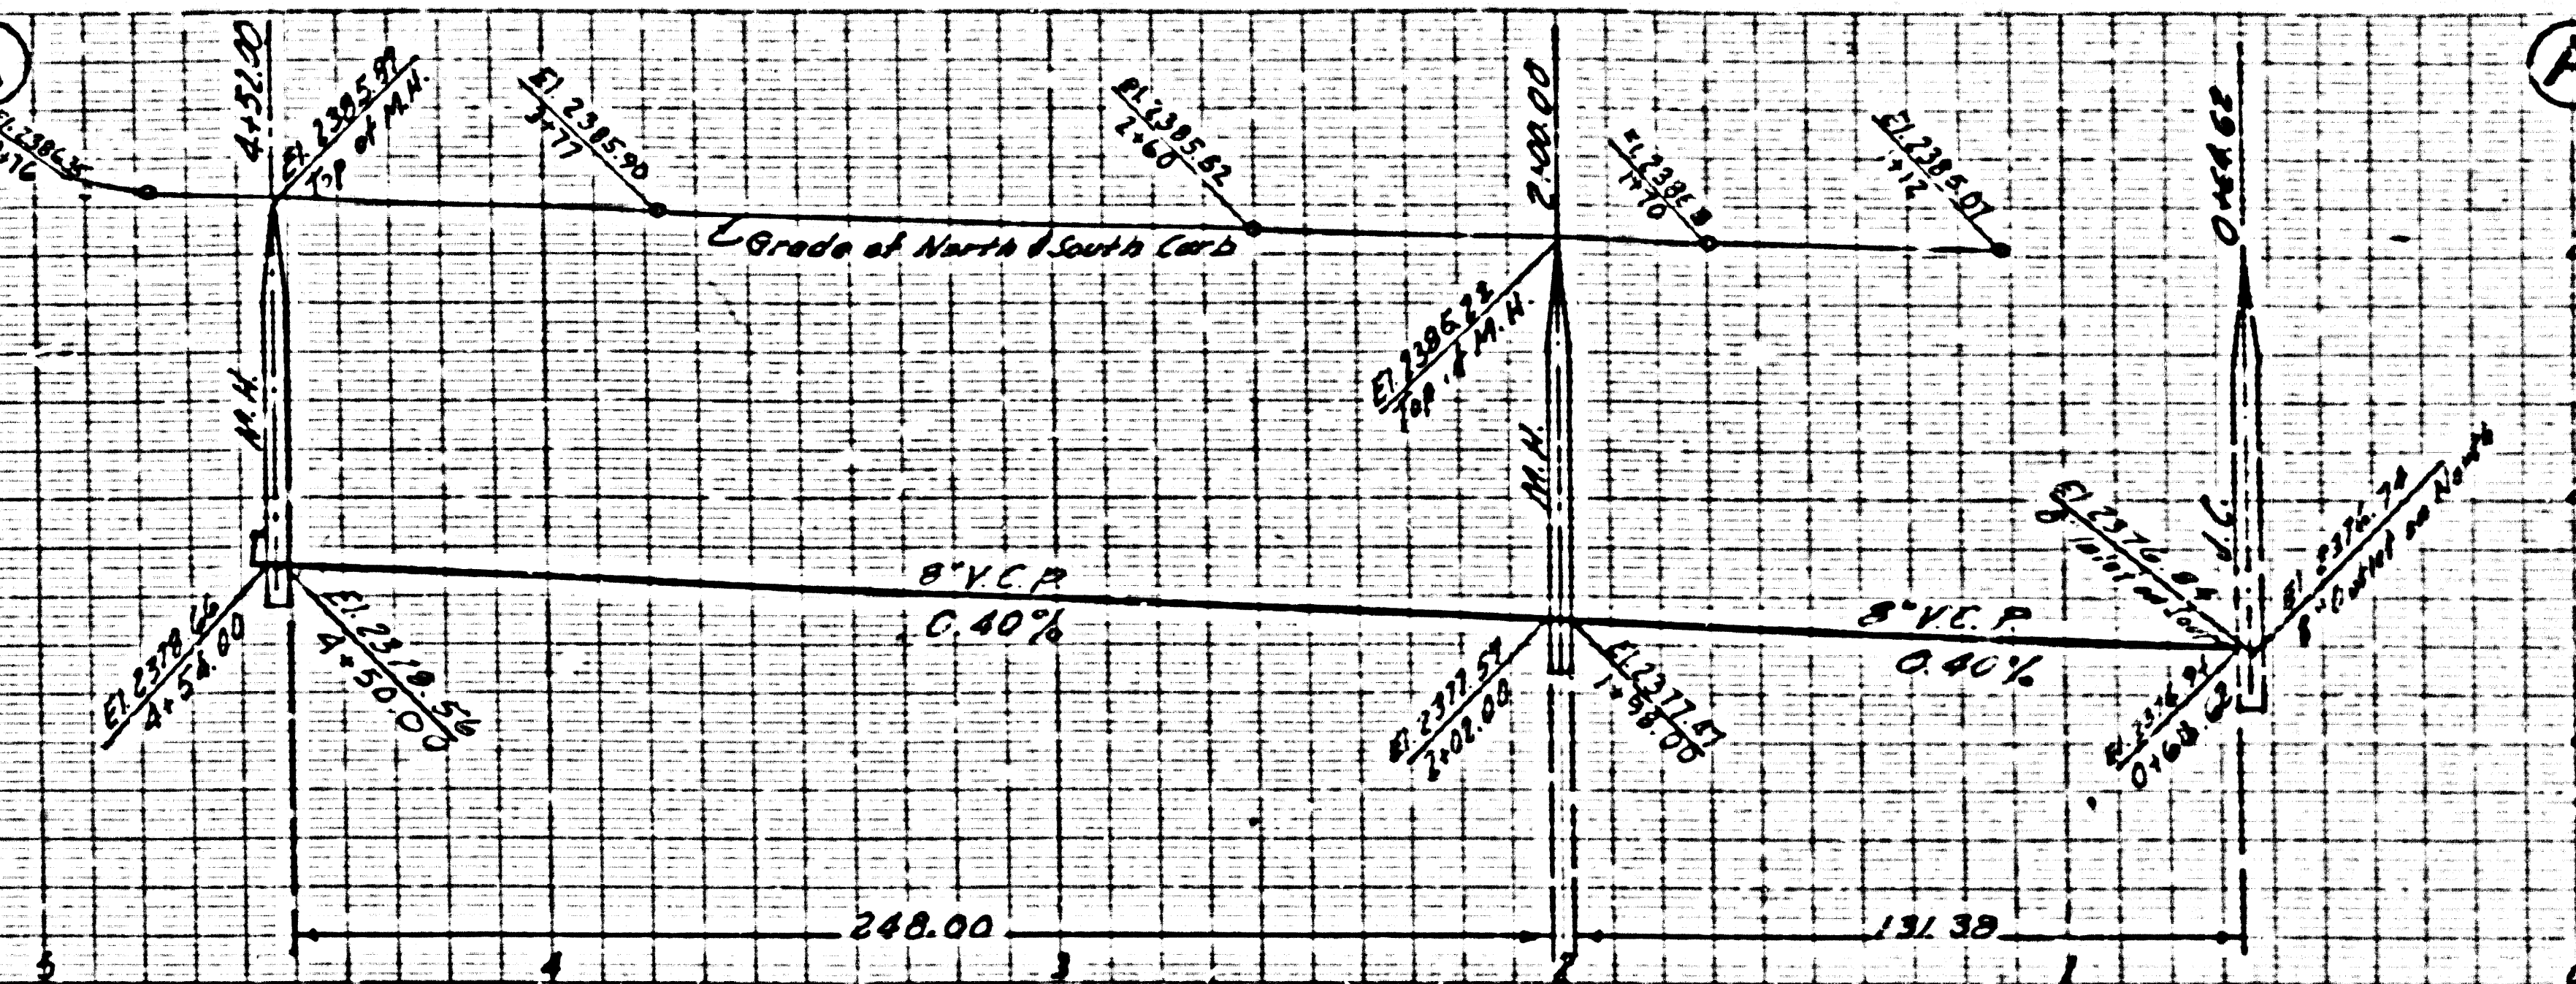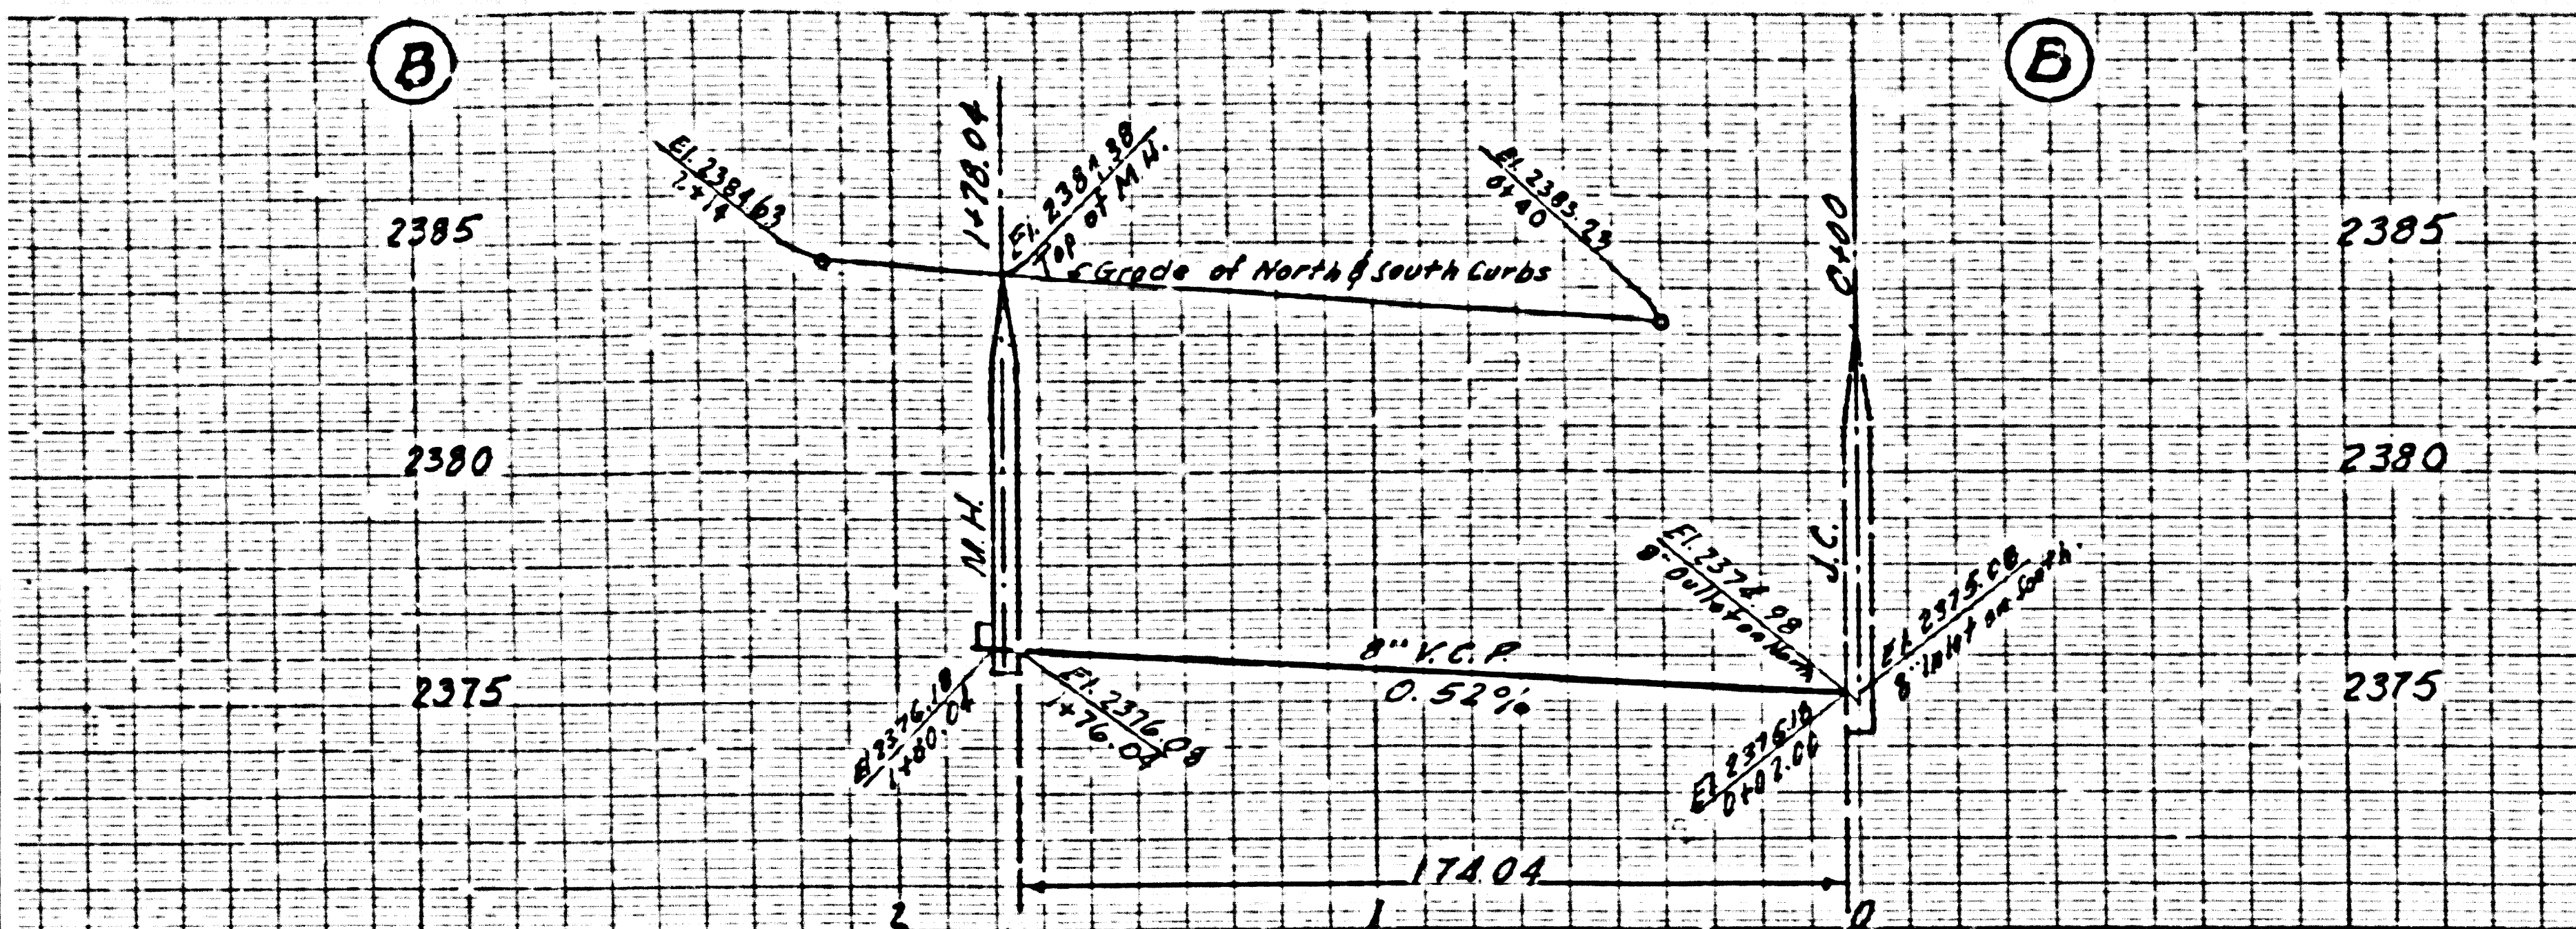


NO CHARGE FOR CONNECTIONS

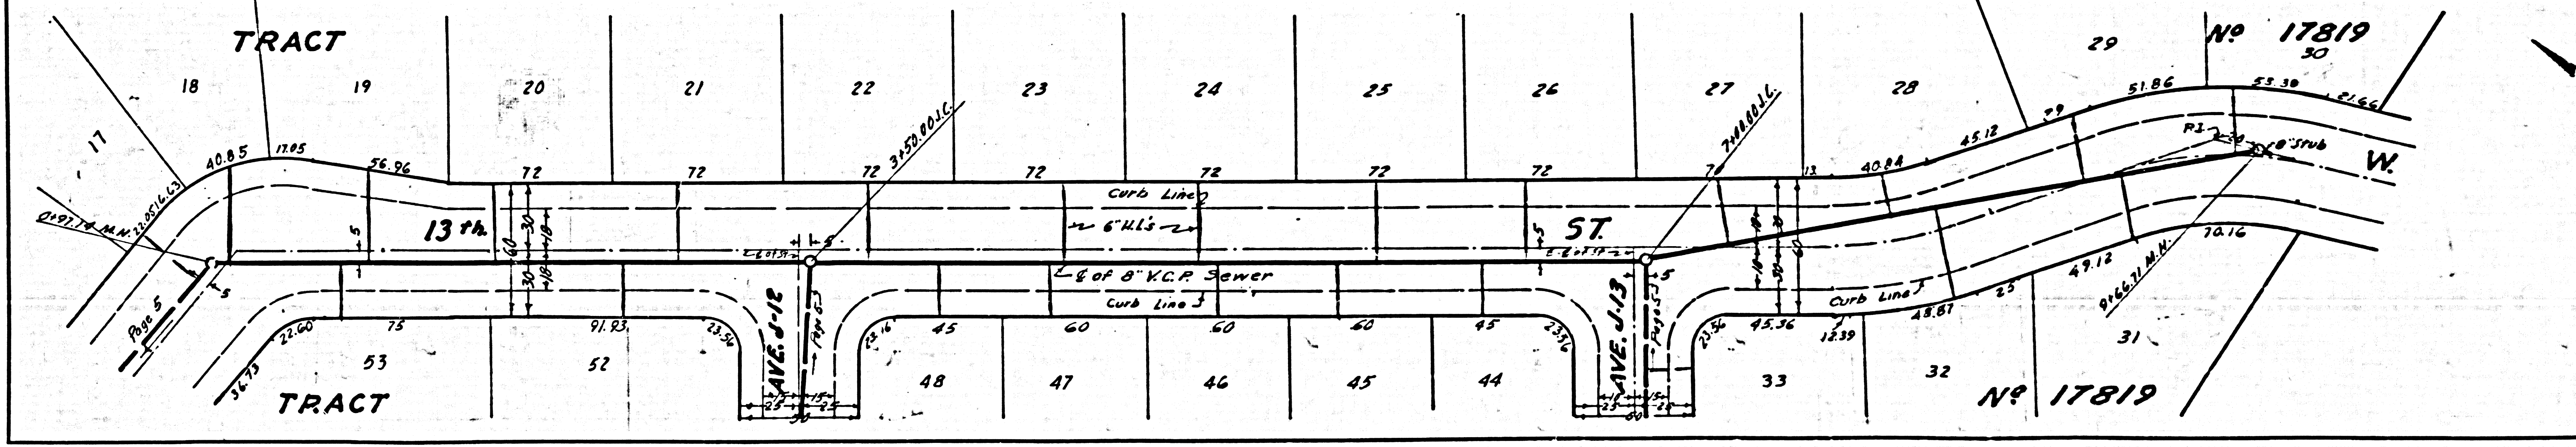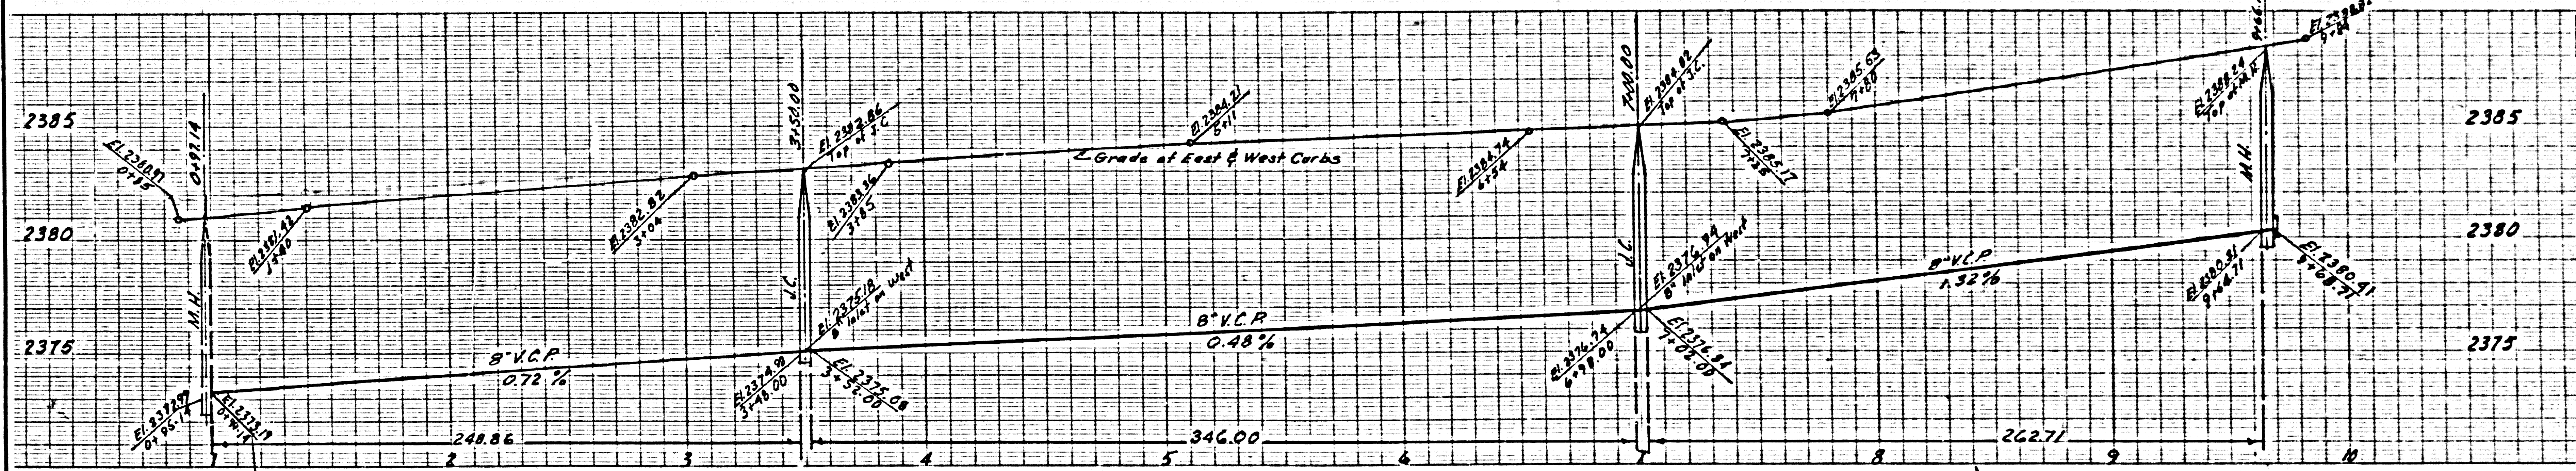

RL

HOUSE LATERALS TO BE CONSTRUCTED WITH 1/4" RISE PER FOOT TO PROPERTY LINE


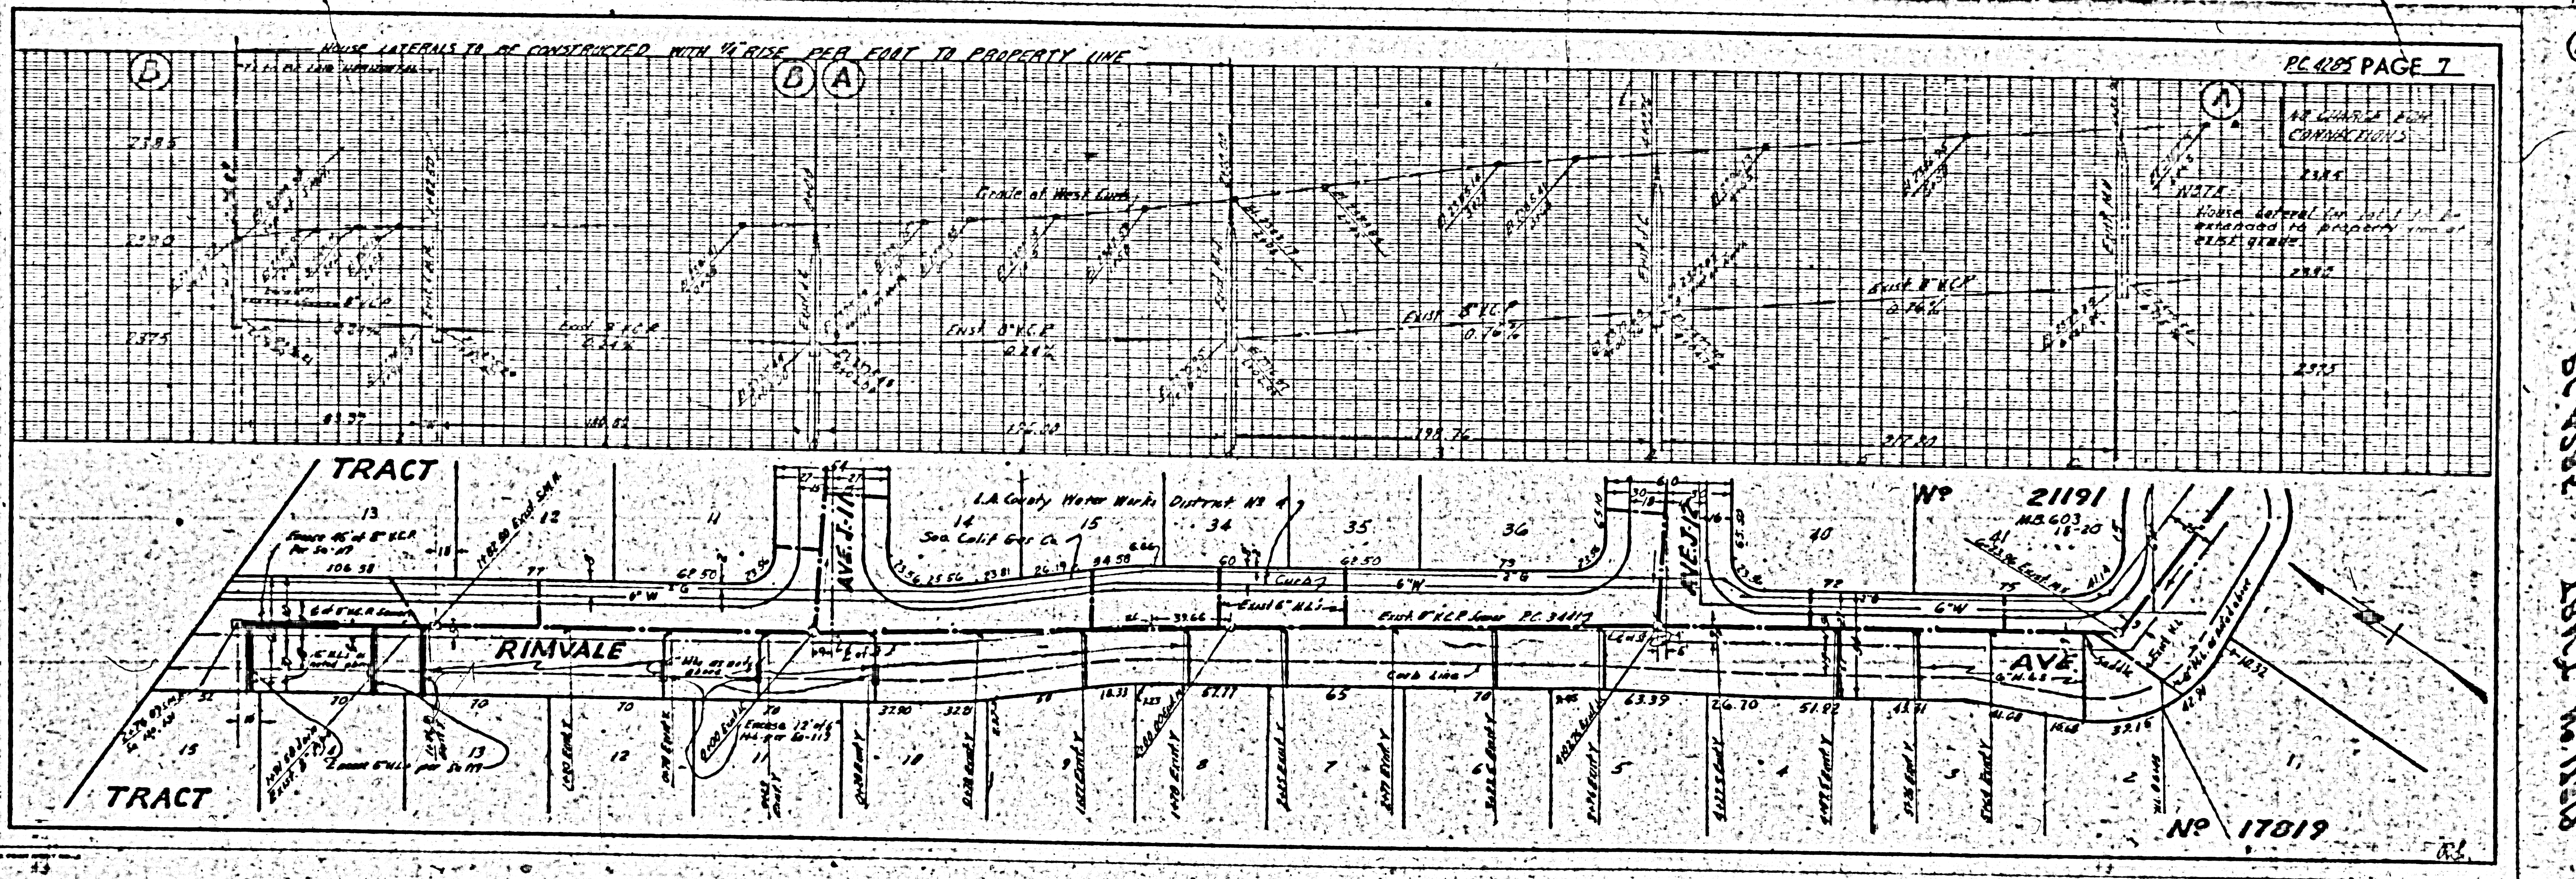


WATER

House lateral for lot 1, 2, 1000

PC 4582

TRAC. NO. 17019