B.M. Rd. Dept. SY 2349 Elev. 51.846
L.&T. near N.E. corner of gasoline station in conc. walk ±80' So. of ℄ of South St. & 70' W. of ℄ Downey Ave. (1958 Base).

LAKEWOOD BLDG. DIST. NO. 4.01

NOTES:

PROVIDE STAKES ON THE PROPERTY LINE OR PROPERTY LINES PRODUCED AT RIGHT ANGLES TO THE SEWER LINE AT THE CENTER LINE OF EACH MANHOLE.

NO REPRESENTATIVE OF THE CITY ENGINEER WILL SURVEY OR LAYOUT ANY PORTION OF THE WORK.

THE OWNER OR HIS AUTHORIZED REPRESENTATIVE SHALL FURNISH THE CITY ENGINEER WITH GRADE SHEETS AND STATION FOR ALL HOUSE LATERALS AND Y BRANCHES AND SHALL PROVIDE STAKES FOR THEM AT THESE PROPER LOCATIONS WITH STATIONING PLAINLY MARKED. ANY CHANGE IN LOCATION SHALL BE REQUESTED IN WRITING BY THE OWNER OR HIS REPRESENTATIVE.

NO REVISIONS SHALL BE MADE IN THESE PLANS WITHOUT THE APPROVAL OF THE CITY ENGINEER.

1. USE STANDARD MANHOLE FRAMES AND COVERS, S-A-117
2. USE STANDARD STRENGTH PIPE
3. USE CEMENT MORTAR, "WEDGE-LOCK", OR "SPEED-SEAL" FOR ALL VITRIFIED CLAY PIPE JOINTS, PER SPECS., SEC. 36 & 40.
4. RESURFACE ALL TRENCH WITHIN PAVED AREA TO MEET L.A. COUNTY ROAD DEPT., OR CALIF. STATE HIGHWAY DEPT. REQUIREMENTS IN ACCORDANCE WITH PERMITS.
5. ENCASE FOUR FEET OF SEWER AT POINTS OF INTERFERENCE WITH POLES, S-A-172, CAS # XIII
6. HOUSE LATERALS TO BE CONSTRUCTED WITH INVERTS AT PROPERTY LINE _____ FEET BELOW CURB GRADE EXCEPT AS NOTED.
7. ALL STRUCTURES SHALL BE BRICK SEWER STRUCTURES, S-A-104,
8. FOR ALLOWABLE LEAKAGE TEST USE FORMULA NO. 1 SPECS., SEC. 54
9. MANHOLE TOPS IN UNIMPROVED RIGHTS-OF-WAY TO BE 6" ABOVE FINISHED GRADE.

NOTE:
THE CONTRACTOR SHALL NOTIFY THE CONSTRUCTION AND STORM DRAIN DIVISION BY TELEPHONE, MADISON 9-4747, EX. 352, AT LEAST 24 HOURS BEFORE STARTING ANY WORK UNDER THIS CONTRACT.

No Charge For Connections
E. Acuedo 8-1-58

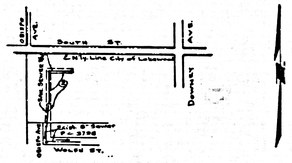

INDEX MAP
Scale-1"=600'
P.C. 4754

APPROVED Chris Whalley 8-1-58
INDUSTRIAL WASTE DIVISION

PROFILE ALIGNMENT AND GRADE OF
J.N. 066214
P.C. 4754
PAGE 1

SANITARY SEWERS

TO BE CONSTRUCTED IN

R/W NORTH OF OBISPO AVENUE

26264

PRIVATE CONTRACT NO. 4754

W.S. 32

1 SHEET ; 2 PAGES

SCALE: VERT. 1"=4' HORIZ. 1"=20' MARCH, 1958

PREPARED IN THE OFFICES OF
OLSON SURVEYING SERVICE

By Thornton E. Parrott
REG. C. E. NO. 7110

FOR LEGEND SEE PLAN NO. S-A-64

NOTE:

GRADES TO WHICH THIS IMPROVEMENT IS TO BE CONSTRUCTED ARE SHOWN ON PLANS AND PROFILES. GRADE POINTS FOR TOP OF CURBS, CENTER LINE OF STREETS, OR CENTER LINE OF ALLEYS ARE SHOWN BY CIRCLES ON PROFILES. AT ALL POINTS BETWEEN DESIGNATED POINTS THE GRADE SHALL BE ESTABLISHED SO AS TO CONFORM TO A STRAIGHT LINE DRAWN BETWEEN SAID DESIGNATED POINTS.

ELEVATIONS ARE IN FEET ABOVE U.S.C.&G.S. SEA LEVEL DATUM OF 1929

THIS DRAWING AND THE DATA HEREON ARE HEREBY MADE A PART OF THE SPECIFICATIONS.

WORK SHALL BE CONSTRUCTED ACCORDING TO SPECIFICATIONS ON FILE IN THE OFFICE OF THE CITY ENGINEER AND SHALL BE PROSECUTED ONLY IN THE PRESENCE OF THE CITY ENGINEER.

BEFORE WORK CAN BE STARTED, THE CONTRACTOR MUST OBTAIN A PERMIT TO EXCAVATE IN CITY STREETS FROM THE L. A. COUNTY ROAD DEPT., DIST. No 6 , AND MAKE A DEPOSIT WITH THE CITY ENGINEER, ROOM 234 PAN AMERICAN BUILDING, 353 SO. BROADWAY SUFFICIENT TO COVER THE COST OF CONSTRUCTION INSPECTION AND RECORD PLANS.

APPROVAL OF THIS PLAN BY THE CITY OF LAKEWOOD DOES NOT CONSTITUTE A REPRESENTATION AS TO THE ACCURACY OF THE LOCATION OF OR THE EXISTENCE OR NON EXISTANCE OF ANY UNDERGROUND UTILITY PIPE, OR STRUCTURE WITHIN THE LIMITS OF THIS PROJECT. THIS NOTE APPLIES TO ALL PAGES.

IF WORK IS TO BE DONE IN A STATE HIGHWAY, A PERMIT MUST BE OBTAINED FROM THE STATE OF CALIFORNIA, DIVISION OF HIGHWAYS, 138 SOUTH SPRING STREET.

CITY OF LAKEWOOD, CALIFORNIA

APPROVED, JOHN A. LAMBIE, CITY ENGINEER

BY C. H. Hughes
SANITATION ENGINEER

APPROVED, A. M. RAWN, CHIEF ENGINEER
CO. SAN. DIST. NO. 3

BY W. Cornhauser
OFFICE ENGINEER

CHECKED BY J. C. Wirth 8-1-58
OFFICE OF CITY ENGINEER, REG. C. E. NO. 9406

RECOMMENDED BY John L. Estow 8-1-58
LOS CERRITOS REGIONAL ENGINEER, REG. C.E. No 3871

P.C. 4754 PAGE 2

26265

No Charge For Connections

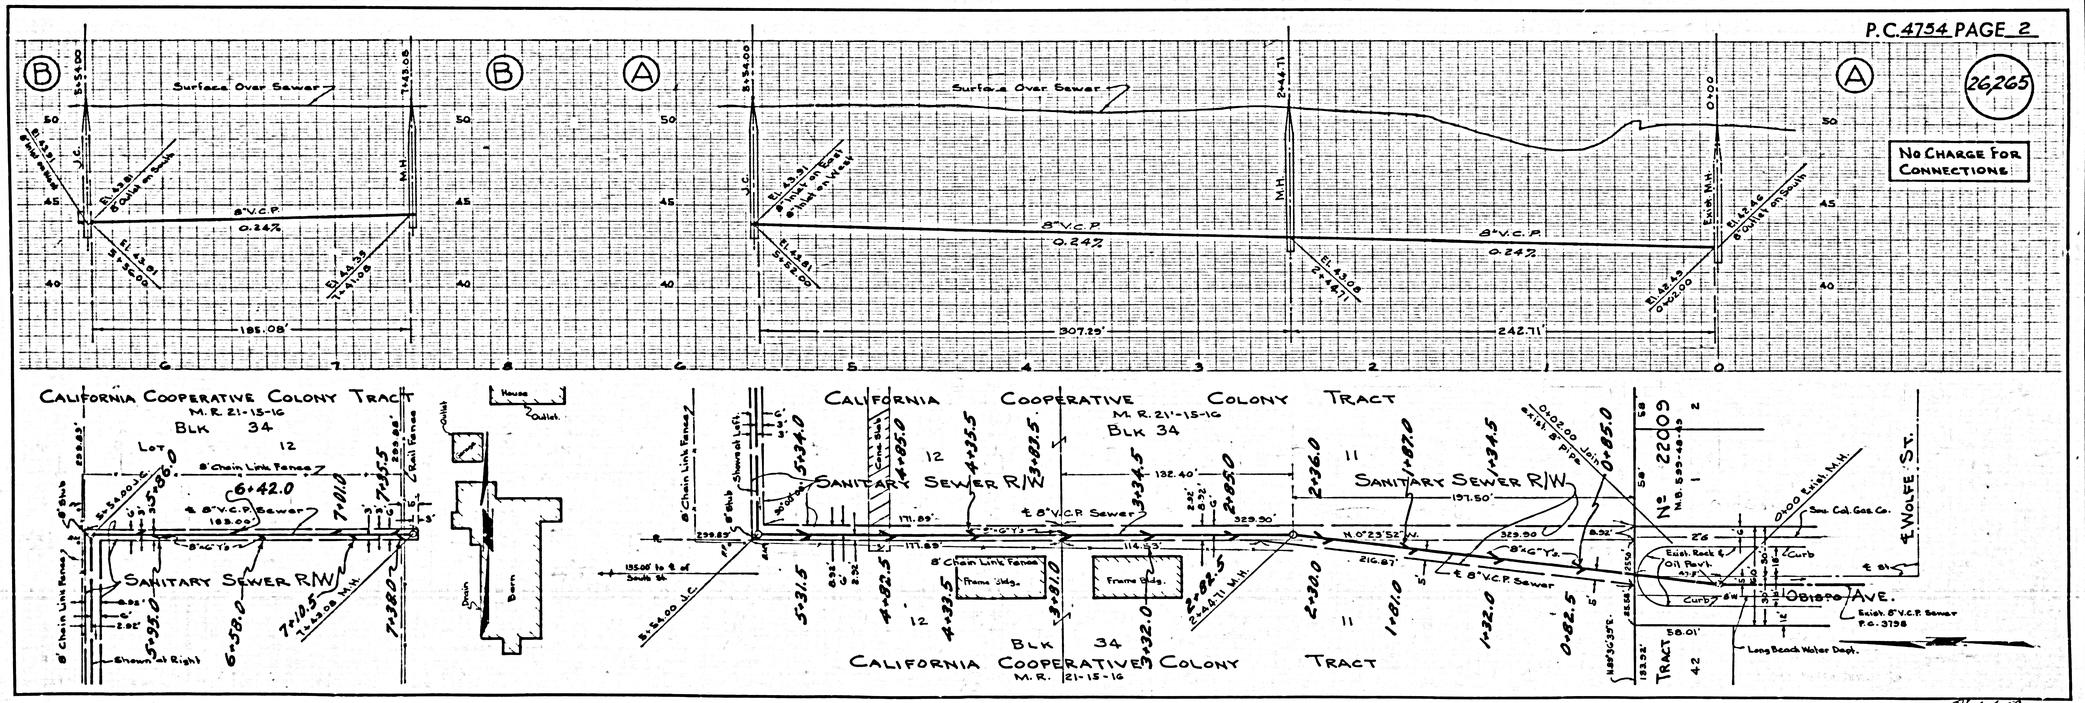

OK 4-6-58