B.M. SY 3895 El. 25.160 Ram set in conc. punt
±14.5' W. & Broadway & 110'N & int.
of Broadway & 174th St. Gardena Quad, 1955

ARTESIA BLVD.

Exist. 8" Sewer P.C. 4795

Exist. 18" Trunk Sewer San. Dist. No 8

Scale: 1"=600'

INDEX MAP
P.C. 4938

LENNOX BLDG. DIST. NO. 7

NOTES.

1. PROVIDE STAKES ON THE PROPERTY LINE OR PROPERTY LINES PRODUCED AT RIGHT ANGLES TO THE SEWER LINE AT THE CENTER LINE OF EACH MANHOLE
2. NO REPRESENTATIVE OF THE COUNTY ENGINEER WILL SURVEY OR LAY OUT ANY PORTION OF THE WORK.
3. THE OWNER OR HIS AUTHORIZED REPRESENTATIVE, SHALL FURNISH THE COUNTY ENGINEER WITH GRADE SHEETS AND STATIONING FOR ALL HOUSE LATERALS AND Y BRANCHES AND SHALL PROVIDE STAKES FOR THEM AT THESE PROPER LOCATIONS WITH STATIONING PLAINLY MARKED. ANY CHANGE IN LOCATION SHALL BE REQUESTED OR WRITTEN BY THE OWNER OR HIS REPRESENTATIVE.
4. THE PRIVATE ENGINEER SHALL FURNISH THE HOUSE LATERAL DEPTH AT THE PROPERTY LINE BELOW THE TOP OF CURB ELEVATION FOR EACH HOUSE LATERAL ON THE GRADE SHEET.
5. NO REVISIONS SHALL BE MADE ON THESE PLANS WITHOUT THE APPROVAL OF THE COUNTY ENGINEER.
6. USE STANDARD MANHOLE FRAMES AND COVERS, S-a-112, EXCEPT AS NOTED.
7. USE STANDARD STRENGTH PIPE EXCEPT AS NOTED.
8. USE CEMENT MORTAR OR "HERCULOCK" OR "SPEED SEAL" FOR ALL V.C.P. JOINTS PER SPEC'S., SECT. 26 & 48.
9. RESURFACE ALL TRENCHES WITHIN PAVED AREA TO 80'W L.A. COUNTY ROAD DEPT. OR CALIF. STATE HIGHWAY REQUIREMENTS IN ACCORDANCE WITH PERMITS.
10. ENCASE FOUR FEET OF SEWER AT POINTS OF INTERFERENCE WITH PIPES, CASE III, S-a-172.
11. HOUSE LATERALS TO BE CONSTRUCTED WITH DIVERSE OF PROPERTY LINE ~~FOUR STRAIGHT GRADE SECTIONS~~ AS NOTED.
12. ALL STRUCTURES SHALL BE BRICK SEWER STRUCTURES, S-a-104, EXCEPT AS NOTED.
13. FOR ALLOWABLE LEAKAGE TEST USE FORMULA NO. 1, SPEC 8, SEC. 24.
14. MANHOLE TOPS IN UNIMPROVED RIGHTS-OF WAY TO BE SIX INCHES ABOVE FINISHED GRADE.
15. THE CONTRACTOR SHALL NOTIFY THE CONSTRUCTION & STORM DRAIN DIVISION BY TELEPHONE, MADISON 9-4111, EXT. 260, AT LEAST TWENTY-FOUR HOURS BEFORE STARTING ANY WORK UNDER THIS CONTRACT.

NO CHARGE FOR CONNECTIONS
D. Cuatro 12-10-58

Revision: Moved M.H. from 4+58.00 to 4+38.00
Approved: Carl L. Pearson 12/16/58
Office of County Engineer, Reg. C.E. No. 9439

PROFILE ALIGNMENT AND GRADE OF P.C. 4938

SANITARY SEWERS PAGE 1

TO BE CONSTRUCTED IN

BROADWAY

26,615

PRIVATE CONTRACT NO. 4938

W.S. 26

1 SHEET, 2 PAGES

SCALE: HORIZ. 1"=40' VERT. 1"=4' OCT., 1958

PREPARED IN THE OFFICES OF

BARCLAY-PEARSON ENGINEERING CO.

By Edward L. Pearson
REG. C. E. NO. 9295

FOR LEGEND SEE PLAN NO. S-A-64

NOTE

GRADES TO WHICH THIS IMPROVEMENT IS TO BE CONSTRUCTED ARE SHOWN ON PLANS AND PROFILES. GRADE POINTS FOR TOP OF CURBS, CENTER LINE OF STREETS, OR CENTER LINE OF ALLEYS ARE SHOWN BY CIRCLES ON PROFILES. AT ALL POINTS BETWEEN DESIGNATED POINTS THE GRADE SHALL BE ESTABLISHED SO AS TO CONFORM TO A STRAIGHT LINE DRAWN BETWEEN SAID DESIGNATED POINTS.

ELEVATIONS ARE IN FEET ABOVE U.S.C. & G.S. SEA LEVEL DATUM OF 1929

THIS DRAWING AND THE DATA THEREON ARE HEREBY MADE A PART OF THE SPECIFICATIONS.

WORK SHALL BE CONSTRUCTED ACCORDING TO SPECIFICATIONS ON FILE IN THE OFFICE OF THE COUNTY ENGINEER AND SHALL BE PROSECUTED ONLY IN THE PRESENCE OF THE COUNTY ENGINEER.

BEFORE WORK CAN BE STARTED, THE CONTRACTOR MUST OBTAIN A PERMIT TO EXCAVATE IN COUNTY STREETS FROM THE L.A. COUNTY ROAD DEPT., DISTRICT OFFICE NO. 3 AND MAKE A DEPOSIT WITH THE COUNTY ENGINEER, ROOM 324 RAM AMERICAN BUILDING, 253 SO. BROADWAY SUFFICIENT TO COVER THE COST OF CONSTRUCTION INSPECTION AND RECORD PLANS.

APPROVAL OF THIS PLAN BY THE COUNTY OF LOS ANGELES DOES NOT CONSTITUTE A REPRESENTATION AS TO THE ACCURACY OF THE LOCATION OF OR THE EXISTENCE OR NON-EXISTENCE OF ANY UNDERGROUND UTILITY PIPE, OR STRUCTURE WITHIN THE LIMITS OF THIS PROJECT. THIS NOTE APPLIES TO ALL PAGES.

IF WORK IS TO BE DONE ON A STATE HIGHWAY, A PERMIT MUST BE OBTAINED FROM THE STATE OF CALIFORNIA, DIVISION OF HIGHWAYS, 120 SOUTH SPRING STREET.

COUNTY OF LOS ANGELES, CALIFORNIA

APPROVED, JOHN A. LAMBIE, COUNTY ENGINEER

BY C. A. Hughes
SANITATION ENGINEER

APPROVED, C.E. CHIEF ENGINEER
BY H. Freethy
OFFICE ENGINEER

CHECKED BY SK Date 12-11-58

OFFICE OF COUNTY ENGINEER, REG. C. E. NO. 9406

Approved By Bernard Valesky 12/9/58
Industrial Waste Division

P.C. 4938 PAGE 2

NO CHARGE FOR CONNECTIONS

26,616

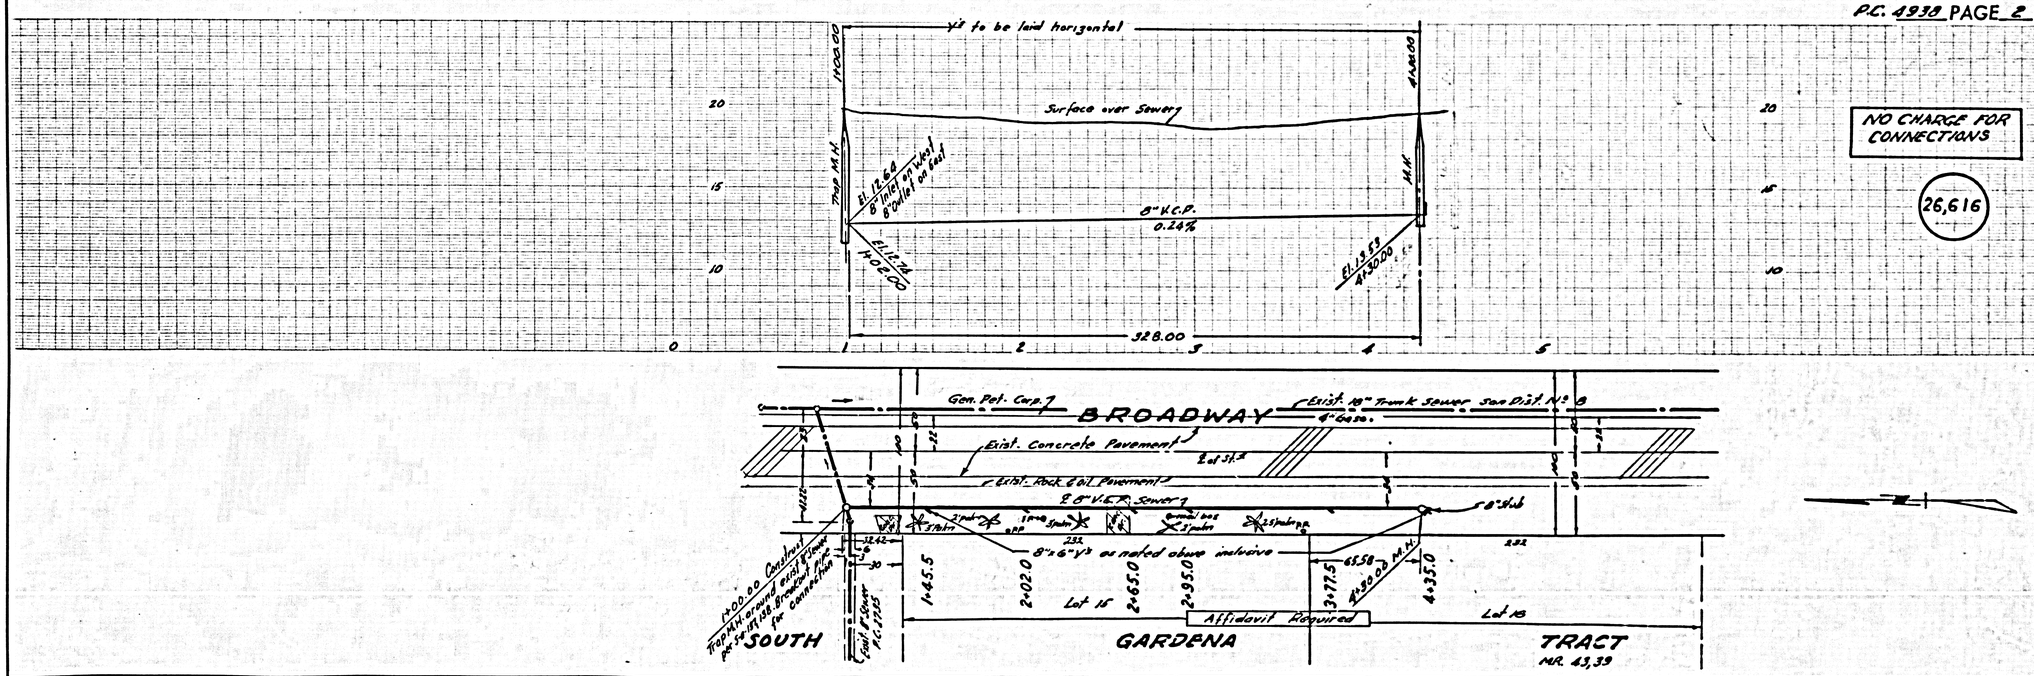

E.I.C. 11-25-58

E. & C. 1140 DO. CAL. BLUE PRINT SHEET NO. 2