




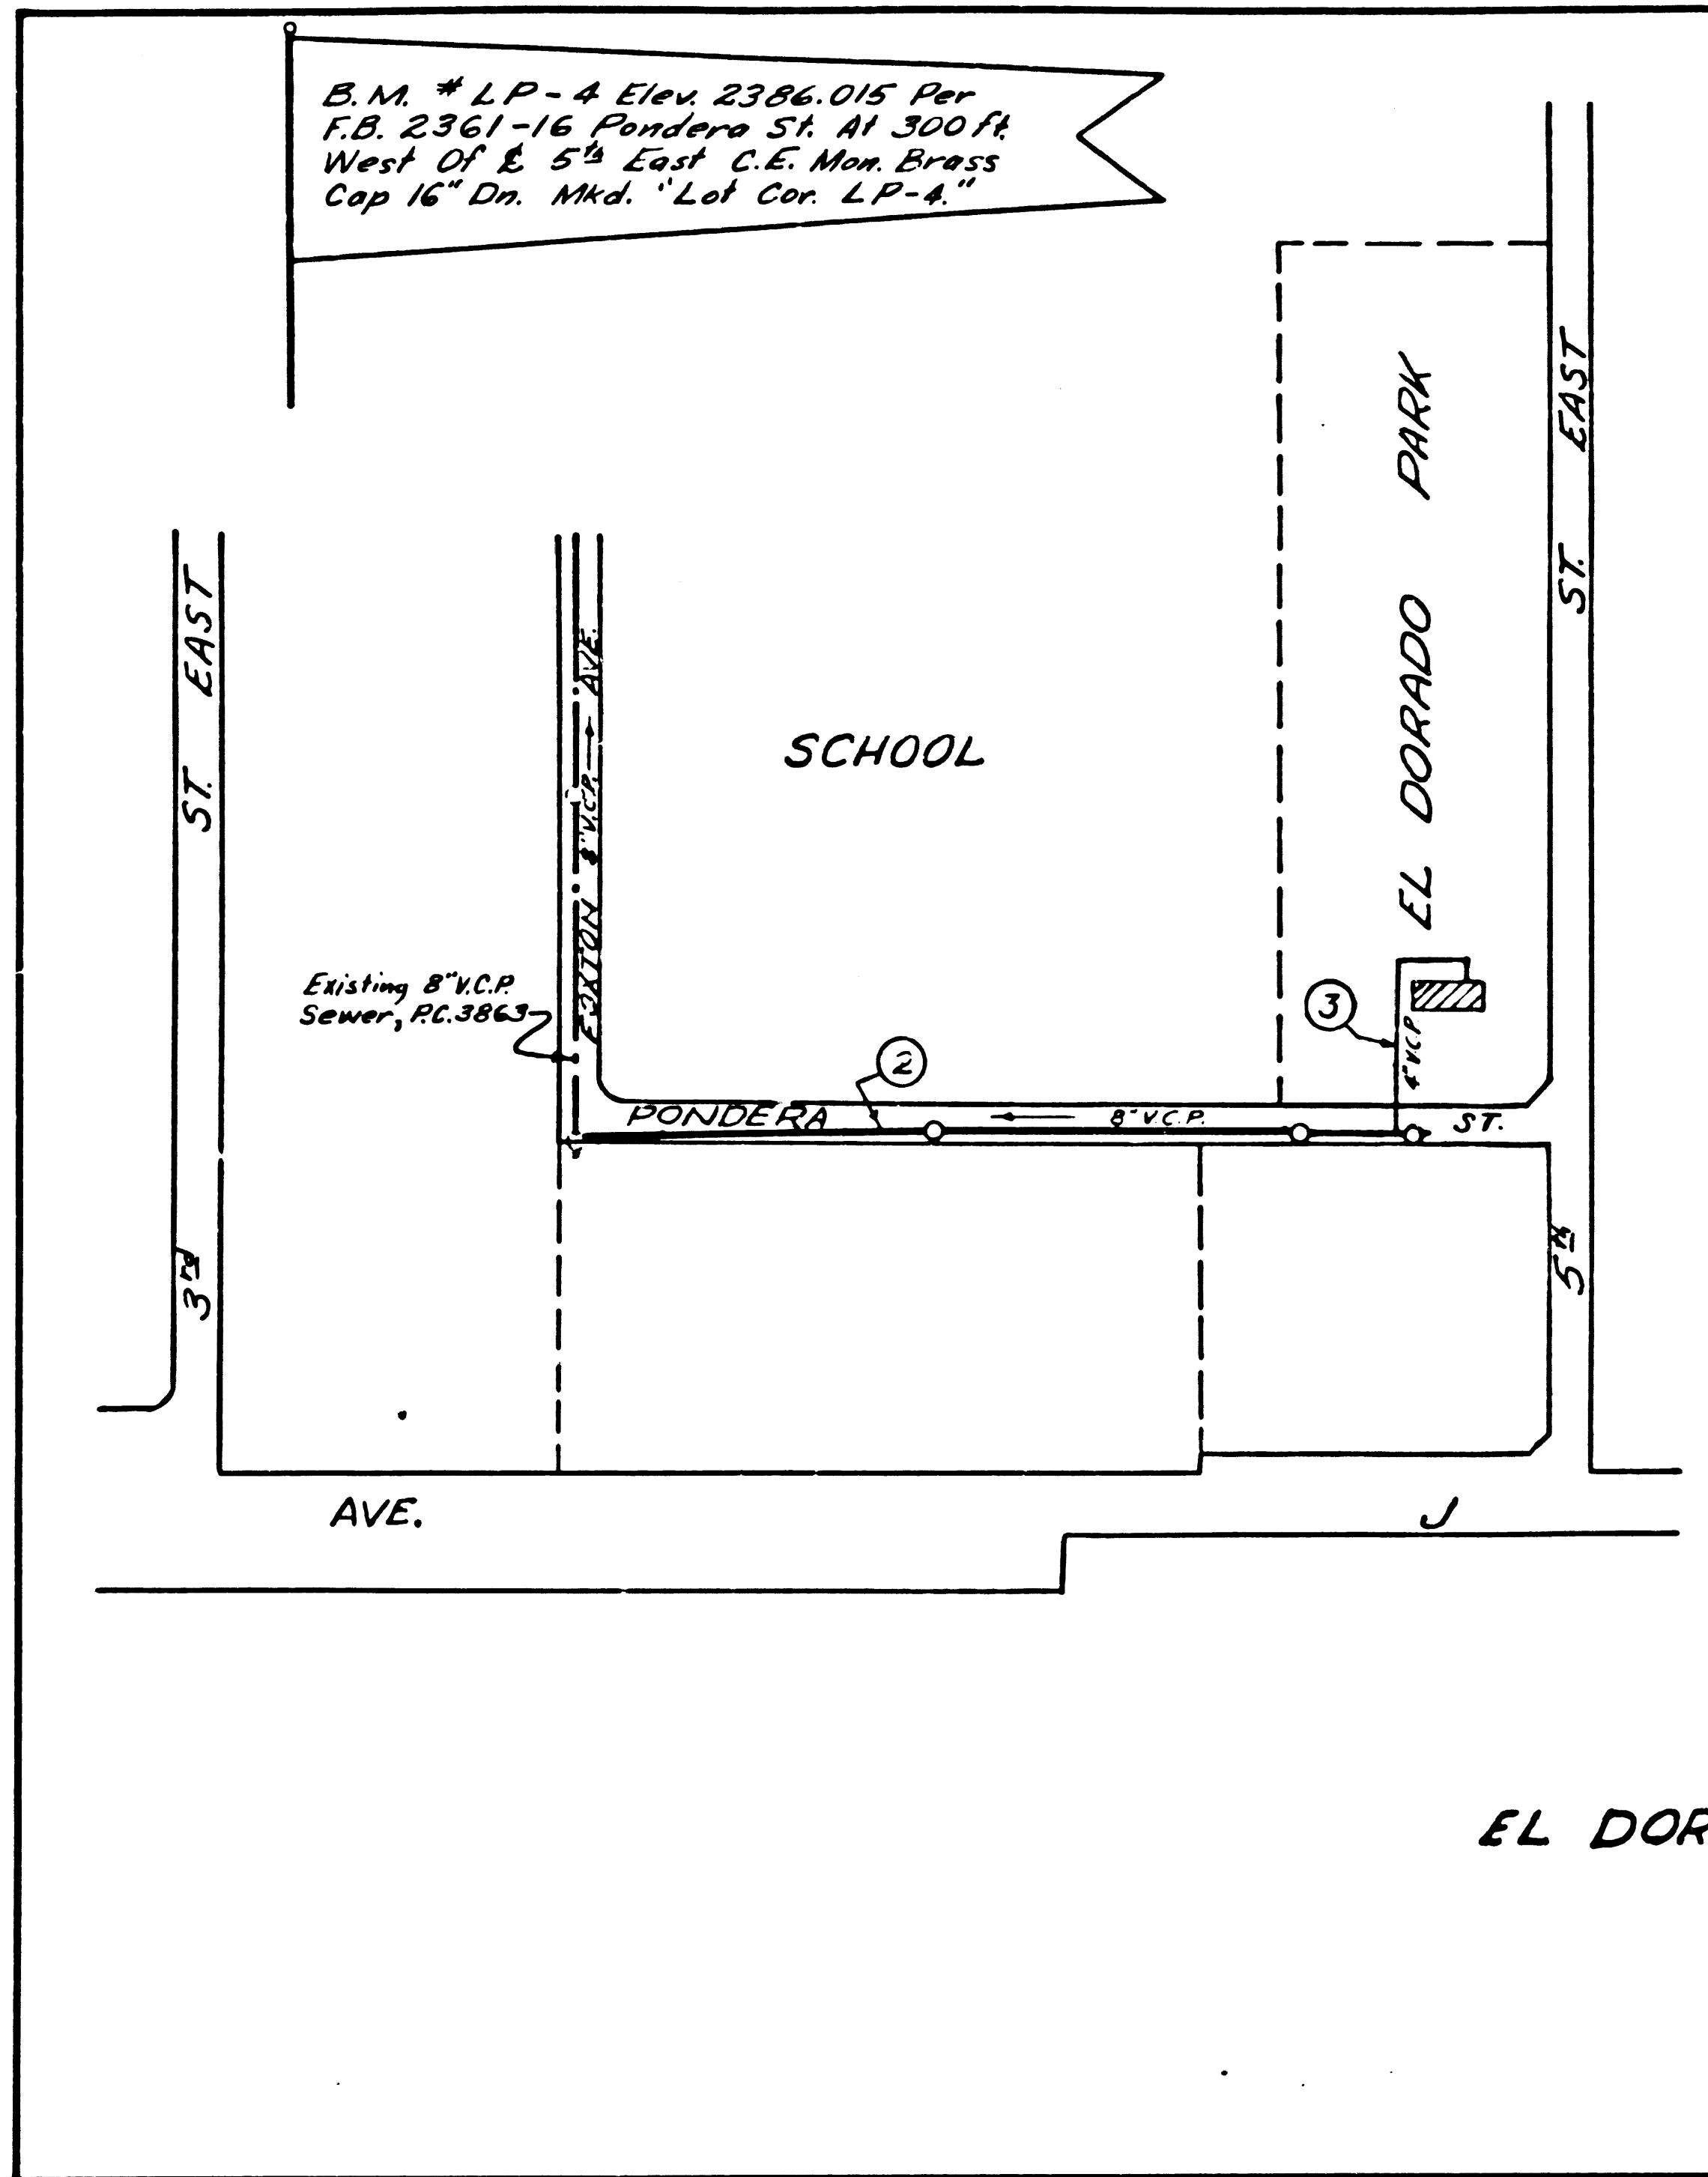

INDEX MAP
EL DORADO PARK P.C. 5920
Scale 1"=200'

LANCASTER BUILDING DISTRICT NO. 8

USE STANDARD STRENGTH PIPE ~~EXCEPT AS NOTED~~
JOINTS SHALL BE "WEDGE-LOCK" OR "SPEED-SEAL" OR EQUAL AS SPECIFIED IN SECTIONS 36 AND 48 OF THE STANDARD SPECIFICATIONS. ALL STRUCTURES SHALL BE BRICK SEWER STRUCTURES AS PER PLAN NO. S-A-104, ~~EXCEPT AS NOTED~~

USE STANDARD MANHOLE FRAMES AND COVERS AS PER PLAN NO. S-A-117, ~~EXCEPT AS NOTED~~

RESURFACE TRENCH WITHIN PAVED AREA WITH PREMIX ROCK AND OIL 3 INCHES IN THICKNESS ~~EXCEPT AS NOTED~~ ON 4 INCHES OF AGGREGATE BASE MATERIAL.

USE FORMULA NO. 1 SEC. 54 OF SPECIFICATIONS TO COMPUTE ALLOWABLE LEAKAGE.

THE CONTRACTOR SHALL NOTIFY THE CONSTRUCTION DIVISION BY TELEPHONE MADISON 9-4747, EXT. 81551 AT LEAST 24 HOURS BEFORE STARTING ANY WORK UNDER THIS CONTRACT.

~~CONSTRUCT HOUSE LATERALS WITH INVERTS AT PROPERTY LINE~~
~~3 FEET BELOW CURB GRADE, OR GRADE OF CENTER LINE OF STREET EXCEPT AS NOTED~~

FIGURES IN CIRCLES AT ENDS OF HOUSE LATERALS INDICATE DEPTH BELOW CURB GRADE, OR GRADE OF CENTER LINE OF STREET.

FIGURES IN CIRCLES AT ENDS OF HOUSE LATERALS INDICATE HOUSE LATERAL SHALL BE CONSTRUCTED WITH "W" INCH PER FOOT TO PROPERTY LINE.

WORDS IN CIRCLES AT ENDS OF HOUSE LATERALS INDICATE "W" SHALL BE FEET HORIZONTAL AND HOUSE LATERALS SHALL BE CONSTRUCTED WITH "W" INCH PER FOOT TO PROPERTY LINE.

~~CONSTRUCTION IN STATE HIGHWAYS SHALL CONFORM WITH STATE HIGHWAY PERMITS~~

L.A. CO. STANDARD SPECIFICATIONS FOR SANITARY SEWERS DATED OCTOBER 10, 1960 APPLY IN THE CONSTRUCTION OF THIS PROJECT.

CONNECTION CHARGES AS INDICATED
Charles O. Higginson

NO CONNECTIONS FOR THE DISPOSAL OF INDUSTRIAL WASTES SHALL BE MADE TO SEWERS SHOWN ON THESE DRAWINGS WITHOUT WRITTEN PERMISSION FROM THE CHIEF ENGINEER AND GENERAL MANAGER OF THE COUNTY SANITATION DISTRICTS.

CAPITAL PROJECT No 9991
PRIVATE CONTRACT No 5920

PROFILE, ALIGNMENT AND GRADE OF
SANITARY SEWERS

TO BE CONSTRUCTED IN
PONDERA STREET
FOR
EL DORADO PARK

31306

PAGE 1 OF 3 PAGES

SCALE VERT. 1" = 4' HORIZ. 1" = 40'

JULY 1961

COUNTY OF LOS ANGELES, CALIFORNIA

JOHN A. LAMBIE

COUNTY ENGINEER

RECOMMENDED *C. E. Brandy*
ASSISTANT SANITATION ENGINEER

APPROVED *C. R. Compton*
SANITATION ENGINEER

SUBMITTED *Walter S. Hines*
DESIGN ENGINEER

C. R. COMPTON
CHIEF ENGINEER OF COUNTY SANITATION DISTRICT NO. 14
W. S. Hines
OFFICE ENGINEER


FOR LEGEND
SEE PLAN NO. S-A-64

NOTE: GRADES TO WHICH THIS IMPROVEMENT IS TO BE CONSTRUCTED ARE SHOWN ON PLANS AND PROFILES. GRADE POINTS FOR TOP OF CURB, CENTER LINE OF STREET OR CENTER LINE OF ALLEY ARE SHOWN BY CIRCLES ON PROFILES. AT ALL POINTS BETWEEN DESIGNATED POINTS THE GRADE SHALL BE ESTABLISHED SO AS TO CONFORM TO A STRAIGHT LINE DRAWN BETWEEN SAID DESIGNATED POINTS. ELEVATIONS ARE IN FEET ABOVE U. S. C. & G. S. SEA LEVEL DATUM AS OF 1929. UNIT PRICES FOR ADDITIONAL WORK WHICH MAY BE REQUIRED BUT WHICH CANNOT BE ASCERTAINED IN ADVANCE, SHALL BE SUBMITTED IN THE PROPOSAL. THIS DRAWING AND THE DATA HEREON ARE HEREBY MADE A PART OF THE SPECIFICATIONS.

REFERENCES				REVISED	
W. S.	70	DESIGNED	L. J. JAIME	July 1961	RWF 10/61
A. B.	3142-37	TRACED	L. J. JAIME	July 1961	RWF 10/61
F. B.	2361-99-107	CHECKED	HIGGINSON	July 1961	R.S. 10-61

23069 E 70 S 31 23069

23069 E 70 S 31 23069

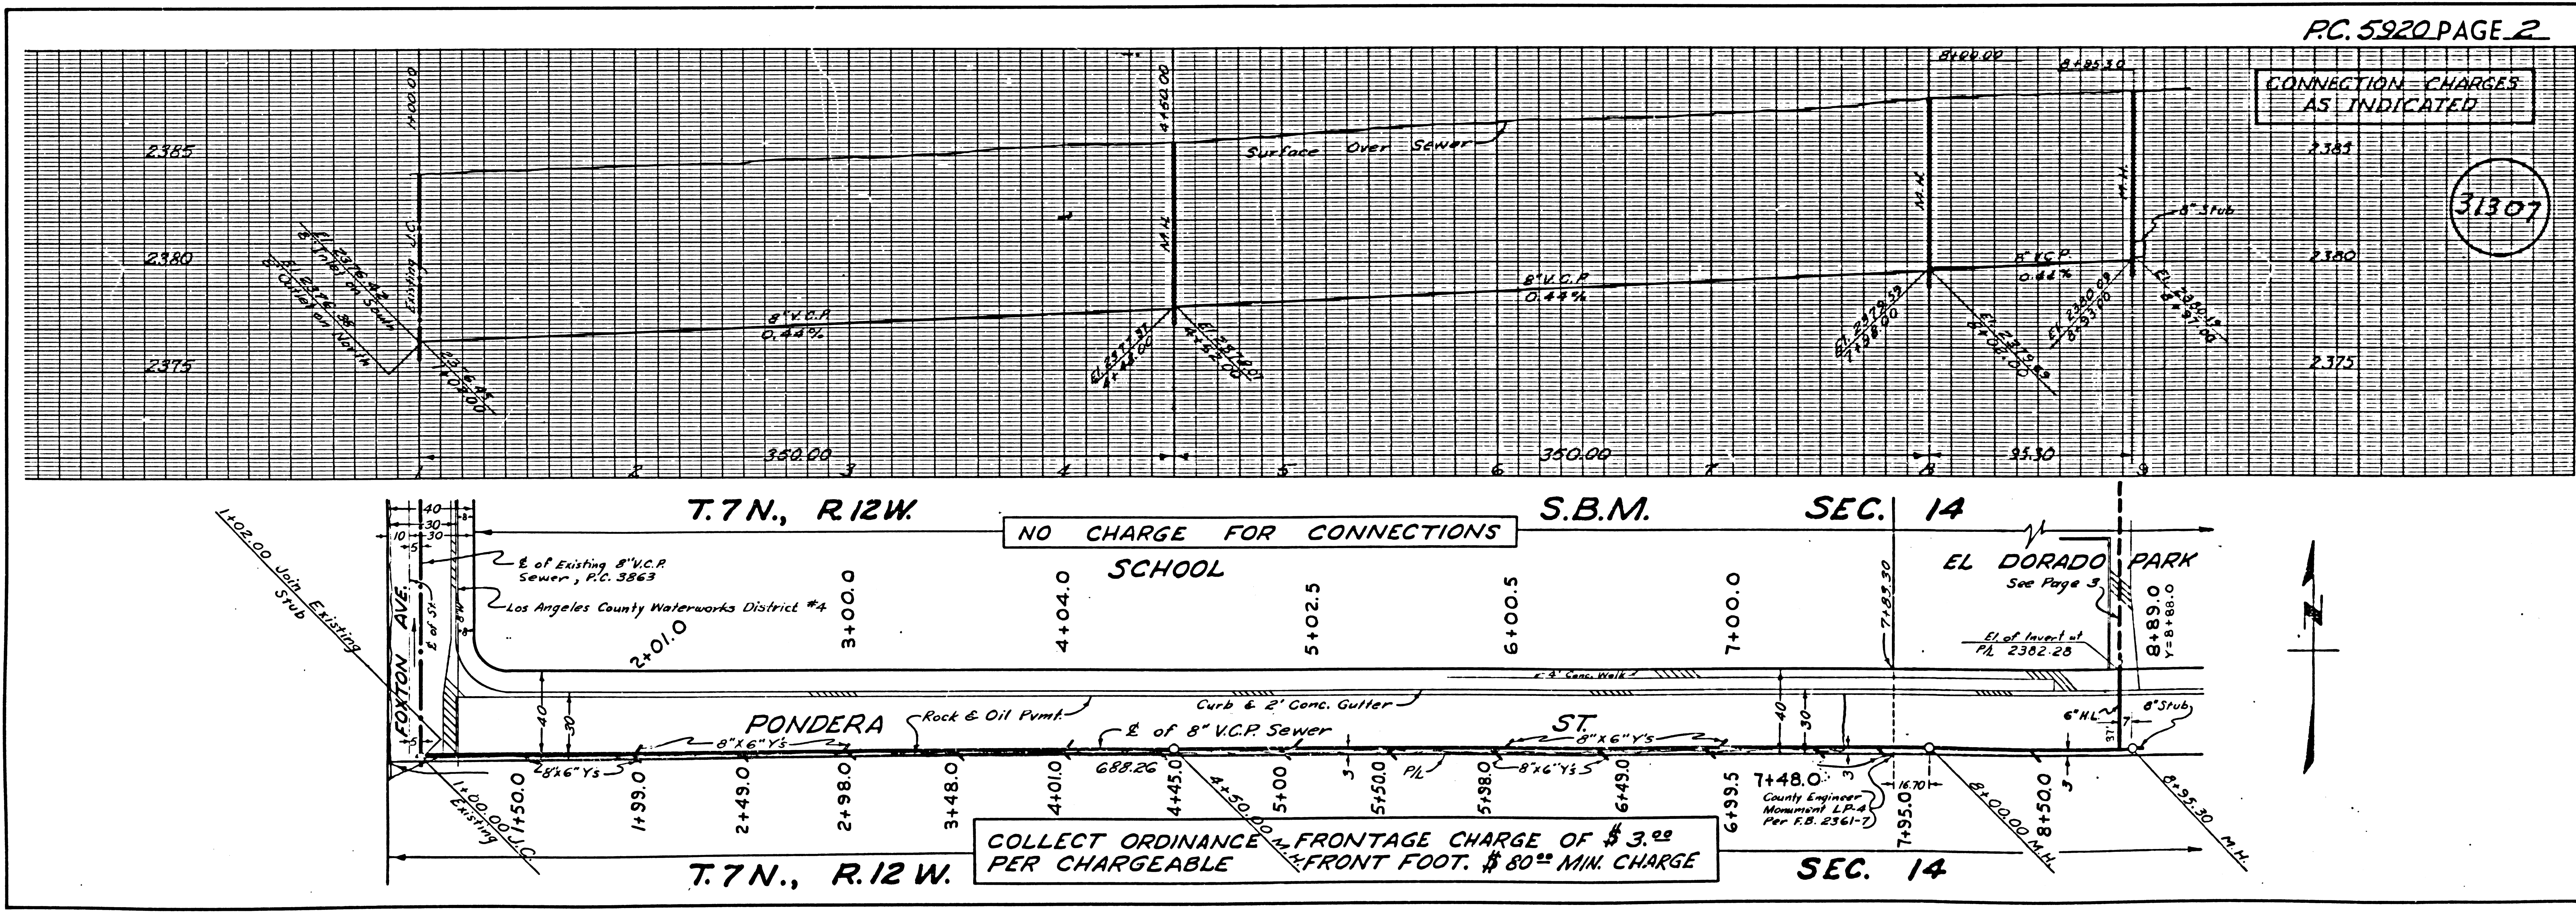

P.C. 5920 PAGE 2

CONNECTION CHARGES AS INDICATED

31307

NO CHARGE FOR CONNECTIONS

COLLECT ORDINANCE FRONTAGE CHARGE OF \$3.00 PER CHARGEABLE FRONT FOOT. \$80.00 MIN. CHARGE

O.C. 5/2
2/20 5/19/61







PC. 5920 PAGE 3

CONNECTION CHARGES AS INDICATED

31308

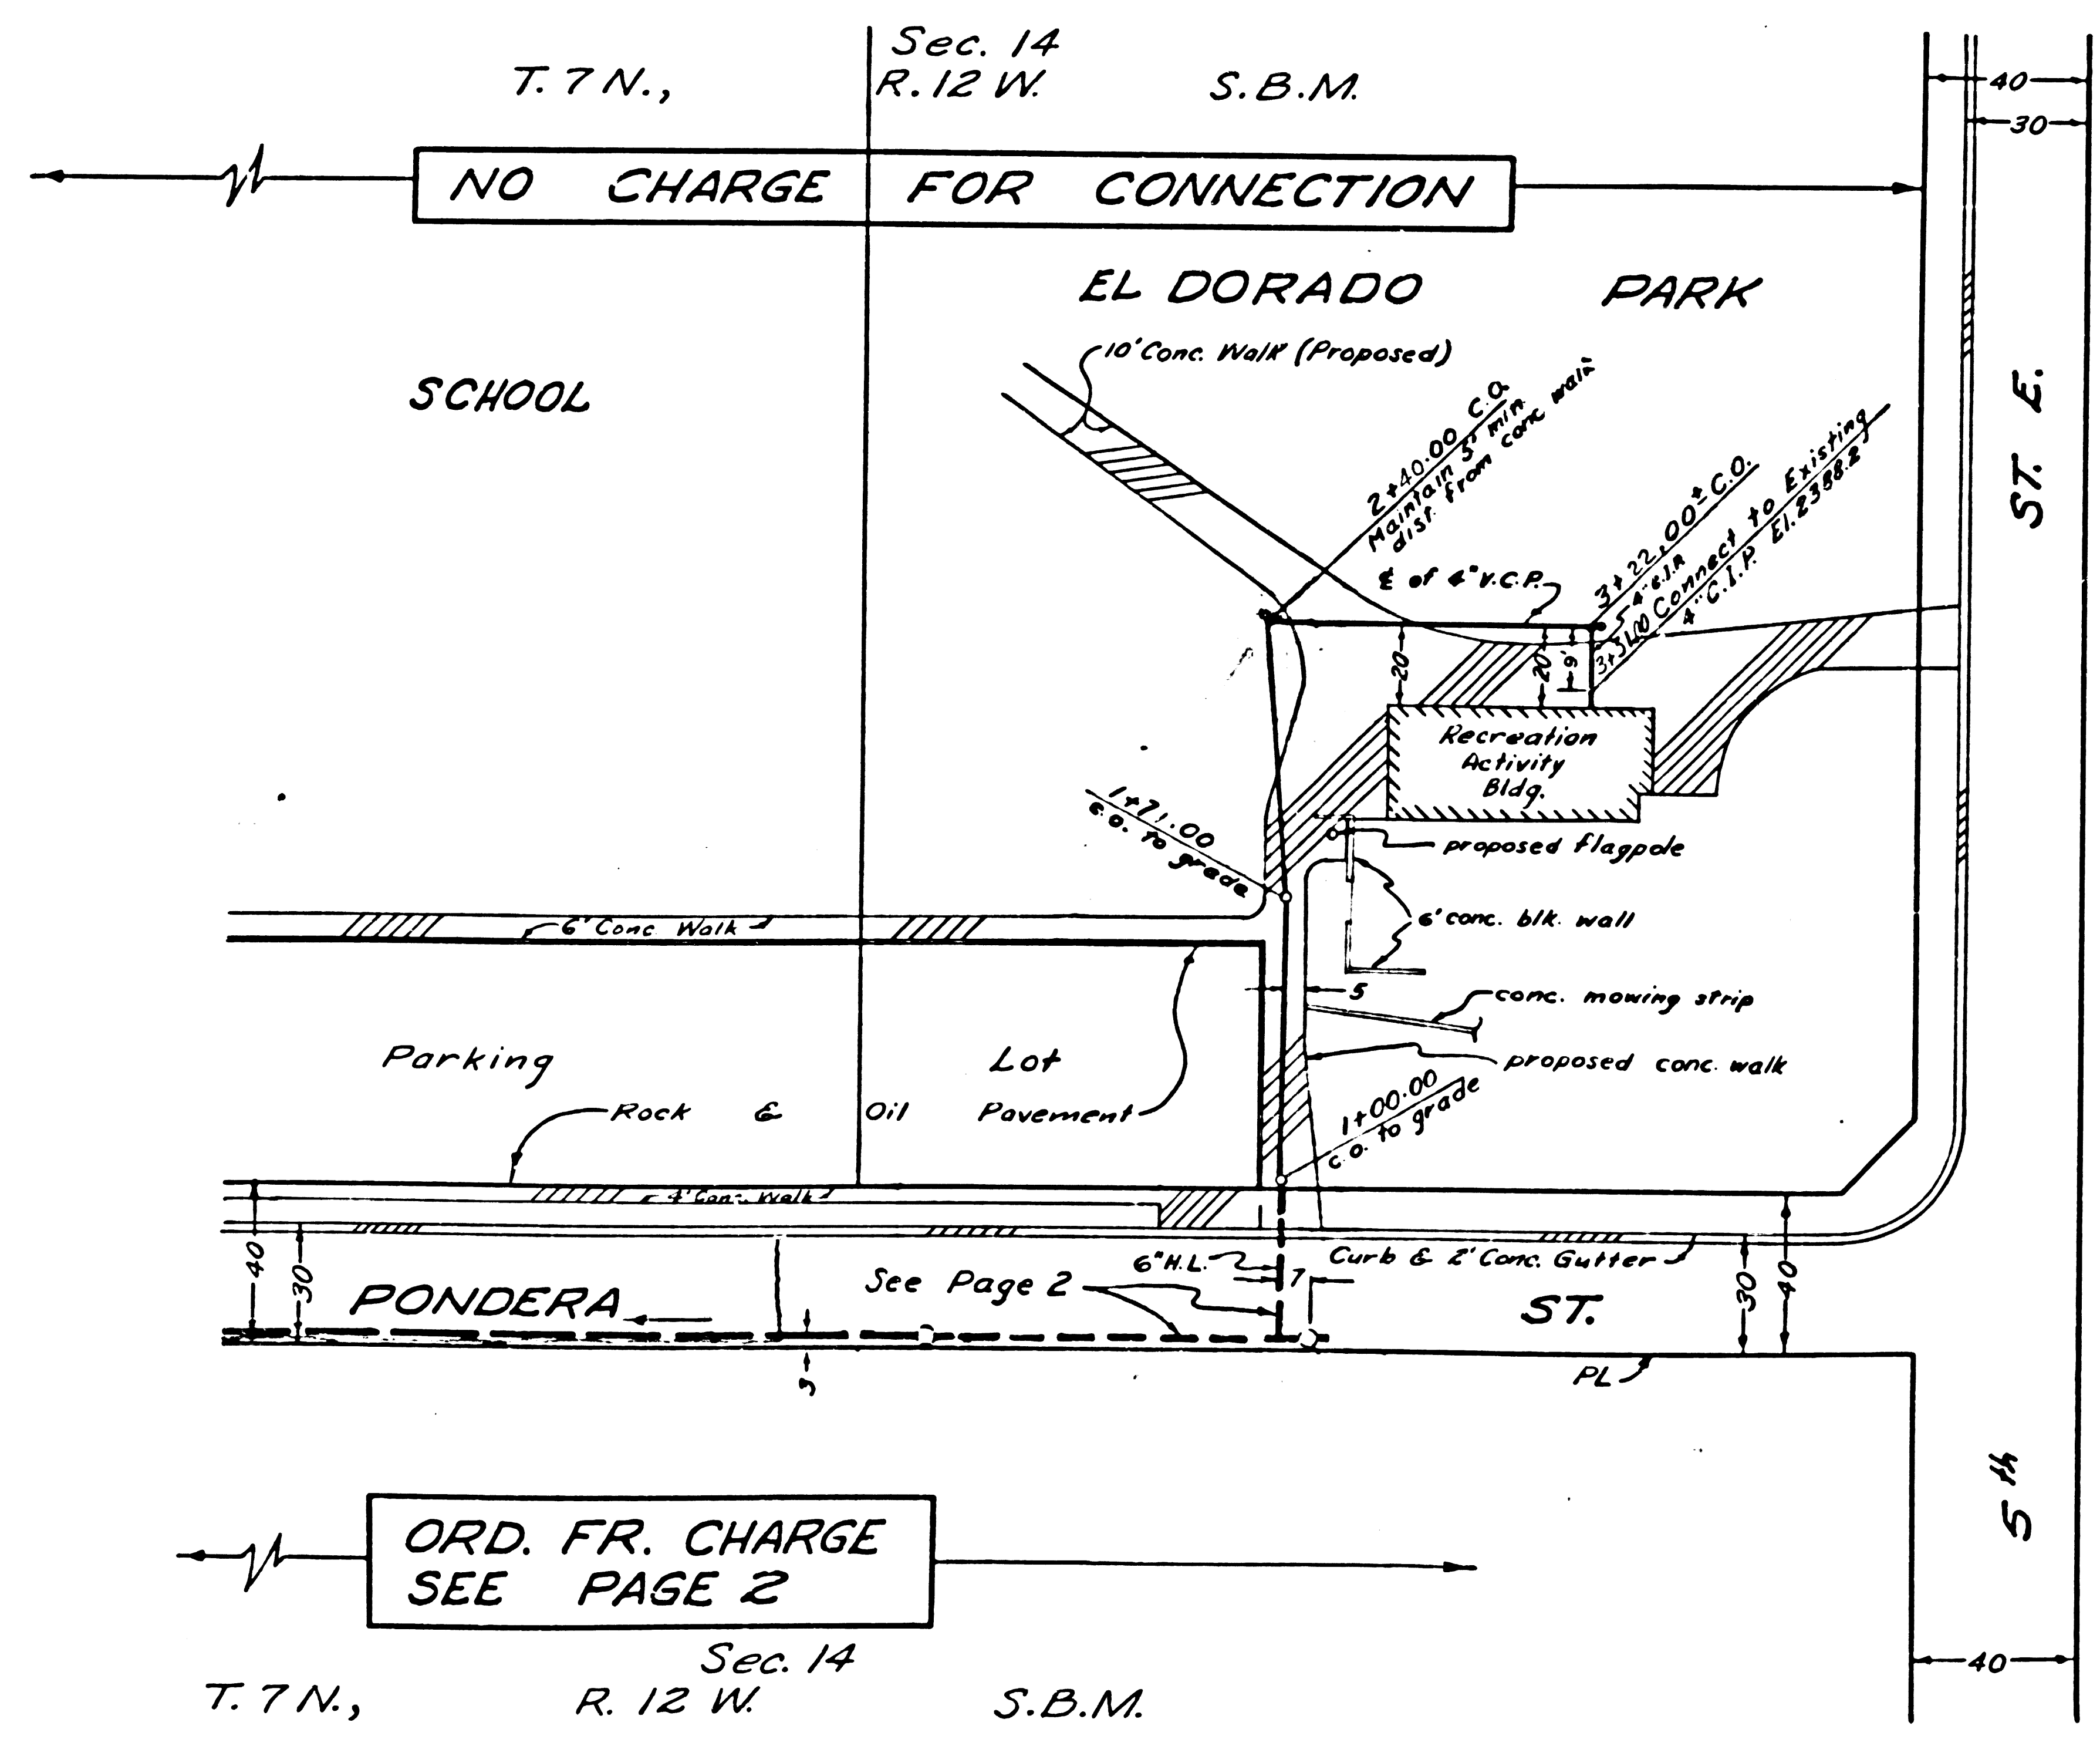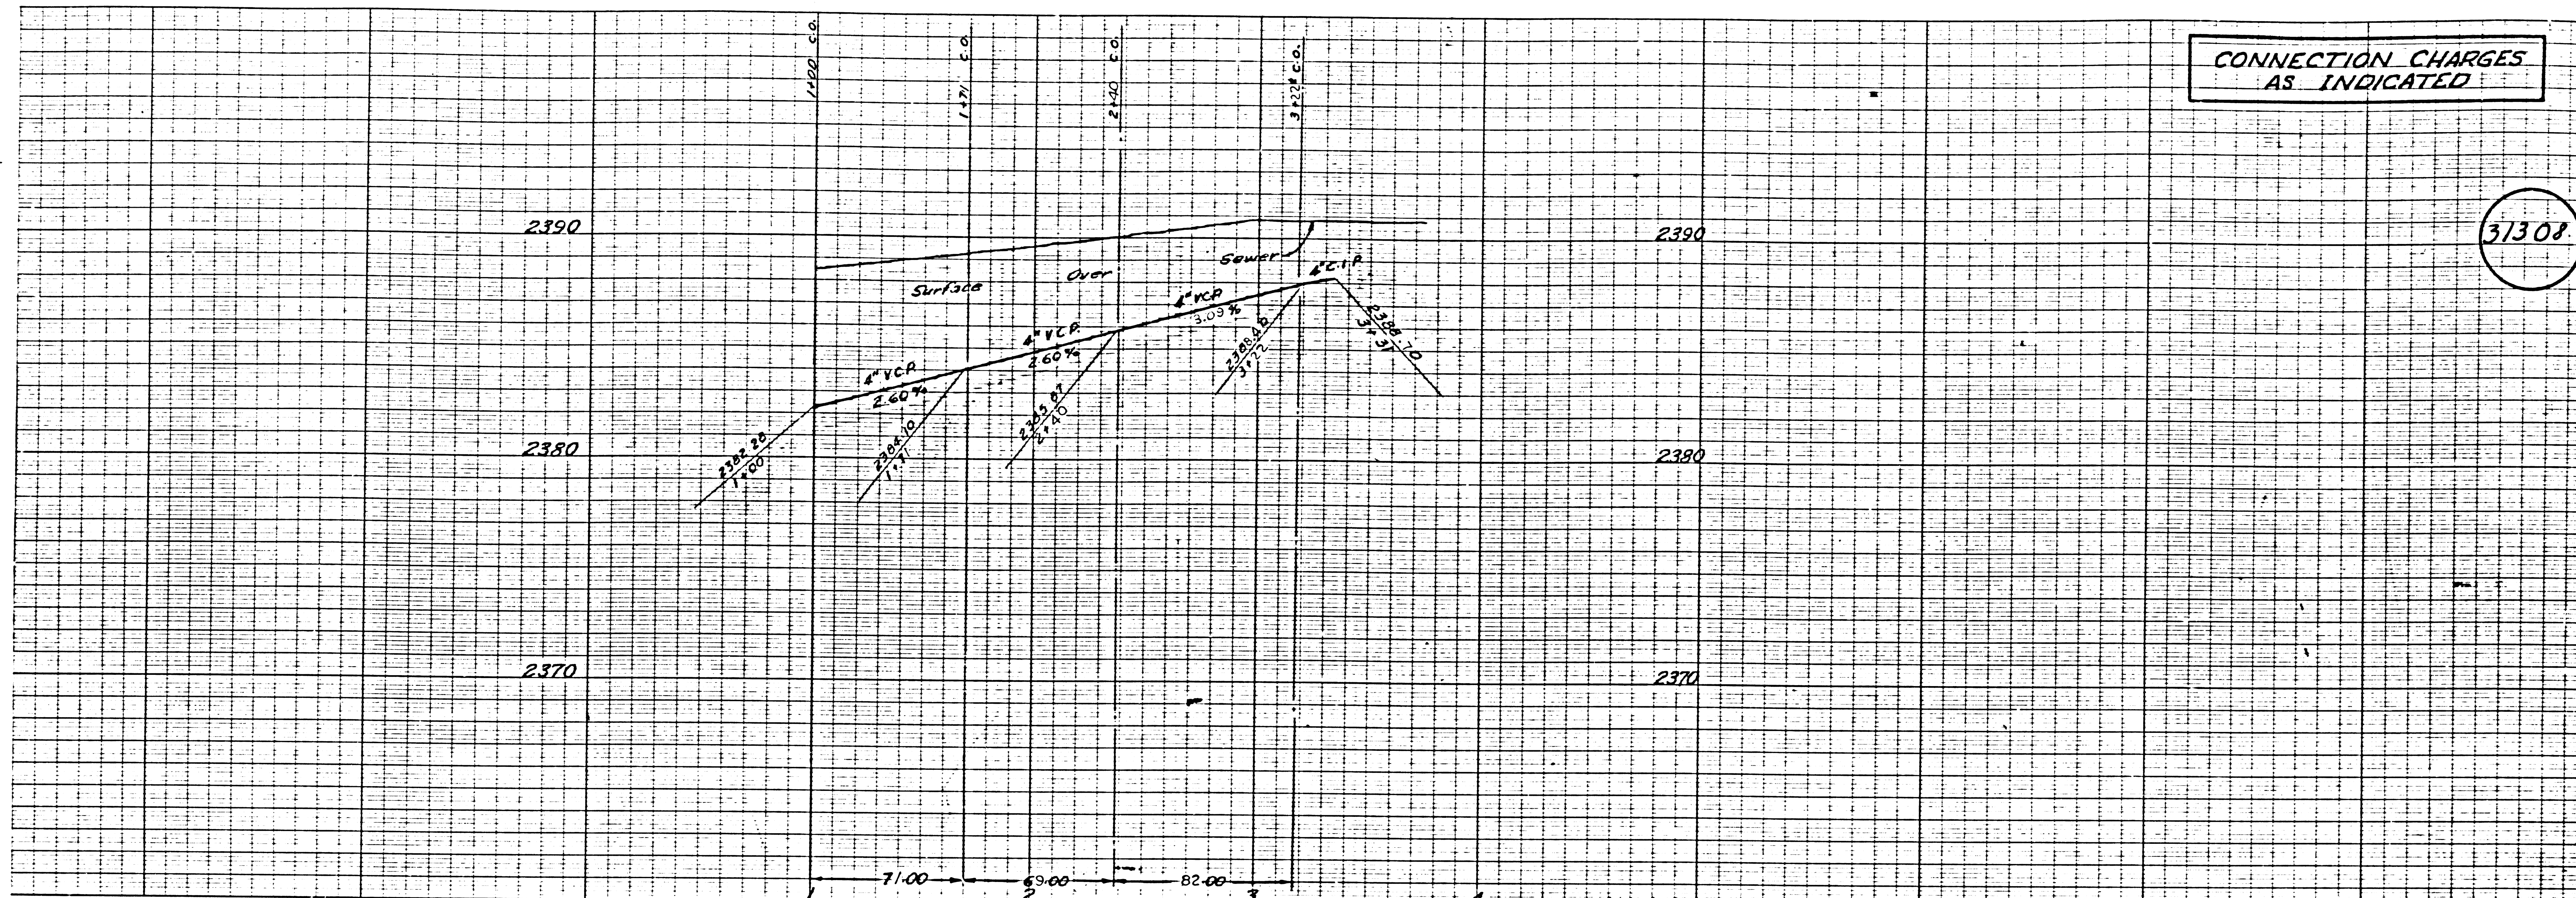

NOTE: C.O. (Clean out) To Be 4"x4" Y, With Y Branch In Vertical Plane.
Cleanouts to grade shall be extended to the surface with a Zurn-Z-1326-10, or equal, set flush with finished grade.



PAGE 3 OF 3 PAGES

EL DORADO PARK

PC. 2250

Trim Line