SANITARY SEWERS
PRIVATE CONTRACT NO. 6544
(PRIVATE SEWER)
KAISER HOSPITAL
WS 32

PREPARED IN THE OFFICES OF
KAISER ENGINEERS
BY _____ REG. C.E. NO. _____

JN 3174.26

ELEVATIONS ARE IN FEET ABOVE U.S.C. & G.S. SEA LEVEL DATUM OF 1929. THIS DRAWING AND THE DATA HEREON ARE HEREBY MADE A PART OF THE SPECIFICATIONS. WORK SHALL BE CONSTRUCTED ACCORDING TO STANDARD SPECIFICATIONS DATED MAY 25, 1948, ON FILE IN THE OFFICE OF THE CITY ENGINEER AND SHALL BE PROSECUTED ONLY IN THE PRESENCE OF THE CITY ENGINEER. BEFORE WORK CAN BE STARTED, THE CONTRACTOR MUST OBTAIN A PERMIT TO EXCAVATE IN CITY STREETS FROM THE CITY OF BELLFLOWER ROAD DEPARTMENT, AND MAKE A DEPOSIT WITH THE CITY OF BELLFLOWER, 9318 BELMONT ST., SUFFICIENT TO COVER THE COST OF CONSTRUCTION INSPECTION AND RECORD PLANS.

APPROVAL OF THIS PLAN BY THE CITY OF BELLFLOWER DOES NOT CONSTITUTE A REPRESENTATION AS TO THE ACCURACY OF THE LOCATION OF OR THE EXISTENCE OR NON-EXISTENCE OF ANY UNDERGROUND UTILITY PIPE, OR STRUCTURE WITHIN THE LIMITS OF THIS PROJECT. THIS APPLIES TO ALL PAGES.

BELLFLOWER BUILDING DIST. NO. 4.07

NOTES:
1. PROVIDE STAKES ON THE PROPERTY LINE OR PROPERTY LINES PRODUCED AT RIGHT ANGLES TO THE SEWER LINE AT THE CENTER LINE OF EACH MANHOLE.
2. NO REPRESENTATIVE OF THE CITY ENGINEER WILL SURVEY OR LAY OUT ANY PORTION OF THE WORK.
3. NO REVISIONS SHALL BE MADE IN THESE PLANS WITHOUT THE APPROVAL OF THE CITY ENGINEER.
4. THE CONTRACTOR SHALL NOTIFY THE CONSTRUCTION DIVISION BY TELEPHONE, NO 9-6747, EXT 81 OR 51 AT LEAST TWENTY-FOUR HOURS BEFORE STARTING ANY WORK UNDER THIS CONTRACT.
5. ~~MANHOLES SHALL BE BRICK SEWER STRUCTURES PER S-D-106, EXCEPT AS NOTED.~~
6. USE STANDARD MANHOLE FRAMES AND COVERS, S-D-117, EXCEPT AS NOTED.
7. USE EXTRA STRENGTH PIPE, ALL PIPE IS EXTRA DEPTH.
8. USE MECHANICAL COMPRESSION JOINTS FOR ALL V.C.P. JOINTS PER SPEC'S, SEC. 36 AND 98.
9. RESURFACE ALL TRENCHES WITHIN PAVED AREAS TO MEET CITY OF BELLFLOWER ROAD DEPARTMENT REQUIREMENTS IN ACCORDANCE WITH PERMITS.
10. FOR ALLOWABLE LEAKAGE TEST USE FORMULA NO. 2, SPEC'S, SEC 54.
11. ALL STATE AND LOCAL TRENCH SAFETY ORDERS WILL BE RIGIDLY ENFORCED.
12. MANHOLES SHALL BE BRICK SEWER STRUCTURES PER S-D-106 OR PRECAST CONCRETE MANHOLES PER S-D-135 OR S-D-173 EXCEPT AS NOTED.

BEFORE BREAKING INTO ANY EXISTING STRUCTURE AND BEFORE FINAL ACCEPTANCE OF THIS WORK, COUNTY SANITATION DISTRICT (DU 4-1281) SHALL BE NOTIFIED IN ORDER THAT REQUIRED INSPECTION CAN BE MADE.

THIS PROJECT TO BE OPERATED AND MAINTAINED BY KAISER HOSPITAL

36466

CITY OF BELLFLOWER, CALIFORNIA

JOHN A LAMBIE, CITY ENGINEER — J. D. PARKHURST, CHIEF ENGINEER CO. SAN. DIST. NO. 3

APPROVED BY, _____ ASSIST. SANITATION ENGR. — APPROVED BY, _____ OFFICE ENGINEER

SUBMITTED BY, _____ 6-21-63 LOS CERRITOS REGIONAL ENGINEER, REG. C.E. NO. 3871

CHECKED BY, _____ 6-27-63 REG. C.E. NO. 9406

APPROVED BY _____ INDUSTRIAL WASTE DIVISION

NO CONNECTIONS FOR THE DISPOSAL OF INDUSTRIAL WASTES SHALL BE MADE TO SEWERS SHOWN ON THESE DRAWINGS WITHOUT WRITTEN PERMISSION FROM THE CHIEF ENGINEER AND GENERAL MANAGER OF THE COUNTY SANITATION DISTRICTS.

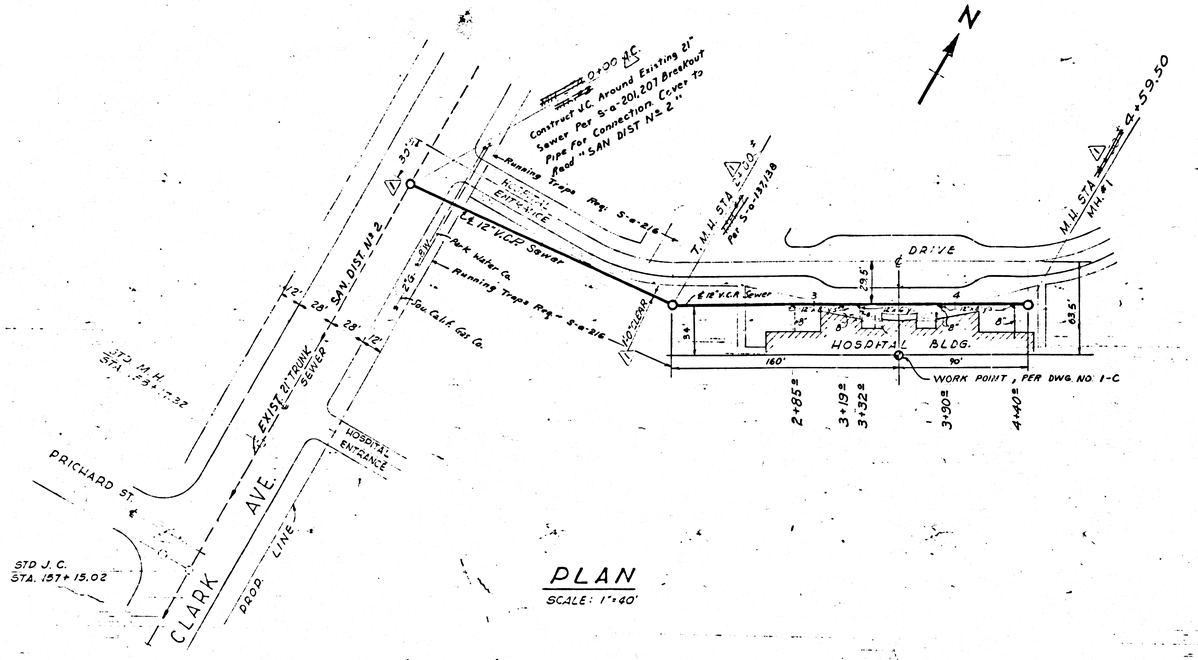

PLAN
SCALE: 1"=40'

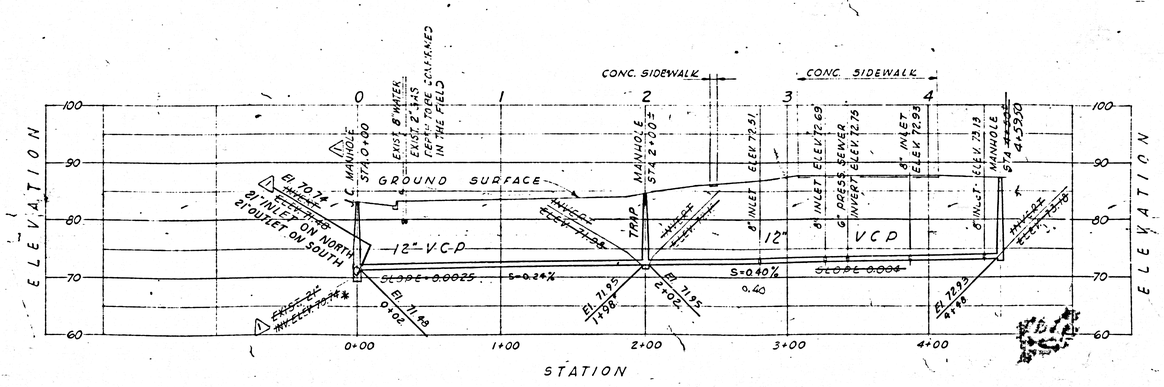

PROFILE
SCALES: HOR: 1"=40'
VERT: 1"=10'

NO	DATE	REVISION	BY	APP.	APP.
5	2-26-63	ADDED ASTERISK AND NOTE 3. ADDED MH #3, REVISED SAN. SEWER ALIGNMENT DOWNSTREAM FROM MH #2	40		

REFERENCE DRAWINGS: CO. SANITATION DIST. NO 2 DOWNEY-BELLFLOWER TRUNK SEWER SHT. 5 OF 19 & SHT. 6 OF 19

NUMBER: 2-P-30

NOTES:
1. FOR NOTES & LEGEND SEE DWG. 1-C.
2. DETAILS OF CONSTRUCTION ARE SHOWN ON DWG 3-C.
3. * - INV. ELEV. TO BE VERIFIED IN THE FIELD. ⚠

DESCRIPTION — COST ACCOUNT

CONSTRUCTION APPROVAL

APPROVAL — DATE

PROJECT ENGINEER

CHIEF ENGINEER

THIS DRAWING IS THE PROPERTY OF KAISER ENGINEERS, DIVISION OF HENRY J. KAISER COMPANY AND IS NOT TO BE COPIED OR USED WITHOUT ITS WRITTEN PERMISSION

DIVISION OF HENRY J. KAISER COMPANY — KAISER ENGINEERS — OAKLAND, CALIFORNIA

SCALE AS NOTED — DATE 1

DRAWN BY J.V.S.NYDER

CHECKED BY

APPROVED BY — DATE 2-26-63

CHIEF DESIGN ENGINEER

FOR KAISER FOUNDATION HOSPITAL

LOCATION BELLFLOWER, CALIFORNIA

SANITARY SEWER MAIN PLAN & PROFILE

JOB No. 6237 — DWG. No. SK 4-C — REVISED R-1