BENCH MARKS

B.M. CL 3690 — ELEV. 1262.866

R.D.B.M. TAG IN CONC. BASE OF EDISON P.P. # 1927400 E 60 FT. S. & 67 FT. E. ℄ INT. LYONS AVE. & WILEY CANYON ROAD.

NEWHALL — QUAD. 1983

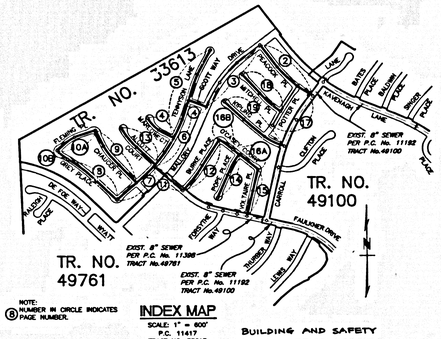

NOTE: (8) NUMBER IN CIRCLE INDICATES PAGE NUMBER.

INDEX MAP

SCALE: 1" = 600'
P.C. 11417
TRACT NO. 33613
INDEX MAP 1258
T.G. 4550-A6

BUILDING AND SAFETY
LOCAL OFFICE
SANTA CLARITA

NO.	REVISION	REVISED BY	APPROVED BY	DATE

STORMWATER POLLUTION CONTROL REQUIREMENTS FOR SEWER CONSTRUCTION

1. Eroded sediments and other pollutants must be retained on site and may not be transported from the site via sheet flow, swales, area drains, natural drainage courses, or wind.
2. Stockpiles of earth and other construction related materials must be protected from being transported from the site by the forces of wind or water.
3. Fuels, oils, solvents, and other toxic materials must be stored in accordance with their listing and are not to contaminate the soil and surface waters. All approved storage containers are to be protected from the weather. Spills must be cleaned up immediately and disposed of in a proper manner. Spills may not be washed into the drainage system.
4. Excess or waste concrete may not be washed into the public way or any other drainage system. Provisions shall be made to retain concrete wastes on site until they can be disposed of as solid waste.
5. Trash and construction-related solid wastes must be deposited into a covered receptacle to prevent contamination of rainwater and dispersal by wind.
6. Sediments and other materials may not be tracked from the site by vehicle traffic. The construction entrance roadways must be stabilized so as to inhibit sediments from being deposited into the public way. Accidental depositions must be swept up immediately and may not be washed down by rain or other means.
7. Any slopes with disturbed soils or denuded of vegetation must be stabilized so as to inhibit erosion by wind and water

CA001 – DEWATERING OPERATIONS
CA002 – PAVING OPERATIONS
CA003 – STRUCTURE CONSTRUCTION AND PAINTING
CA010 – MATERIAL DELIVERY AND STORAGE
CA020 – SOLID WASTE MANAGEMENT
CA021 – HAZARDOUS WASTE MANAGEMENT
CA023 – CONCRETE WASTE MANAGEMENT
CA024 – SANITARY/SEPTIC WASTE MANAGEMENT
CA030 – VEHICLE AND EQUIPMENT CLEANING
CA031 – VEHICLE AND EQUIPMENT FUELING
CA032 – VEHICLE AND EQUIPMENT MAINTENANCE
ESC01 – SCHEDULING
ESC02 – PRESERVATION OF EXISTING VEGETATION
ESC10 – SEEDING AND PLANTING
ESC11 – MULCHING
ESC20 – GEOTEXTILES AND MATS
ESC21 – DUST CONTROLS
ESC22 – TEMPORARY STREAM CROSSING
ESC23 – CONSTRUCTION ROAD STABILIZATION
ESC24 – STABILIZED CONSTRUCTION ENTRANCE
ESC54 – STORM DRAIN INLET PROTECTION

STANDARD PLANS:

THE FOLLOWING LATEST REVISED STANDARD PLANS ON FILE IN THE OFFICE OF THE FOLLOWING DEPARTMENT SHALL APPLY IN THE CONSTRUCTION OF THIS PROJECT:

LOS ANGELES COUNTY DEPARTMENT OF PUBLIC WORKS

APWA 208–0 BREAKING INTO EXISTING MANHOLES
APWA 222–0 HOUSE CONNECTION SEWER
APWA 223–0 HOUSE CONNECTION REMODELING
2000–0 LEGEND FOR SANITARY SEWER PLANS AND PROFILES AND DISTRICT MAPS.
2021–0 BEDDING FOR SEWER PIPE
2024–0 WYE OR TEE SUPPORT
2027–0 ALLOWABLE TRENCH WIDTHS

THIS SEWER PRIVATE CONTRACT ACCEPTED FOR PUBLIC USE
12-16-2004
COUNTY OF LOS ANGELES DEPARTMENT OF PUBLIC WORKS LAND DEVELOPMENT DIVISION

LOTS 299 THROUGH 314 ARE RESTRICTED TO NO CONSTRUCTION OF RESIDENTIAL BUILDING AND WILL NOT BE SERVED BY THIS SEWER.

ISSUE NO HOUSE LATERAL CONNECTION PERMITS UNTIL OUTLET SEWER P.C. 11192 AND P.C. 11398 ARE ACCEPTED FOR PUBLIC USE BY THE COUNTY OF LOS ANGELES.

NO CONNECTION FOR THE DISPOSAL OF INDUSTRIAL WASTES SHALL BE MADE TO SEWERS SHOWN ON THESE DRAWINGS UNTIL A PERMIT FOR INDUSTRIAL WASTEWATER DISCHARGE HAS BEEN ISSUED BY THE SANITATION DISTRICTS FOR SAID CONNECTION

BEFORE BREAKING INTO OR CONSTRUCTION ON A COUNTY SANITATION DISTRICT SEWER AND PRIOR TO FINAL ACCEPTANCE OF THE PROJECT, A SANITATION DISTRICT INSPECTOR SHALL BE NOTIFIED BY PHONE AT (626) 256-4563 SO THAT REQUIRED INSPECTIONS CAN BE MADE.

PRIVATE CONTRACT SEWER GENERAL NOTES

The following general notes are to be included on Page 1 of all Private Contract Sewer Plans:

1. A sewer construction permit shall be obtained and a fee paid for construction inspection and record plans to the Department of Public Works at the Permit Counter, 900 South Fremont Avenue, 8th Floor, Alhambra, at least 72 hours prior to starting work under this permit. Copies of all other required permits, such as Road Excavation, Caltrans, etc., must be filed with the permit application.
2. Prior to issuance of any permit, the contractor shall file a permit for excavations and trenches from the State of California Division of Industrial Safety, and a Certificate of Worker's Compensation Insurance with the Department of Public Works named as the Certificate Holder to be notified 30 days prior to cancellation of policy.
3. If work is done in a State Highway, a permit must be obtained from the State of California Division of Highways, 120 South Spring Street, Los Angeles, California.
4. When work is within a contract city, the contractor must contact the Director of Public Works of that city, to determine the location to pay the inspection fee.
5. The contractor shall contact the district office listed on the "Application for Construction Permit" to arrange for an acceptable construction start date.
6. Approval of this plan by the County of Los Angeles does not constitute a representation as to accuracy of the location of or the existence or non-existence of any underground utility pipe or structure within the limits of this project. This note applies to all pages.
7. All work shall be in accordance with the latest appro-ed edition of the "Standard Specifications for Public Works Construction, including supplements and the latest Special Provisions for the Construction of Sanitary Sewers and shall be prosecuted only in the presence of the Departme..t of Public Works
8. The contractor's attention is directed to Section 7-10.4.1 of the Standard Specifications for Public Works Construction in regard to safety orders and shall conform to the "Minimum Public Safety Requirements" as shown on Los Angeles Department of Public Works' Standard S-2.
9. Elevations are in feet above U.S.C. & G.S. sea level datum of 1929.
10. No revisions shall be made in these plans without the approval of the Director of Public Works.
11. No representative of the Department of Public Works will survey or lay out any portion of the work.
12. Grades to which this improvement is to be constructed are shown on plans and profiles. Grade points for top of curbs, centerline of streets, centerline of alleys, are shown by circles on profiles at all points between designated points. The grade shall be established so as to conform to a straight line drawn between said designated points.
13. The private engineer shall furnish the Department of Public Works with grade sheets and stationing for all house laterals and "Y" or "T" branches and shall provide stakes for them at their proper locations with stationing plainly marked. All house laterals shall be constructed in a straight alignment at right angles from the main line sewer except as shown on the plans. House laterals from chimneys shall not have an angle of less than 45 degrees with the M.L. sewer. Any change in alignment shall be requested in writing by the private engineer.
14. The private engineer shall furnish the house lateral depth at the property line below the top of curb elevation for each house lateral on the grade sheet.
15. The engineer shall revise this plan to show the as-built location of house laterals before the sewer is accepted for public use and the sewer security can be released.

CONSTRUCTION NOTES

1. Provide survey stakes on the property line or property lines produced at right angles to the sewer line at the centerline of each manhole
2. Vitrified clay pipe joints shall be type "D" or "O" per standard specifications section 208-2.
3. If a powerpole is within three feet of the sewer, the sewer shall be encased per standard plan S-23, case II, two feet on each side from the point of interference.
4. All joints between cast iron pipe and vitrified coly shall be made with a rubber sleeve joint, type "D" (with bushing if necessary) per standard specifications section 208-2.
5. House laterals to be constructed with inverts at the property line 6 feet below curb grade except as noted.
6. Wye or tee branches may be used for connections to the mainline sewers except as noted.
7. If during the course of construction, it is determined that there is less than four feet of cover over the top of a mainline or house lateral V.C.P. sewer which is not indicated on the plans, the pipes shall be encased per standard plan S-23, case II, unless otherwise required by the director of Public Works.
8. All structures shall be either brick sewer manholes per standard plan S-3 or precast concrete sewer manholes per standard plan S-36, or reinforced precast concrete manhole plan per standard plan S-6, except as noted.
9. resurface all trenches within paved areas to meet Los Angeles County Public Works or California State Highway requirements in accordance with the permits.
10. Full compliance with section 306-1.3.4. of the standard specification will be required for backfill in street certification of backfill compaction and sand equivalents by a qualified civil engineer shall be provided by the permitee prior to the issuance of a certificate of partial acceptance.
11. All backfill and fills outside of the street right of way shall be compacted to 90% of the maximum density as determined by ASTM soil compaction test D 1557-78 method "D" unless otherwise specified. This shall be certified by a qualified civil engineer. This certification shall be submitted to the Construction Division of the Department of Public Works prior to the acceptance of the work by the county.
12. Manhole tops in unimproved rights of way to be six inches above finished grade.
13. Sewers to be tested for leakage per section 306-1/4 of the standard specifications and special provisions.

RECORD PLANS

PROFILE, ALIGNMENT AND GRADE OF SANITARY SEWERS

TO BE CONSTRUCTED IN

TRACT NO. 33613 PC NO. 11417

10 SHEETS 19 PAGES

COUNTY OF LOS ANGELES CALIFORNIA

INDEX 1258

54956

HARRY W STONE — DIRECTOR OF PUBLIC WORKS

APPROVED BY BUILDING & SAFETY/LAND DEVELOPMENT DIVISION
BY Donald S. Ondreyco — ASSISTANT DIVISION ENGINEER — DATE 7-26-99

SUBMITTED BY P. Lauer — SUBDIVISION PLAN CHECKING SECTION — DATE 7/26/99

APPROVED: COUNTY SANITATION DISTRICT OF LOS ANGELES CALIF.
CHARLES W. CARRY – CHIEF ENGINEER and GENERAL MANAGER

COUNTY SANITATION DISTRICT NO. 32

BY _____ OFFICE ENGINEER — DATE: 7-26-99

PRIVATE ENGINEERS NOTICE TO CONTRACTORS

THE EXISTENCE AND LOCATION OF ANY UNDERGROUND UTILITY PIPES OR STRUCTURES SHOWN ON THESE PLANS IS REQUIRED BY A SEARCH OF AVAILABLE RECORDS TO THE BEST OF OUR KNOWLEDGE. THERE MAY BE EXISTING UTILITIES EXCEPT AS SHOWN ON THIS MAP. THE CONTRACTOR IS REQUIRED TO TAKE PRECAUTIONARY MEASURES TO PROTECT THE UTILITY LINES SHOWN AND ANY OTHER LINES NOT OF RECORD OR NOT SHOWN ON THIS DRAWING. PRIOR TO EXCAVATION THE CONTRACTOR SHALL CALL U.S.A. TOLL FREE 1-800-422-4133 TO VERIFY THE UNDERGROUND LOCATION OF GAS AND TELEPHONE LINES. THE CONTRACTOR SHALL ALSO CONTACT THE LOCAL OFFICE OF GENERAL TELEPHONE COMPANY AT 1-800-948 4871 SO THAT THEY CAN MARK THE LOCATION OF UNDERGROUND TELEPHONE LINES.

Warren L. Smith — RCE NO 61381 8 — 7-26-99 DATE

P.C. 11417 PAGE 2

NO L.A. CO. CHARGES FOR CONNECTION
SEE CO. SANITATION DISTRICT FOR SPECIAL CONNECTION CHARGES
TEL. (562) 699-7411 EX. 2727
DOUBLE SCALE

54957

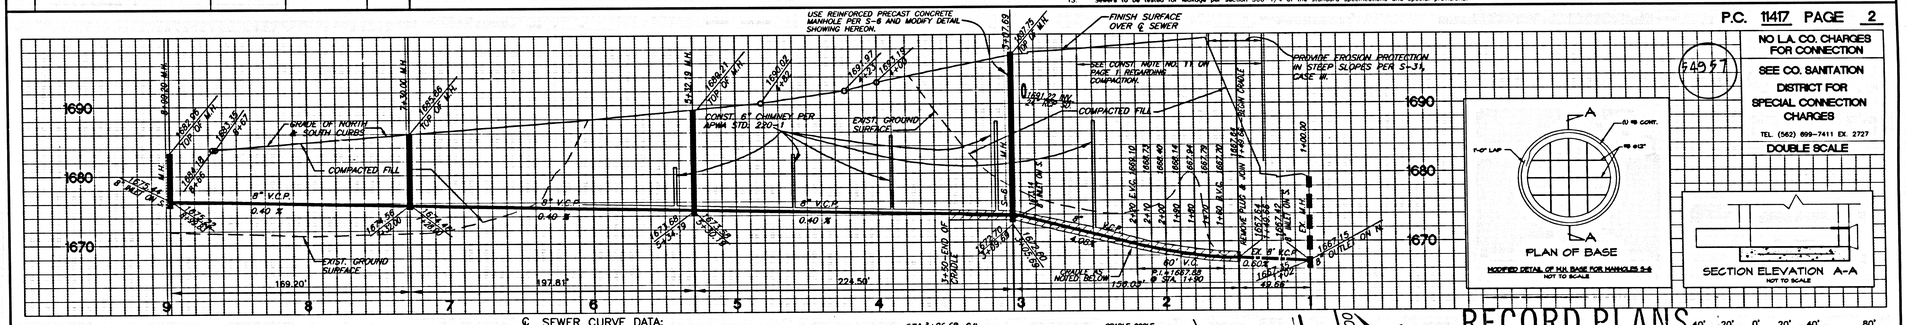

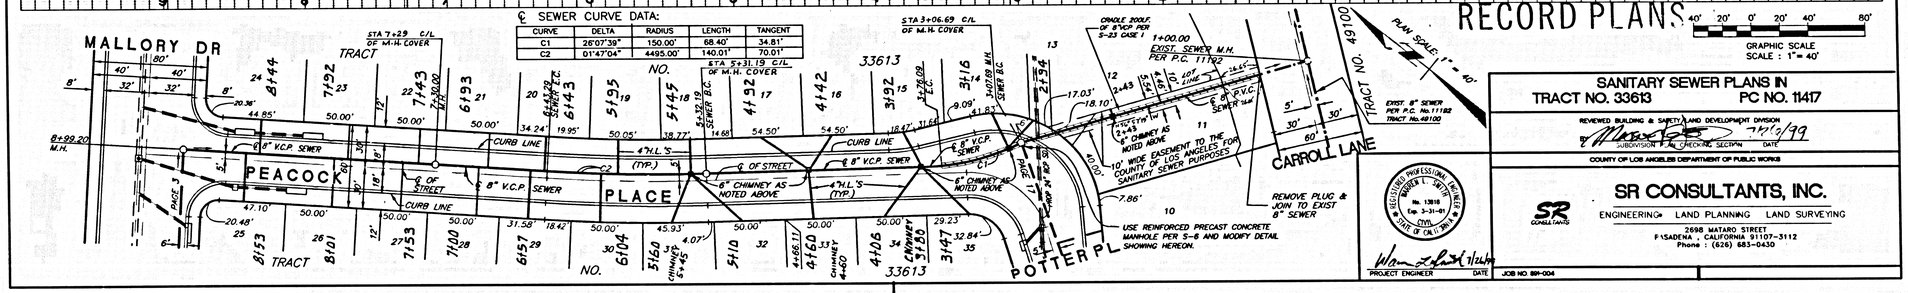

RECORD PLANS

SANITARY SEWER PLANS IN TRACT NO. 33613 PC NO. 11417

REVIEWED BUILDING & SAFETY/LAND DEVELOPMENT DIVISION
BY _____ SUBDIVISION PLAN CHECKING SECTION — DATE 7/26/99

COUNTY OF LOS ANGELES DEPARTMENT OF PUBLIC WORKS

REGISTERED PROFESSIONAL ENGINEER WARREN L. SMITH No. 13818 Exp. 3-31-01 CIVIL STATE OF CALIFORNIA

PROJECT ENGINEER — DATE 7/26/99

JOB NO. 891-004

SR CONSULTANTS

SR CONSULTANTS, INC.
ENGINEERING LAND PLANNING LAND SURVEYING
2698 MATARO STREET
PASADENA, CALIFORNIA 91107-3112
Phone : (626) 683-0430

TRACT NO. 33613

FILE I:\PROJECTS\891-007 tr 33613\SEWER\sewer-idl\PPSS1.dwg
REV. 7-20-99 9:25 AM

P.C. 11417 PAGE 3

RECORD PLANS

NO L.A. CO. CHARGES FOR CONNECTION

SEE CO. SANITATION DISTRICT FOR SPECIAL CONNECTION CHARGES
TEL. (562) 699-7411 EX. 2727

DOUBLE SCALE

54959

REGISTERED PROFESSIONAL ENGINEER WARREN L. SMITH No. 13818 Exp. 3-31-01 CIVIL STATE OF CALIFORNIA

REVIEWED BY BUILDING & SAFETY/LAND DEVELOPMENT DIVISION
BY SUBDIVISION PLAN CHECKING SECTION 7/26/99 DATE

P.C. 11417 PAGE 4

NO L.A. CO. CHARGES FOR CONNECTION

SEE CO. SANITATION DISTRICT FOR SPECIAL CONNECTION CHARGES
TEL. (562) 699-7411 EX. 2727

DOUBLE SCALE

54959

RECORD PLANS

℄ SEWER CURVE DATA:

CURVE	DELTA	RADIUS	LENGTH	TANGENT
C1	10°15'28"	420.00'	75.20'	37.70'
C2	24°24'19"	420.00'	178.90'	90.82'

* INDICATES BACKWATER VALVES MAY BE REQUIRED FOR THESE LOTS.

REGISTERED PROFESSIONAL ENGINEER WARREN L. SMITH No. 13818 Exp. 3-31-01 CIVIL STATE OF CALIFORNIA

REVIEWED BY BUILDING & SAFETY/LAND DEVELOPMENT DIVISION
BY SUBDIVISION PLAN CHECKING SECTION 7/26/99 DATE

FILE I:\PROJECTS\891-007 tr 33613\SEWER\sewer-ld\pons2dwg.dwg
REV. 7-20-99 8:58 AM

(2)

P.C. 11417

TRACT NO. 33613

P.C. 11417 PAGE 5

NO L.A. CO. CHARGES FOR CONNECTION

SEE CO. SANITATION DISTRICT FOR SPECIAL CONNECTION CHARGES
TEL. (562) 699-7411 EX. 2727

DOUBLE SCALE

54960

RECORD PLANS

TRACT NO. 33613

℄ SEWER CURVE DATA:

CURVE	DELTA	RADIUS	LENGTH	TANGENT
C1	07°09'52"	1295.00'	161.93'	81.07'
C2	04°14'01"	1295.00'	95.69'	47.87'

* INDICATES BACKWATER VALVES MAY BE REQUIRED FOR THESE LOTS.

PLAN SCALE: 1" = 40'

GRAPHIC SCALE
SCALE : 1" = 40'

REGISTERED PROFESSIONAL ENGINEER WARREN L. SMITH No. 13818 Exp. 3-31-01 CIVIL STATE OF CALIFORNIA

REVIEWED BY BUILDING & SAFETY LAND DEVELOPMENT DIVISION
BY SUBDIVISION PLAN CHECKING SECTION DATE 7/26/99

P.C. 11417 PAGE 6

NO L.A. CO. CHARGES FOR CONNECTION

SEE CO. SANITATION DISTRICT FOR SPECIAL CONNECTION CHARGES
TEL. (562) 699-7411 EX. 2727

DOUBLE SCALE

54961

RECORD PLANS

TRACT NO. 33613

* INDICATES BACKWATER VALVES MAY BE REQUIRED FOR THESE LOTS.

** CONST. SPECIAL H.L.'S PER S-25 CASE II AND ENCASE 10' OF 4" H.L. PER S-23 CASE II.

℄ SEWER CURVE DATA:

CURVE	DELTA	RADIUS	LENGTH	TANGENT
C1	02°32'50"	1705.00'	75.80'	37.91'
C2	08°33'45"	1705.00'	254.80'	127.64'
C3	06°13'25"	1705.00'	185.20'	92.69'
C4	05°53'39"	1705.00'	175.40'	87.78'
C5	00°49'29"	1705.00'	24.54'	12.27'

PLAN SCALE: 1" = 40'

GRAPHIC SCALE
SCALE : 1" = 40'

REGISTERED PROFESSIONAL ENGINEER WARREN L. SMITH No. 13818 Exp. 3-31-01 CIVIL STATE OF CALIFORNIA

REVIEWED BY BUILDING & SAFETY LAND DEVELOPMENT DIVISION
BY SUBDIVISION PLAN CHECKING SECTION DATE 7/26/99

FILE = \PROJECTS\891-007 tr 33613\SEWER\sewer-16\psrss3dwg.dwg
REV. 7-26-99 10:53 AM

P.C. 11417 TRACT NO. 33613

P.C. 11417 PAGE 7

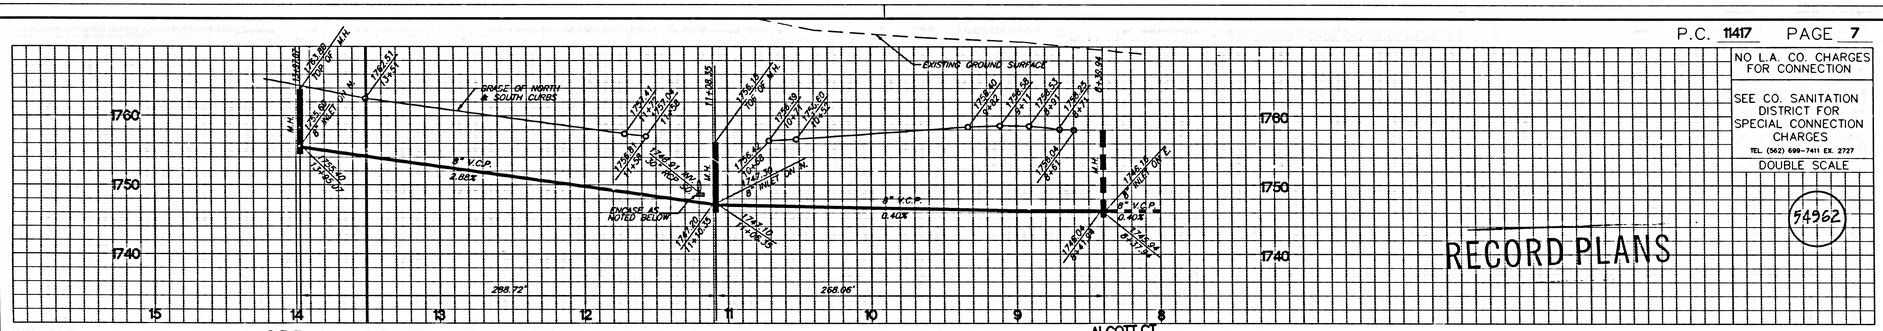

NO L.A. CO. CHARGES FOR CONNECTION

SEE CO. SANITATION DISTRICT FOR SPECIAL CONNECTION CHARGES
TEL. (562) 699-7411 EX. 2727

DOUBLE SCALE

54962

RECORD PLANS

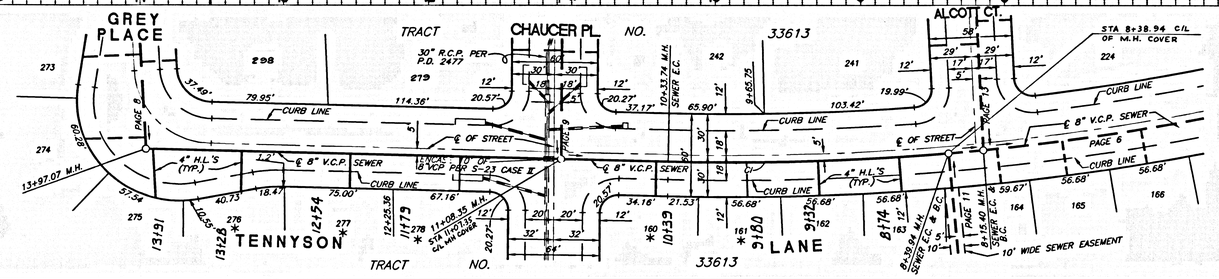

℄ SEWER CURVE DATA:

CURVE	DELTA	RADIUS	LENGTH	TANGENT
C1	04°29'39"	1705.00'	133.74'	66.90'

PLAN SCALE: 1" = 40'

* INDICATES BACKWATER VALVES MAY BE REQUIRED FOR THESE LOTS.

REGISTERED PROFESSIONAL ENGINEER WARREN L. SMITH No. 13818 Exp. 3-31-01 CIVIL STATE OF CALIFORNIA

40' 20' 0' 20' 40' 80'
GRAPHIC SCALE
SCALE : 1" = 40'

REVIEWED BY BUILDING & SAFETY/LAND DEVELOPMENT DIVISION
BY SUBDIVISION PLAN CHECKING SECTION
DATE 7/26/99

P.C. 11417 PAGE 8

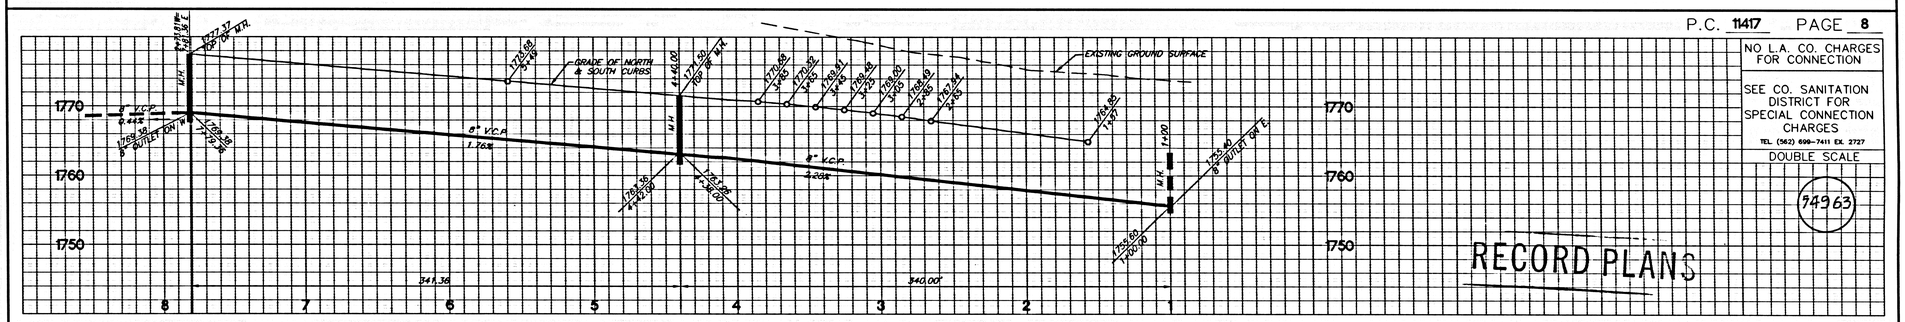

NO L.A. CO. CHARGES FOR CONNECTION

SEE CO. SANITATION DISTRICT FOR SPECIAL CONNECTION CHARGES
TEL. (562) 699-7411 EX. 2727

DOUBLE SCALE

54963

RECORD PLANS

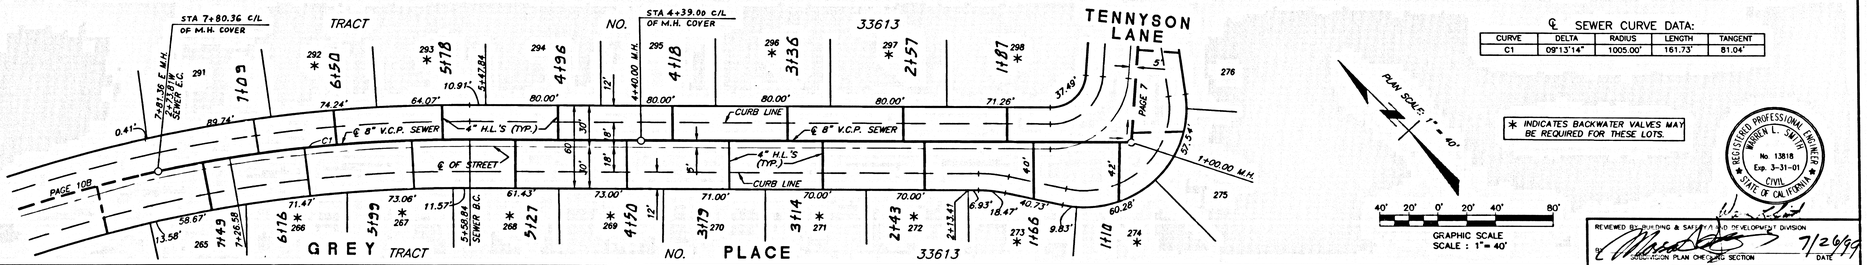

℄ SEWER CURVE DATA:

CURVE	DELTA	RADIUS	LENGTH	TANGENT
C1	09°13'14"	1005.00'	161.73'	81.04'

PLAN SCALE: 1" = 40'

* INDICATES BACKWATER VALVES MAY BE REQUIRED FOR THESE LOTS.

REGISTERED PROFESSIONAL ENGINEER WARREN L. SMITH No. 13818 Exp. 3-31-01 CIVIL STATE OF CALIFORNIA

40' 20' 0' 20' 40' 80'
GRAPHIC SCALE
SCALE : 1" = 40'

REVIEWED BY BUILDING & SAFETY/LAND DEVELOPMENT DIVISION
BY SUBDIVISION PLAN CHECKING SECTION
DATE 7/26/99

FILE I:\PROJECTS\891-007 tr 33613\SEWER\sewer-mh\pass4sep.dwg
REV. 7-26-99 11:52 AM

P.C. 11417 TRACT NO. 33613

P.C. 11417 PAGE 9

NO L.A. CO. CHARGES FOR CONNECTION

SEE CO. SANITATION DISTRICT FOR SPECIAL CONNECTION CHARGES
TEL. (562) 699-7411 EX. 2727

DOUBLE SCALE

54964

RECORD PLANS

℄ SEWER CURVE DATA:

CURVE	DELTA	RADIUS	LENGTH	TANGENT
C1	17°00'33"	560.00'	166.24'	83.74'

* INDICATES BACKWATER VALVES MAY BE REQUIRED FOR THESE LOTS.

REGISTERED PROFESSIONAL ENGINEER
MARVIN L. SMITH
No. 13818
Exp. 3-31-01
CIVIL
STATE OF CALIFORNIA

REVIEWED BY BUILDING & SAFETY LAND DEVELOPMENT DIVISION
SUBDIVISION PLAN CHECKING SECTION
7/26/99
DATE

P.C. 11417 PAGE 10

NO L.A. CO. CHARGES FOR CONNECTION

SEE CO. SANITATION DISTRICT FOR SPECIAL CONNECTION CHARGES
TEL. (562) 699-7411 EX. 2727

DOUBLE SCALE

54965

RECORD PLANS

* INDICATES BACKWATER VALVES MAY BE REQUIRED FOR THESE LOTS.

℄ SEWER CURVE DATA:

CURVE	DELTA	RADIUS	LENGTH	TANGENT
C1	16°34'08"	405.00'	117.12'	58.97'
C2	06°41'19"	405.00'	47.28'	23.67'
C3	16°46'33"	200.00'	58.56'	29.49'

REGISTERED PROFESSIONAL ENGINEER
MARVIN L. SMITH
No. 13818
Exp. 3-31-01
CIVIL
STATE OF CALIFORNIA

REVIEWED BY BUILDING & SAFETY LAND DEVELOPMENT DIVISION
SUBDIVISION PLAN CHECKING SECTION
7/26/99
DATE

FILE D:\PROJECTS\891-007 tr 33613\SEWER\sewer-idh\pss5dwg.dwg
REV. 7-26-99 10:27 AM

TRACT NO. 33613

P.C. 11417

5

P.C. 11417 PAGE 11

NO L.A. CO. CHARGES FOR CONNECTION

SEE CO. SANITATION DISTRICT FOR SPECIAL CONNECTION CHARGES
TEL. (562) 699-7411 EX. 2727

DOUBLE SCALE

54966

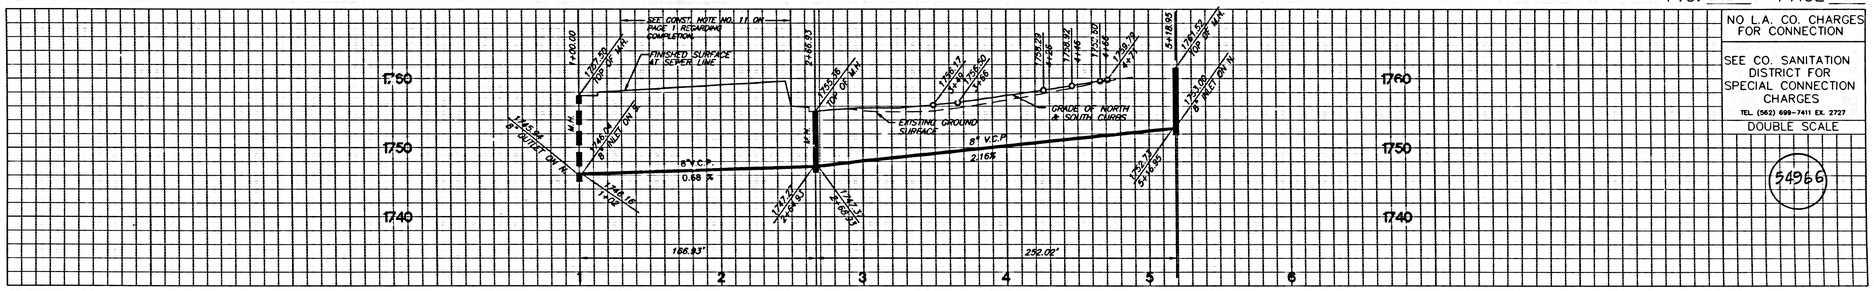

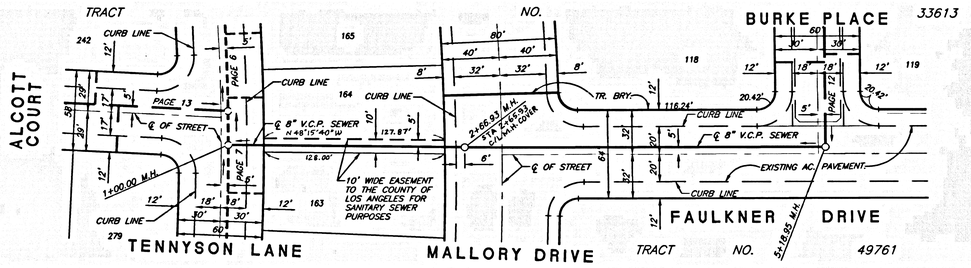

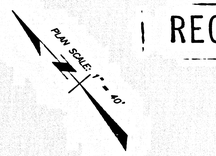

GRAPHIC SCALE
SCALE : 1" = 40'

RECORD PLANS

REGISTERED PROFESSIONAL ENGINEER
WARREN L. SMITH
No. 13818
Exp. 3-31-01
CIVIL
STATE OF CALIFORNIA

REVIEWED BY BUILDING & SAFETY AND DEVELOPMENT DIVISION
BY _____ 7/26/99
SUBDIVISION PLAN CHECKING SECTION DATE

P.C. 11417 PAGE 12

NO L.A. CO. CHARGES FOR CONNECTION

SEE CO. SANITATION DISTRICT FOR SPECIAL CONNECTION CHARGES
TEL. (562) 699-7411 EX. 2727

DOUBLE SCALE

54967

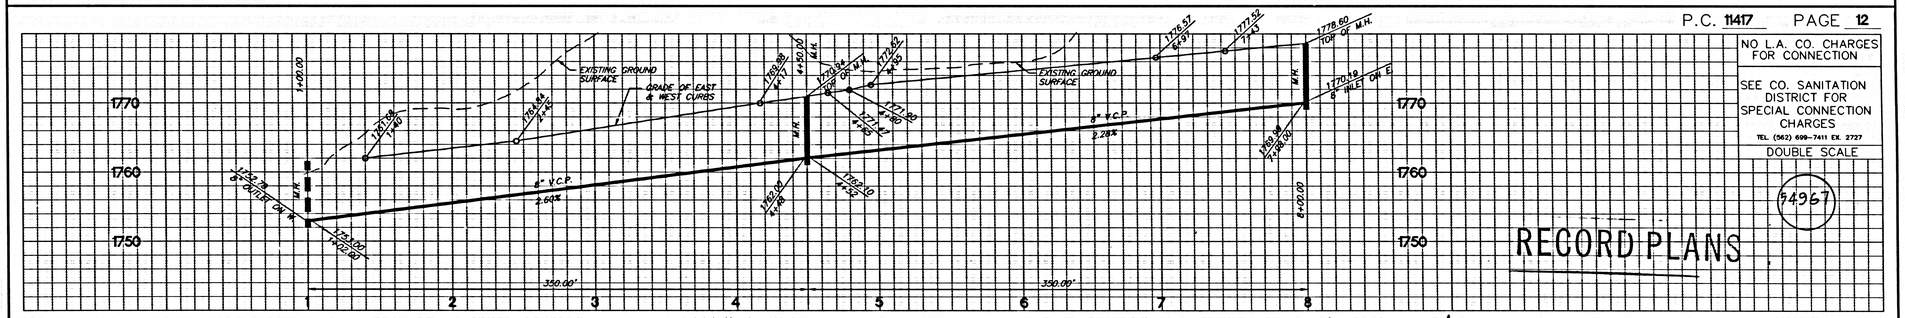

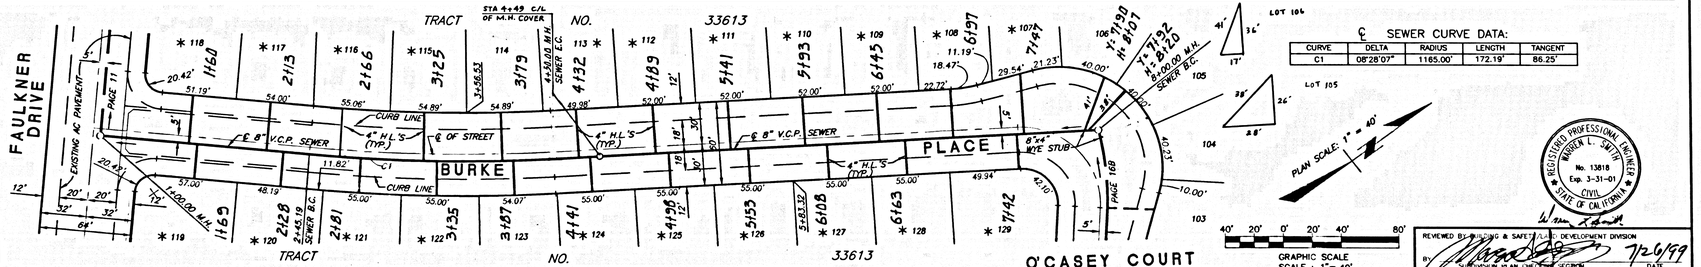

℄ SEWER CURVE DATA:

CURVE	DELTA	RADIUS	LENGTH	TANGENT
C1	08°28'07"	1165.00'	172.19'	86.25'

GRAPHIC SCALE
SCALE : 1" = 40'

REGISTERED PROFESSIONAL ENGINEER
WARREN L. SMITH
No. 13818
Exp. 3-31-01
CIVIL
STATE OF CALIFORNIA

REVIEWED BY BUILDING & SAFETY AND DEVELOPMENT DIVISION
BY _____ 7/26/99
SUBDIVISION PLAN CHECKING SECTION DATE

FILE I:\PROJECTS\891-007 to 33613\SEWER\sewer-all-spreadsheet.dwg
REV. 7-26-99 10:32 AM

TRACT NO. 33613

P.C. 11417 PAGE 13

NO L.A. CO. CHARGES FOR CONNECTION

SEE CO. SANITATION DISTRICT FOR SPECIAL CONNECTION CHARGES
TEL. (562) 699-7411 EX. 2727

DOUBLE SCALE

54968

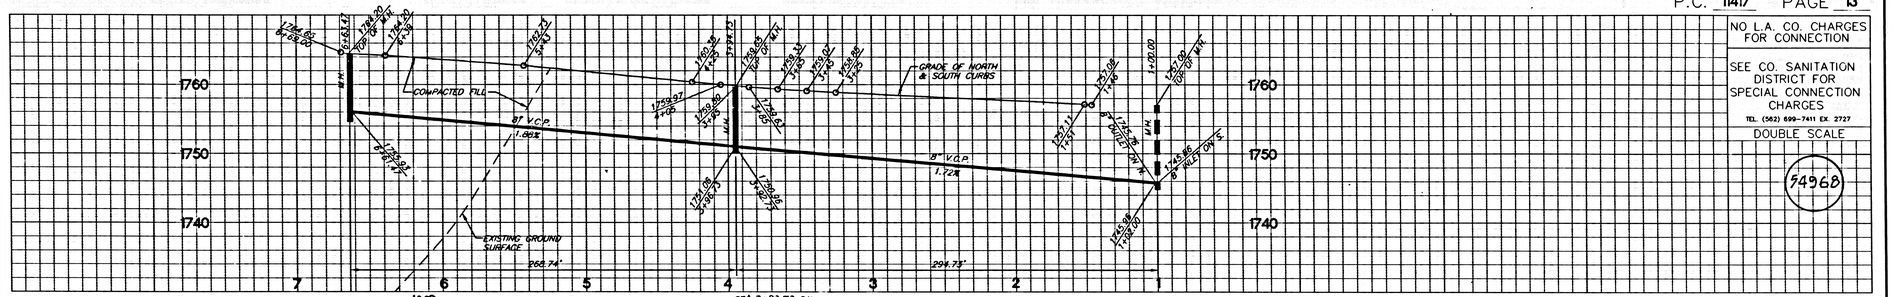

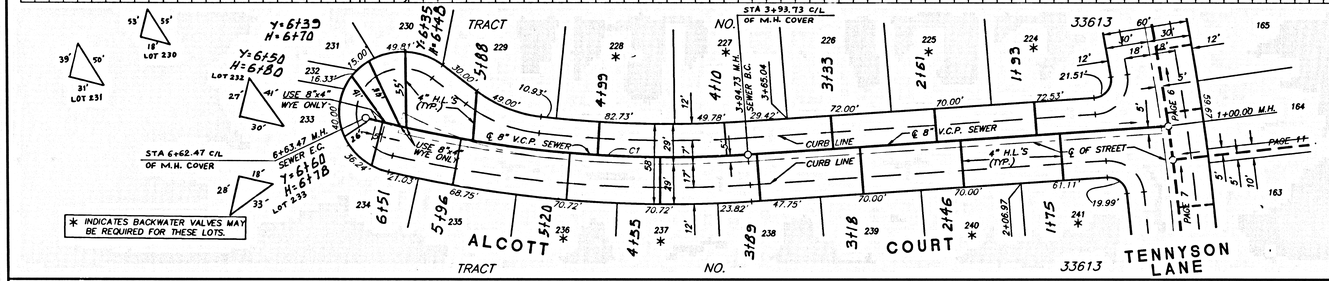

℄ SEWER CURVE DATA:

CURVE	DELTA	RADIUS	LENGTH	TANGENT
C1	19°22'05"	795.00'	268.74'	135.66'

PLAN SCALE: 1" = 40'

RECORD PLANS

REGISTERED PROFESSIONAL ENGINEER MARLIN L. SMITH No. 13818 Exp. 3-31-01 CIVIL STATE OF CALIFORNIA

GRAPHIC SCALE
SCALE : 1" = 40'

REVIEWED BY BUILDING & SAFETY LAND DEVELOPMENT DIVISION
BY SUBDIVISION PLAN CHECKING SECTION DATE 7/26/99

P.C. 11417 PAGE 14

NO L.A. CO. CHARGES FOR CONNECTION

SEE CO. SANITATION DISTRICT FOR SPECIAL CONNECTION CHARGES
TEL. (562) 699-7411 EX. 2727

DOUBLE SCALE

54969

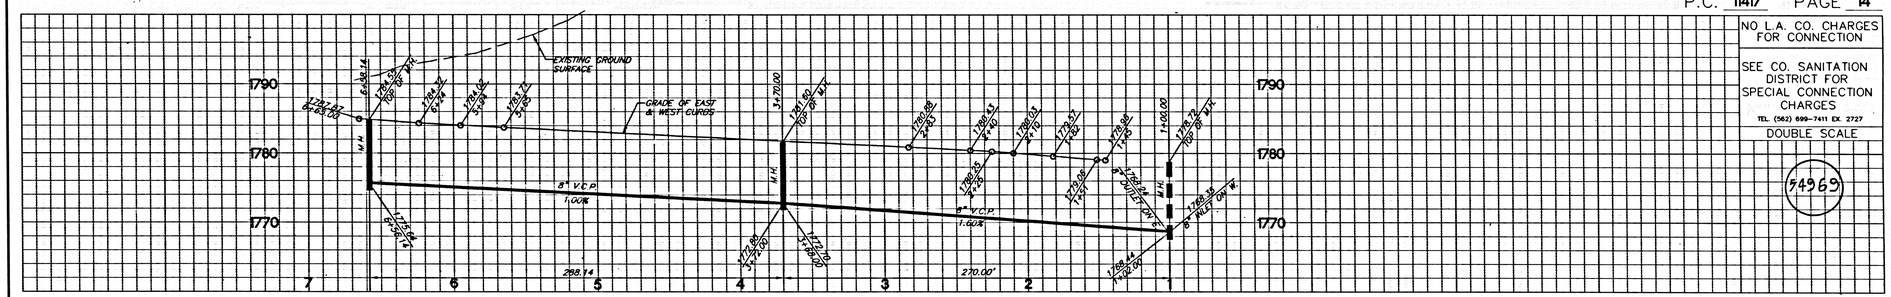

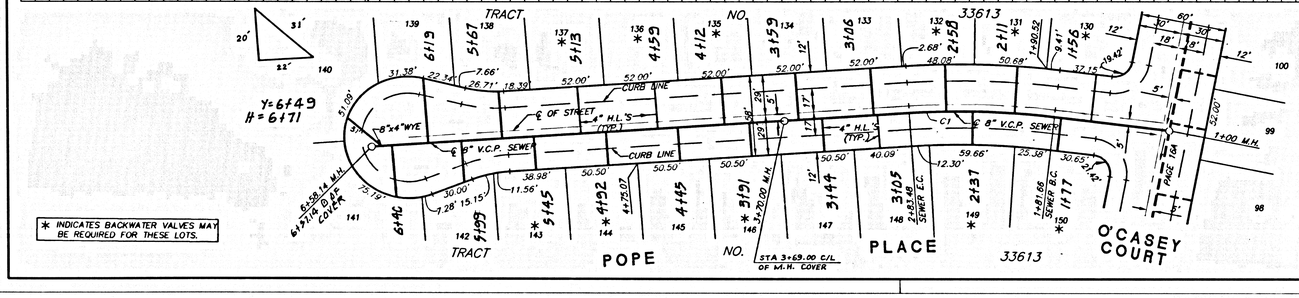

℄ SEWER CURVE DATA:

CURVE	DELTA	RADIUS	LENGTH	TANGENT
C1	11°08'40"	547.33'	106.46'	53.40'

PLAN SCALE: 1" = 40'

RECORD PLANS

REGISTERED PROFESSIONAL ENGINEER MARLIN L. SMITH No. 13818 Exp. 3-31-01 CIVIL STATE OF CALIFORNIA

GRAPHIC SCALE
SCALE : 1" = 40'

REVIEWED BY BUILDING & SAFETY LAND DEVELOPMENT DIVISION
BY SUBDIVISION PLAN CHECKING SECTION DATE 7/26/99

FILE I:\PROJECTS\891-007 tr 33613\SEWER\sewer-ish\pss7deg.dwg
REV. 7-20-99 10:48:34 am

P.C. 11417 PAGE 15

NO L.A. CO. CHARGES FOR CONNECTION

SEE CO. SANITATION DISTRICT FOR SPECIAL CONNECTION CHARGES
TEL. (562) 699-7411 EX. 2727

DOUBLE SCALE


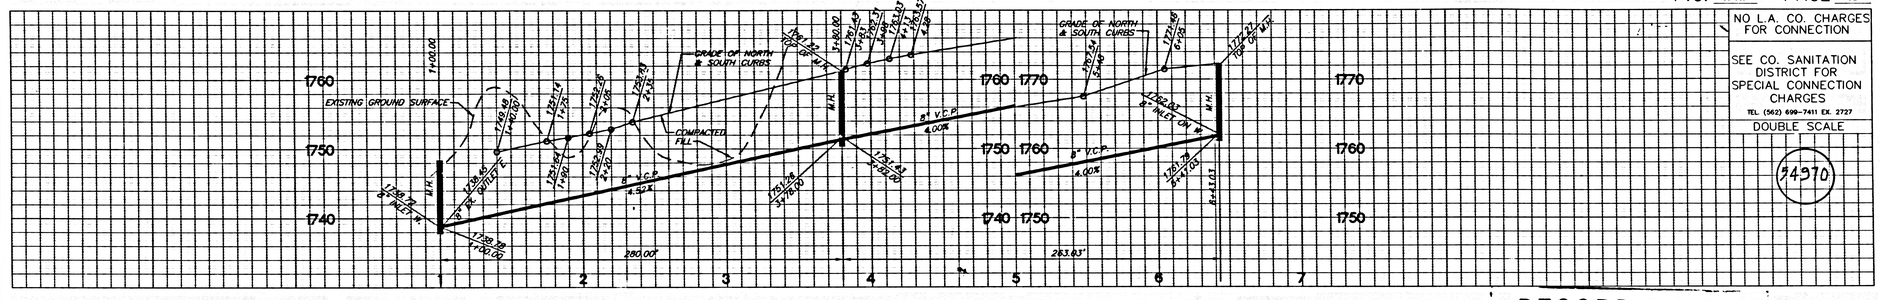

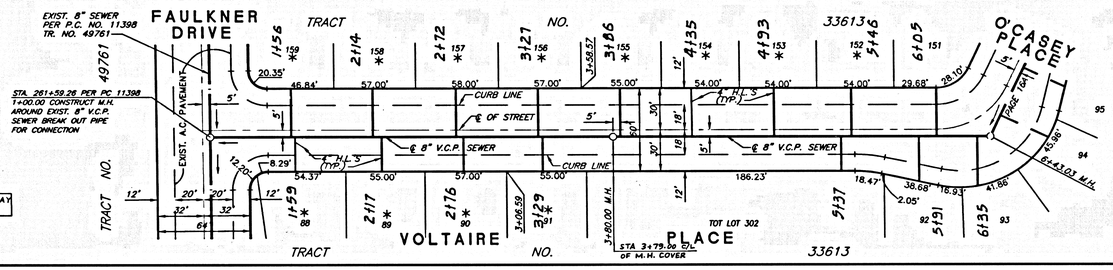

RECORD PLANS

PLAN SCALE: 1" = 40'

GRAPHIC SCALE
SCALE : 1" = 40'

REGISTERED PROFESSIONAL ENGINEER
WARREN L. SMITH
No. 13818
Exp. 3-31-01
CIVIL
STATE OF CALIFORNIA

REVIEWED BY BUILDING & SAFETY LAND DEVELOPMENT DIVISION
BY SUBDIVISION PLAN CHECKING SECTION
DATE 7/26/99

P.C. 11417 PAGE 16

NO L.A. CO. CHARGES FOR CONNECTION

SEE CO. SANITATION DISTRICT FOR SPECIAL CONNECTION CHARGES
TEL. (562) 699-7411 EX. 2727

DOUBLE SCALE


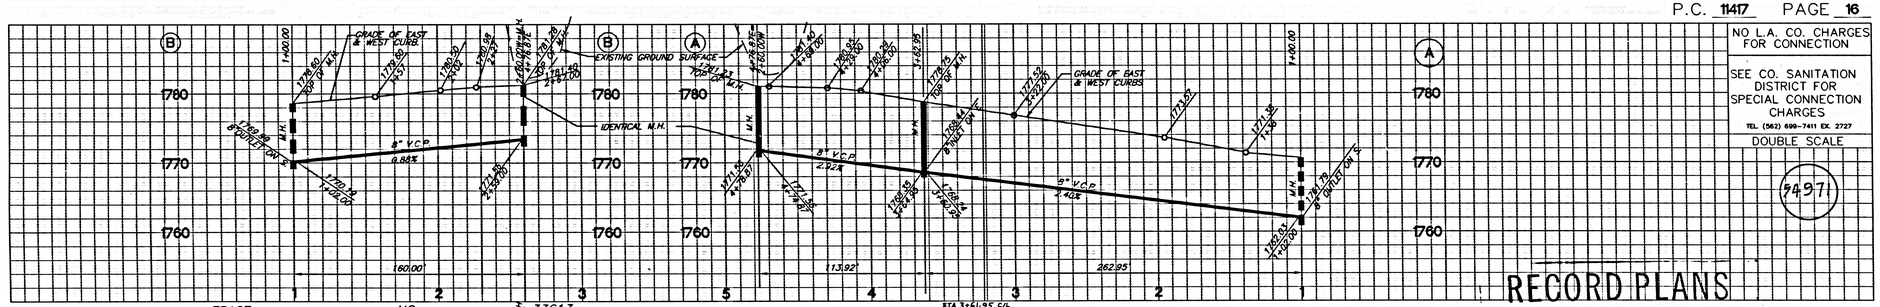

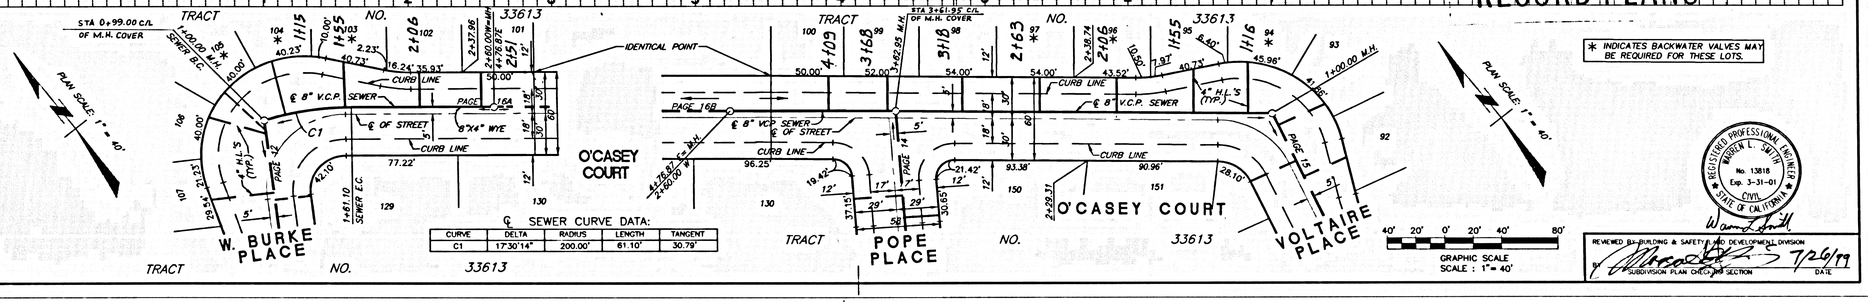

RECORD PLANS

PLAN SCALE: 1" = 40'

GRAPHIC SCALE
SCALE : 1" = 40'

REGISTERED PROFESSIONAL ENGINEER
WARREN L. SMITH
No. 13818
Exp. 3-31-01
CIVIL
STATE OF CALIFORNIA

REVIEWED BY BUILDING & SAFETY LAND DEVELOPMENT DIVISION
BY SUBDIVISION PLAN CHECKING SECTION
DATE 7/26/99

FILE I:\PROJECTS\891-007 tr 33613\SEWER\sewer-ish\pss8dwg.dwg
REV. 7-26-99 11:36 AM

TRACT NO. 33613

8

P.C. 11417 PAGE 17

NO L.A. CO. CHARGES FOR CONNECTION

SEE CO. SANITATION DISTRICT FOR SPECIAL CONNECTION CHARGES
TEL. (562) 699-7411 EX. 2727

DOUBLE SCALE

54972

RECORD PLANS

* INDICATES BACKWATER VALVES MAY BE REQUIRED FOR THESE LOTS.

PLAN SCALE: 1" = 40'

GRAPHIC SCALE
SCALE : 1" = 40'

CURVE DATA:

CURVE	DELTA	RADIUS	LENGTH	TANGENT
C1	01°55'55"	5426.70'	182.97'	91.50'
C2	01°47'04"	4495.00'	140.01'	70.01'

REGISTERED PROFESSIONAL ENGINEER
WARREN L. SMITH
No. 13818
Exp. 3-31-01
CIVIL
STATE OF CALIFORNIA

REVIEWED BY BUILDING & SAFETY AND DEVELOPMENT DIVISION
BY _____ 7/26/99
SUBDIVISION PLAN CHECKING SECTION DATE

P.C. 11417 PAGE 18

NO L.A. CO. CHARGES FOR CONNECTION

SEE CO. SANITATION DISTRICT FOR SPECIAL CONNECTION CHARGES
TEL. (562) 699-7411 EX. 2727

DOUBLE SCALE

54973

RECORD PLANS

* INDICATES BACKWATER VALVES MAY BE REQUIRED FOR THESE LOTS.

℄ SEWER CURVE DATA:

CURVE	DELTA	RADIUS	LENGTH	TANGENT
C1	11°41'37"	995.00'	203.07	103.07

PLAN SCALE: 1" = 40'

GRAPHIC SCALE
SCALE : 1" = 40'

REGISTERED PROFESSIONAL ENGINEER
WARREN L. SMITH
No. 13818
Exp. 3-31-01
CIVIL
STATE OF CALIFORNIA

REVIEWED BY BUILDING & SAFETY AND DEVELOPMENT DIVISION
BY _____ 7/26/99
SUBDIVISION PLAN CHECKING SECTION DATE

TRACT NO. 33613

FILE I:\PROJECTS\891-007 tr 33613\SEWER\sewer-ia\ppss9dwg.dwg
REV. 7-20-99 8:54:02 am

(10)

P.C. 11417 PAGE 19

NO L.A. CO. CHARGES FOR CONNECTION

SEE CO. SANITATION DISTRICT FOR SPECIAL CONNECTION CHARGES
TEL. (562) 699-7411 EX. 2727

DOUBLE SCALE

54974

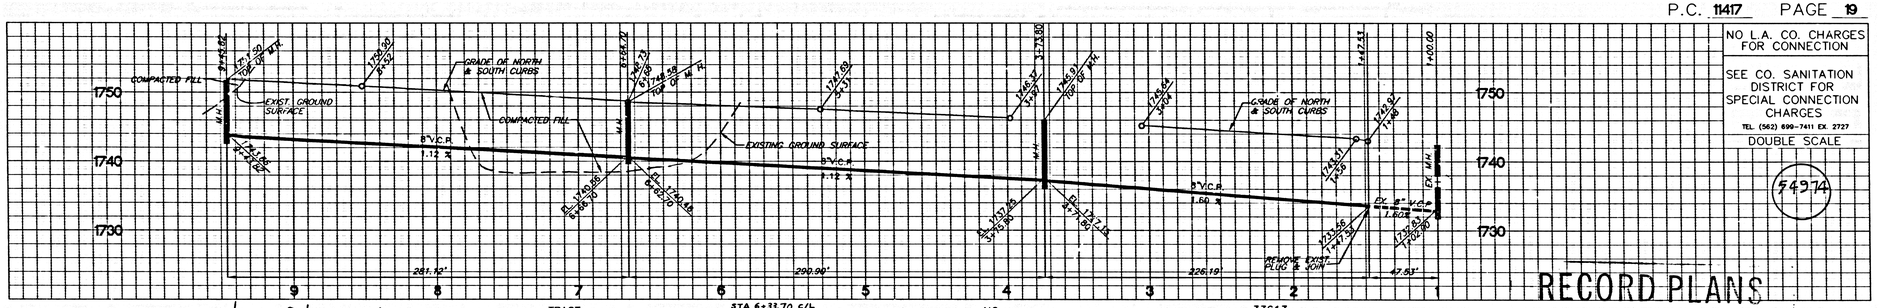

RECORD PLANS

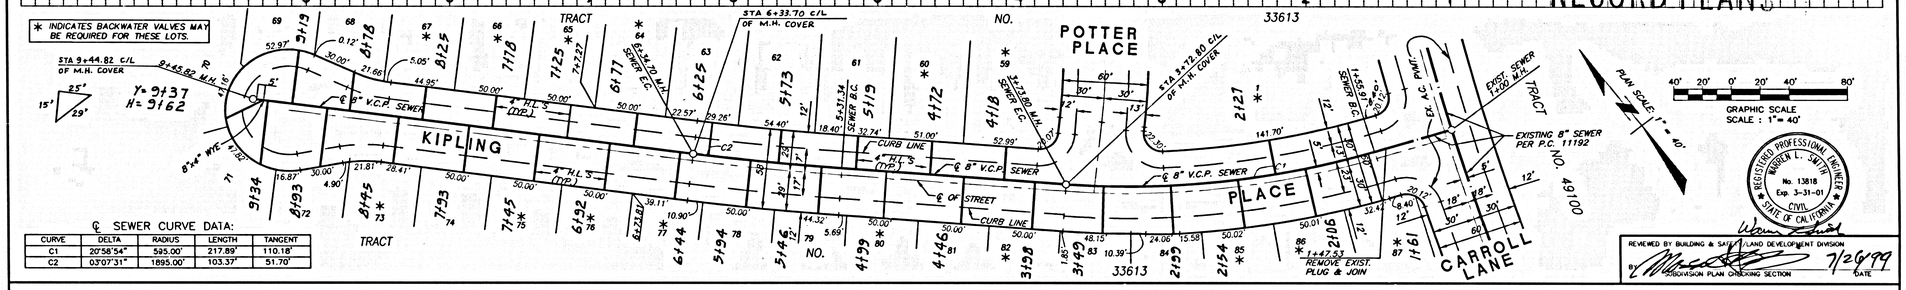

℄ SEWER CURVE DATA:

CURVE	DELTA	RADIUS	LENGTH	TANGENT
C1	20°58'54"	595.00'	217.89'	110.18'
C2	03°07'31"	1895.00'	103.37'	51.70'

REGISTERED PROFESSIONAL ENGINEER
WARREN L. SMITH
No. 13818
Exp. 3-31-01
CIVIL
STATE OF CALIFORNIA

REVIEWED BY BUILDING & SAFETY LAND DEVELOPMENT DIVISION

BY _____ 7/26/99
SUBDIVISION PLAN CHECKING SECTION DATE

TRACT NO. 33613

P.C. 11417