


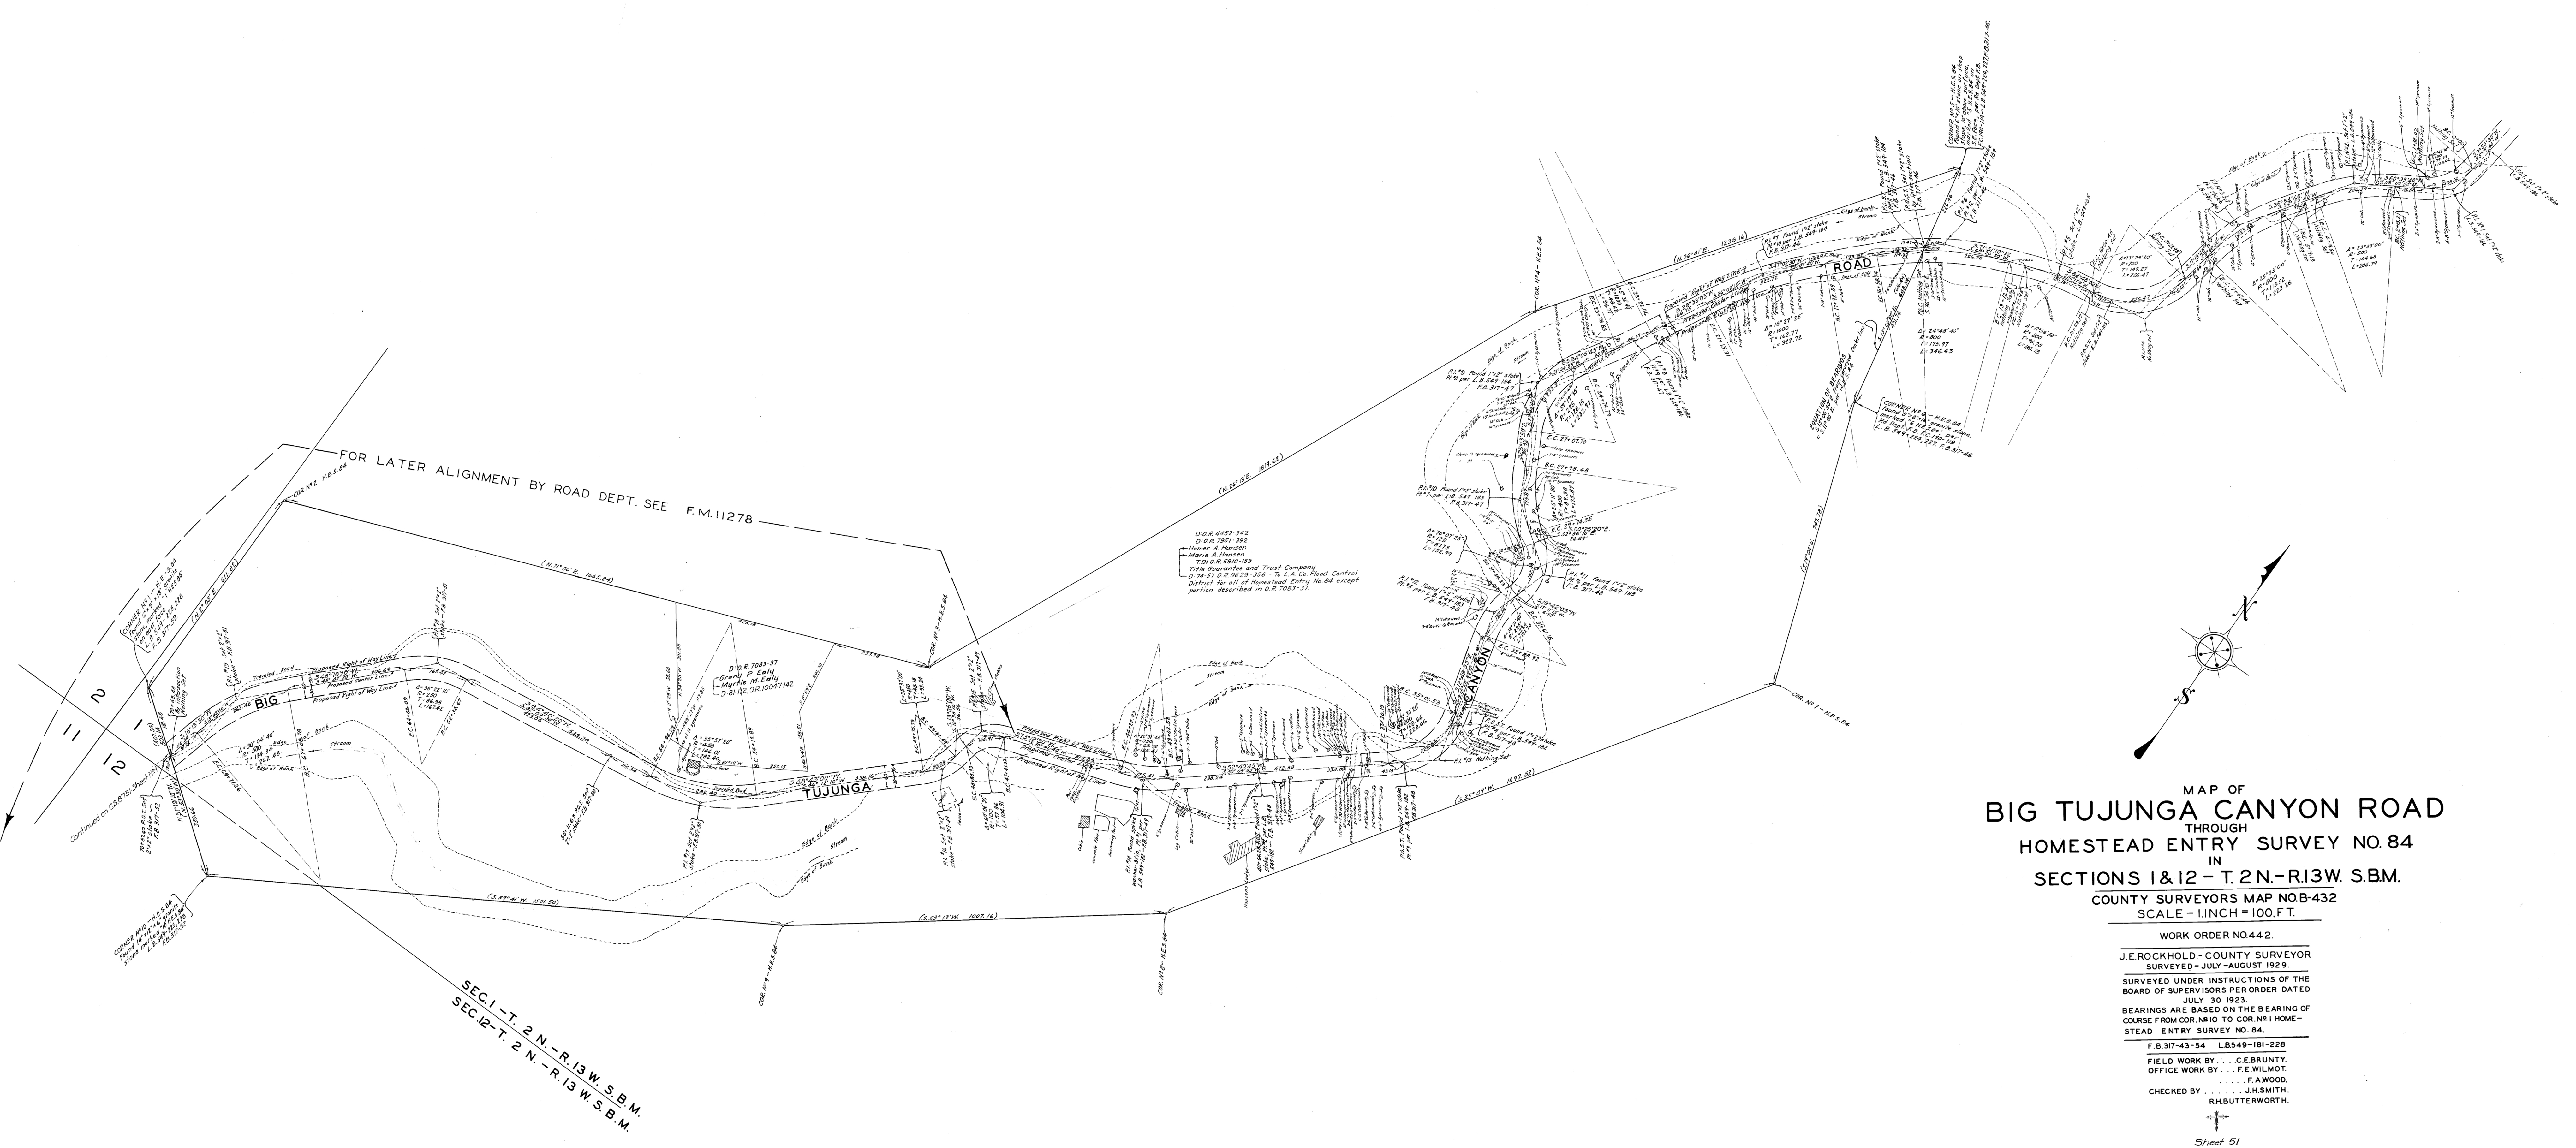

MAP OF
BIG TUJUNGA CANYON ROAD
THROUGH
HOMESTEAD ENTRY SURVEY NO. 84
IN
SECTIONS 1 & 12 - T.2N.-R.13W.S.B.M.
COUNTY SURVEYORS MAP NO. B-432
SCALE - 1 INCH = 100 FT.

WORK ORDER NO. 442.
J.E. ROCKHOLD - COUNTY SURVEYOR
SURVEYED - JULY - AUGUST 1929.
SURVEYED UNDER INSTRUCTIONS OF THE
BOARD OF SUPERVISORS PER ORDER DATED
JULY 30 1923.
BEARINGS ARE BASED ON THE BEARING OF
COURSE FROM COR. N10 TO COR. N11 HOME-
STEAD ENTRY SURVEY NO. 84.

F.B. 317-43-54 LB. 549-181-228
FIELD WORK BY . . . C.E. BRUNTY.
OFFICE WORK BY . . . F.E. WILMOT.
CHECKED BY . . . F.A. WOOD.
R.H. BUTTERWORTH.

