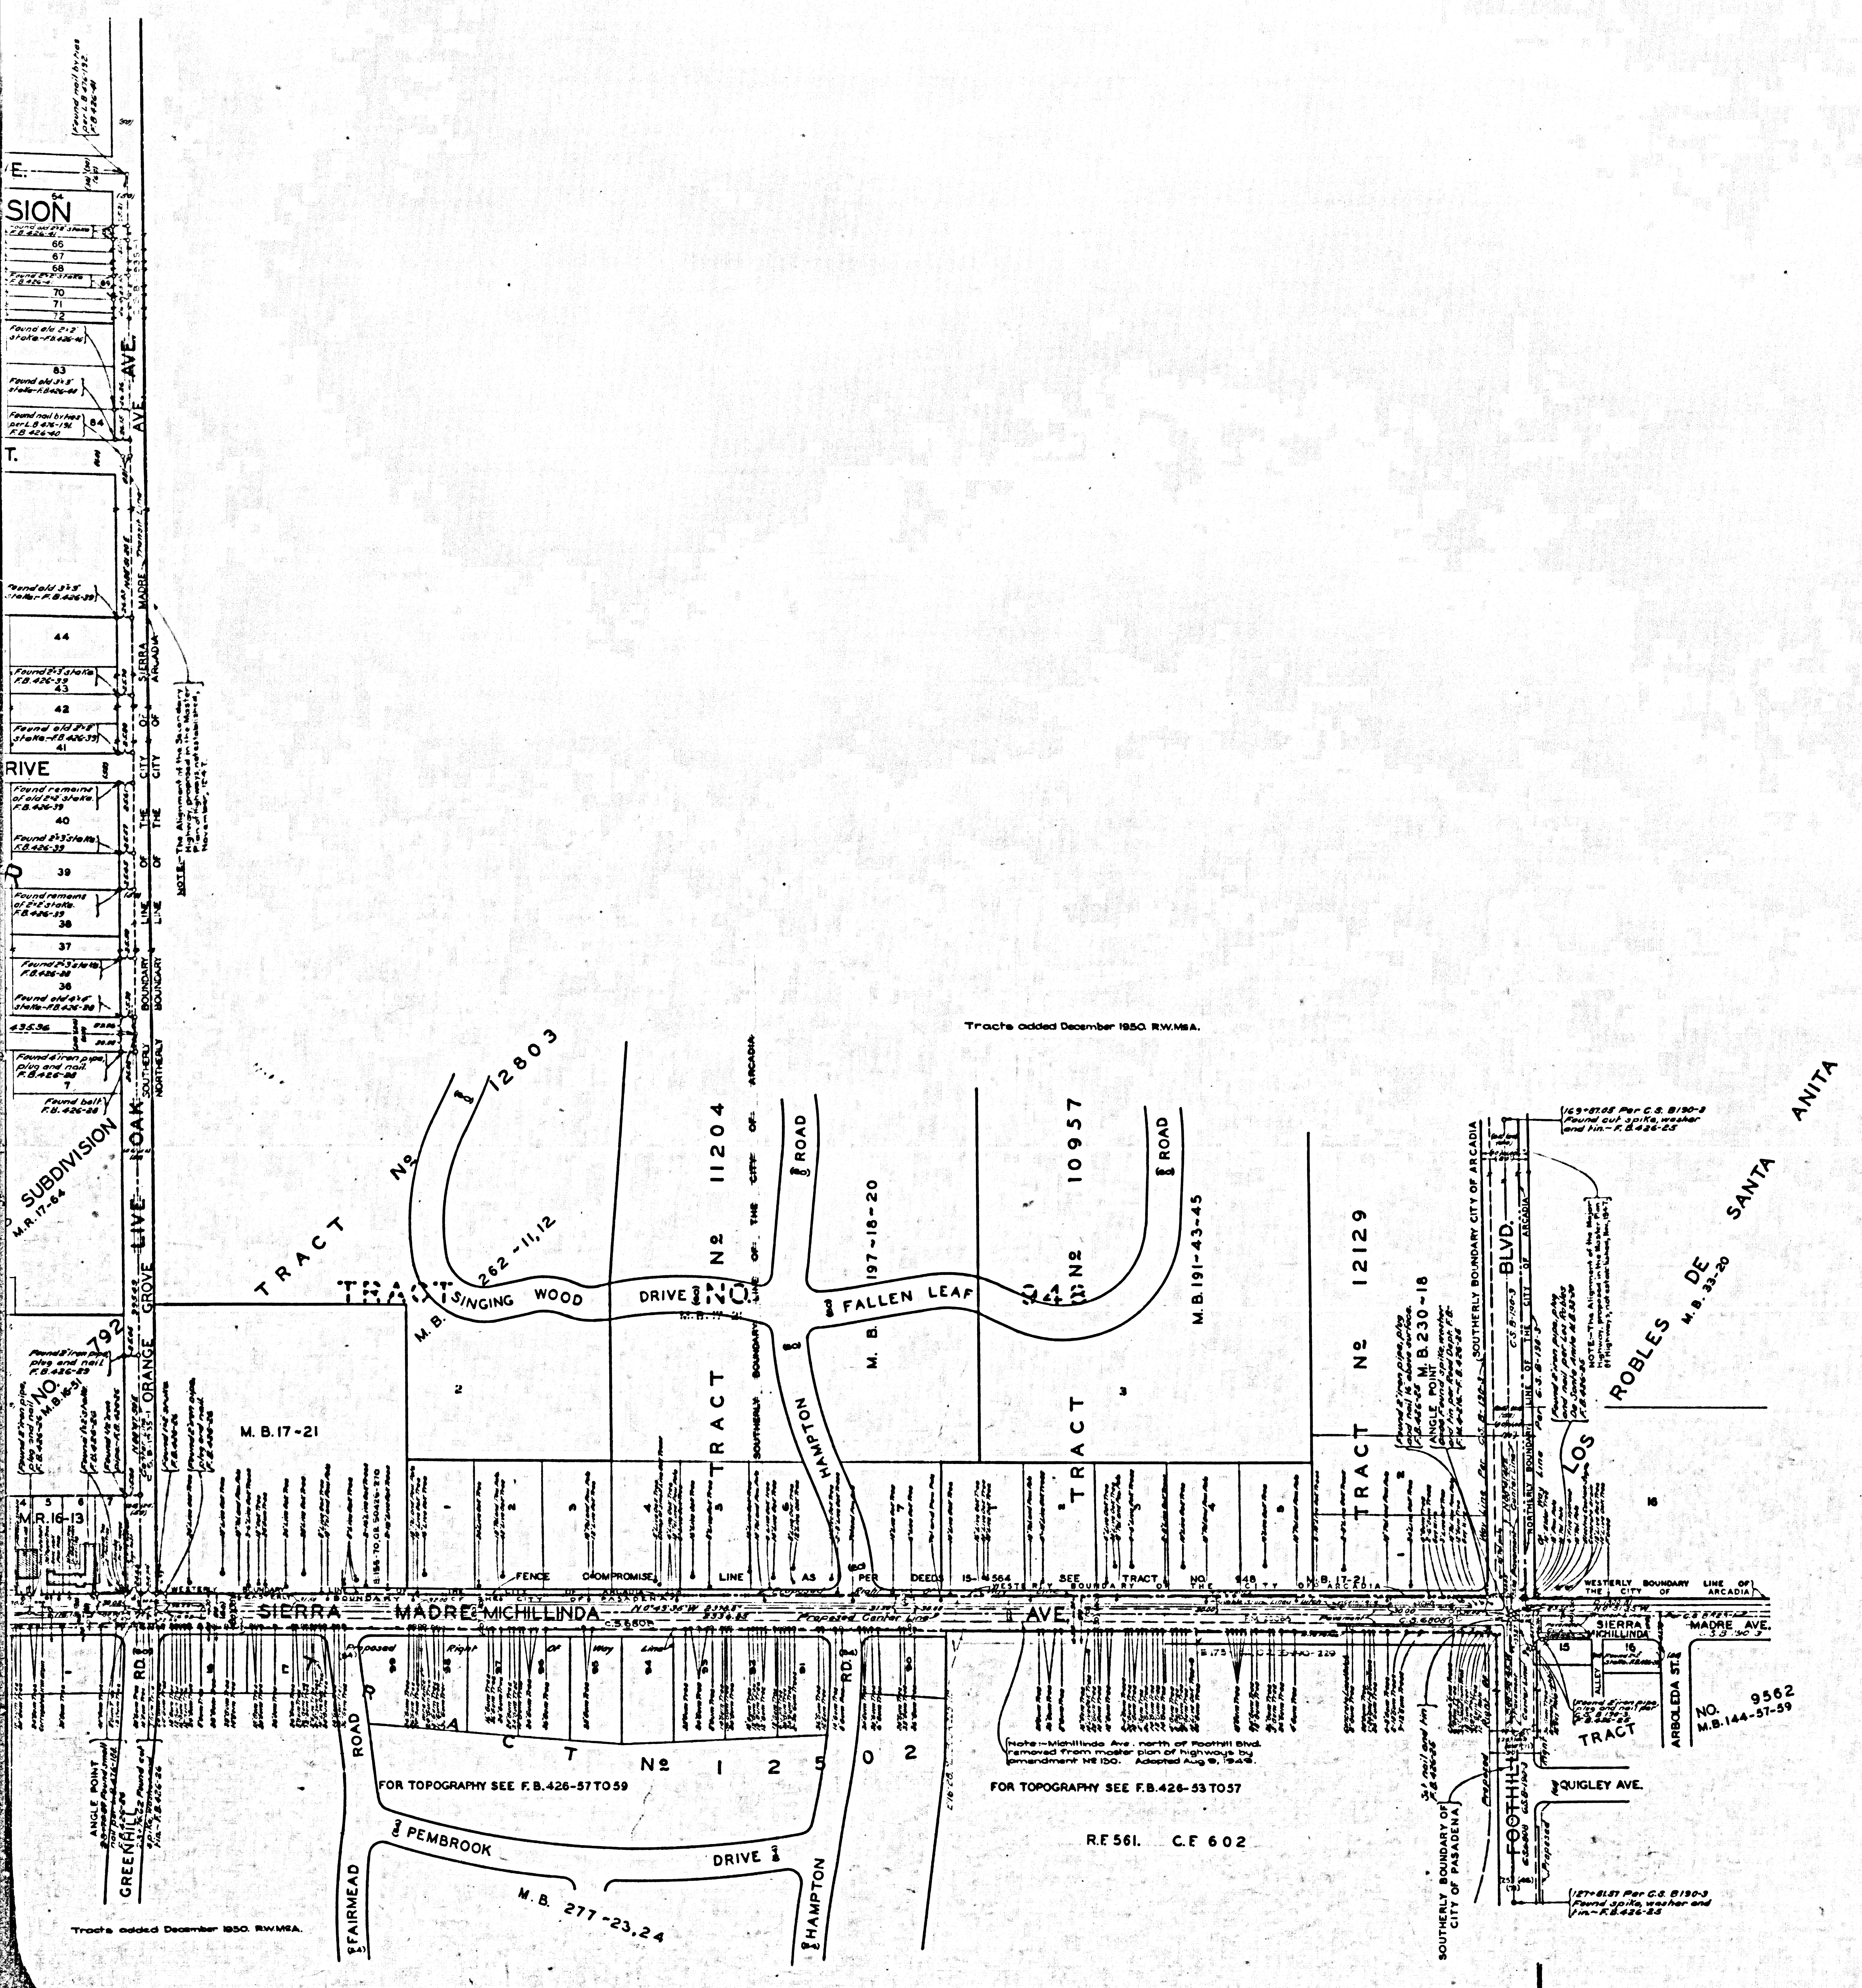

TRACT № 12803
M.B. 262-11,12
SINGING WOOD DRIVE
TRACT № 11204
M.B. 197-18-20
FALLEN LEAF
TRACT № 10957
M.B. 191-43-45
TRACT № 12129
M.B. 230-18
HAMPTON ROAD
ROAD
SANTA ANITA
LOS ROBLES DE
M.B. 33-20
BLVD.
SOUTHERLY BOUNDARY CITY OF ARCADIA
SIERRA MADRE MICHILLINDA AVE
Proposed Center Line
FENCE COMPROMISE LINE AS PER DEEDS
M.B. 17-21
TRACT № 12502
M.B. 277-23,24
PEMBROOK DRIVE
FAIRMEAD
HAMPTON
GREENHILL RD.
ORANGE GROVE
LIVE OAK AVE.
SIERRA MADRE AVE.
SUBDIVISION
M.R. 17-64
M.R. 16-13
NO. 792
ANGLE POINT
SION
RIVE
NORTHERLY BOUNDARY LINE OF THE CITY OF ARCADIA
SOUTHERLY BOUNDARY LINE OF THE CITY OF ARCADIA
Tracts added December 1950. RW.M&A.
Note—Michillinda Ave. north of Foothill Blvd. removed from master plan of highways by Amendment № 130. Adopted Aug. 9, 1949.
FOR TOPOGRAPHY SEE F.B. 426-57 TO 59
FOR TOPOGRAPHY SEE F.B. 426-53 TO 57
R.E. 561. C.F. 602
SOUTHERLY BOUNDARY OF CITY OF PASADENA
FOOTHILL
QUIGLEY AVE.
TRACT NO. 9562
M.B. 144-57-59
ARBOLEDA ST.
SIERRA MICHILLINDA
MADRE AVE.
WESTERLY BOUNDARY LINE OF THE CITY OF ARCADIA

MAP OF See note below

~~MICHILLINDA BOULEVARD~~

~~SIERRA MADRE AVENUE~~

FROM

FOOTHILL BOULEVARD

TO

SIERRA MADRE ~~CENTRAL AVENUE~~ BOULEVARD

COUNTY SURVEYORS MAP NºB-523
SHEET NO. 2 OF 2 SHEETS
SCALE - 1. INCH = 100. FT.

WORK ORDER NO. 957

J.E. ROCKHOLD - COUNTY SURVEYOR
SURVEYED NOVEMBER 1929 TO DECEMBER 1930

SURVEYED UNDER INSTRUCTIONS OF THE BOARD OF SUPERVISORS PER ORDER DATED AUGUST 12, 1929

BEARINGS ARE BASED ON THE BEARING OF FOOTHILL BOULEVARD AS SHOWN ON C.S.B 190-3

F.B. 426-1 TO 70

FIELD WORK BY P.T. DUNLAP
" " " W.A. MILLER
OFFICE WORK BY BERT McATEE
CHECKED BY D.M. FINLEY

Sht. 44
Sht. 45

NOTE:-
MICHILLINDA BLVD. NORTH OF FOOTHILL BLVD. REMOVED FROM MASTER PLAN OF HIGHWAYS BY AMENDMENT № 130. ADOPTED AUG. 9, 1949.

NOTE.
Sierra Madre Ave. changed to Michillinda Ave. from Foothill Blvd. to Orange Grove Ave. Sierra Madre Ave. changed to Michillinda Blvd. from Orange Grove Ave. to northeasterly Boundary of the City of Sierra Madre.

Revised, May, 1947 - J.D. Pries.
Revised, Nov. 1947 - J.D. Pries.
Revised Dec. 1950. R.W.M&A.

CSB-523-2
A1 OF A3

BALDWIN AVE.
AUBURN AVE.
LIMA ST.
GROVE ST.
GROVE ST.
SIERRA VISTA TRACT
M.B. 11-76
MRS. C.B. JONES SUBDIVISION
M.R. 13-89
HERMOSA AVE.
TRACT NO. 6962
SPAULDING AND PINNEY'S SUBDIVISION
OAK KNOLL TRACT
WHITE'S SUBDIVISION
M.R. 15-19
TRACT NO. 8305
M.B. 94-8
FOWLER PLACE
M.B. 14-22
SIERRA MADRE TRACT
M.R. 4-502-503
HERMOSA AVE.
HART'S SUBDIVISION
M.R. 14-5
TRACT
ESPERANZA AVE.
BONITA AVE.
PROSPECT PARK
TRACT NO. 2117
M.B. 21-173
VACATION
M.R. 53-56
PARK AVE.
PALM COURT
PALM DRIVE
MANOR
TRACT NO. 338
TRACT NO. 90
M.B. 13-49
SIERRA MADRE TRACT
M.B. 11-160
TRACT NO. 5065
M.B. 53-99
TRACT NO. 2206
M.B. 22-115
PARK PLACE SIERRA MADRE
M.B. 10-93
13320
FAIRVIEW AVE.
ALEGRIA AVE.
GRAND VIEW AVE.
HIGHLAND AVE.
MONTECITO AVE.
SUNNYSIDE AVE.
WHEELER HEIGHTS
M.B. 8-5
GURHARDY HEIGHTS
M.B. 13-188
TRACT NO. 7256
M.B. 94-21
WILSON ST.
TRACT NO. 10174
REPLAT OF TRACT
M.B. 179-19
M.R. 52-30
EDGEMONT
REPLAT OF GRAND VIEW TRACT
M.B. 7-139
PIERCE'S
EDGEMONT TRACT
M.B. 7-116
SIERRA MADRE CENTRAL
Wm. B. CRISP'S SUBDIVISION
M.R. 17-64
MARIPOSA AVE.
RAMONA AVE.
MANZANITA AVE.
ANDREWS
M.B. 16-13
SUBDIVISION
TRACT NO. 9699
Wm. B. CRISPS SUBDIVISION
M.R. 17-64
TRACT NO. 792
LIVE OAK
ORANGE GROVE
TRACT NO.
M.B. 17-21
SINGING
SIERRA MADRE BLVD.
MICHILLINDA
EASTERLY BOUNDARY OF CITY OF PASADENA
WESTERLY BOUNDARY OF THE CITY OF SIERRA MADRE
PACIFIC ELECTRIC RY. RIGHT OF WAY
SIERRA MADRE BLVD.
NORTHERLY BOUNDARY CITY OF PASADENA
FOR TOPOGRAPHY SEE F.B. 426-67 TO 70
FOR TOPOGRAPHY SEE F.B. 426-62 TO 67
FOR TOPOGRAPHY SEE F.B. 426-59 TO 62
FOR TOPOGRAPHY SEE
TRACT No 12501
SHADOW GROVE RD.
M.B. 294-29-31
GREENHILL RD.
ROAD
PEMBROOK
FAIRMEAD
LAND OF A.B. CHAPMAN
R.F. 561
C.F. 602
Tracts added December 1950. R.W.M.A.

CS B-523-2
A2 OF A3

STATION NO. 16
SANTA ANITA RANCHO
Set by intersection A 2" iron pipe set in concrete 8" below surface with brass cap marked - F.B 426-9
Note - Loma Alta Drive removed from master plan of highways by amendment No 150, adopted Aug 9 1949
LOMA ALTA DRIVE
Proposed Right of Way Line Per C.S.B. 306-2
Found 4"x4" redwood stake 20 above surface and 15' East of canyon rim. F.B. 426-9
Found 4x4 redwood stake in mound of rocks, 1' West of fence corner in bottom of canyon per Tract No 2927 M.B 30-41 - F.B 426-8
1/4 SECTION LINE
Found 2x4 stake and nail rotted off. Reset top of stake where base was found F.B 426-8
TRACT NO. 2927 M.B. 30-41
VOSBURG TRACT
K
PART OF VOSBURG TRACT
J
M.R. 52-77
REPLAT
VOSBURG TRACT
M.R. 14-85-86
ANGLE POINT
SIERRA MADRE VILLA AVE.
NORTHERLY LINE OF THE SANTA ANITA RANCHO
T.1N., R.11W.
T.1N., R.12W.
RANGE LINE
KINNELOA RANCH M.R. 70-52
C.F. 178
SOUTHERN CALIFORNIA EDISON COMPANY RIGHT OF WAY
D.O.R. 5674-162
MARGINAL MAP
SCALE: 1 INCH=200 FT.
Found 3x3 white stake 24 above surface marked W.C. on South face. F.B. 426-5
Found 2"x2" stake F.B. 426-5
Found Southern California Edison Company monument 6" below surface with brass cap per L.B. 614-231 F.B. 426-5
Found 3"x3" white stake 18" above surface marked "W.C." on North face. - F.B. 426-5
STATION NO. 15
SANTA ANITA RANCHO
Found Southern California Edison Company monument 18" below surface with brass cap per L.B. 614-231. Rock mound 4' North - F.B. 426-5
STATION NO. 16
SANTA ANITA RANCHO
Set by intersection A 2" iron pipe set in concrete 8" below surface with brass cap marked F.B. 426-9
Found 4"x4" redwood stake per L.B. 576-162 - F.B. 426-9
NORTHEASTERLY LINE OF THE SANTA ANITA RANCHO
Set 2" iron pipe in concrete by intersection with brass cap marked - F.B. 426-9
Found 6"x6" concrete monument per L.B. 576-162 - F.B. 426-9
1/4 SECTION CORNER
WESTERLY BOUNDARY LINE OF THE CITY OF SIERRA MADRE
MICHILLINDA
Center Line
SIERRA MADRE
C.S.B-306-2
N 0°44'10" W
1326.69
204+33.27 B.C. Per C.S.B-306-2
Note - Michillinda Blvd. north of Foothill Blvd. removed from master plan of highways by amendment No 130, adopted Aug. 9, 1949.
Note - Loma Alta Drive removed from master plan of highways by amendment No 130, adopted Aug 9 1949.
LOMA ALTA DRIVE
SIERRA MADRE TRACT
SIERRA MADRE TRACT No 13320
M.R. 4-502-503
M.B. 265-42
Tract added Dec. 1950. R.W.M.A.
SUNNYSIDE
FAIRVIEW AVE.
ALEGRIA AVE.
WHEELER HEIGHTS
M.B. 6-5
GURHARDY HEIGHTS
M.B. 13-188
GRAND VIEW
BALDWIN
AUBURN
LIMA
GROVE ST.
AVE.
WESTERLY BOUNDARY
LAND
20
19
3
4
5
7
18
12
13

CS B-523-2
A3 OF A3