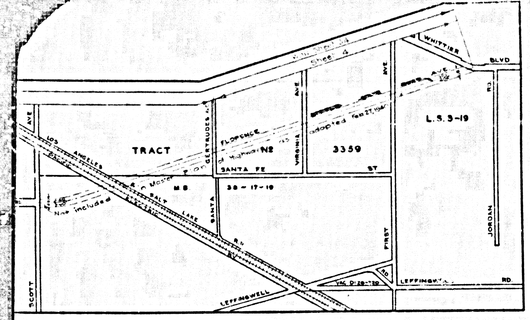
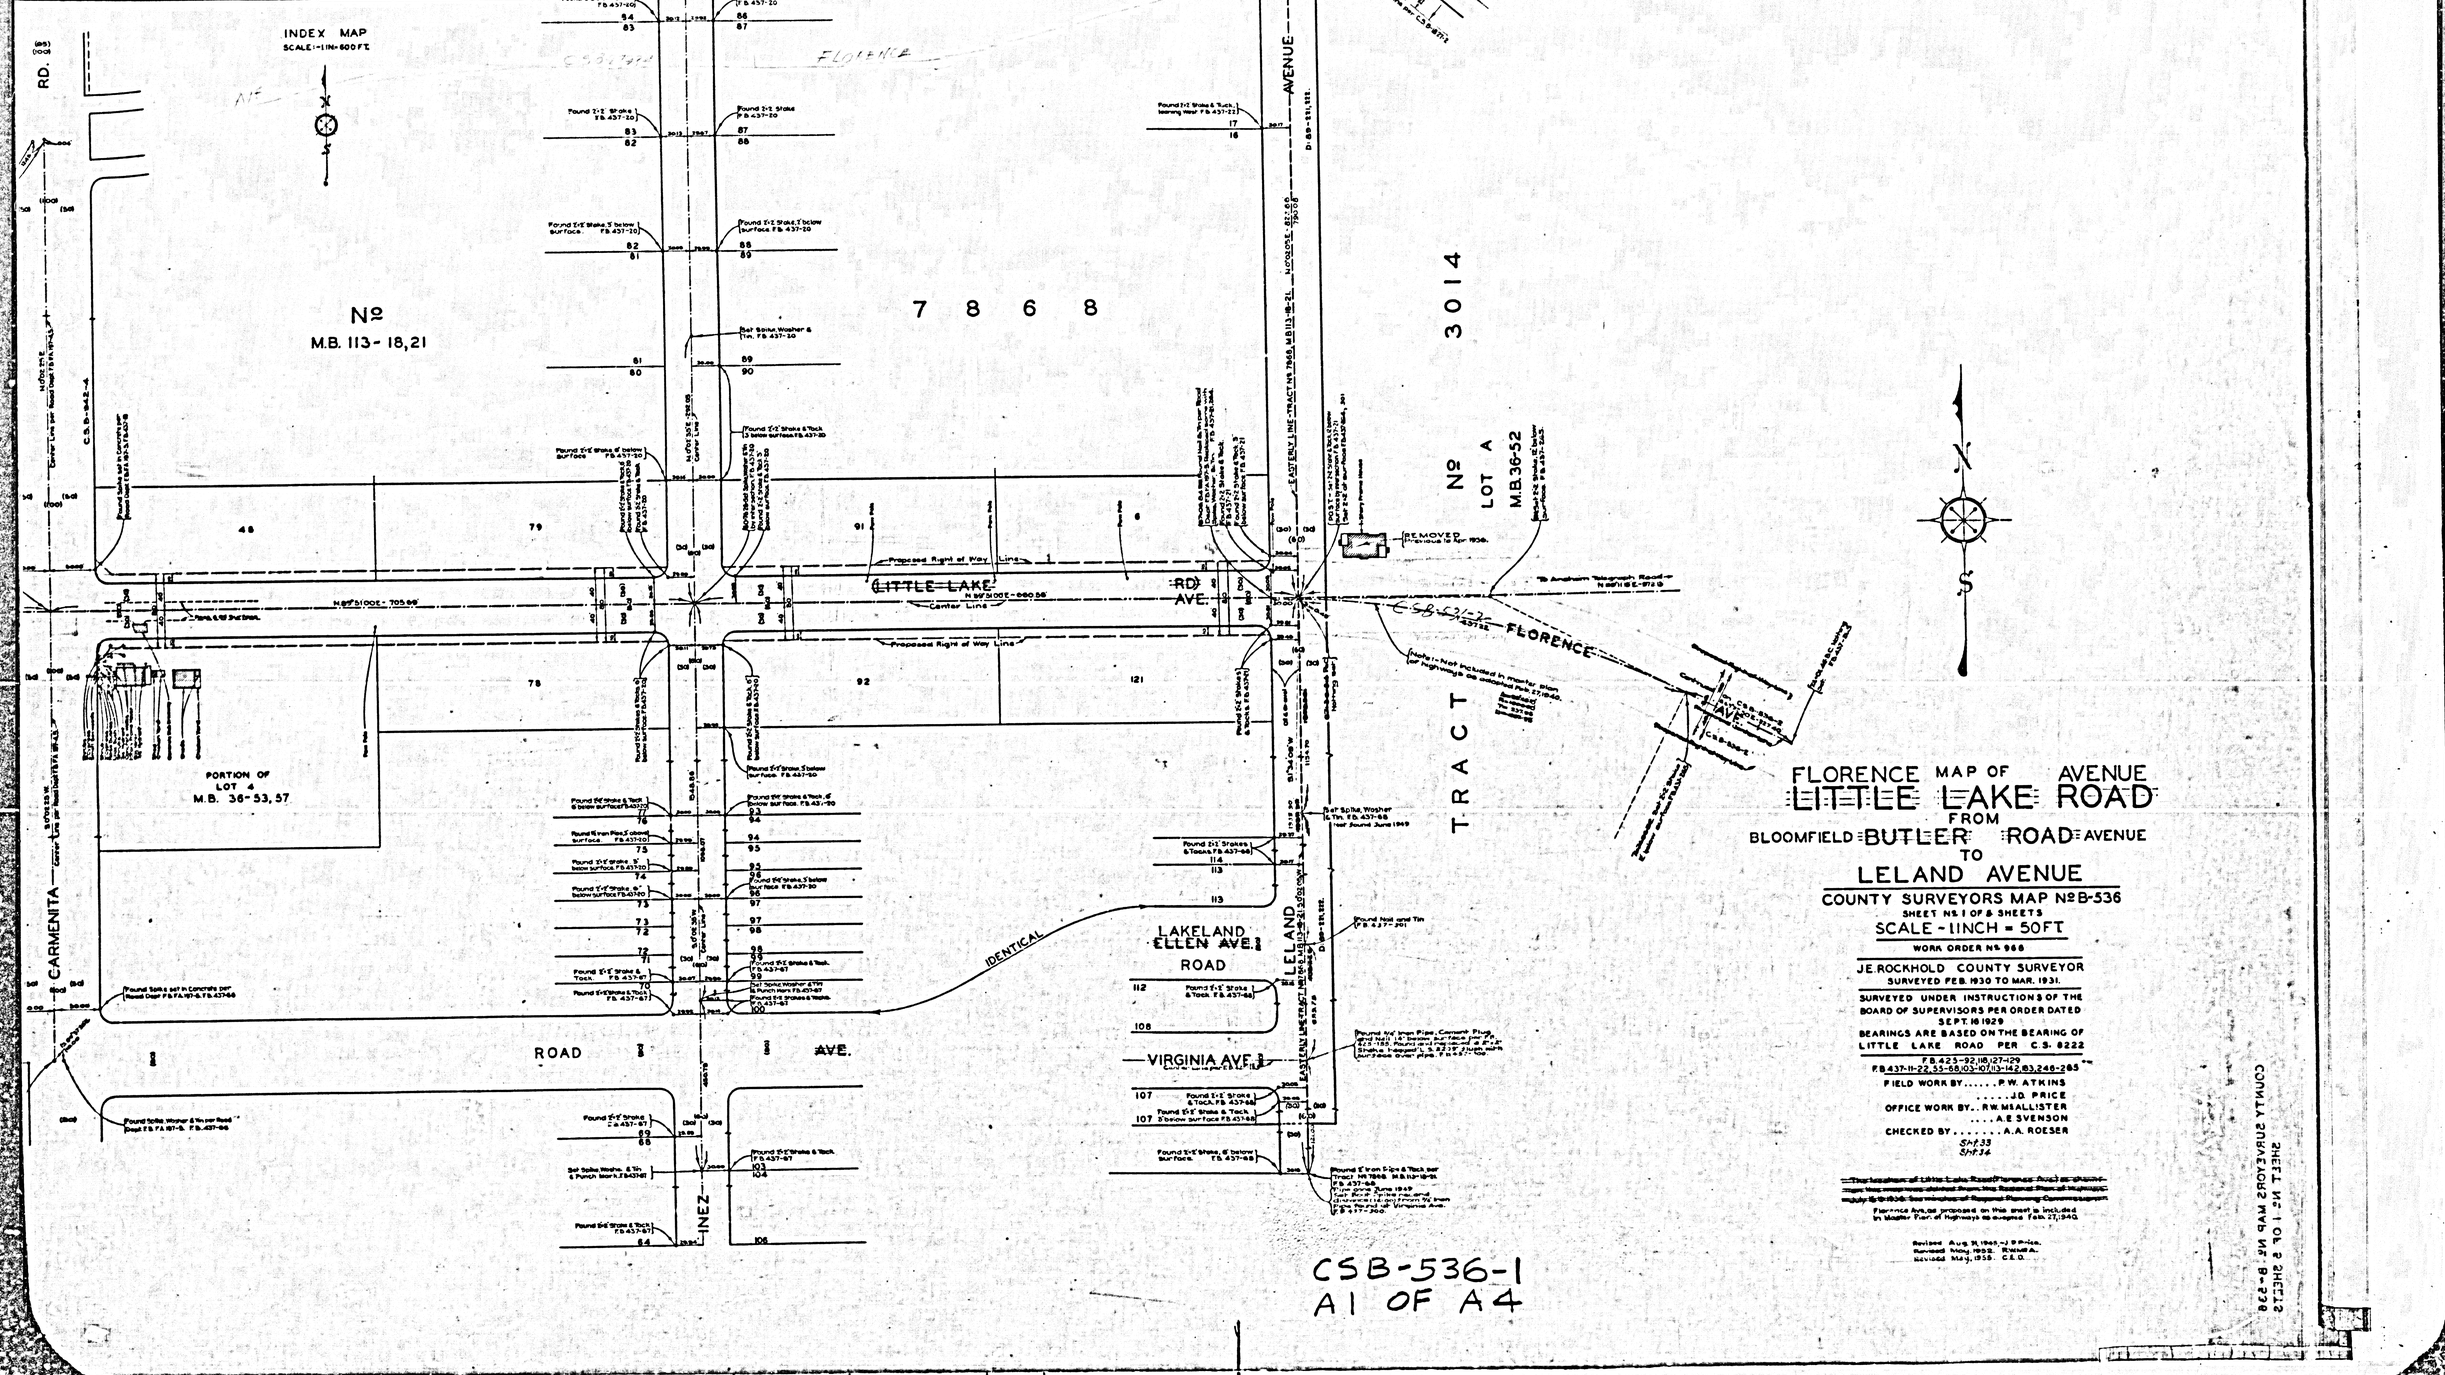


INDEX MAP
SCALE: 1 INCH = 600 FEET


Nº
M.B. 113 - 18, 21
7 8 6 8
Nº 3014
LOT A
M.B. 36-52
PORTION OF LOT 4 M.B. 36-53, 57
TRACT
ANAHEIM TELEGRAPH ROAD
AVENUE
FLORENCE
LITTLE LAKE
RD
AVE.
CARMENITA
ROAD
AVE.
LINEZ
LELAND
LAKELAND
ELLEN AVE.
ROAD
VIRGINIA AVE.
IDENTICAL
REMOVED
Proposed Right of Way Line
Center Line
Found 1"x2" Stake & Tack, FB. 437-20
Found 1"x2" Stake, 3" below surface, FB. 437-20
Set Lead & Tack in pavement (in inter section) FB. 437-22
Found 2" Iron Pipe set in Concrete with tablet "L.S. 4417 Brass M.B. 113-18-21" and FB. 437-68
Found 1"x2" Stake & Tack, leaning West FB. 437-22
Found 1"x2" Stakes & Tacks, FB. 437-66
Found 1"x2" Stake & Tack, FB. 437-66
Found 1"x2" Stake & Tack, 3" below surface FB. 437-66
Found 1"x2" Stakes & Tacks, FB. 437-67
Found 1"x2" Stake & Tack, 3" below surface FB. 437-67
Found 1"x2" Stakes & Tacks, FB. 437-68
Found 1"x2" Stake & Tack, 3" below surface FB. 437-68
M. B. 10-73

ANAHEIM

TELEGRAPH RD.

C S B-1527-2

AVE.

LOT 6

LOT 14

Lot 26

LOT 27

LOT 13

FLORENCE

LITTLE LAKE

AVENUE

IDENTICAL

Proposed Right of Way Line

Proposed Center Line

Proposed Right of Way L

Old Dirt Road

4 Inch Orange Tree

REMOVED

ANGLE POINT

Mc.D.H.-L.P.M. Line Nail in Top

Meyer Road Set 20' Inside R/W

Below surface P.B. 437-118

TOR. F 5264

RD.

MEYER

SHOEMAKER

LAKELAND ROAD

ELLEN LAKELAND ROAD

Continued on C.S.B. 410-2

CSB-536-1
A3 OF A4

COUNTY SURVEYOR'S MAP NO. B-536
SHEET NO. 1 OF 2 SHEETS

CLARK AVE.

SANTA FE SPRINGS
M.R. 107 ~ 234.235

BONE BRAKE AVE.

DUNN SMITH & CORNWELL'S SUBDIVISION
M.R. 18-98

MEYER

EQUATION

FLORENCE ~~LITTLE~~ LAKE

MILLS BLVD. RD.

WARD ST.

NORWALK & PUENTE

TOR. B.C. 19902

TOR. F 5264

BUTLER

BLOOMFIELD

ROAD AVE.

MURRAY

ROMANDEL

AVE. R/W AVE.

SANTA

IDENTICAL

ANGLE POINT


DETAIL

ATCHISON-TOPEKA & SANTA FE RAILWAY

~~MEYER~~ LAKELAND ROAD ~~RD.~~

~~MEYER~~ LAKELAND

CSB-536-1
A4 OF A4

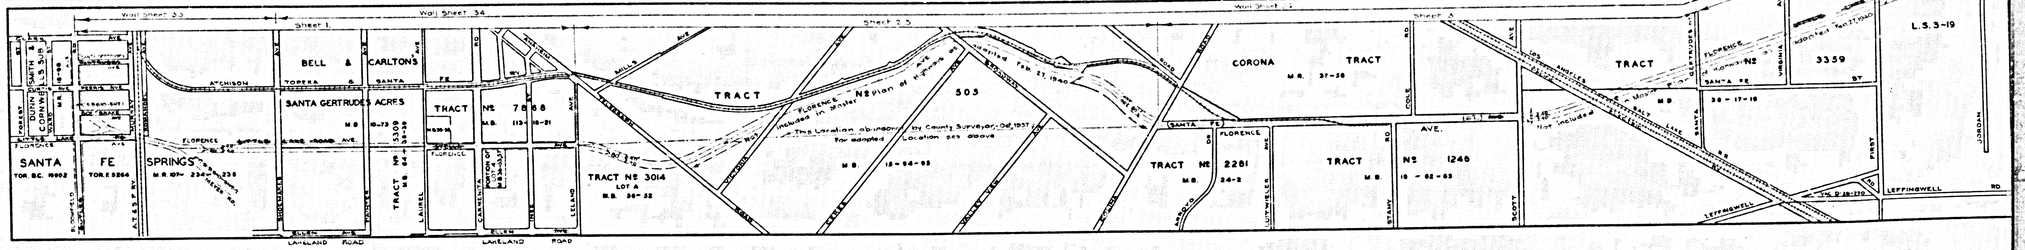

INDEX MAP
SCALE: 1 IN = 600 FT.

CARLTON'S
RUDES ACRES
M.B. 10-73

ATCHISON TOPEKA & SANTA FE RAILWAY R/W

ALLEY

FLORENCE CSB-2738-1

AVE.

5309

Nº M.B. 64-38,39

LOT 14

LOT 13

LOT 10

LOT 11

TRACT

TRACT Nº 3152
M.B. 36-56
PORTION OF LOT 4

Nº
M.B. 113-18,21

PORTION OF
LOT 4
M.B. 36-53,57

Proposed Right of Way Line

Center Line

LITTLE LAKE FLORENCE

FLORENCE STELLA

PAINTER AVE.

ROAD AVE.

LAUREL

CARMENITA RD.

ELLEN LAKELAND

CSB-536-1
A2 OF A4