
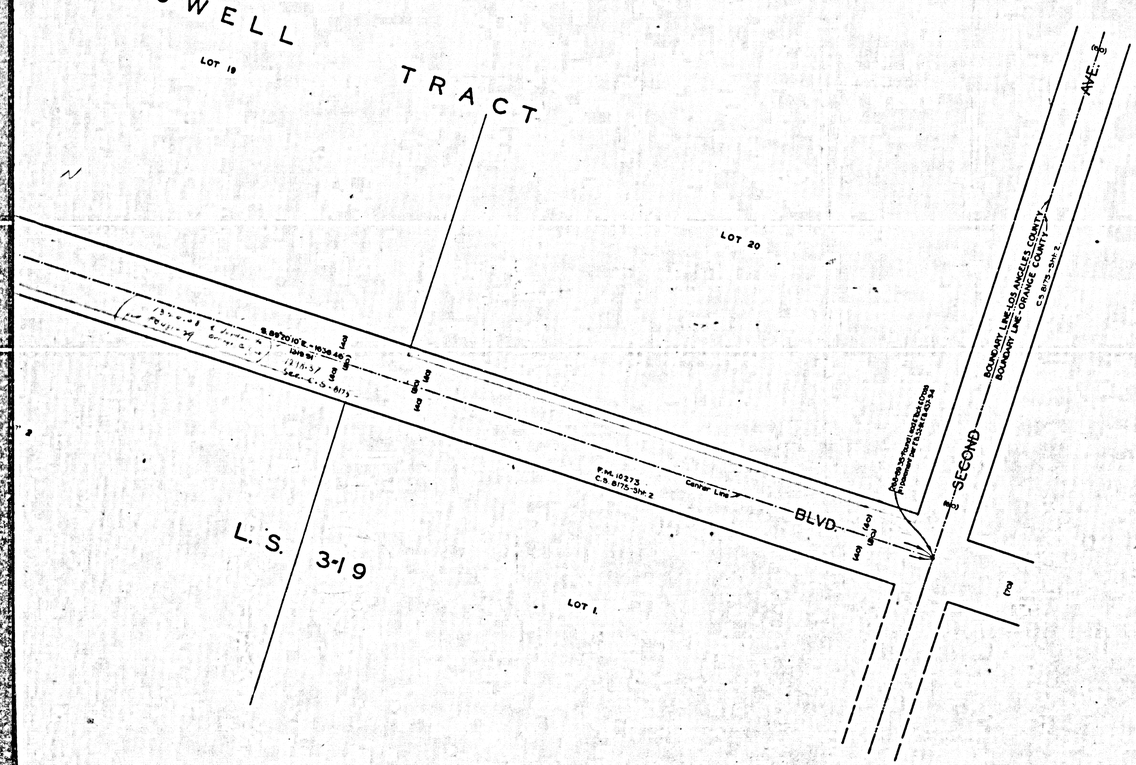


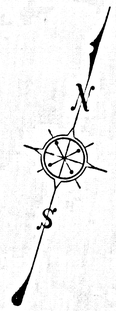

FLORENCE AVENUE
~~LITTLE LAKE ROAD~~
MAP OF
FROM
SANTA GERTRUDES AVE.
TO
WHITTIER BOULEVARD

COUNTY SURVEYORS MAP Nº B-536

SHEET NO 4 OF 5 SHEETS

SCALE:- 1 INCH = 50 FT.

WORK ORDER NO 966

J.E. ROCKHOLD COUNTY SURVEYOR

SURVEYED FEB. 1930 TO MAR 1931.

SURVEYED UNDER INSTRUCTIONS OF THE BOARD OF SUPERVISORS PER ORDER DATED SEPT. 16 1929

BEARINGS ARE BASED ON THE BEARING OF LITTLE LAKE ROAD PER C.S. 8222

F.B. 437-37, 41, 80-90, 94-96, 225-244.

FIELD WORK BY..... P.W. ATKINS.

..... J.D. PRICE.

OFFICE WORK BY.. R.W. McALLISTER.

..... A.E. SVENSON.

CHECKED BY..... A.A. ROESER.

Sept 34

The location of ~~intersecting street~~ Florence Ave. as shown on this ~~statement~~ sketch is in the Regional Plan of Highways, July 15th 1936. See minutes of Regional Planning Commission.

Florence Ave., as proposed on this sheet, is not included in Master Plan of Highways as adopted February 17, 1940.

Revised, Sept. 19, 1940 - H. D. Pinion

CSB-536-4
A1 OF A4

BLOCK A OF THE LOWELL TRACT

M.R. 54-17

WHITTIER BLVD

WHITTIER AVE

FLORENCE AVE

LITTLE LAKE RD

FIRST ST

JORDAN ROAD

DELETED FROM MASTER PLAN - 1910

L. S. 3-19

LOT 22

LOT 4

LOT 17

LOT 18

LOT 19

LOT 3

LOT 2

LOT L

CSB-536-4
A2 OF A4



















































from Continued on CS B-536-SH 3

CSB-536-3

N 71°51'05" E - 1249.19'

DELETED FROM MASTER PLAN - 1940

SANTA GERTRUDES

SANTA FE

S 89°58'45" E 1185.98'

1149.98'

LOS ANGELES & SALT LAKE

LEFFINGWELL ROAD

VAC. D 28-220

R.R. R/W.

VIRGINIA

S 89°58'45" E 1181.89'

Center Line

ST.

CSB-536-4
A4 OF A4