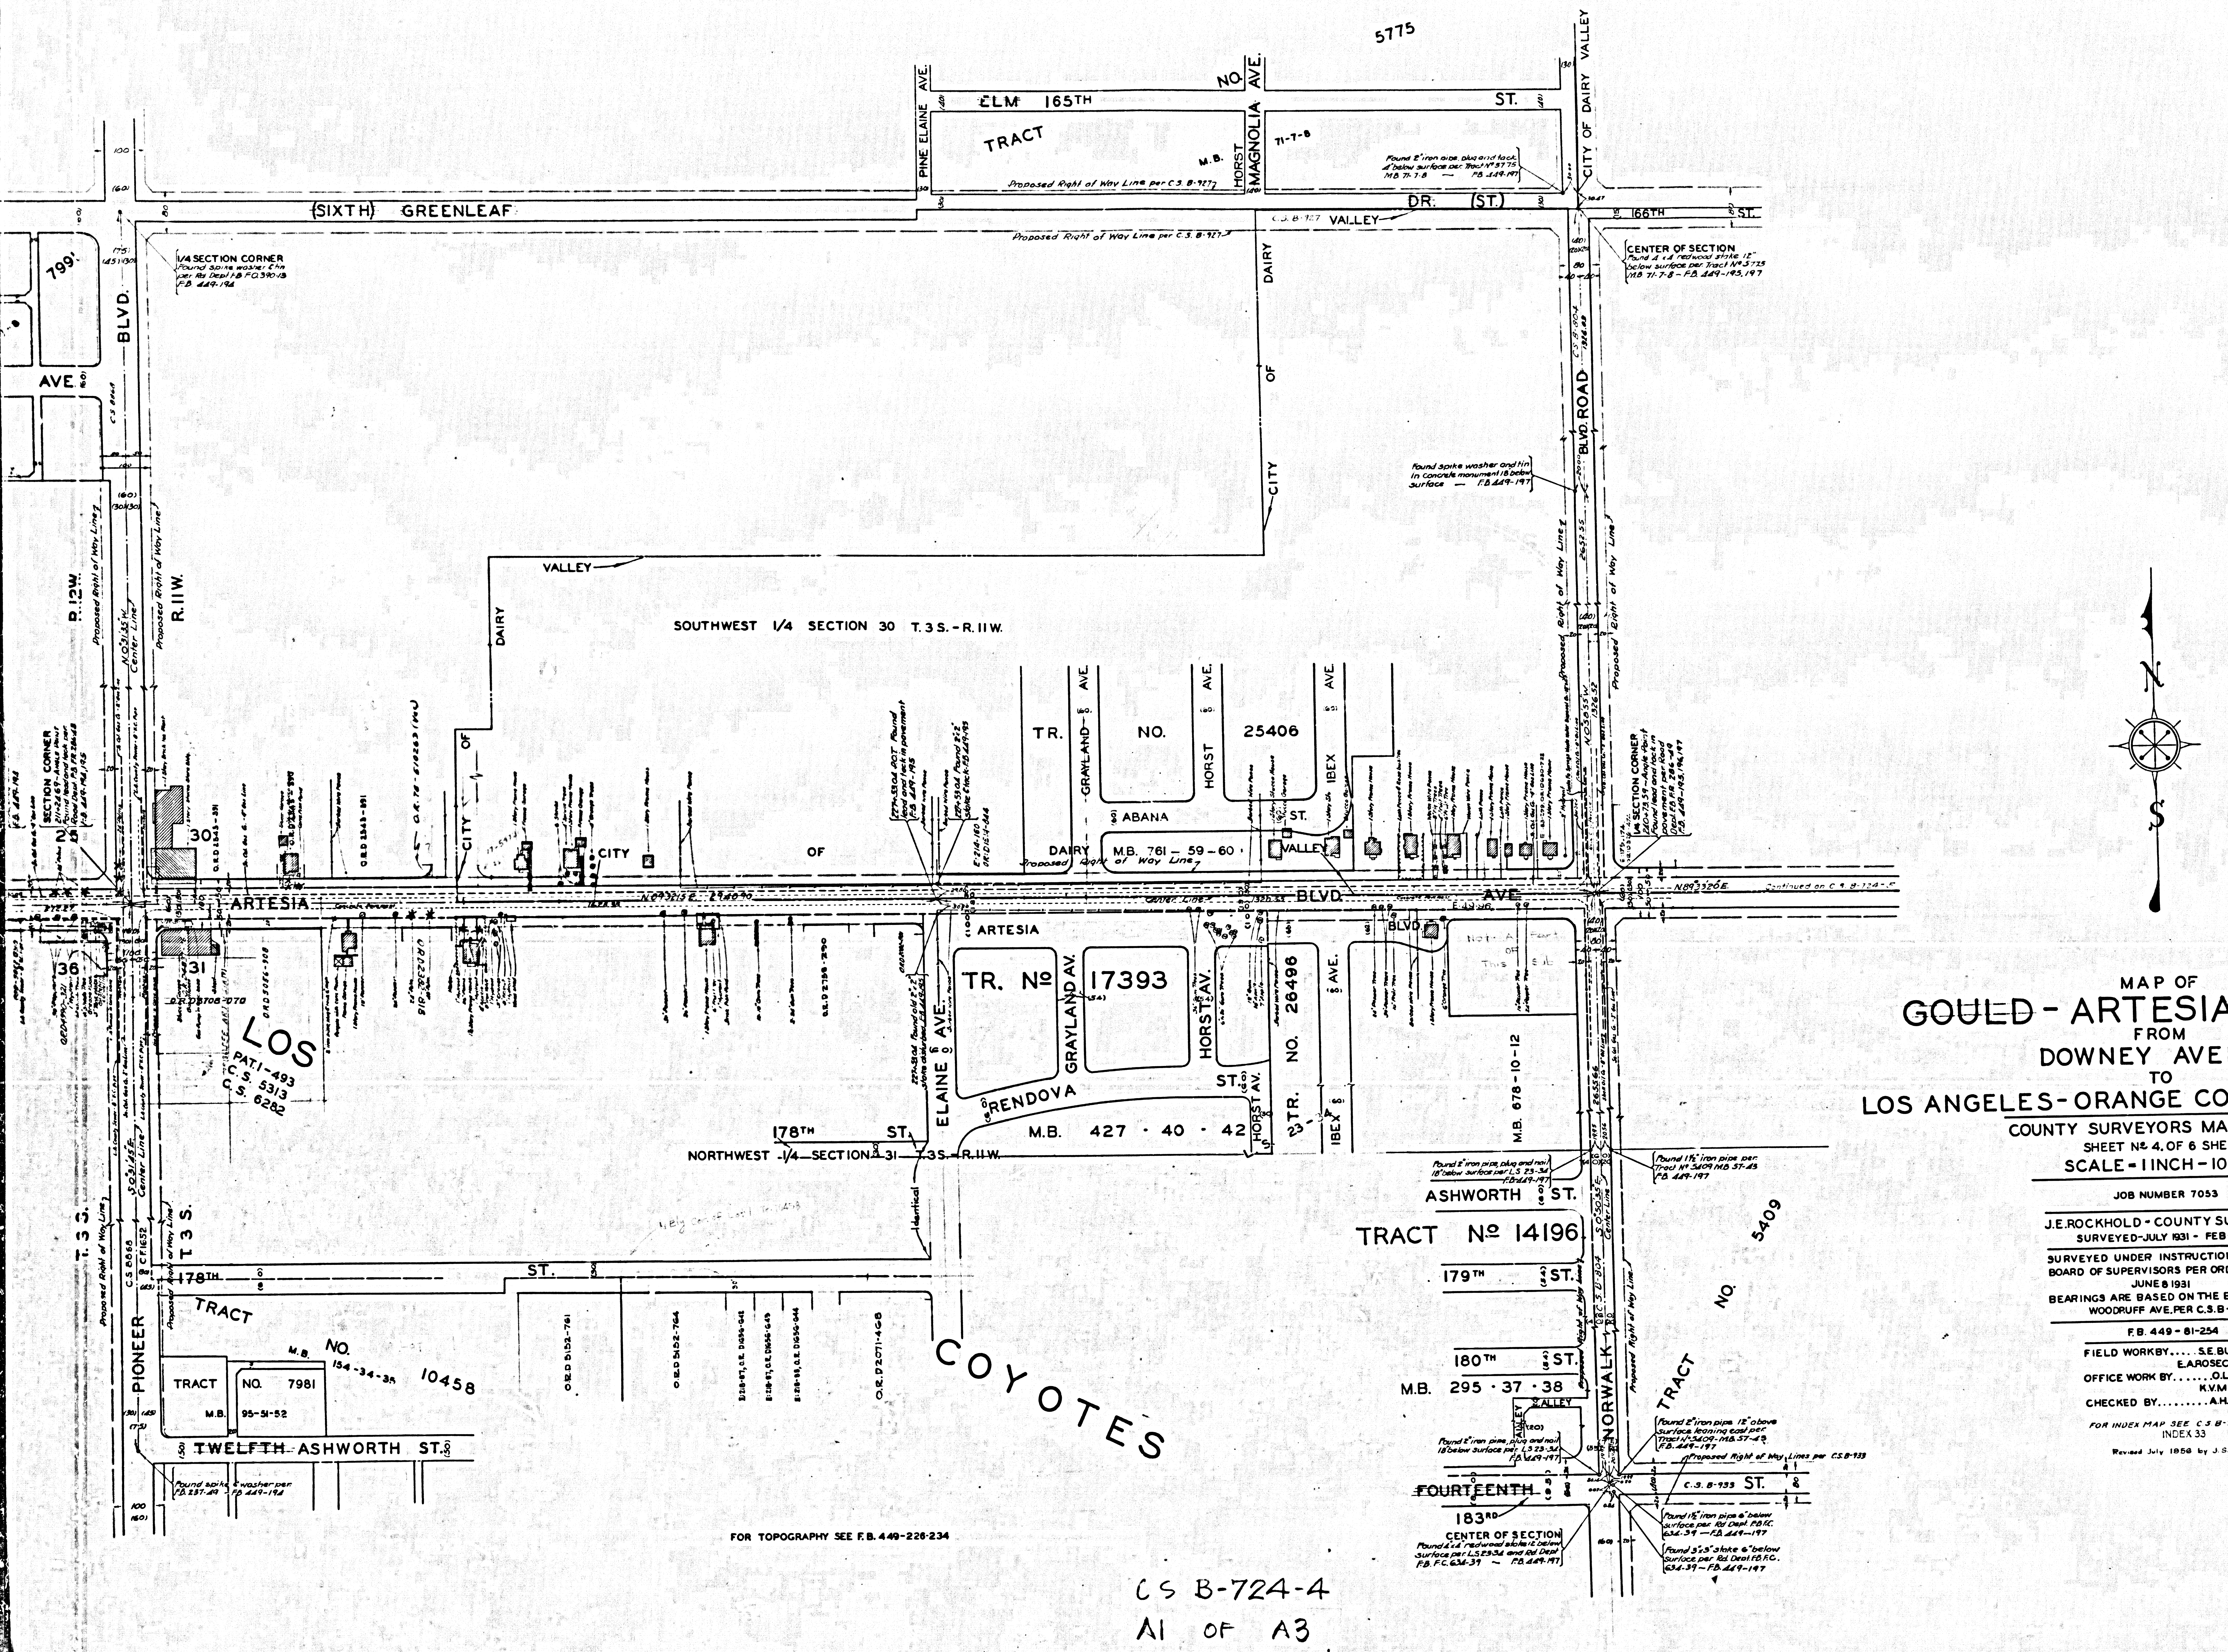

MAP OF

~~GOULD~~ - ARTESIA ~~AVENUE~~ BLVD.

FROM

DOWNEY AVENUE

TO

LOS ANGELES - ORANGE COUNTY BOUNDARY

COUNTY SURVEYORS MAP No B-724.
SHEET No 4. OF 6 SHEETS.
SCALE - 1 INCH - 100 FT.

JOB NUMBER 7053

J.E. ROCKHOLD - COUNTY SURVEYOR
SURVEYED - JULY 1931 - FEB. 1932.

SURVEYED UNDER INSTRUCTIONS OF THE BOARD OF SUPERVISORS PER ORDER DATED JUNE 8 1931
BEARINGS ARE BASED ON THE BEARING OF WOODRUFF AVE. PER C.S. B-315-4.

F.B. 449-81-254

FIELD WORK BY..... S.E. BUTLER.
E.A. ROSECRANS.
OFFICE WORK BY....... O.L. PACK.
K.V. MORIN.
CHECKED BY......... A.H. DREW.

FOR INDEX MAP SEE C.S. B-724-1
INDEX 33

Revised July 1956 by J.S.H.

CS B-724-4
A1 OF A3

CS B-724-4
A2 of A3

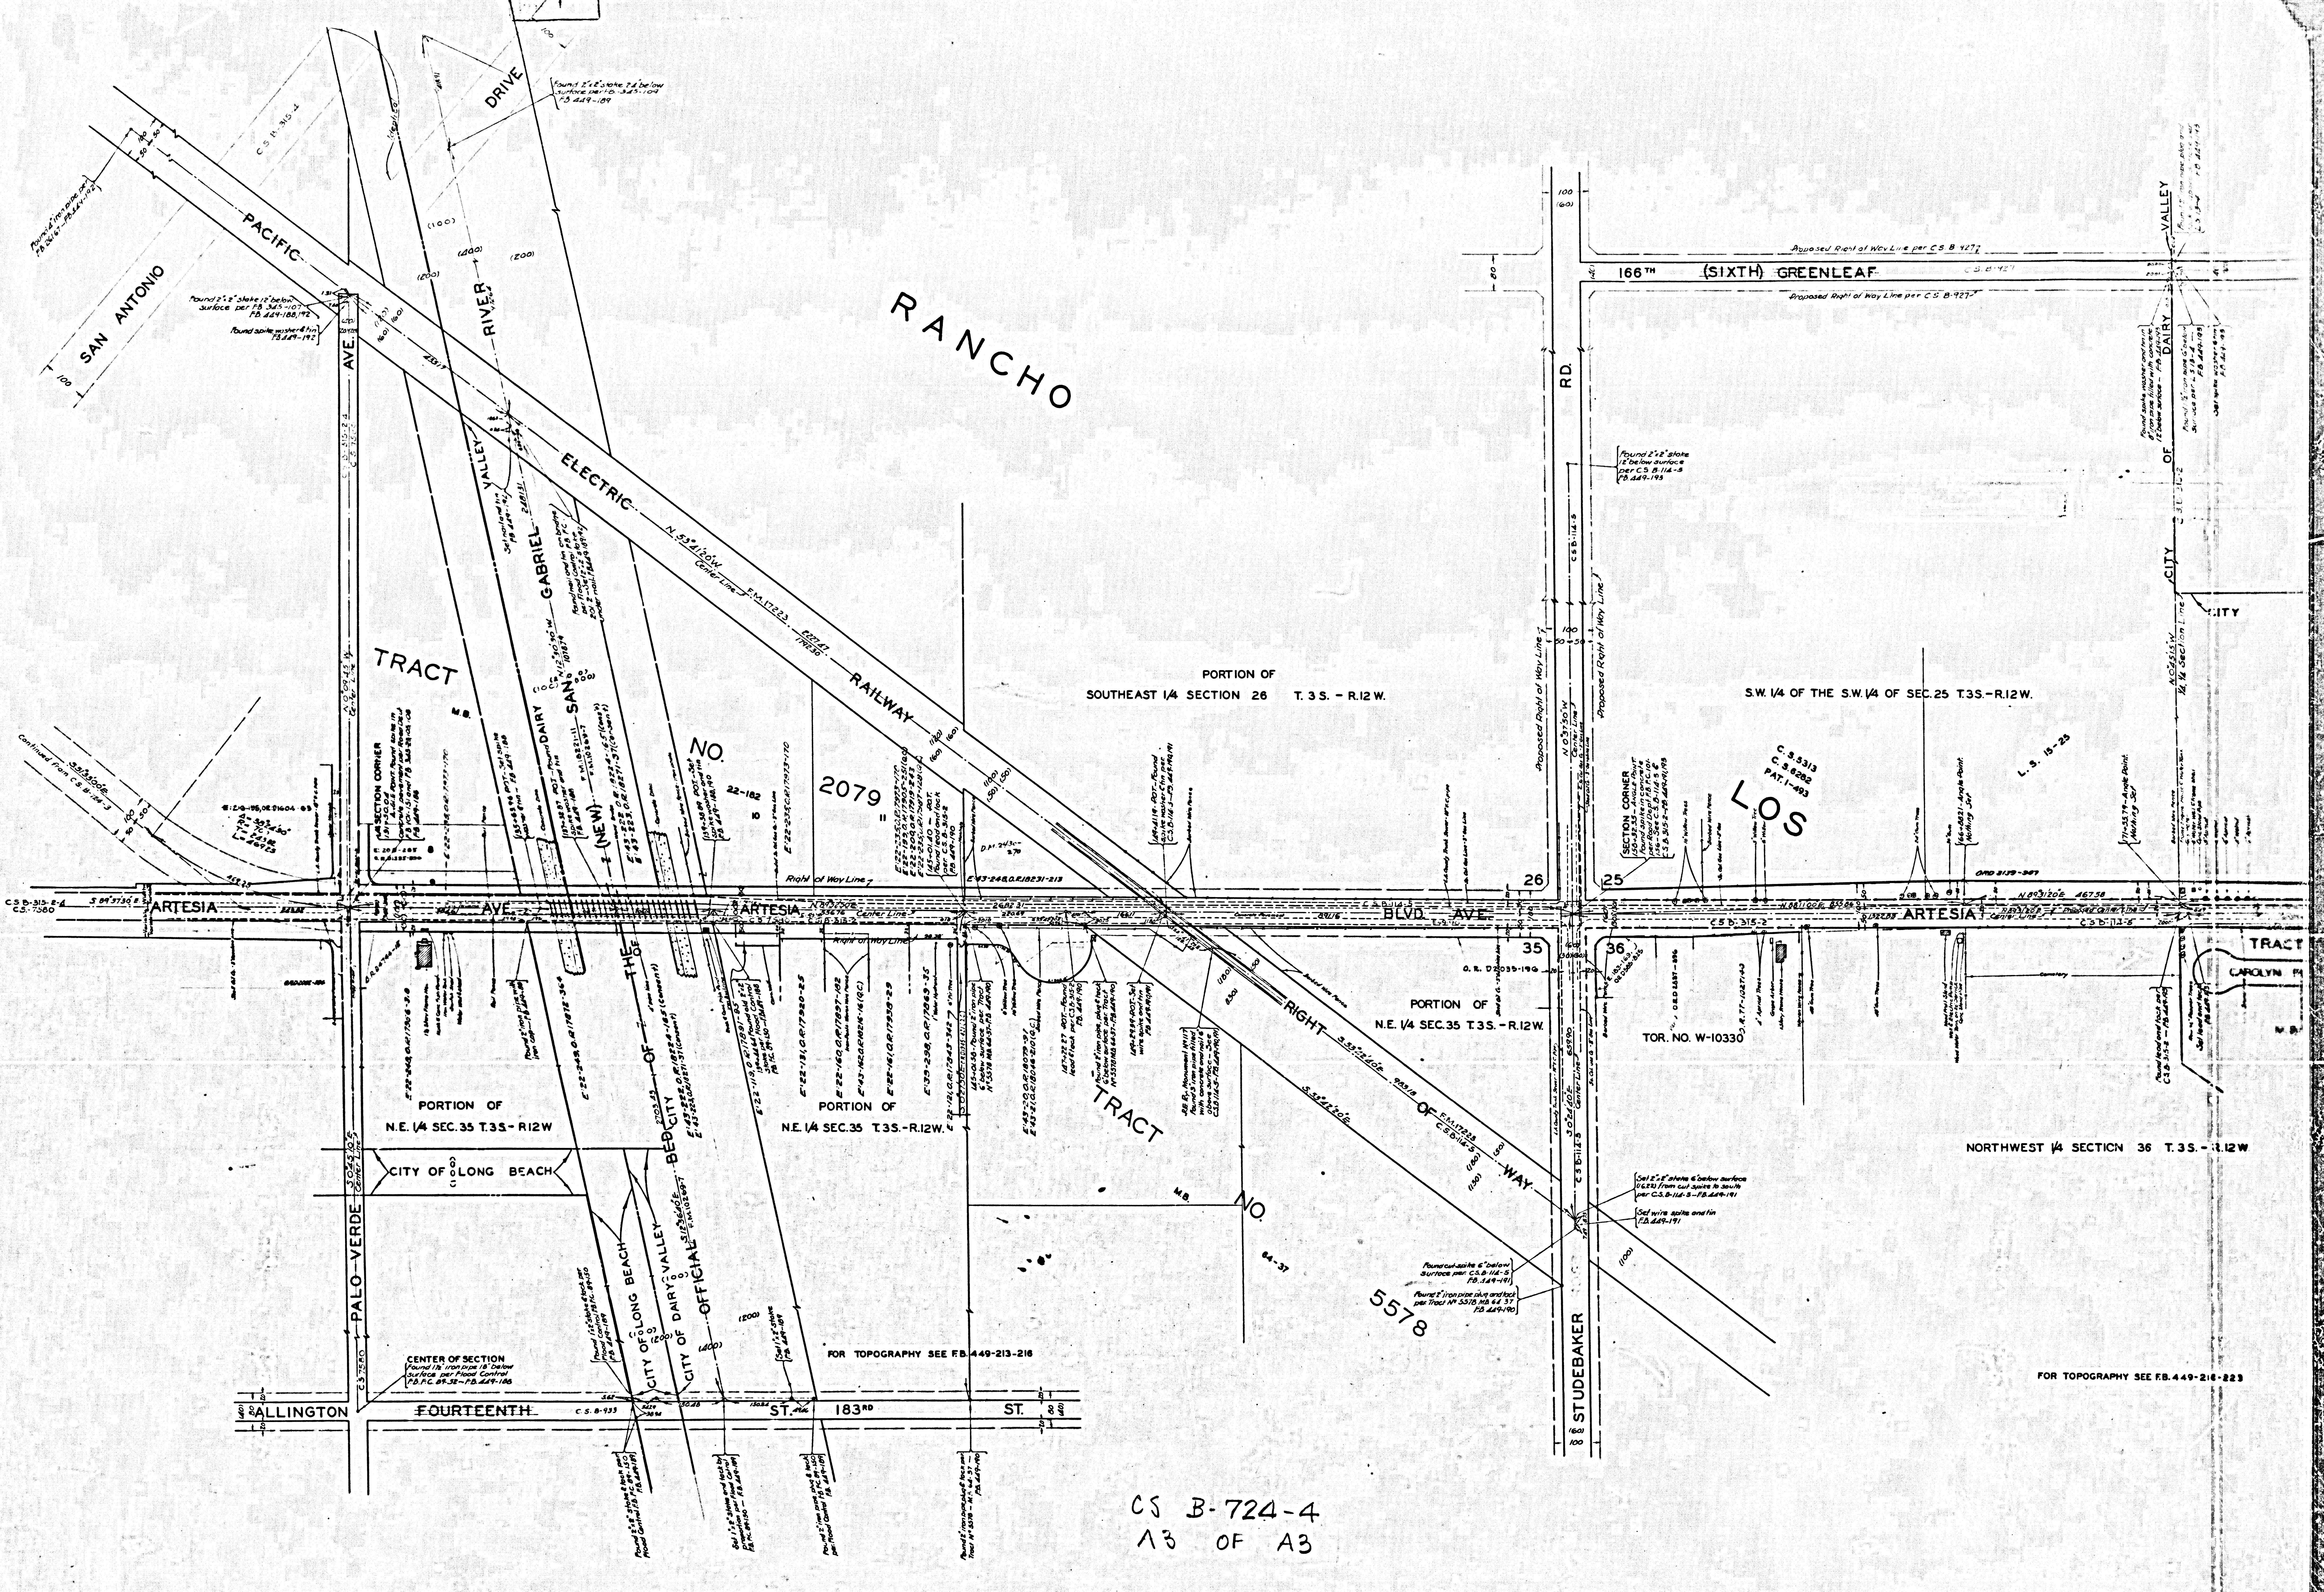

CS B-724-4
A3 OF A3