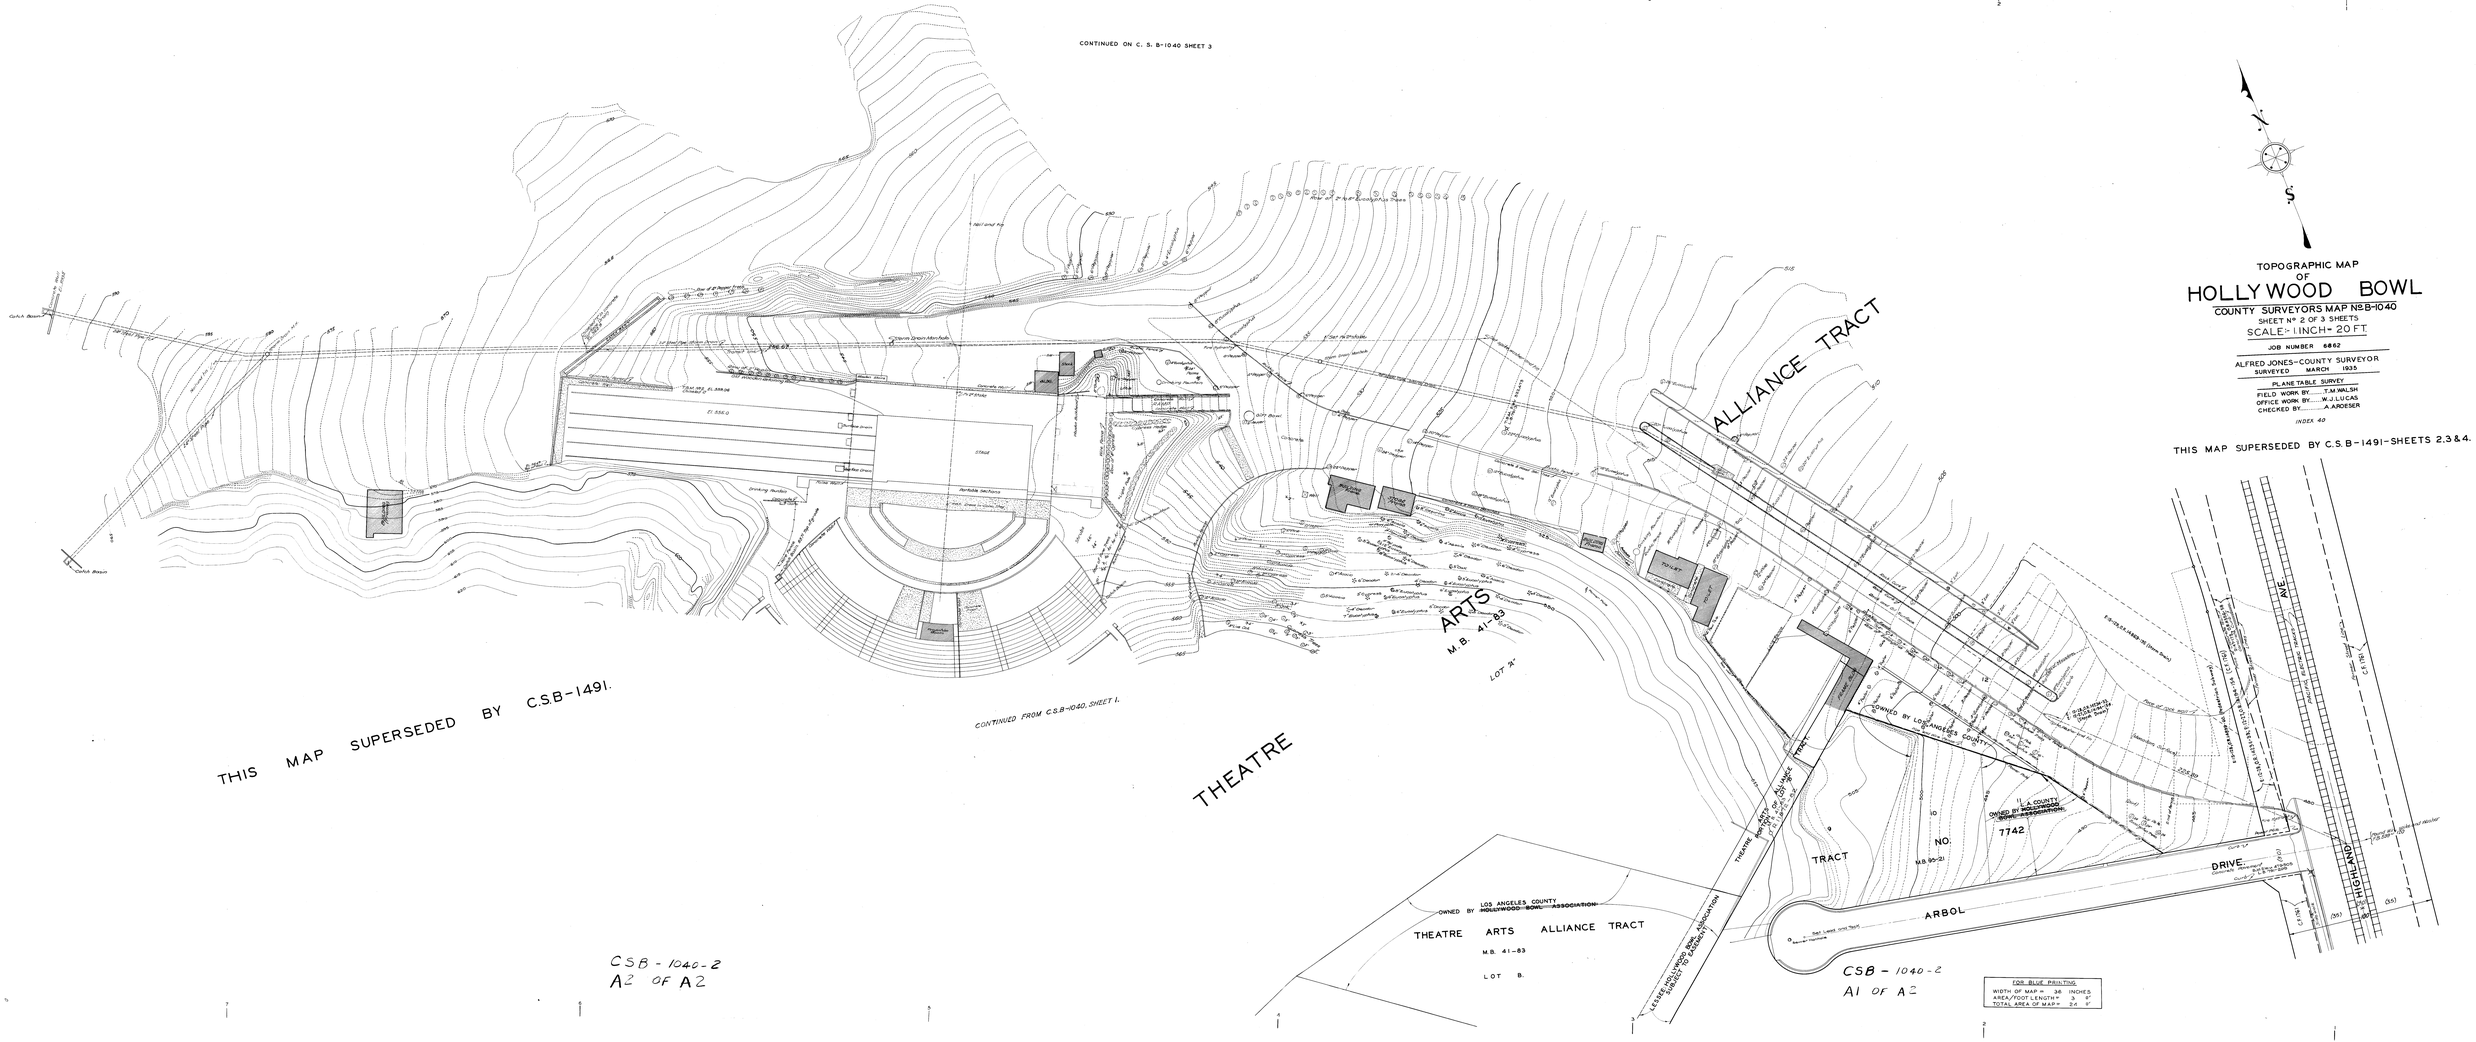
CONTINUED ON C. S. B-1040 SHEET 3
TOPOGRAPHIC MAP
OF
HOLLYWOOD BOWL
COUNTY SURVEYORS MAP No. B-1040
SHEET No. 2 OF 3 SHEETS
SCALE: 1 INCH = 20 FT
JOB NUMBER 6862
ALFRED JONES-COUNTY SURVEYOR
SURVEYED MARCH 1935
PLANE TABLE SURVEY
FIELD WORK BY T.M. WALSH
OFFICE WORK BY W.J. LUCAS
CHECKED BY A. ROESER
INDEX 40
THIS MAP SUPERSEDED BY C.S.B-1491-SHEETS 2,3 & 4.
THIS MAP SUPERSEDED BY C.S.B-1491.
CONTINUED FROM C.S.B-1040, SHEET 1.
THEATRE ARTS ALLIANCE TRACT
M.B. 41-83
LOT "A"
THEATRE
OWNED BY LOS ANGELES COUNTY
~~HOLLYWOOD BOWL ASSOCIATION~~
THEATRE ARTS ALLIANCE TRACT
M.B. 41-83
LOT B.
LEASE HOLLYWOOD BOWL ASSOCIATION
COUNTY OF LOS ANGELES
ALLIANCE TRACT
OWNED BY LOS ANGELES COUNTY
L.A. COUNTY
OWNED BY ~~HOLLYWOOD BOWL ASSOCIATION~~
TRACT NO. 7742
M.B. 85-21
ARBOL DRIVE
HIGHLAND AVE
CSB-1040-2
A2 OF A2
CSB-1040-2
A1 OF A2
FOR BLUE PRINTING
WIDTH OF MAP = 36 INCHES
AREA/FOOT LENGTH = 3 8'
TOTAL AREA OF MAP = 24 9'