

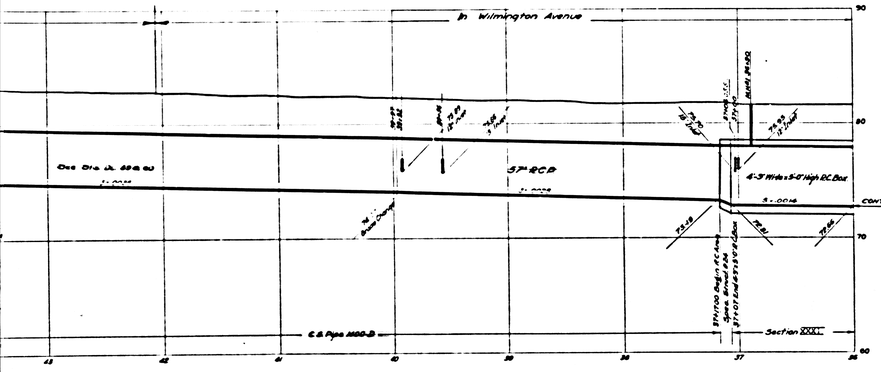


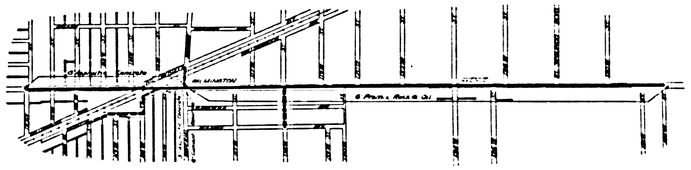

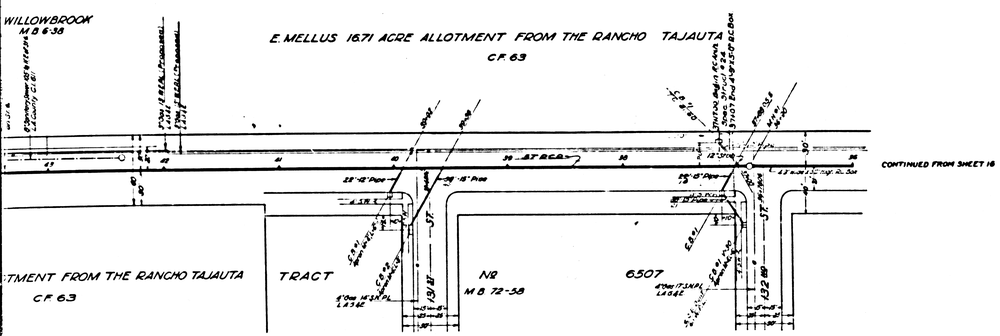

INDEX

Lines Shown on this Sheet
Reading From Left to Right

PLAN AND PROFILE
WILMINGTON AVENUE LINE

KEY MAP
SHOWING DRAINS AND RESURFACING

NOTES:

Elevations are in feet above U.S.G.S. or mea Sea Level Datum.

Stations of inlets and junctions refer to the intersections of the center lines of the inlets with the center line of the main drain.

Elevations of all inlets except catch basin inlets into box sections refer to the flow lines of the inlets produced on their gradients to the vertical plane thru the center line of the main drain. Elevations of catch basin inlets into box sections refer to the intersections of the flow lines of these inlets with the inside wall of the box sections.

For details of all standard structures see Standard Plans.

All pipe not otherwise specified shall be plain cement pipe.

All stubs to be one length of pipe with ends sealed with 2" redwood planking, unless otherwise specified.

Catch basins shall be built with a curb face of 10" or more which shall include a minimum depression at opening of 4" below gutter grade, unless otherwise specified.

Sanitary sewers crossing storm drains, shown in profile with less than 1½ feet clearance, are to be encased as per Std 6 for a length equal to the width of conduit trench. In addition if less than ½ Ft. clearance sewers must be of cast iron pipe and encased as noted above.

Connector Pipes in Box Sections shall be laid in conjunction with Junction Structures MH (Standard D.35) unless otherwise directed by the Construction Engineer

Corrected as Constructed

September 1941
A.T. Fiander

GLEN AVENUE DRAINAGE SYSTEM

OF THE COUNTY OF LOS ANGELES, CALIFORNIA
PLAN AND PROFILE OF

WILMINGTON AVE. LINE

STA. 1120+43 TO STA. 36+00

SHEET 15 OF 26 SHEETS

SCALE 100' = 1" H
40' = 1" V

NOVEMBER 1935

ALFRED JONES COUNTY SURVEYOR

RECOMMENDED [signature] APPROVED [signature]

REFERENCE		DESIGNED	J.L. Partin	MAR. 1932
F.B.	496			
L.B.	681	TRACED	Messenger & O.R. Henderson	JUNE 1934
	Records Oct 1" = 20ft Dec 60" = 20ft Aug 84" = 20ft.	CHECKED	E.E. Mitchell	JULY 1934

CSB-1171-15

(15)

A1 OF A8

Trim Prints to this line

In Wilmington Avenue

ST.

117 th

118 th

119 th

120 th

51" R.C.P.

SUBSTITUTE

4'-6" x 4'-0" R.C. ARCH

51"R.C.P.

SUBSTITUTE 4'-6"x4'-6" R.C. ARCH 54"R.C.P.

C.S. Pipe 1400-D

E MMABILA 538.28 ACRE ALLOTMENT FROM THE RANCHO TAJAUTA C.F. 63

ROSCOE

TRACT

M.B. 9-59

SPRINGDALE

M.B. 6-194

GATE

M.B. 13-14,15

SOUTH

GEORGE

AVENUE LINE

CSB-1171-15
A5 OF A8

Unit #2 — Unit #1

In Wilmington Ave.

114TH ST.

117TH ST.

IMPERIAL HIGHWAY

33° R.C.P.

48" R.C.P.

SUBSTITUTE 45°-14'-10" R.C.ARCH

51" R.C.P.

SUBSTITUTE 46'-4" R.C.ARCH

C.S. Pipe 1800-D

Cradle 2/6" as per Dr-54

Cradle 30" per Dr-54

Changes to fit Pipe as laid in Ground

JOSE MABILA 538.28 ACRE ALLOTMENT FROM THE RANCHO TAJAUTA C.F. 63

TRACT

WILLOWBROOK AVE.

ALLEY

114TH ST.

R/W

PACIFIC ELECTRIC R/W

MONITOR AVE.

DUNBAR ALLEY

IMPERIAL HIGHWAY

PARK

ROSCOE ST.

MB 9-59


MB 26-59


SOUTH GATE TRACT MB 13-14,15

WILMINGTON AVENUE LINE

CSB-1171-15


A6 OF A8

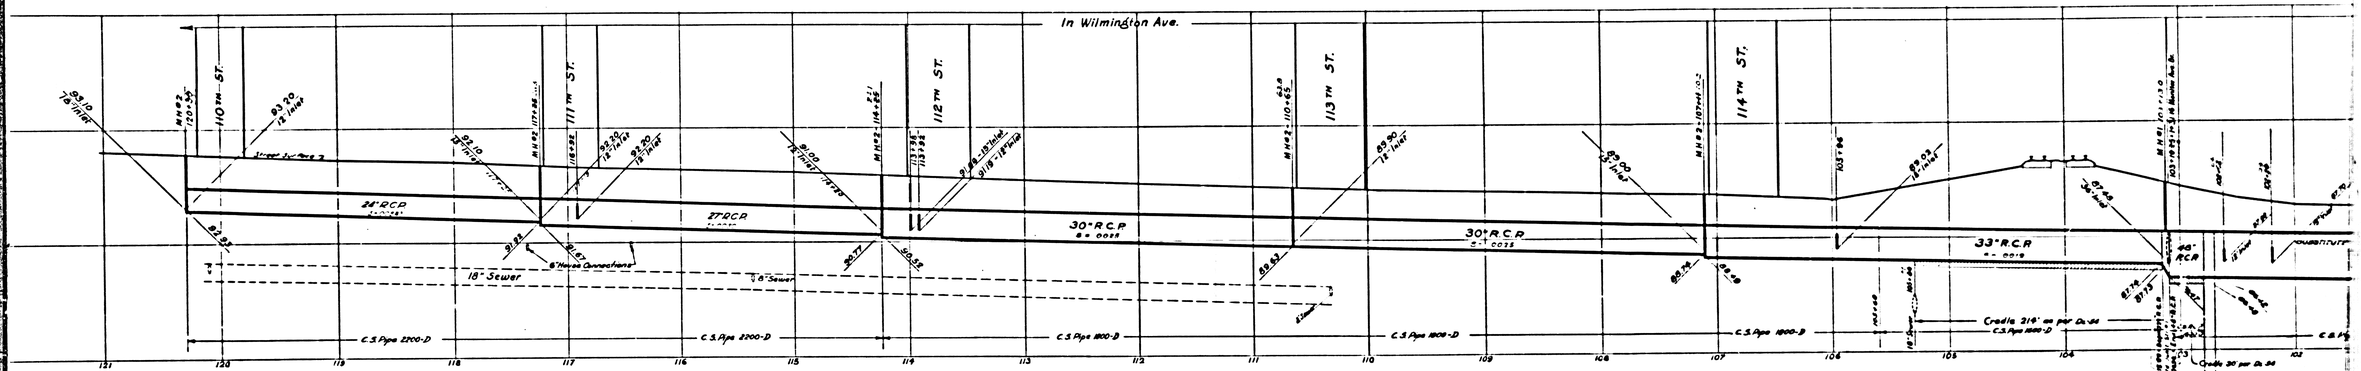

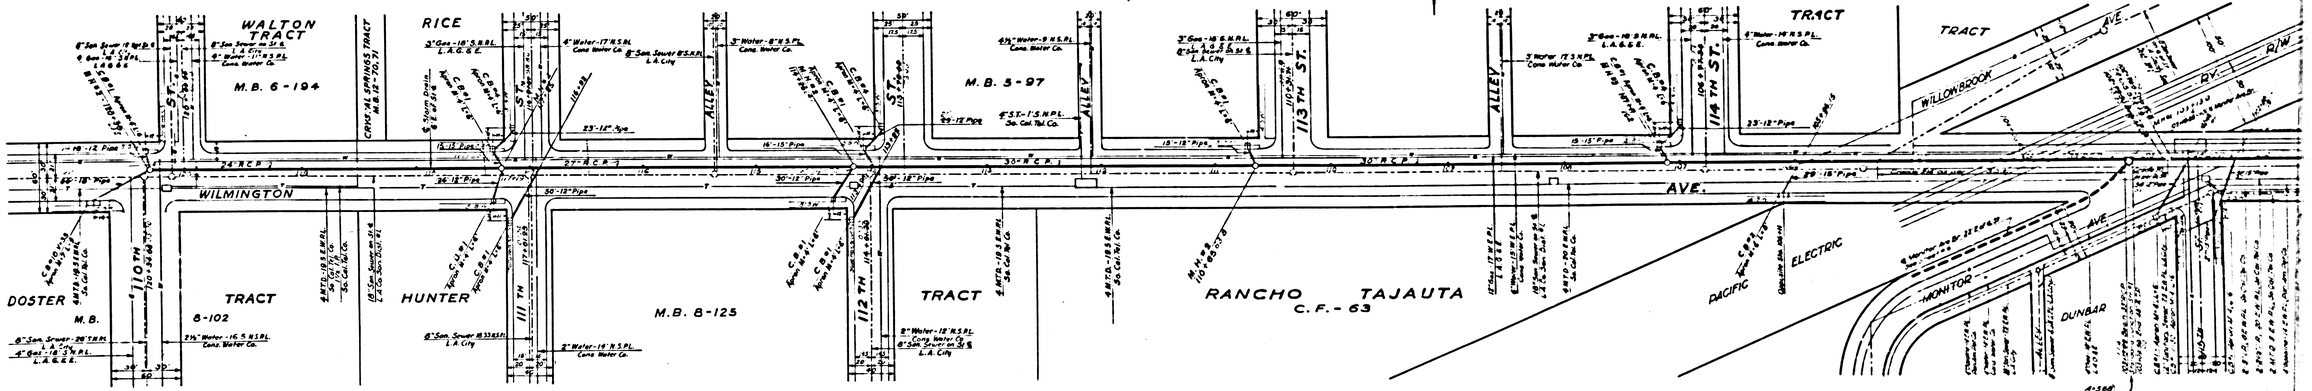


CSB-1171-15
A7 OF A8

Trim Prints to this line

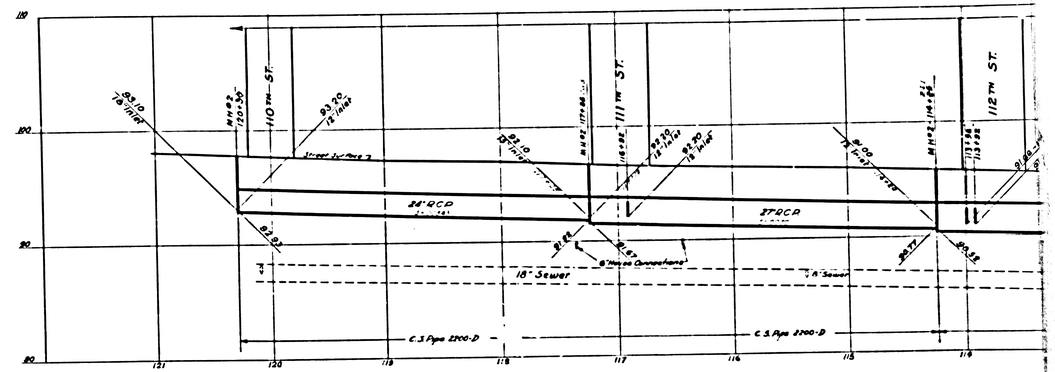



INDEX
Lines Shown on this Sheet
Reading from Left to Right
PLAN AND PROFILE
WILMINGTON AVENUE LINE.

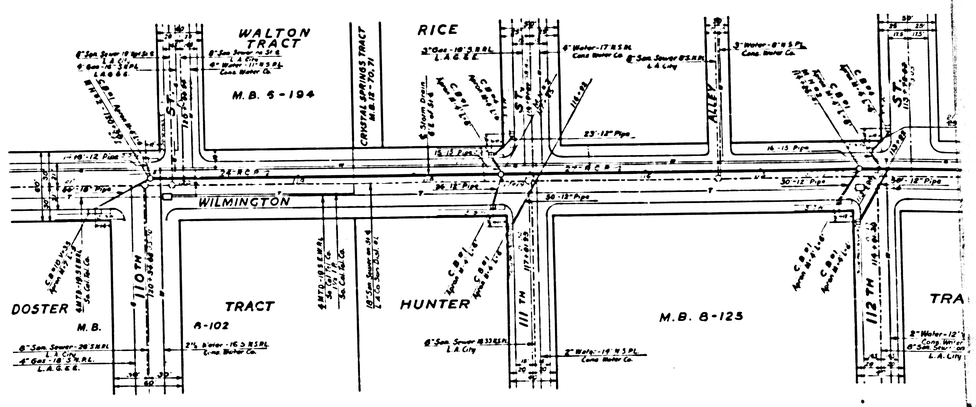


CSB-1171-15
A8 OF A8

Trim Prints to this line

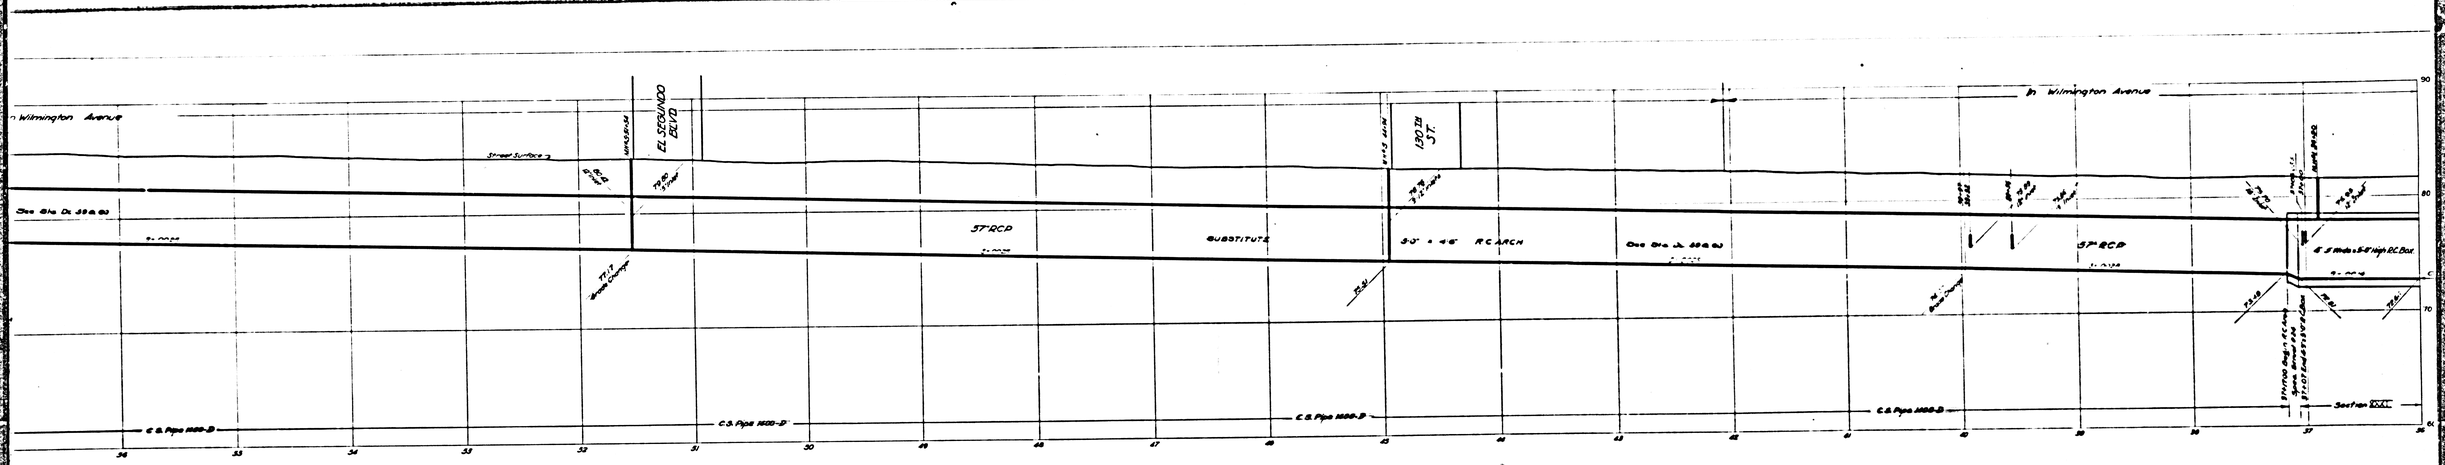

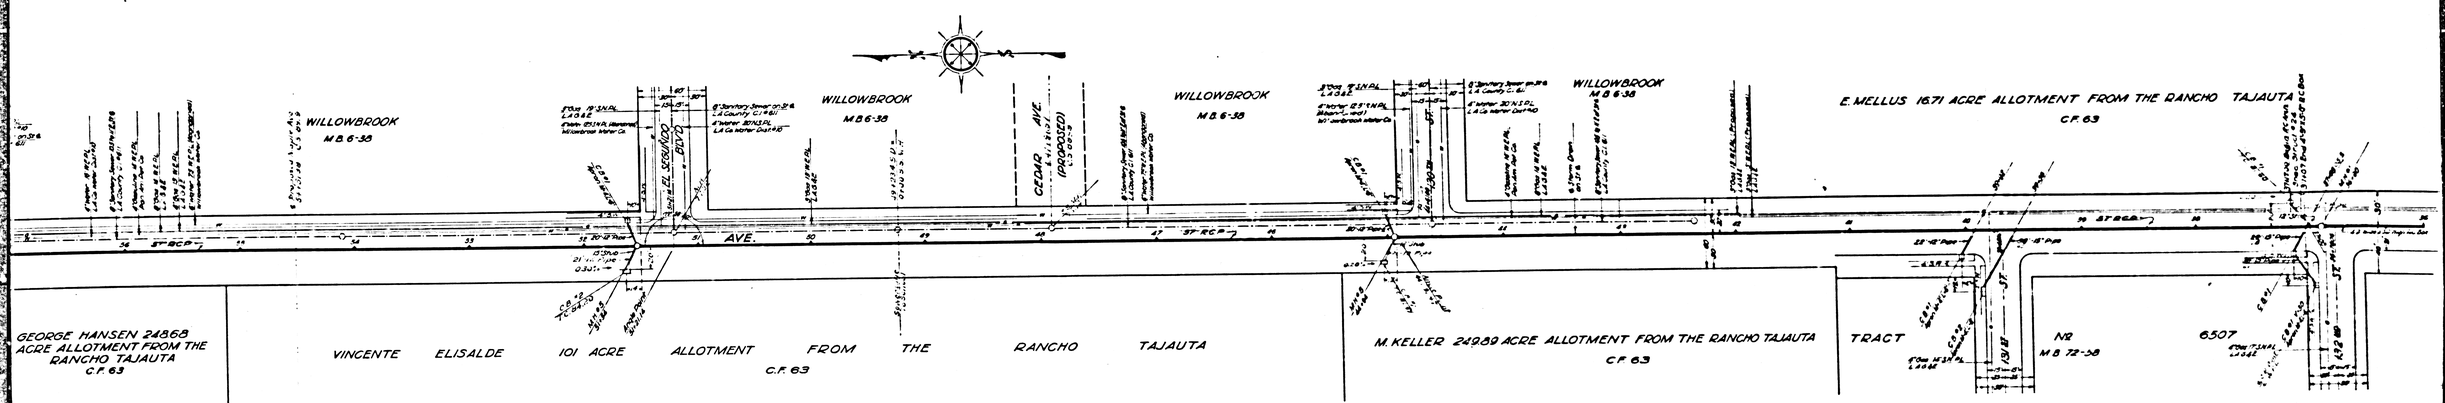

CSB-1171-15
A2 OF A8

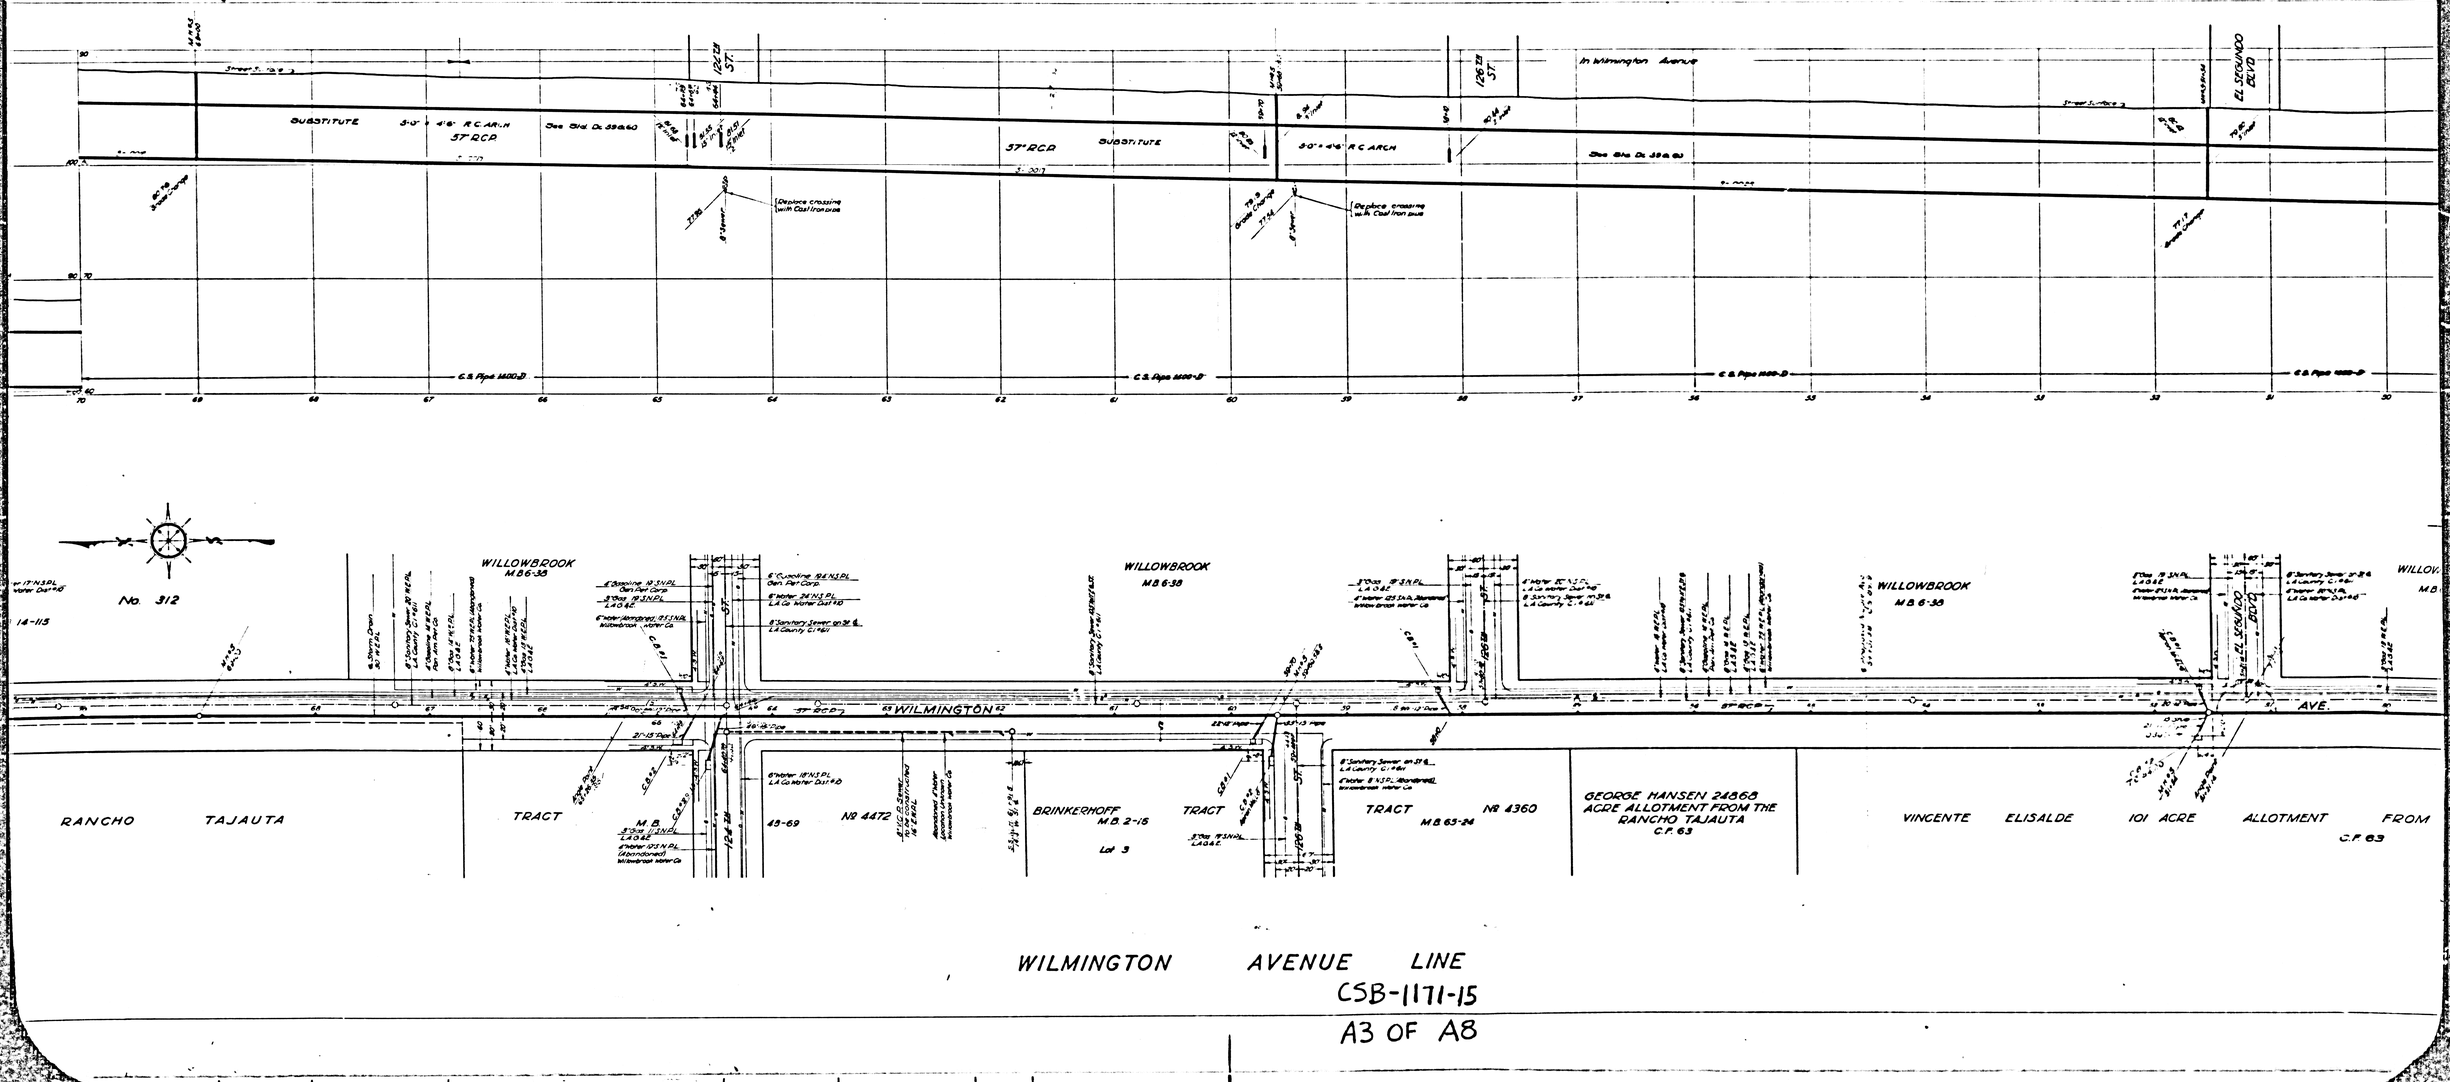

WILMINGTON AVENUE LINE

CSB-1171-15

A3 OF A8

(Partly in Wilmington Avenue)
(Partly in right of way)

ST.
119.88
ST.
120.00
ST.
122.88
ST.
122.88

Street Surface

SUBSTITUTE 4'-0" x 4'-0" R.C. ARCH
54"RCA
Sta. Elev. D. 498.60
57"RCA
SUBSTITUTE 3'-0" x 4'-6" R.C. ARCH
Sta. Elev. D. 498.60
57"RCP
SUBSTITUTE
57"RCP
Sta. Elev. D. 498.60

C.S. Pipe 1400-B
C.S. Pipe 1400-D
C.S. Pipe 1400-B

TRACT
SPRINGDALE
M.B. 6-194
TRACT
TRACT
M.B. 14-115
No. 312
WILLOWBROOK
M.B. 6-38
TRACT
M.B.
48-69
M.R. 44

GATE
M.B. 13-14.15
TRACT
GEORGE HANSEN 248.68 ACRE ALLOTMENT FROM THE RANCHO TAJAUTA
C.F. 63

6" Sewer Connections to be Constructed See Sheet 13

E-23-187.0 & 187.1-24 (Storm Drain)

CSB-1171-15
A4 OF A8