

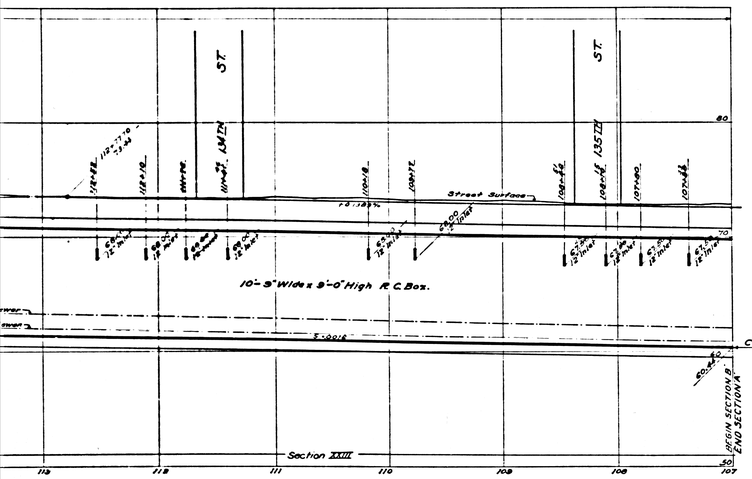


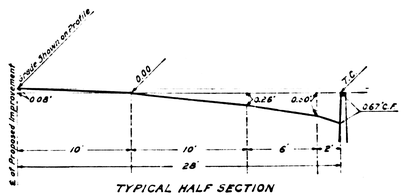


TYPICAL HALF SECTION

Note: Grade and Cross Section for future 60' Street as furnished by the Road Department. November 1937.

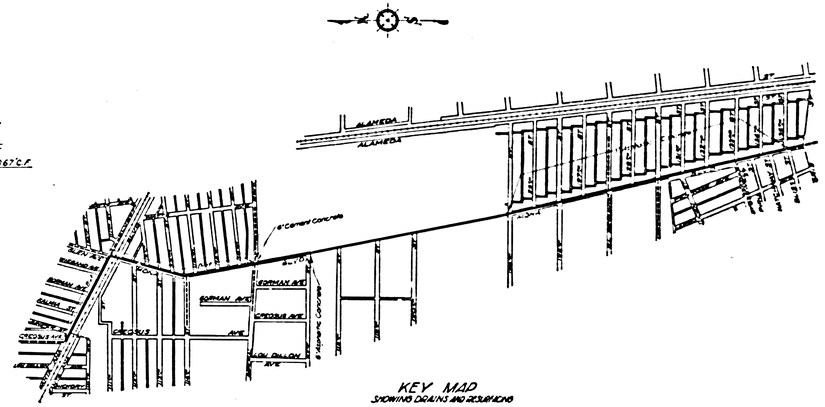

KEY MAP
SHOWING DRAINS AND RESURVEYS

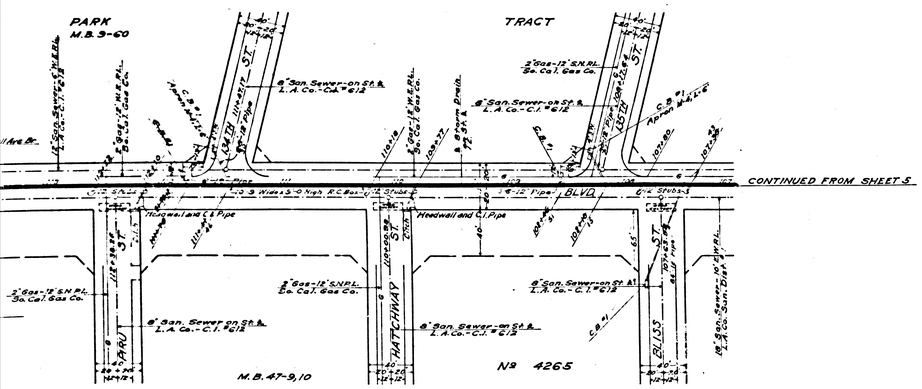

NOTES:

Elevations are in feet above U.S.G.S. or mean Sea Level Datum.

Stations of inlets and junctions refer to the intersections of the center lines of the inlets with the center line of the main drain.

Elevations of all inlets except catch basin inlets into box sections refer to the flow lines of the inlets produced on their gradients to the vertical plane thru the center line of the main drain. Elevations of catch basin inlets into box sections refer to the intersections of the flow lines of these inlets with the inside wall of the box section.

For details of all standard structures see Standard Plans.

All pipe not otherwise specified shall be plain cement pipe.

All stubs to be one length of pipe with ends sealed with 2" redwood planking, unless otherwise specified.

Catch basins shall be built with a curb face of 10" or more which shall include a minimum depression at opening of 8" below gutter grade, unless otherwise specified.

Sanitary sewers crossing storm drains, shown in profile with less than two feet clearance, are to be encased as per C.a-6 for a length equal to the width of conduit trench. In addition if less than 1½ Ft. clearance sewers must be of cast iron pipe and encased as noted above.

Section B Corrected as Constructed — August 1941
Section C " " " " — A.T. Runcard
Section D " " " "
Section E " " " "

GLEN AVENUE DRAINAGE SYSTEM

OF THE COUNTY OF LOS ANGELES, CALIFORNIA

PLAN AND PROFILE OF

GLEN AVE. TRUNK

STA. 214+00 TO STA. 107+00

SHEET 4 OF 26 SHEETS

NOVEMBER 1935

ALFRED JONES — COUNTY SURVEYOR

RECOMMENDED C.E. Chenoweth — APPROVED Alfred Jones

REFERENCE				
F.B.	495	DESIGNED	L.Longacre	JAN. 1932
L.B.	678	TRACED	H.C.Glenn	AUG. 1933
	Revised 11-4-37	CHECKED	E.E.Mitchell	NOV. 1933

(4)

CSB-1171-4
A10FA8

Sht #1

In Right of Way

Street Surface

Ground Surface

7'-9" Wide x 7'-0" High R.C. Box.

S=.0033

Invert 18" Sewer

Section XVII

Section XVIII

Section XIX

BULLIS

LAND

BULLIS

M. R. 3-399

BLVD.

For encroachment see Sheet No 28

No 1410

ROSCOE

M.B.

9-59

TRACT

SPRINGDALE

M. B. 6-194

MONA

CSB-1171-4


A50FA8


Unit #2 — Unit #1


Identical


Identical

CSB-1171-4
A60FA 8

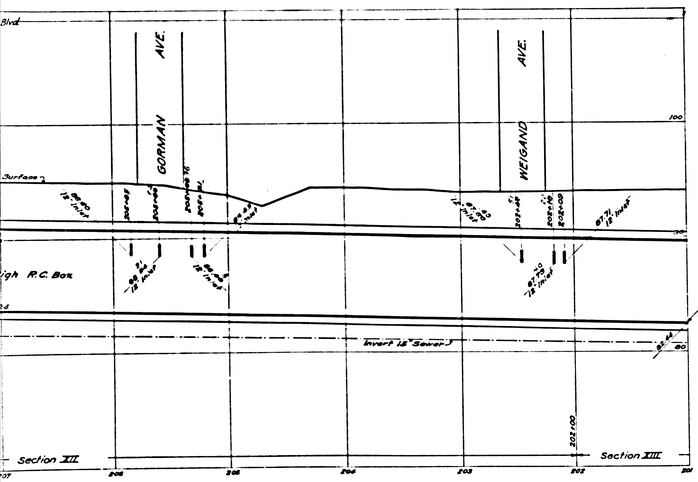

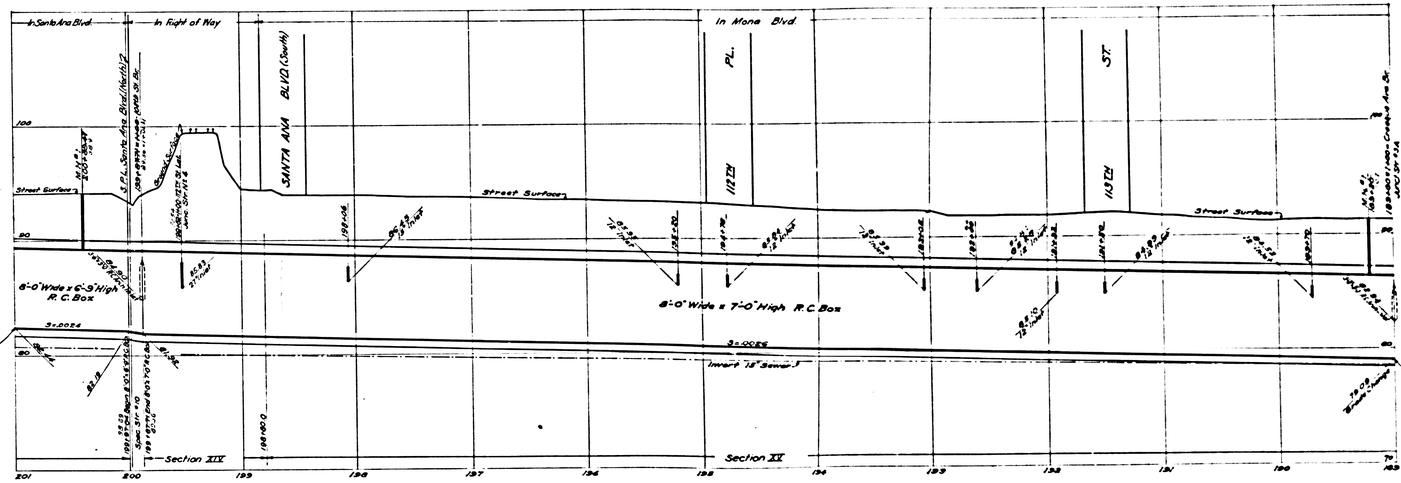


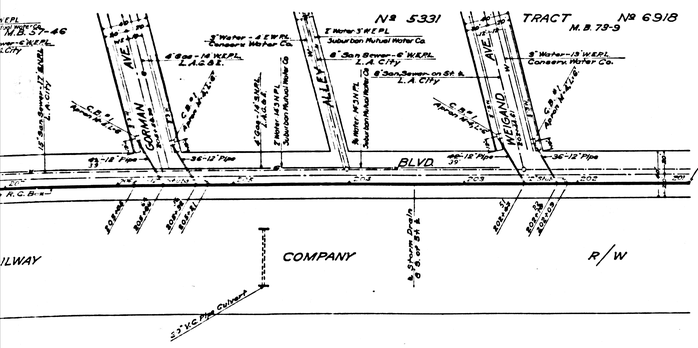

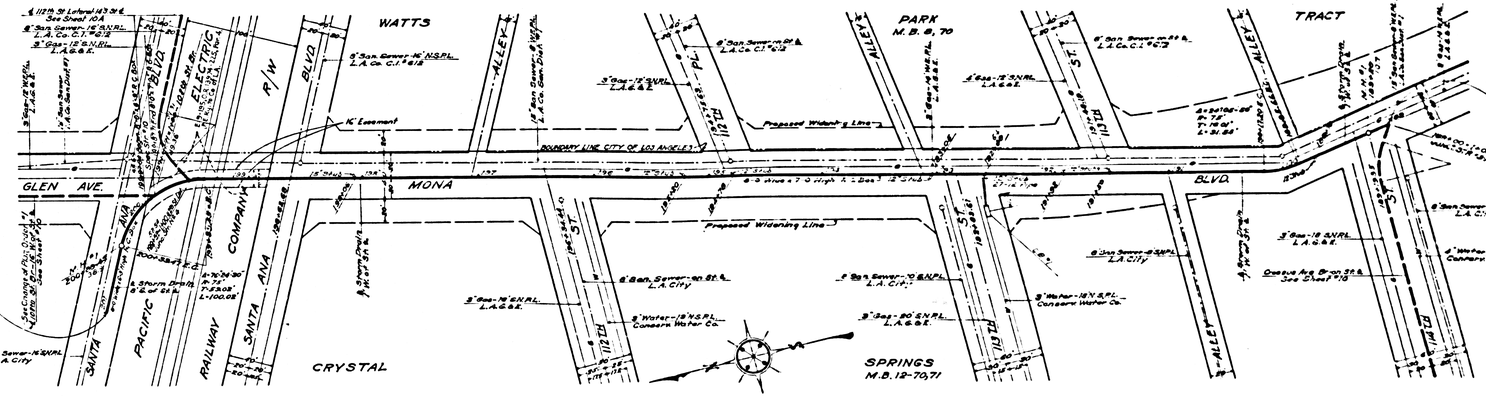

CSB-1171-4
A70FA8

INDEX
Lines Shown on this Sheet
Reading from Left to Right
PLAN AND PROFILE
GLEN AVE. TRUNK

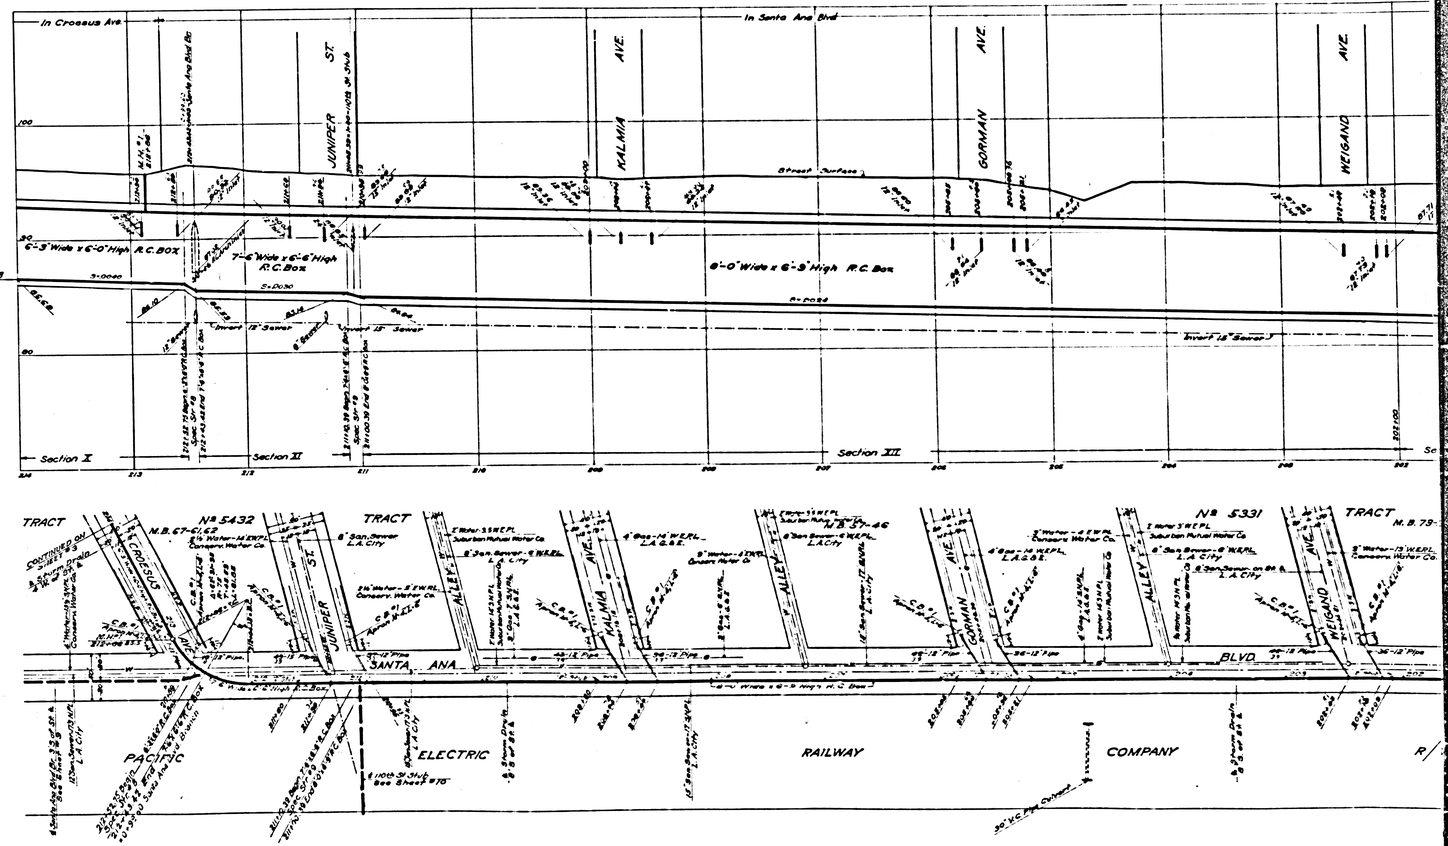

CSB-1171-4
A8 OF A8

Mona Blvd.

3'-6" Wide x 6'-0" High R.C. Box.

Invert 18" Sewer

S=.0015

Section XXII

Section XXIII

Section XXIV

TRACT

LYNWOOD

PARK
M.B. 9-60

MONA BLVD.

PROPOSED 129TH ST.

WILLOWBROOK
M.B. 6-38

EAST

LUCIEN ST.

RICHLAND
M.B. 10-16


TRACT

STOCKWELL AVE.


TRACT


M.B. 47-9, 10


CSB-1171-4
A20FA8

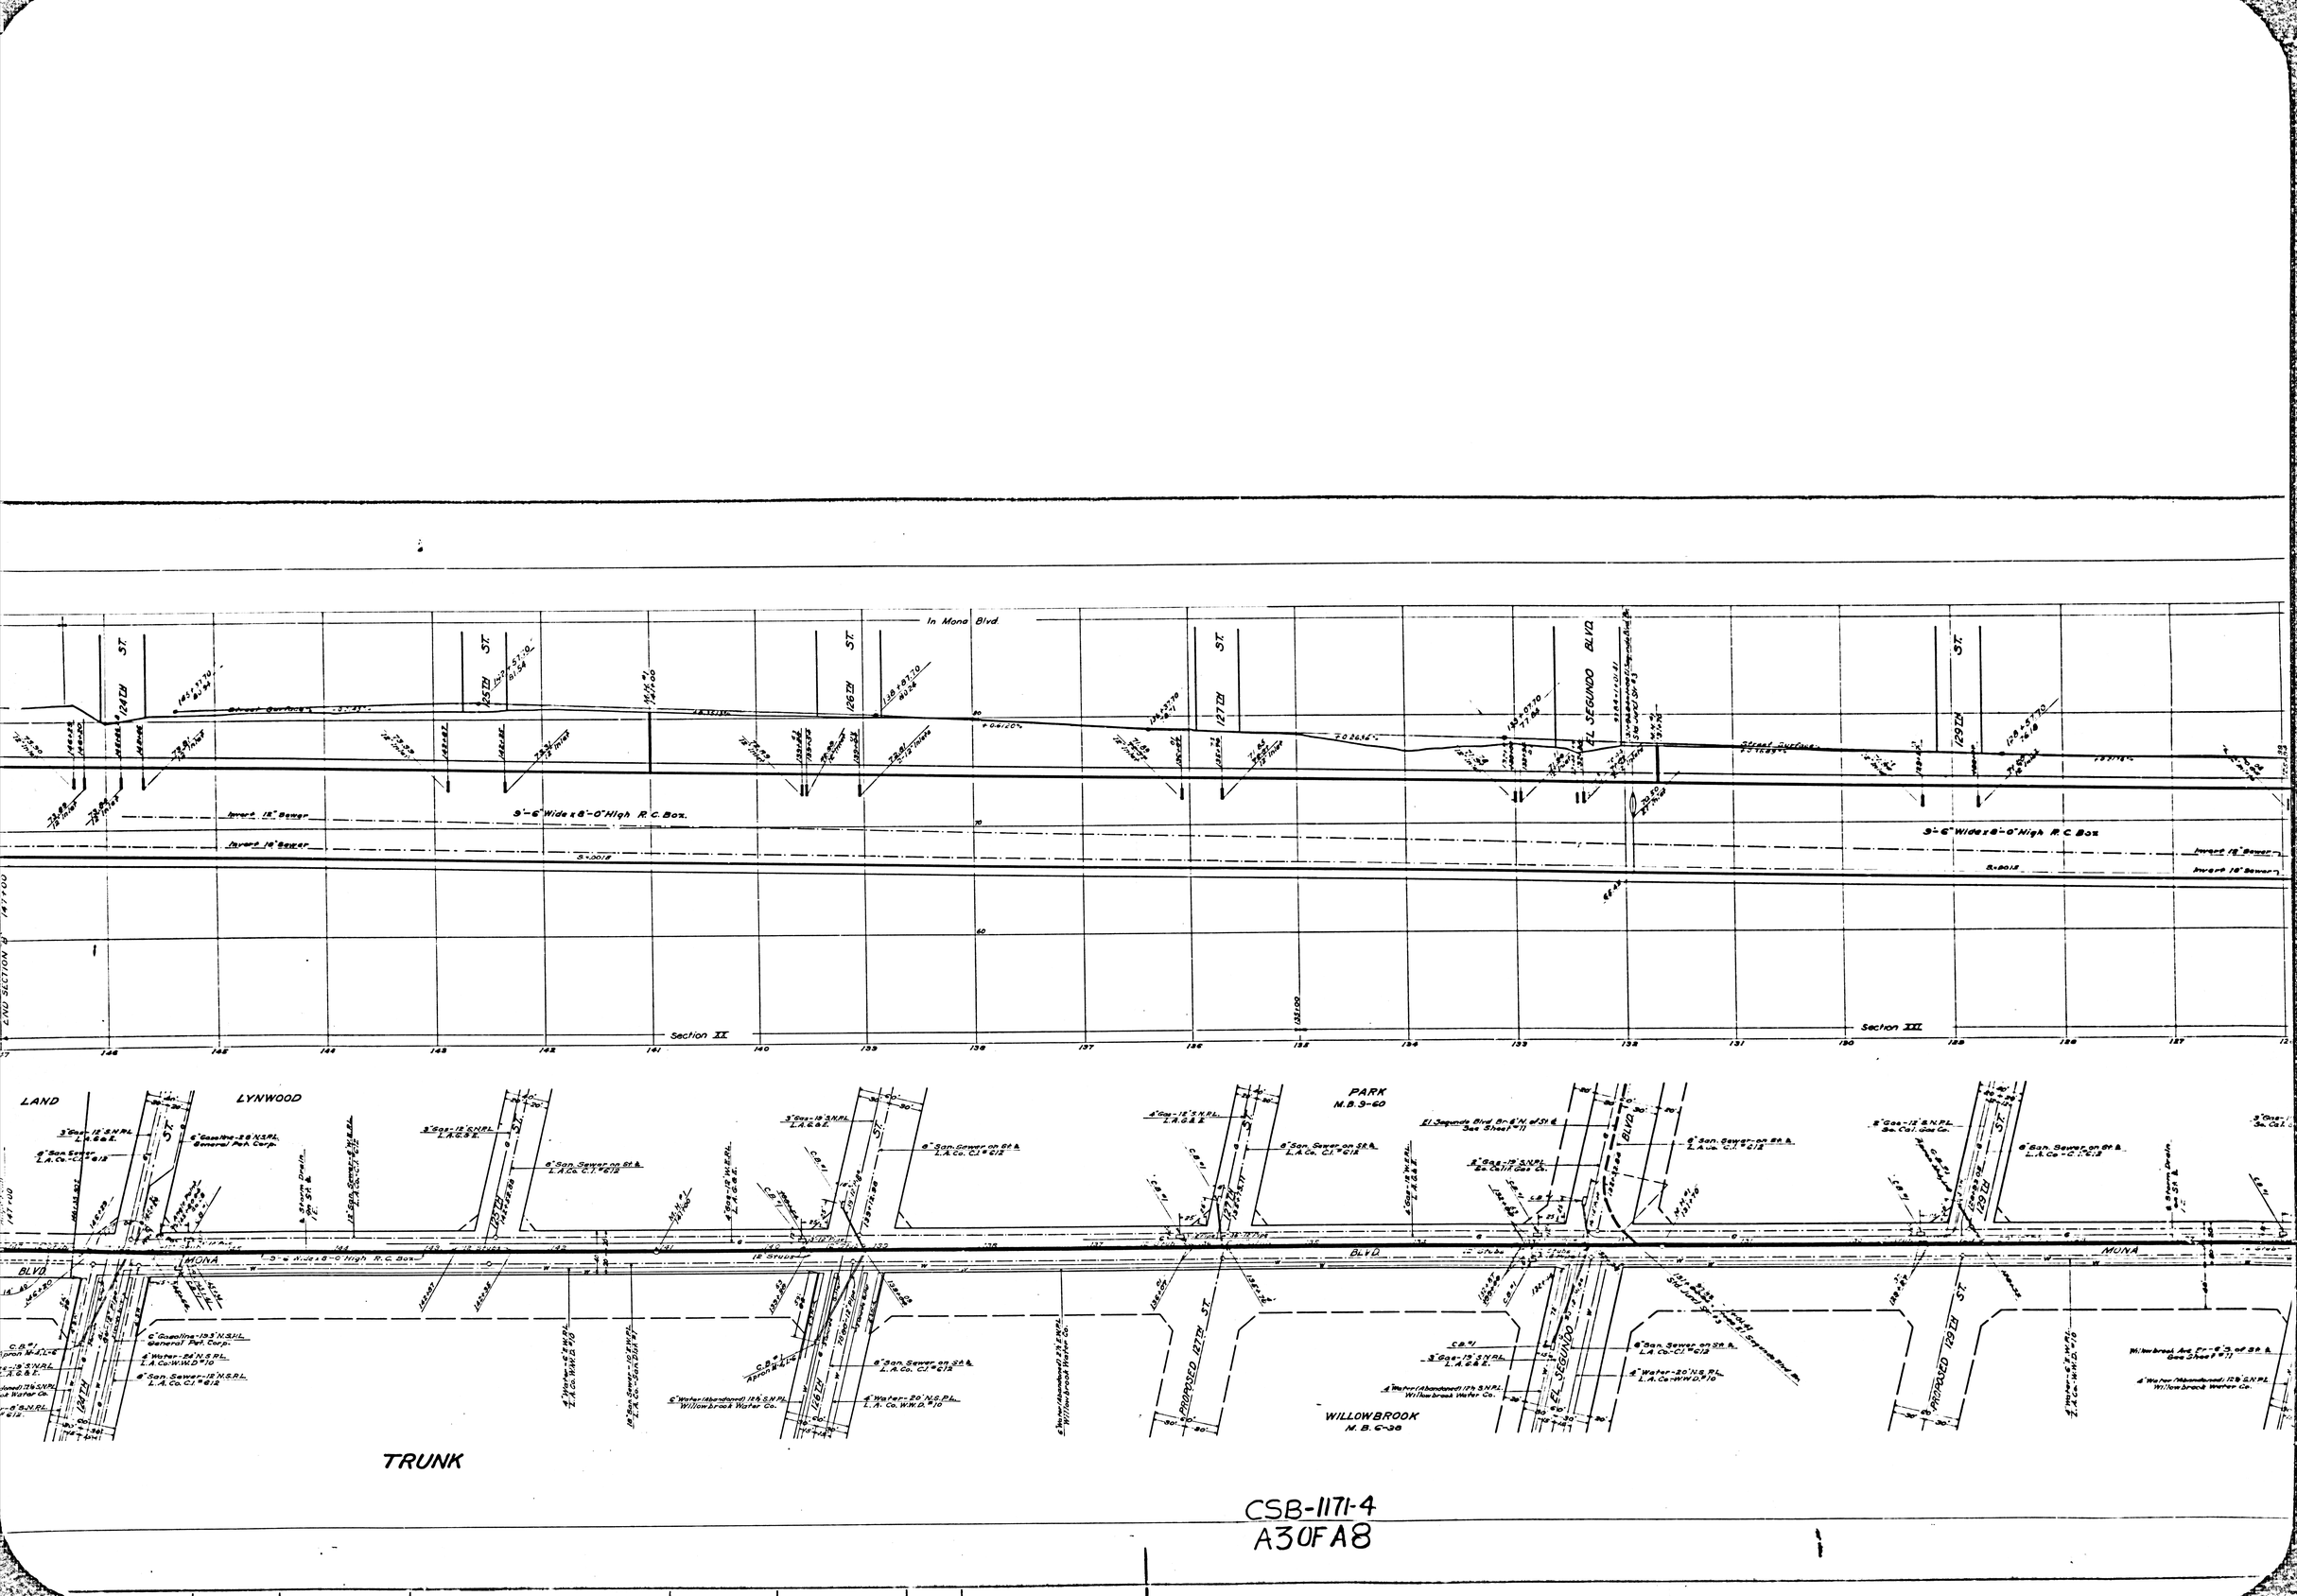


CSB-1171-4
A30FA8

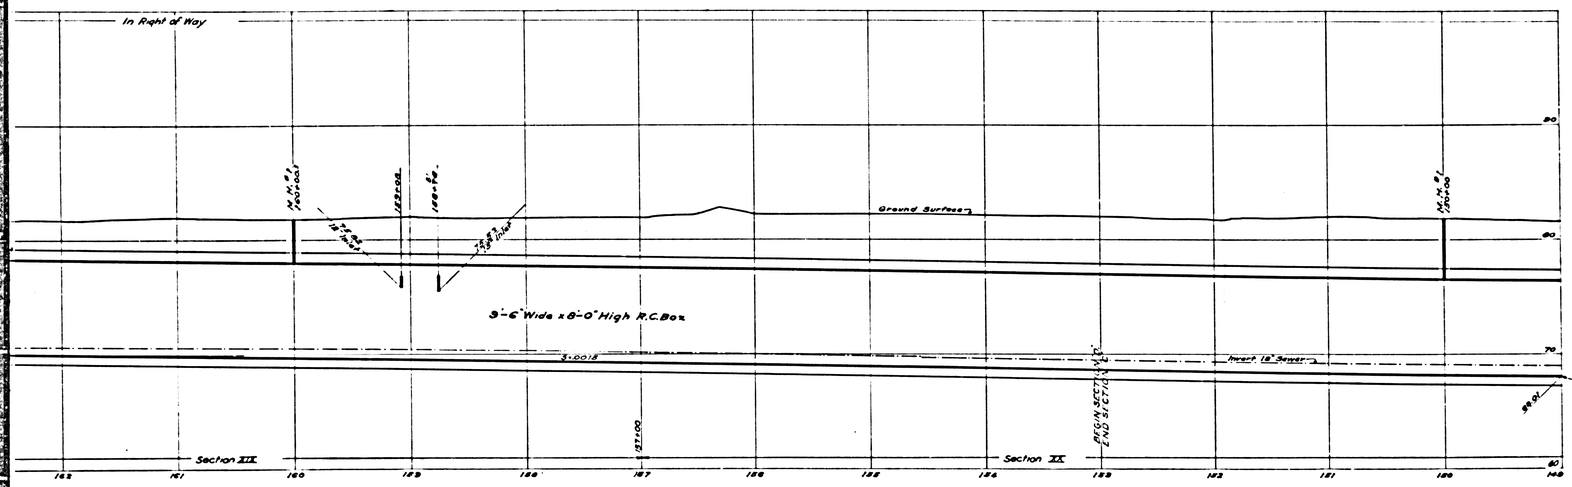

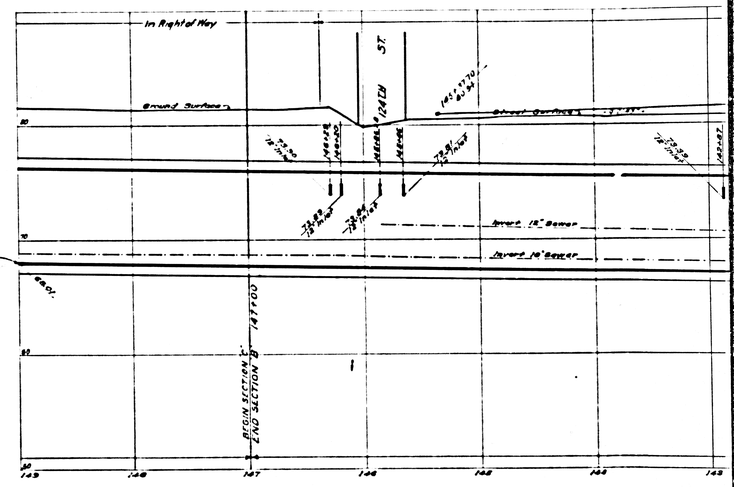

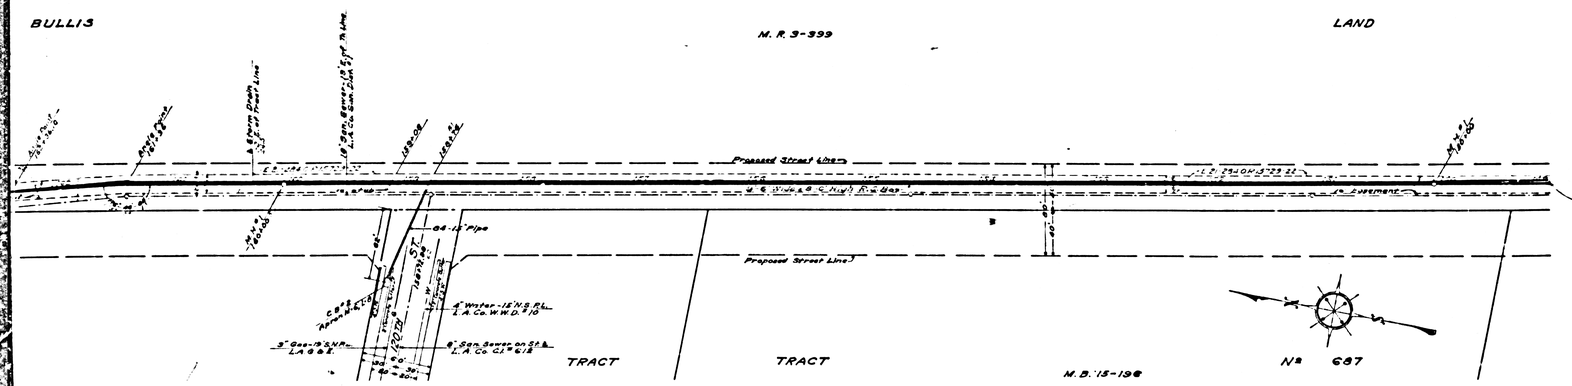

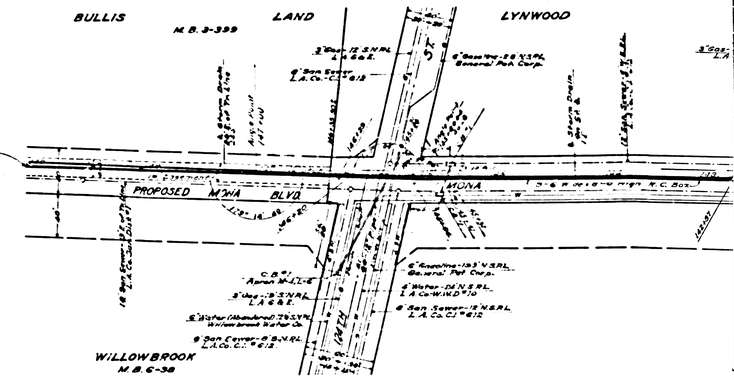

CSB-1171-4
A40FA8