MAP OF

LOS ANGELES COUNTY FIRE STATION SITE Nº40

~~SAN GABRIEL VALLEY~~ IN ~~MAP OF~~ THE

~~SANTA FE SPRINGS~~ COUNTY FIRE PROTECTION DISTRICT ~~LOT~~

CONSOLIDATED ~~PICO~~ FIRE STATION – ENGINE CO. NO. 40

LOTS 1 & 2. TRACT Nº 7805 M.B. 91-7&8.

COUNTY SURVEYORS MAP Nº B-1628

SCALE:-1 INCH = 20 FT.

INDEX 36

JOB NUMBER 8306

ALFRED JONES COUNTY SURVEYOR

SURVEYED DECEMBER 1940.

SURVEYED AT REQUEST OF COUNTY FORESTER AND FIRE WARDEN BY RULE 21. ORDINANCE 929. PER LETTER DATED NOVEMBER 22. 1940. BEARINGS ARE BASED ON THE BEARING OF DURFEE AVE. PER C.S. B-964

F.B. 898-201-206.

PLANE TABLE SHEET Nº E-188

FIELD WORK BY........ H.F. EVANS

FIELD WORK BY... F.C. GREENWOOD

OFFICE WORK BY........ D.A. WHITE

CHECKED BY...... K.R. McPHERSON

REVISED MARCH, 1948 – R.L.R.

DATUM – MEAN SEA LEVEL
ELEVATIONS SHOWN HEREON ARE BASED ON THE COUNTY ROAD DEPT. DATUM (B.M. Nº 2B B.O. 204-2) F.B. 1226-5.

CSB-1628
A1 OF A2

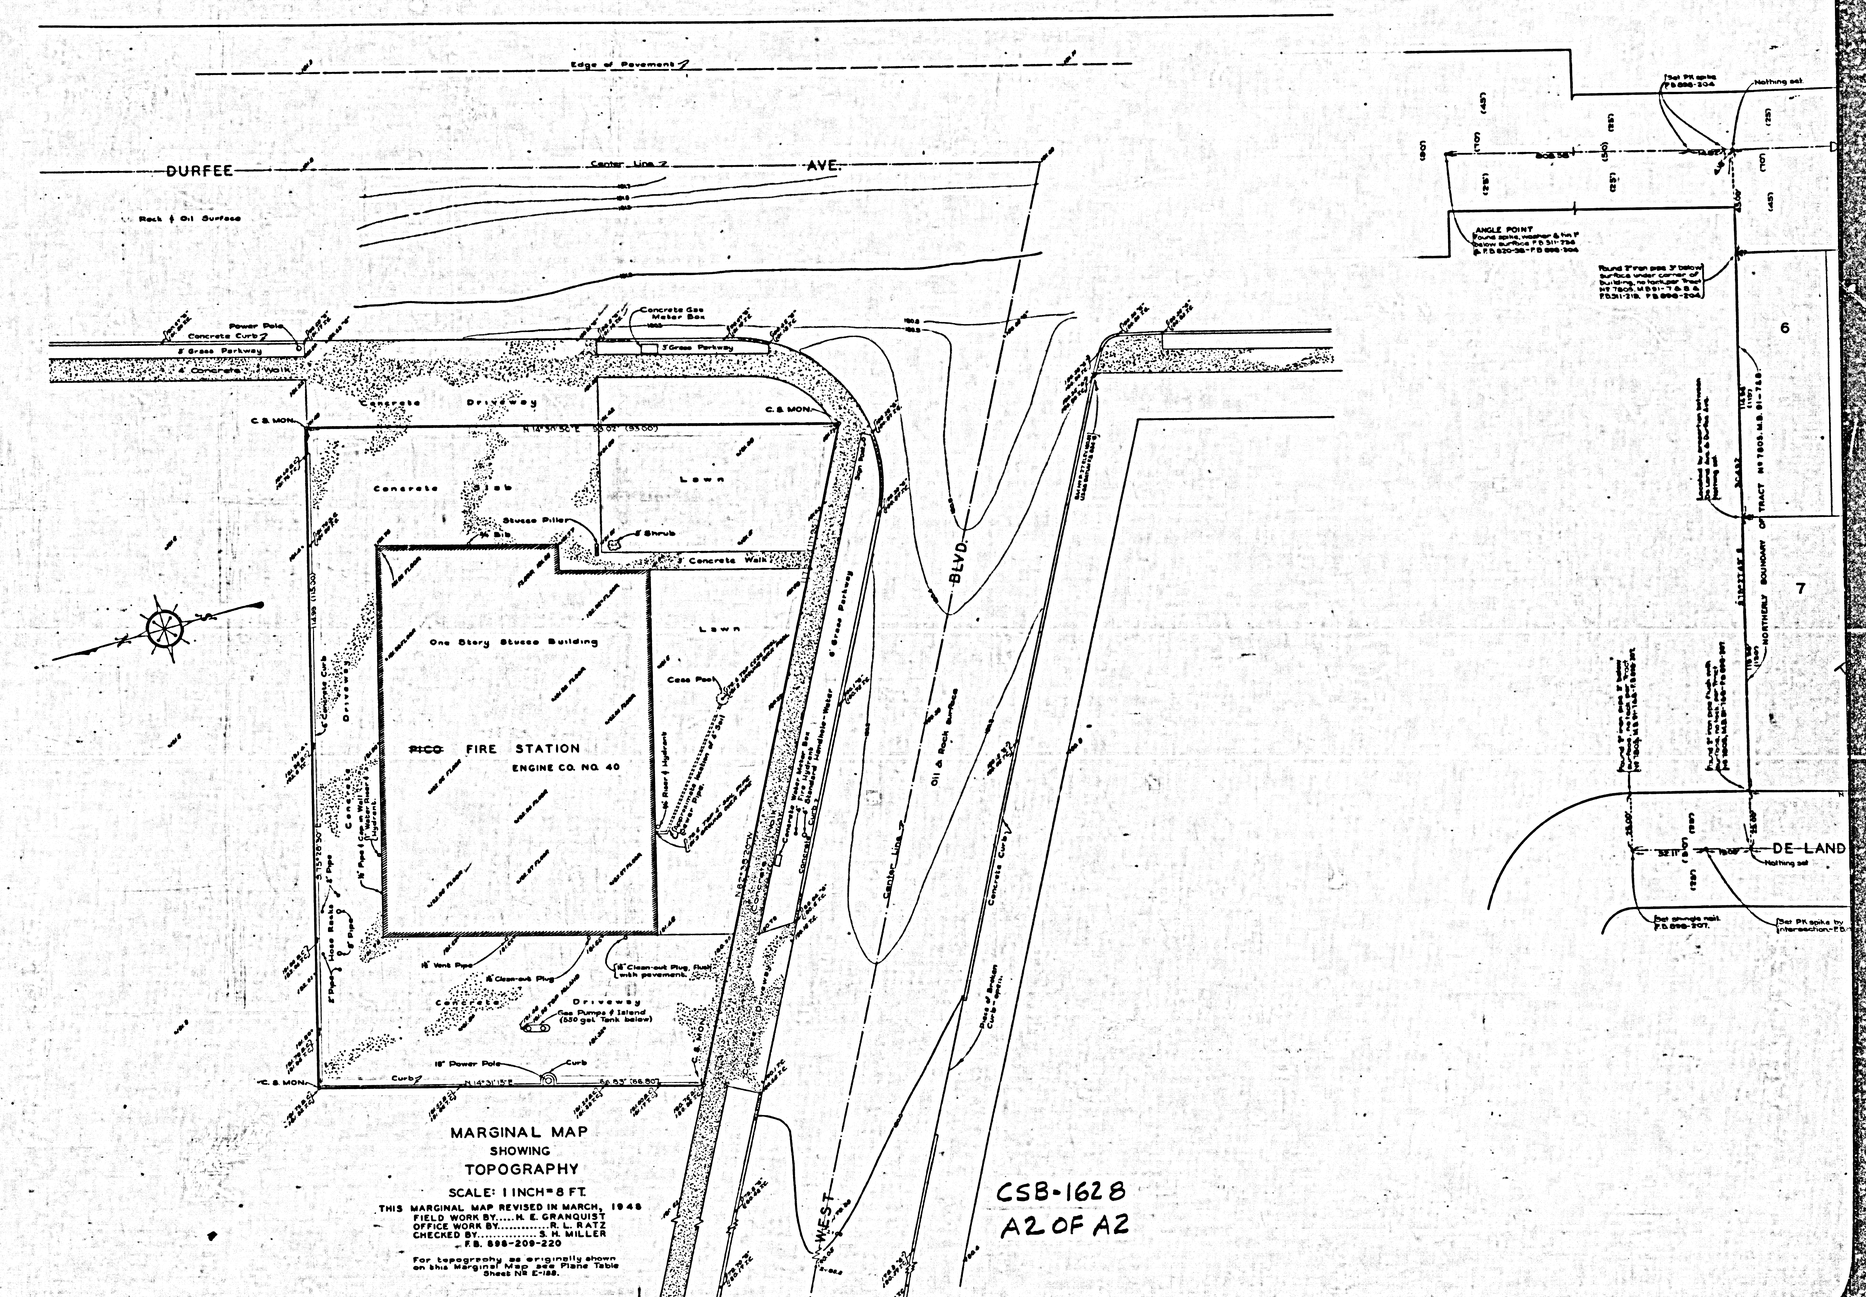

MARGINAL MAP
SHOWING
TOPOGRAPHY

SCALE: 1 INCH = 8 FT.

THIS MARGINAL MAP REVISED IN MARCH, 1948
FIELD WORK BY.....H. E. GRANQUIST
OFFICE WORK BY.....R. L. RATZ
CHECKED BY.....S. H. MILLER
F.B. 898-209-220

For topography as originally shown on this Marginal Map see Plane Table Sheet No E-188.

CSB-1628
A2 OF A2

COUNTY SURVEYORS MAP No B-1658