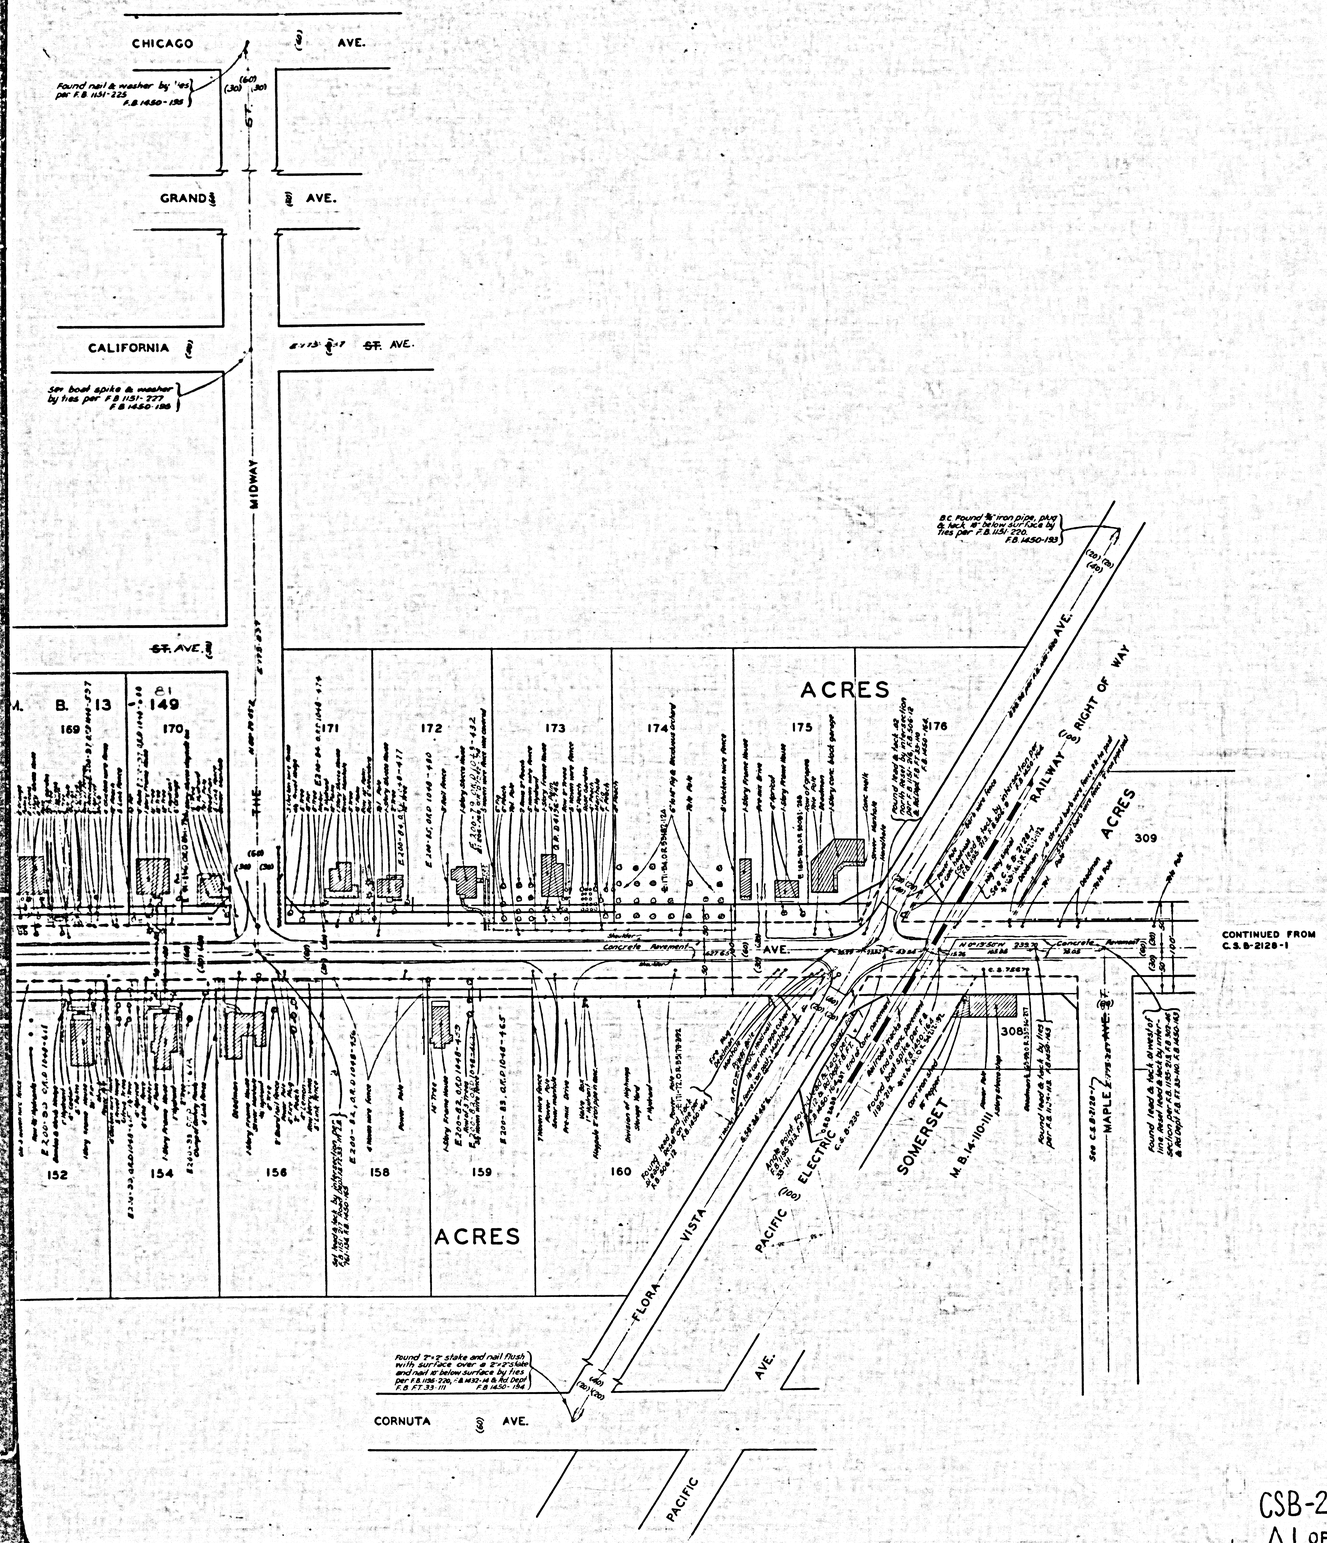


COUNTY OF LOS ANGELES

MAP OF

WOODRUFF AVENUE

SOUTH FROM ST.

ORANGETHORPE AVENUE

TO

IMPERIAL HIGHWAY

COUNTY SURVEYORS MAP NO. B-2128

SHEET NO. 2 OF 3 SHEETS

SCALE: 1 INCH = 50 FT.

JOB NUMBER 8519

C. E. ARNOLD - COUNTY SURVEYOR

SURVEYED AUG. 1948 TO FEB. 1949

SURVEYED ON REQUEST OF THE REGIONAL PLANNING COMMISSION UNDER SEC. 79, ORD. 4099 BY LETTER DATED JULY 30, 1948 & AS AUTHORIZED BY THE BOARD OF SUPERVISORS IN THEIR ORDER OF JUNE 1, 1938.

BEARINGS ARE BASED ON THE BEARING OF ROSECRANS AVE. AS SHOWN ON C.S.B-1649-5 & 6.

F. B. 1450-103-252 F.B. 1534-7-75

FIELD WORK	BY	R. L. WILLEY C. A. BENSON C. V. CRUMLEY F. H. BLANCHARD
OFFICE WORK	BY	H. U. M. HIGGINS R. L. RATZ C. E. DROWN
CHECKED	BY	S. H. MILLER Index 33

CSB-2128-2
A1 OF A3

CHICAGO AVE.

GRAND AVE.

CALIFORNIA ~~ST.~~ AVE.

OREGON

~~ST.~~ AVE.

SOMERSET

M. B. 13 - 149

M. B. 13 - 81

RANCHO LOS COYOTES

PAT. 1 - 493 - 494

SOMERSET ACRES

SHEETS 9 & 10

CENTER ST.

MIDWAY

WOODRUFF AVE.

CORNUTA AVE.

FLORA VISTA

PACIFIC

BLVD.

CSB-2128-2
A2 OF A3

RANCHO LOS COYOTES

PAT. 1 - 493 - 494

SOMERSET ACRES

SHEETS 9 & 10

RANCHO LOS COYOTES

PAT. 1 - 493 - 494

SOMERSET ACRES

M. B. 162 - 163

M. B. 13 - 81

PAT. 1-

CONTINUED ON C.S.B.-2128-3

WOODRUFF

(N.E. 1/4 S.E. 1/4) S.E.C. 22 T.3 S. R.12 W.

CENTER

CORNUTA AVE.

BELLFLOWER BLVD.

C.S.B.-117-2

C.S.B.-117-3

CSB-2128-2

A3 OF A3