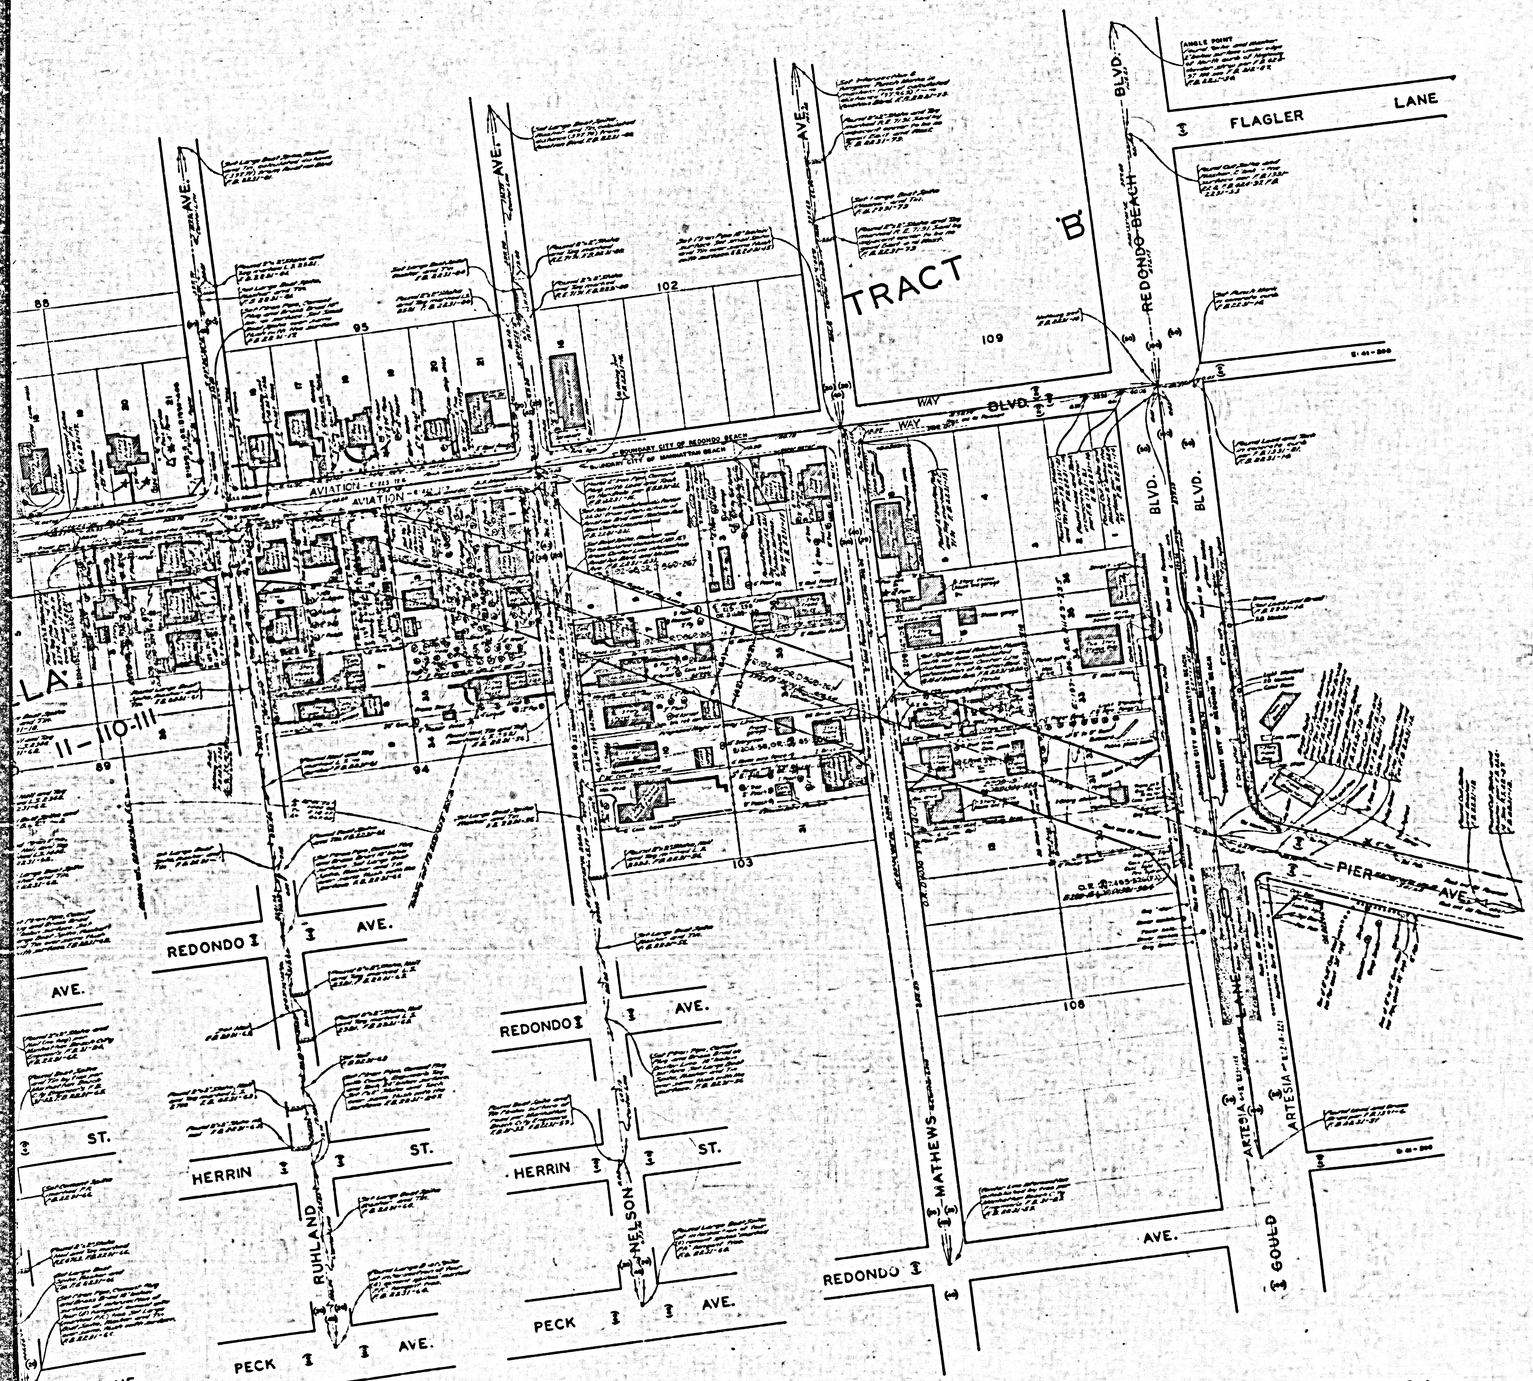


COUNTY OF LOS ANGELES

MAP OF

AVIATION BOULEVARD

FROM

ARTESIA ~~REDONDO~~ ~~BEACH~~ BOULEVARD

TO

MANHATTAN BEACH BOULEVARD

COUNTY SURVEYOR'S MAP NO. B-2433

SHEET NO. 1 OF 2 SHEETS

SCALE-1 INCH = 50 FT.

JOB NUMBER 9075.20

JOHN A. LAMBIE - COUNTY ENGINEER

SURVEYED JUNE 1956 - OCT. 1956

SURVEYED ON REQUEST OF THE REGIONAL PLANNING COMMISSION UNDER SEC. 79 ORD. 4099. BY LETTER DATED MARCH 22, 1957 AND BY BOARD ORDER DATED DEC. 11, 1951

BEARINGS ARE BASED ON THE CALIFORNIA COORDINATE SYSTEM ZONE 7 PER ACT 8351 GENERAL LAWS SEE C.S. 8428

LM. 25

F.B. 2235 - 8 - 239

FIELD WORK BY..... J.H. BROWN

OFFICE WORK BY..... L.C. WILSON

W.B. HABER

CHECKED BY..... J. AJA

Revised by H.M.F. Dong May 1963

CSB-2433-1

A1 OF A3

TRACT "B"

TRACT NO. 3

VILLA

M.B. 11-110-111

REDONDO

BLOSSOM LANE

MACKAY LANE

GREEN LANE

GREEN AVE.

PERRY BLVD.

PLANT AVE.

ROBINSON ST.

GRAHAM AVE.

GATES AVE.

AVIATION BLVD.

SLAUSON AVE.

5TH. ST.

3RD. ST.

6TH. AVE.

REDONDO AVE.

HERRIN ST.

PECK AVE.

1ST. AVE.

2ND. AVE.

CURTIS ST.

VOORHEES AVE.

RUHLAND AVE.

CSB-2433-1
A2 OF A3

REDONDO

VILLA

TRACT

M.B. 11 – 110-111

M.B. 10 – 185

BLOSSOM ½ LANE

GREEN ½ LANE

BLVD. ½

AVE.

WARFIELD ½ AVE.

DUFOUR ½ AVE.

BATAAN ½ AVE.

FARRELL ½ AVE.

ERNEST ½ AVE.

PERRY ½ AVE.

AVIATION BLVD.

AVIATION ½

CONTINUED ON C.S.B. 2433-2

WENDY WAY

ST. ½

12TH.

MANHATTAN BEACH ½

HARKNESS

HARKNESS ST.

SEE C.S.B. 2433-2

11TH. ½

10TH. ½

9TH. ½

8TH. ½

6TH. ½

5TH. ½

1ST. ½

REDONDO ½ AVE.

CSB-2433-1
A3 OF A3