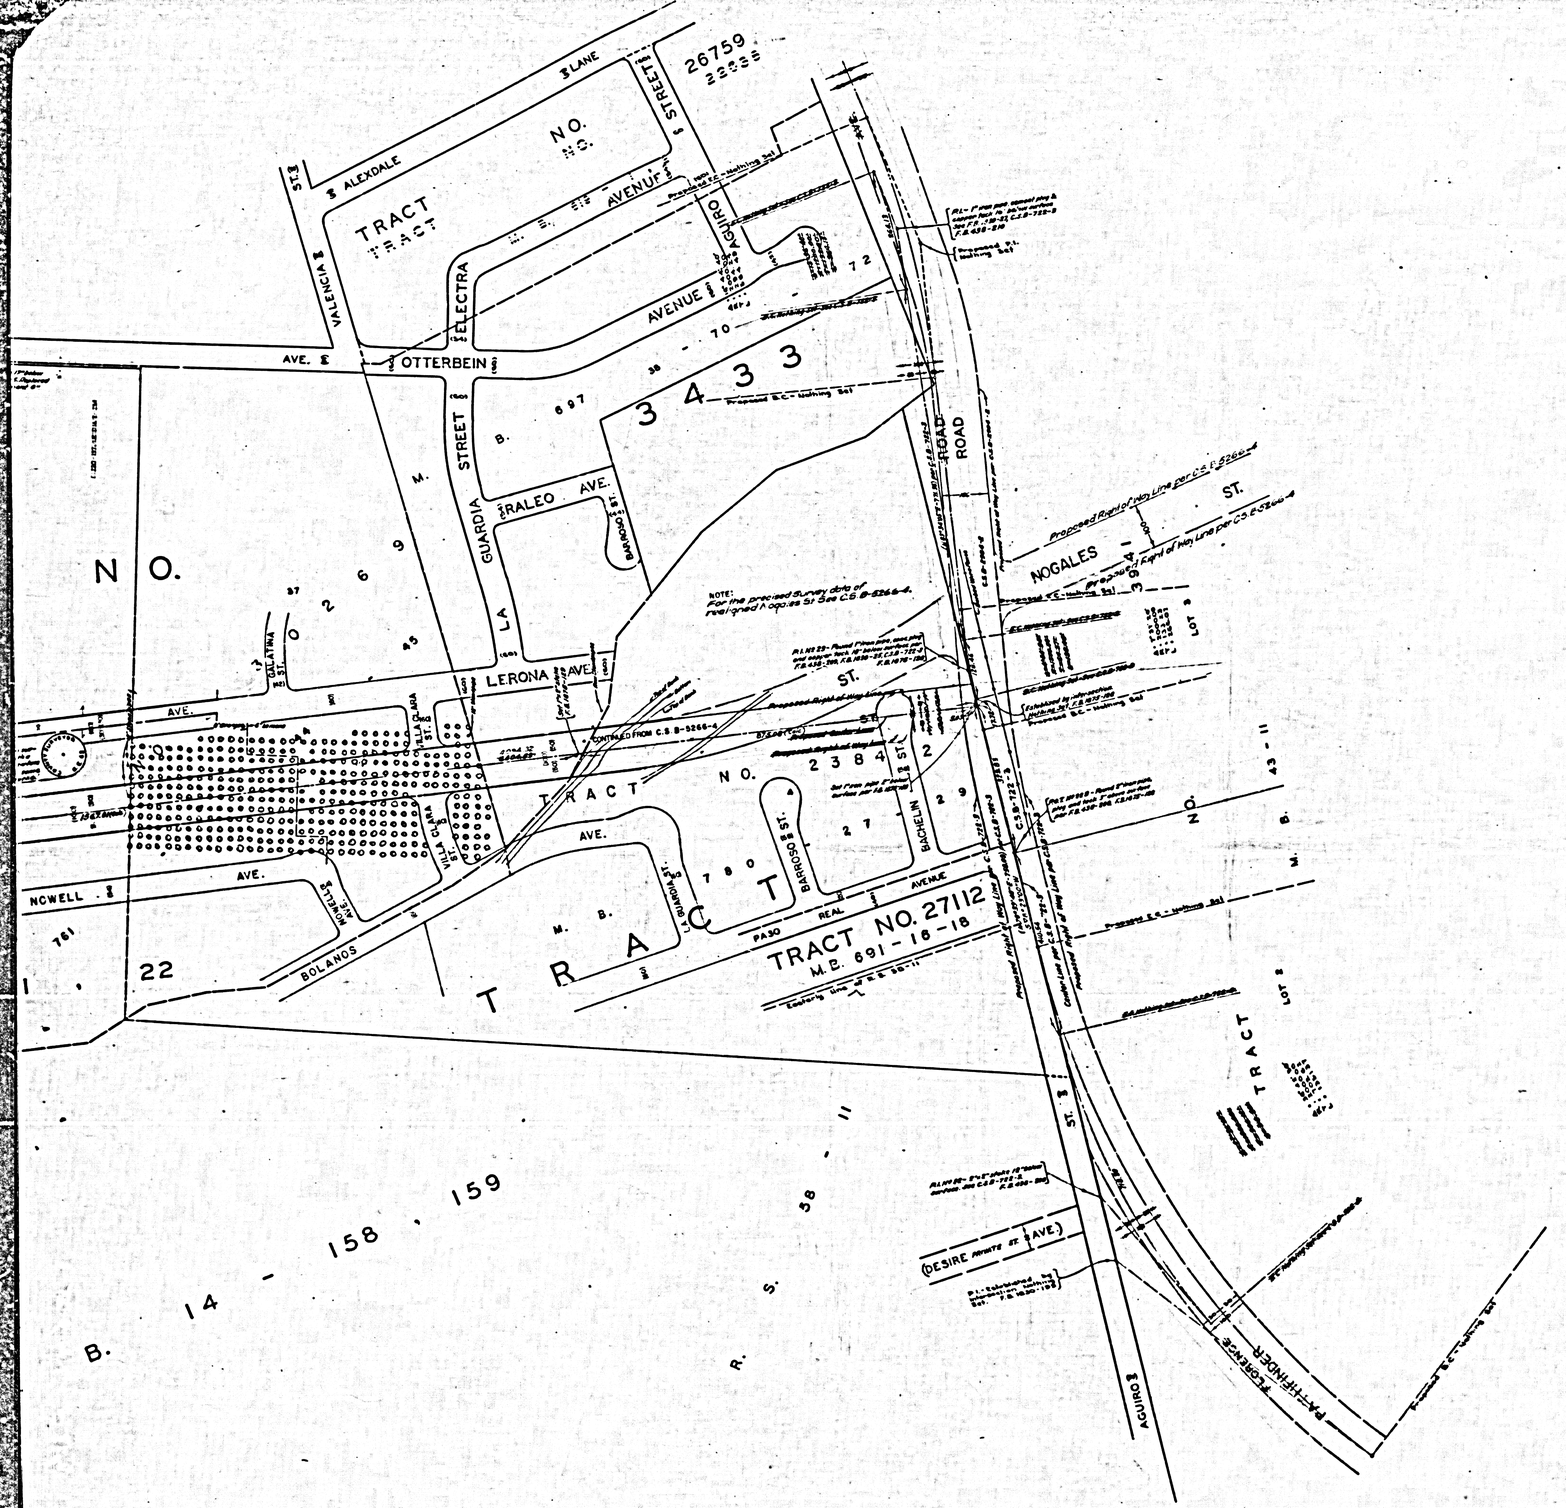


COUNTY OF LOS ANGELES
MAP OF
NOGALES STREET
FROM PATHFINDER ROAD
PROPOSED ~~FLORENCE AVENUE~~
TO AMAR ROAD
PROPOSED ~~TEMPLE AVENUE~~

COUNTY SURVEYORS MAP NO. B-2446-1
SHEET NO. 1 OF 2 SHEETS
SCALE: 1 INCH = 100 FT.

JOB NUMBER 6075 03

JOHN A. LAMBIE - COUNTY ENGINEER
SURVEYED JUNE 1955

SURVEYED ON REQUEST OF THE REGIONAL PLANNING COMMISSION UNDER SEC. 79 ORD. 4009 BY LETTER DATED MAY 16, 1958 AND BY BOARD ORDER DATED DEC. 11, 1951.

BEARINGS ARE BASED ON THE CALIFORNIA COORDINATE SYSTEM ZONE 7 PER ACT 6354 GENERAL LAWS SEE C. S. 8423

F.B. 1078-125-201

FIELD WORK BY G. PORTER
OFFICE WORK BY R.L. GREEN
CHECKED BY W. J. BREHNER

LM 54

CSB-2446-1
A1 OF A3

SECONDARY HIGHWAY CHANGED TO MAJOR HIGHWAY ON THE MASTER PLAN OF HIGHWAYS BY AMENDMENT NUMBER 427

ROWLAND TRACT

TRACT NO. 27097

TRACT NO. 30 M.B. 742 - 98

TRACT NO. 27607

TRACT NO. 27861 M.B. 702 - 7

TRACT NO. 0269 M.B. 14 - 158 . 159

GRAZIDE

OTTERBEIN AVE.

VALENCIA ST.

ALEXDALE ST.

ELECTRA ST.

LA GUARDIA STREET

GALLYNN ST.

LERONA AVE.

NOGALES ST.

NOWELL AVE.

BOLANOS AVE.

RALEO AVENUE

DAISETTA ST.

TRANBARGER ST.

ABDERA ST.

CUSTOZA

ELLESFORD AVE.

COMPANARIO DR.

GARRETA DRIVE

BARNEY ST.

BETLEY ST.

CARDONA ST.

M. AVENUE B.

FIFTH AVE.

GRAZIDE RD.

BOUNDARY LINE CITY OF INDUSTRY

IDENTICAL

R. F. 584

C.S.B.-191-B

H-45-3,4

MARGINAL MAP
SCALE: 1 IN. = 50 FT.

CSB-2446-1
A2 OF A3

COUNTY SURVEYOR'S MAP NO R-5248
SHEET NO 1 OF 3 SHEETS

OTTERBEIN AVE.

SAN JOSE ST.

FORSTER AND ROWLAND TRACT
M. B. 20 - 14, 15

FRONT ST.

RAILROAD

C.S. 6511 R/W

BOUNDARY LINE CITY OF INDUSTRY

FORSTER AND ROWLAND

WALNUT

M. B. 17 - 195

TRANBARGER ST.

ABDERA ST.

DAISETTA ST.

CUSTOZA

NOGALES

CONTINUED ON C.S.B-2446-2 S

LAKE

C. F. 170

JOHN A ROWLAND 166.64 ACS.

ANGELES

RAILROAD

RAILROAD ST.

R.S. 62 - 46

CSB-2446-1
A3 OF A3

MARGINAL MAP
SCALE: 1 IN. = 50 FT.

FIFTH AVE.

GRAZIDE RD.

ST.

O.R.D 2922 — 5

COUNTY SURVEYORS MAP NO R-5248
SHEET NO 1 OF 3 SHEETS