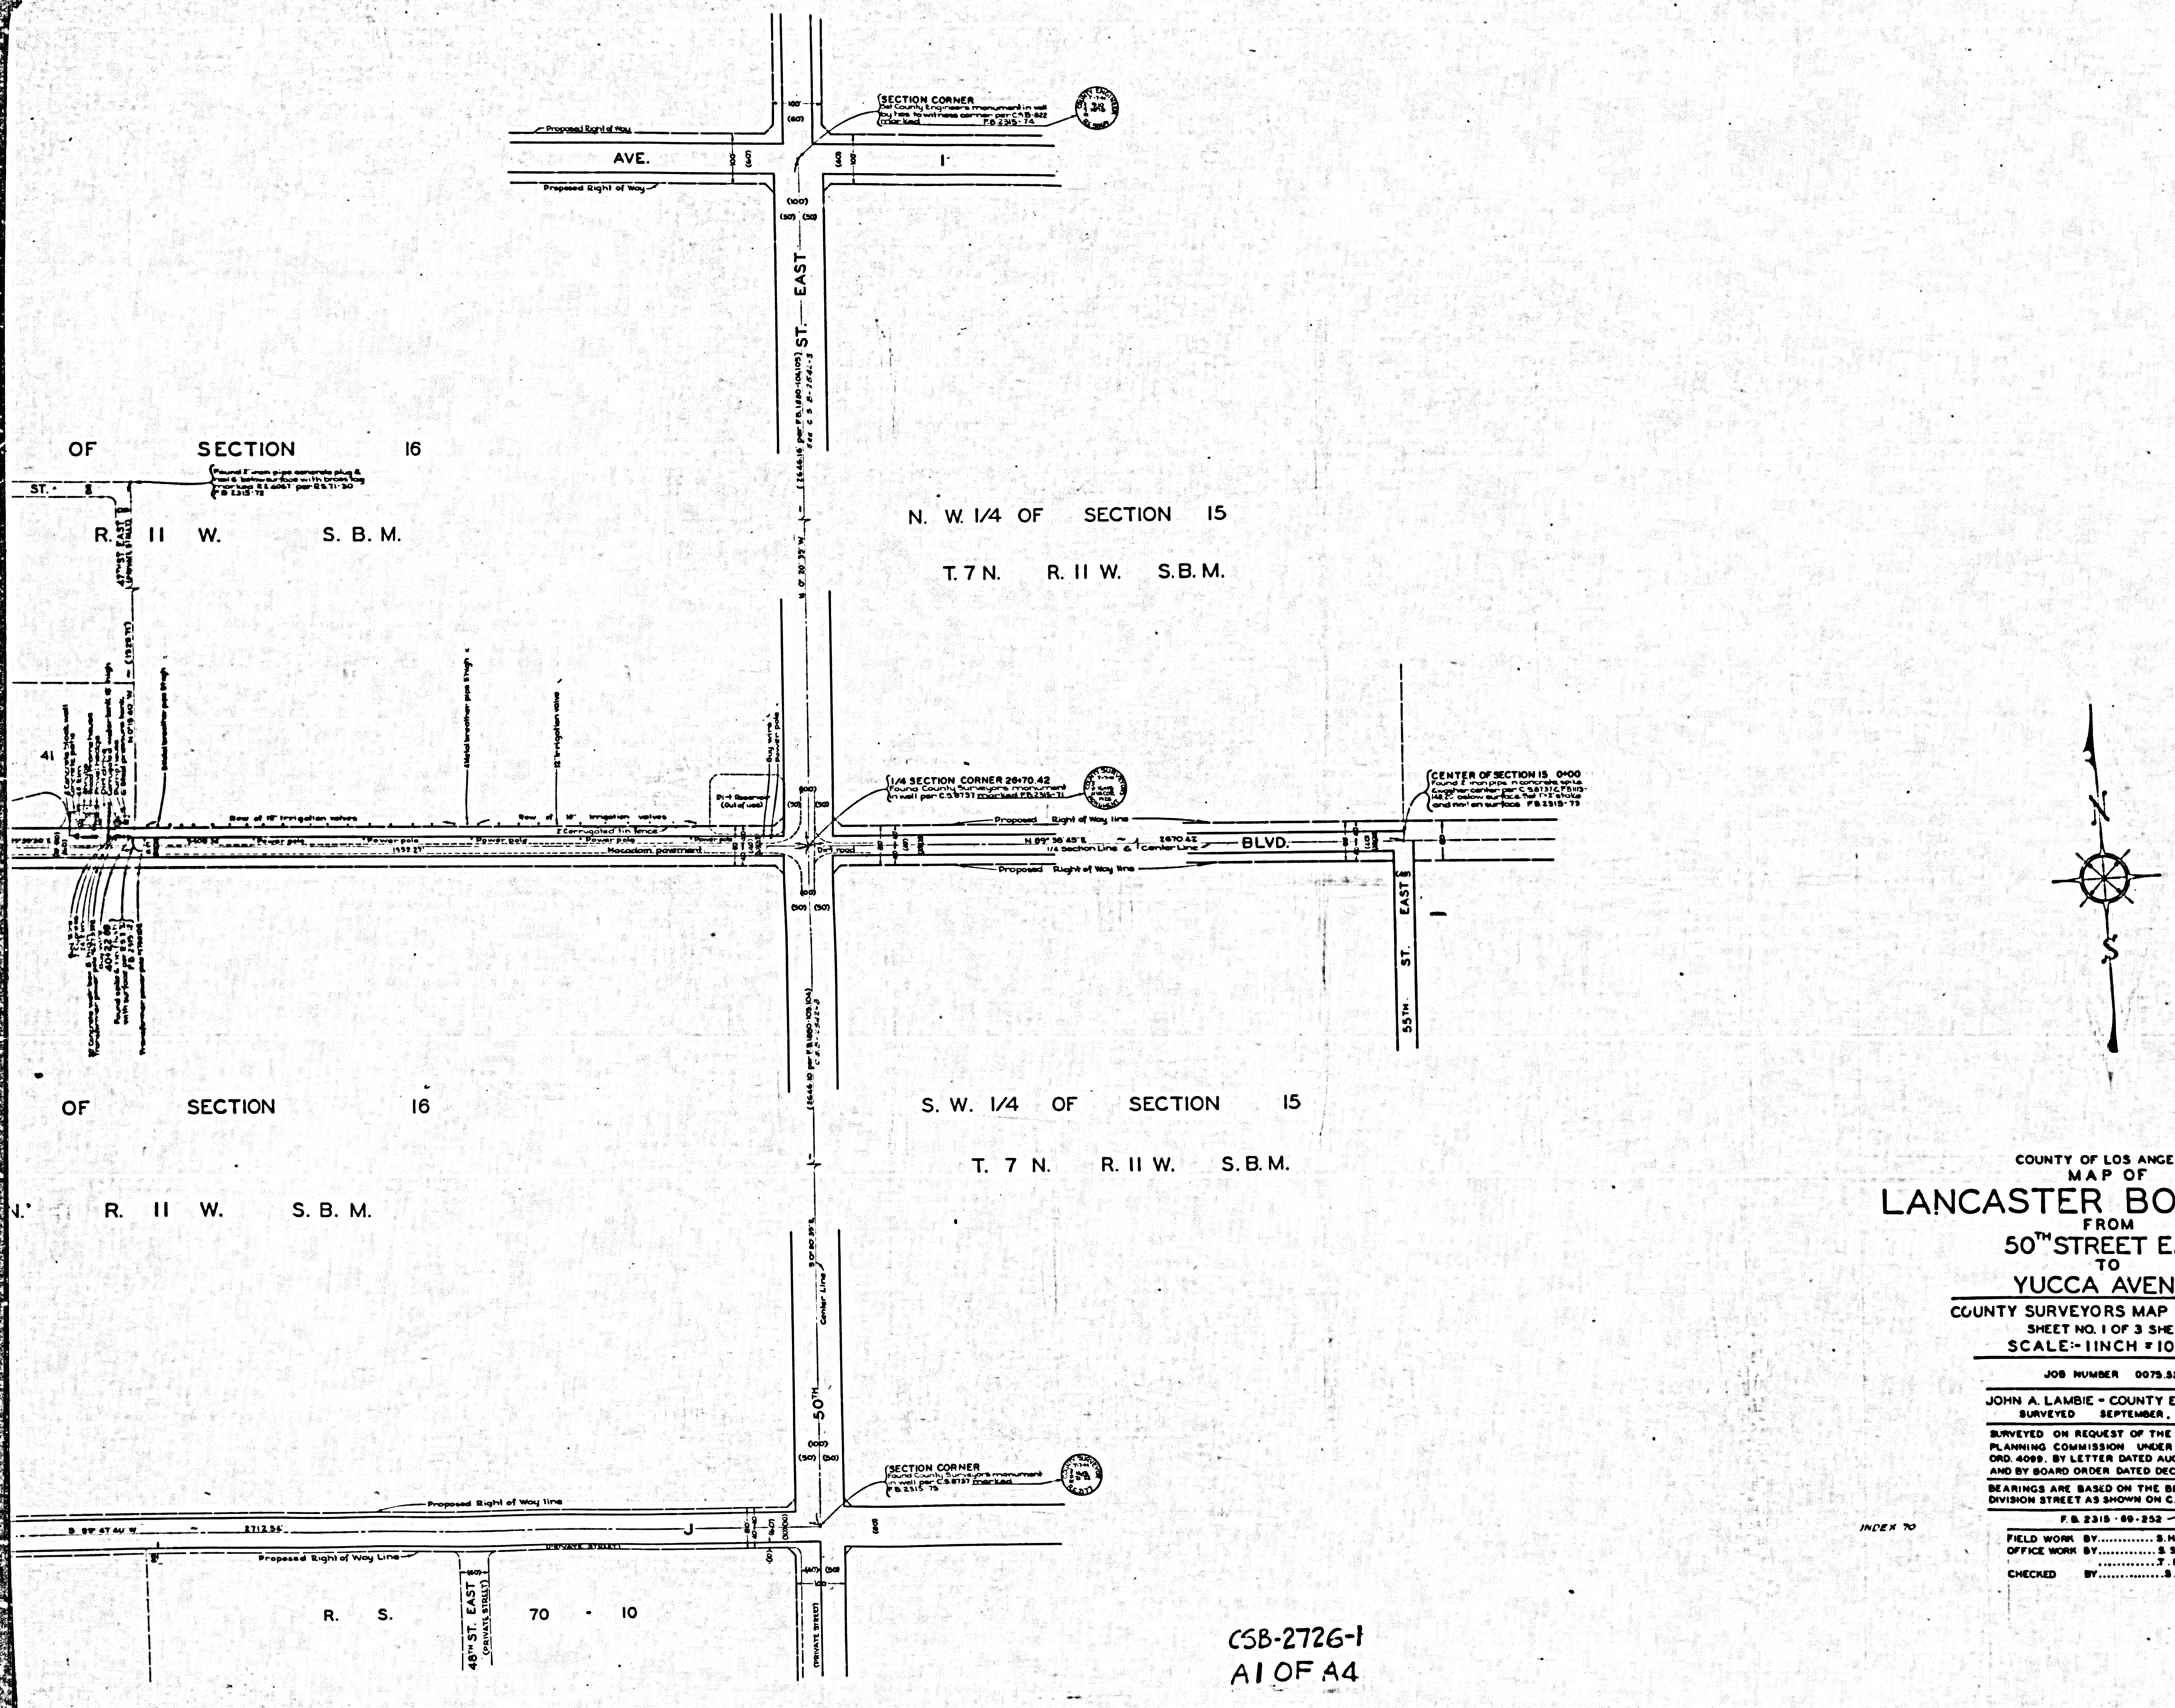
Proposed Right of Way
AVE.
I
Proposed Right of Way
100'
(60')
(100)
(50) (50)
SECTION CORNER
Set County Engineers monument in well by ties to witness corner per C.S.B-822 marked F.B. 2315-74
ST. EAST
OF SECTION 16
ST.
R. 11 W. S.B.M.
47TH ST. EAST
N.W. 1/4 OF SECTION 15
T. 7 N. R. 11 W. S.B.M.
41
Row of 18" irrigation valves
Corrugated tin fence
Power pole
Macadam pavement
Dirt Reservoir (Out of use)
Guy wire & Power pole
Dirt road
1/4 SECTION CORNER 26+70.42
Found County Surveyors monument in well per C.S. 8737 marked F.B. 2315-71
Proposed Right of Way line
N 89° 38' 45" E 2670.42
1/4 Section Line & Center Line
BLVD.
Proposed Right of Way line
CENTER OF SECTION 15 0+00
Found 2" iron pipe in concrete spike & washer center per C.S. 8737 C, F.B. 113-148, 2C below surface. Set 1"x2" stake and nail on surface F.B. 2315-73
55TH ST. EAST
N
S
OF SECTION 16
R. 11 W. S.B.M.
S.W. 1/4 OF SECTION 15
T. 7 N. R. 11 W. S.B.M.
Center Line
50TH
(100)
(50) (50)
SECTION CORNER
Found County Surveyors monument in well per C.S. 8737 marked F.B. 2315-75
Proposed Right of Way line
S 89° 47' 40" W 2712.54'
J
(PRIVATE STREET)
Proposed Right of Way Line
48TH ST. EAST (PRIVATE STREET)
(PRIVATE STREET)
R. S. 70 - 10

CSB-2726-1
A1 OF A4

COUNTY OF LOS ANGELES
MAP OF
# LANCASTER BOULEVARD
FROM
50TH STREET EAST
TO
YUCCA AVENUE

COUNTY SURVEYORS MAP NO. B-2726
SHEET NO. 1 OF 3 SHEETS
SCALE:- 1 INCH = 100 FT.

JOB NUMBER 0075.52

JOHN A. LAMBIE - COUNTY ENGINEER
SURVEYED SEPTEMBER, 1959

SURVEYED ON REQUEST OF THE REGIONAL PLANNING COMMISSION UNDER SECTION 79 ORD. 4099. BY LETTER DATED AUGUST 30, 1957 AND BY BOARD ORDER DATED DEC. 11, 1951.

BEARINGS ARE BASED ON THE BEARING OF DIVISION STREET AS SHOWN ON C.S.B-1344-1

F.B. 2315 - 69 - 252

INDEX 70

FIELD WORK BY............. S. HALISCKY
OFFICE WORK BY............. S. SHINODA
.... T. PALMERI
CHECKED BY............. S. MILLER

SECTION CORNER Found remains of 2" iron pipe with spike center 8" below surface per C.S. B-822 Reset with County Engineers monument in well marked F.B. 2315-84
Proposed Right of Way Line
1
EAST
ST.
N.0°00'25" E.
Center Line
Proposed Right of Way per C.S.B.
1/4 SECTION CORNER 80+78.76 Found County Surveyors monument in well per C.S. 8737 marked F.B. 2315-76
LANCASTER
Tel. pole
Proposed Right of Way
2 Woven wire fence 4 strand bar bed wire on top
Power pole
30" Cottonwood
N. W. 1/4 OF SECTION 16
T. 7 N R. 11 W. S.B.M.
Found 2" iron pipe, concrete plug tack & brass tag marked "R.E. 6067" per R.S. 71-30, F.B. 2315-79
EAST
ST.
42ND (PRIVATE ST.)
KETTERING
LANCASTER
43RD
(PRIVATE ST.)
48
47
46
45
Found 2" iron pipe concrete plug tack & brass tag marked R.E. 6067, 2' below surface per R.S. 71-30 F.B. 2315-80
ST.
(PRIVATE ST.)
R.
S.
Found spike washer & tin per F.B. 430-93
1/4 SECTION CORNER Found County Surveyors monument in well per C.S.B.-822 marked F.B. 2315-81
AVE.
AVE. (PRIVATE ST.)
Proposed Right of Way
1
EASTERLY LINE OF R.S. 71-30
EAST
ST.
1/4 SECTION LINE
Found 2" iron pipe concrete plug nail & brass tag marked R.E. 6067 per R.S. 71-30 F.B. 2315-78
KETTERING
71
30
Proposed Right of Way Line
Proposed Center Line
CENTER SEC.
44
43
42
41
BLVD.
ST. EAST
(PRIVATE ST.)
Found 2" iron pipe, concrete plug & nail 10" below surface with tag marked R.E. 6067 per R.S. 71-30 F.B. 2315-77
N. E. 1/4 OF SECTION 16
ST.
Found 2" iron pipe concrete plug & nail 6" below surface with brass tag marked R.E. 6067 per R.S. 71-30 F.B. 2315-72
T. 7 N. R. 11 W. S.B.M.
47TH ST. EAST (PRIVATE STREET)
AVE.
Proposed Right of Way
Power pole
Macadam
S. W. 1/4 OF SECTION 16
T. 7 N. R. 11 W. S.B.M.
S. E. 1/4 OF SECTION 16
T. 7 N. R. 11 W. S.B.M.
40TH
SECTION CORNER Found County Surveyors monument in well per C.S. 8737 & F.B. 1880-132 marked F.B. 2315-83
AVENUE
S 89°47'45" W 2712.51
45TH
1/4 SECTION CORNER Found County Surveyors monument 34" below surface per F.B. 1880-131 Set County Engineers monument over same in well, marked F.B. 2315-82
C.S.B.-2542-3
S 89°47'40" W 2712.94
Center Line
Proposed Right of Way line
Proposed Right of Way Line
(PRIVATE STREET)
R. S. 70 - 10
48TH ST. EAST (PRIVATE STREET)

CSB-2726-1
A2 OF A4

AVE.
I
Proposed Right of Way Line
1/4 SECTION CORNER
Found County Surveyors monument 22" below surface per C.S. B-822 marked
Set 1"-2" stake flush with surface over same
F.B. 2315-89
SECTION CORNER
Found remains of 2" iron pipe with spike center 8" below surface per C.S. B-822. Reset with County Engineers monument in well marked
F.B. 2315-84
EAST
ST.
35TH
40TH
Center Line
SECTION 17
R. 11 W. S. B. M.
N. E. 1/4 OF SECTION 17
T. 7 N. R. 11 W. S. B. M.
N. W. 1/4
T. 7 N.
CENTER SECTION 17 107+51.59
Set County Engineers monument in well by intersection marked F.B. 2315-86
1/4 SECTION CORNER 80+78.76
Found County Surveyors monument in well per C.S. 8737 marked
F.B. 2315-76
BLVD.
LANCASTER
Tel pole
Power pole
2 Woven wire fence, 4 strand bar bed wire on top
Proposed Right of Way
S. E. 1/4 OF SECTION 17
T. 7 N. R. 11 W. S. B. M.
S. W. 1/4
T. 7 N.
1/4 SECTION CORNER
Found County Surveyors monument 22" below surface marked per C.S. 87.37. Set 1"-2" stake flush with surface over same
F.B. 2315-90
SECTION CORNER
Found County Surveyors monument in well per C.S. 8737 & F.B. 1880-132
marked
F.B. 2315-83
C.S. 8202
AVENUE
Proposed Right of Way Line

CSB-2726-1
A3 OF A4

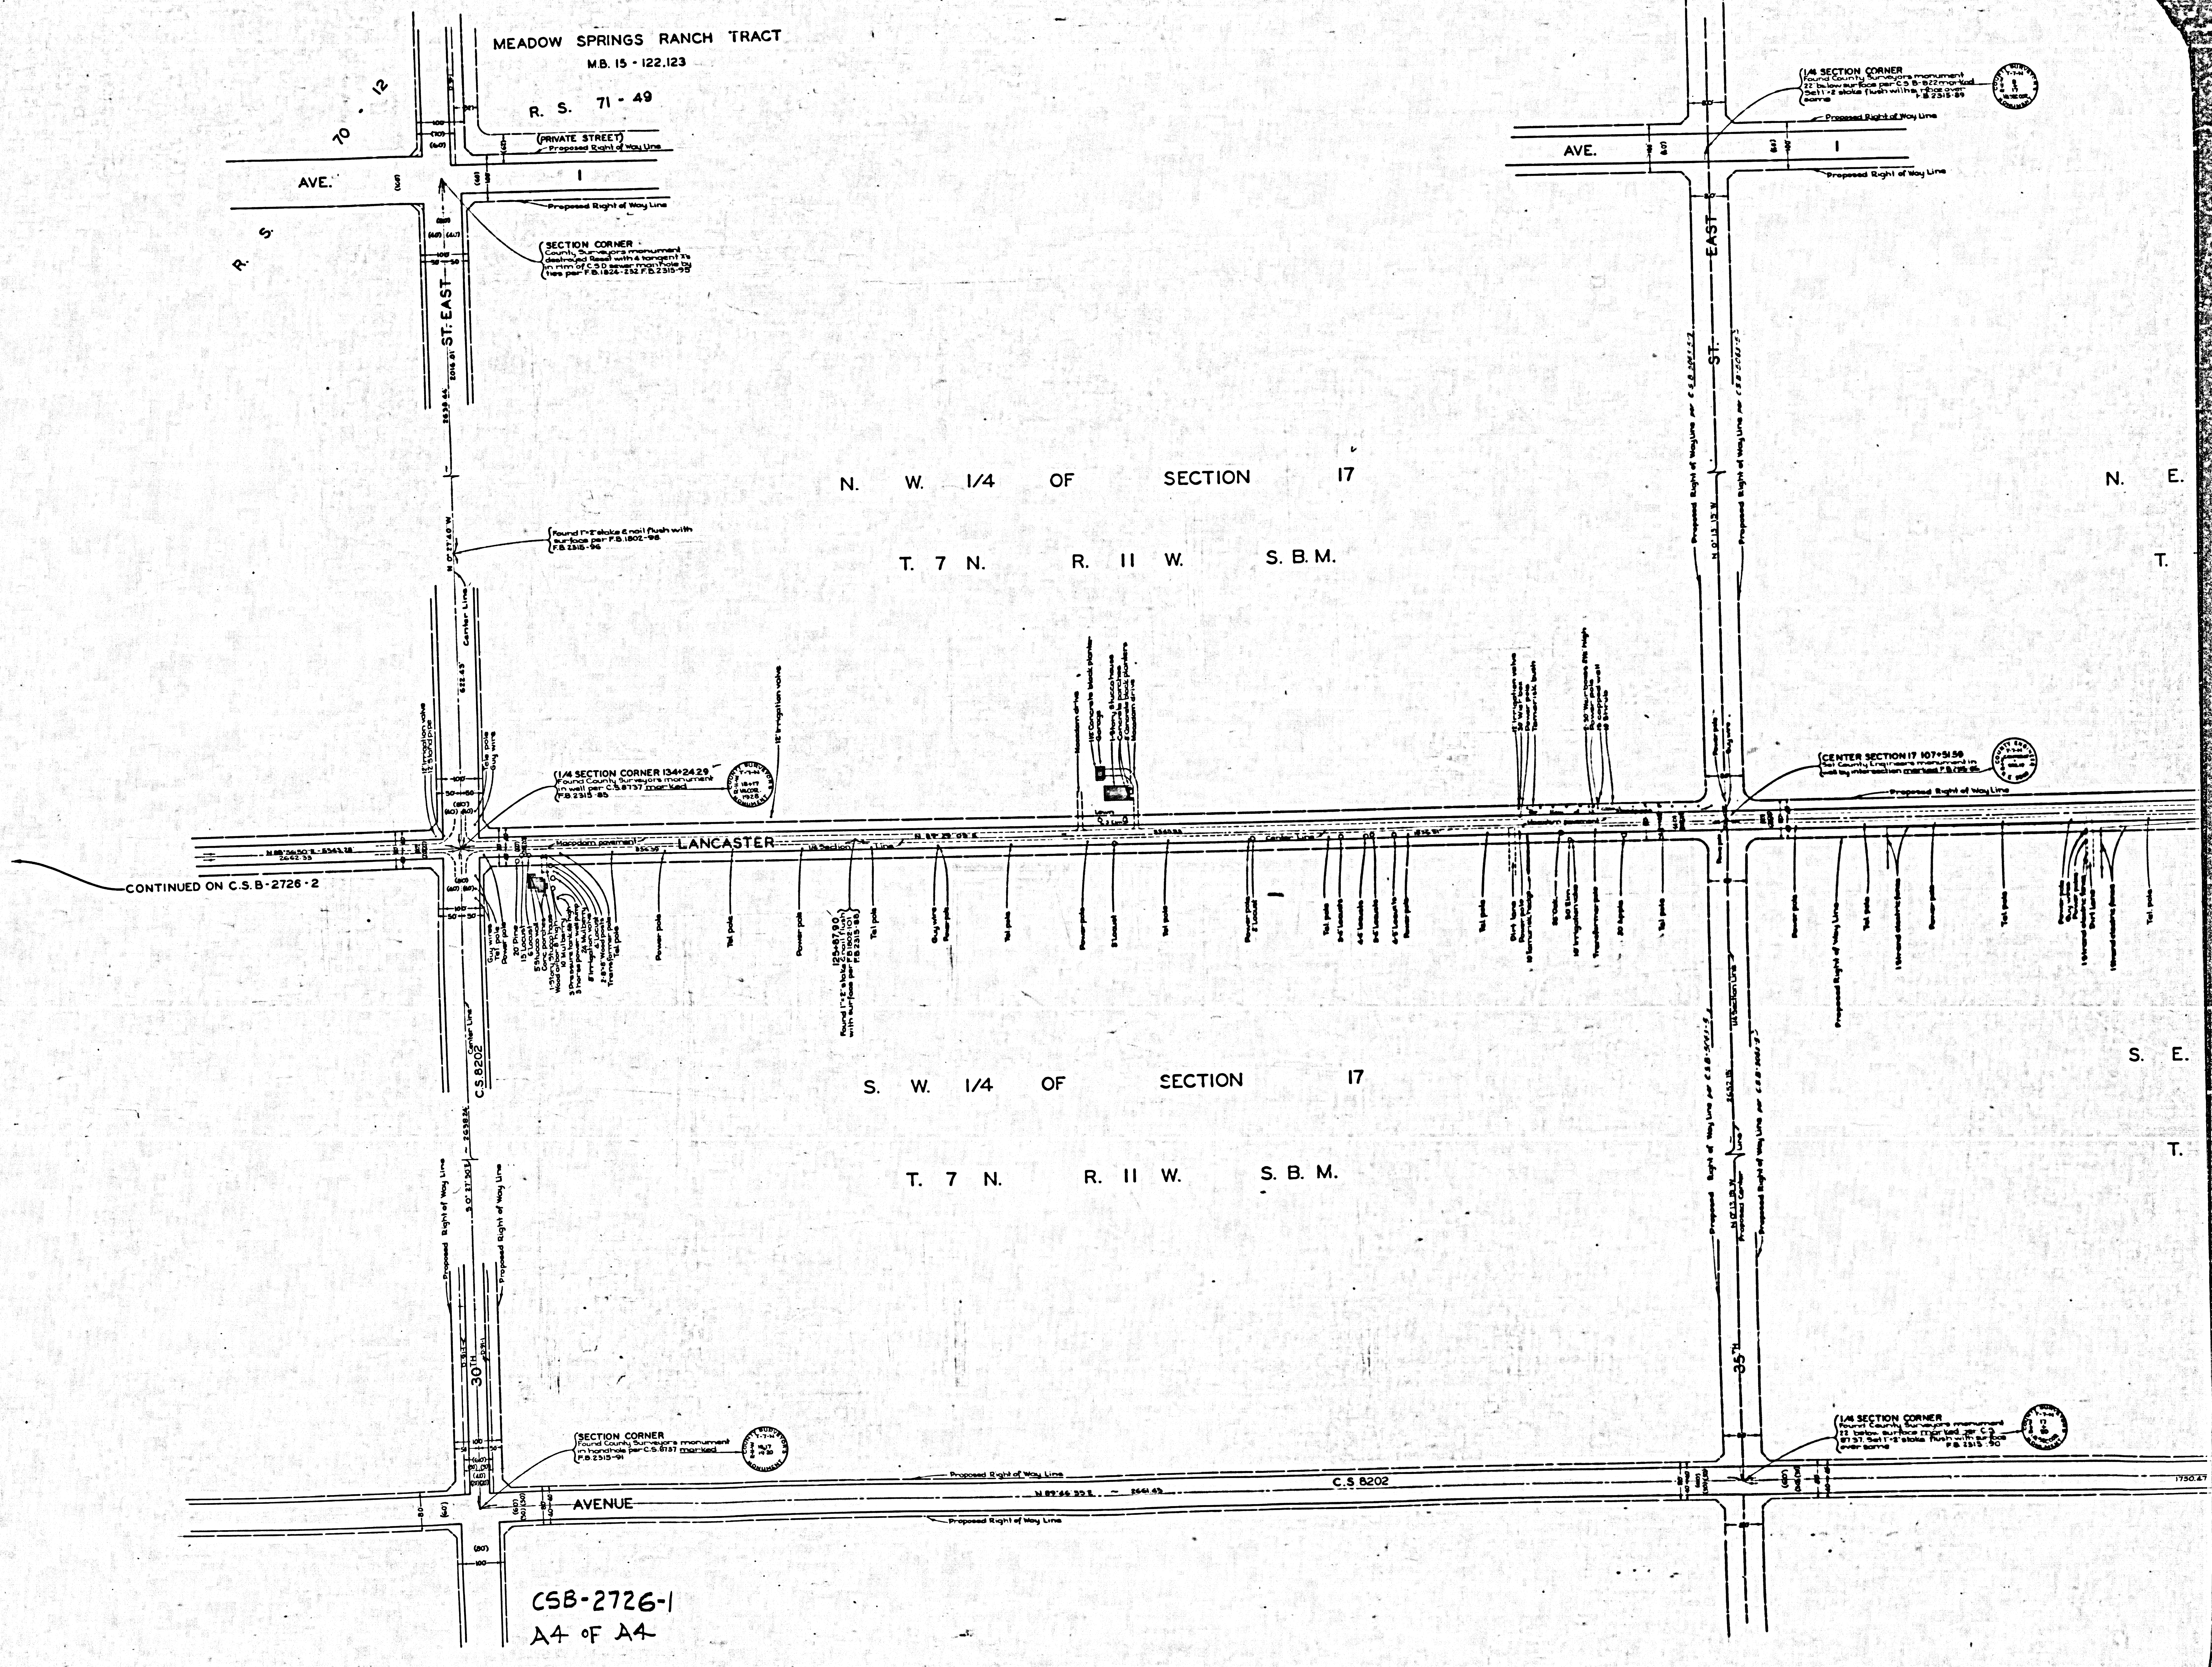
MEADOW SPRINGS RANCH TRACT
M.B. 15 - 122.123
R. S. 71 - 49
R. S. 70 - 12
R. S.
(PRIVATE STREET)
Proposed Right of Way Line
AVE.
1
SECTION CORNER
County Surveyors monument destroyed Reset with 4 tangent X's in rim of C.S.D sewer manhole by ties per F.B.1824-232 F.B.2315-95
30TH ST. EAST
Found 1"×2" stake & nail flush with surface per F.B.1802-98. F.B.2315-96
Center Line
1/4 SECTION CORNER 134+24.29
Found County Surveyors monument in well per C.S.8737 marked F.B.2315-85
COUNTY SURVEYORS MONUMENT T-7-N R-11-W 18+17 WACOR. 1928
12" Irrigation valve
Tele. pole
Guy wire
Macadam pavement
LANCASTER
1/4 Section Line
CONTINUED ON C.S.B-2726-2
N. W. 1/4 OF SECTION 17
T. 7 N. R. 11 W. S. B. M.
S. W. 1/4 OF SECTION 17
T. 7 N. R. 11 W. S. B. M.
N. E.
T.
S. E.
T.
C.S.8202
Proposed Right of Way Line
Power pole
Tel. pole
1/4 SECTION CORNER
Found County Surveyors monument 22" below surface per C.S. B-822 marked Set 1"×2" stake flush with surface over same F.B.2315-89
AVE.
1
EAST ST.
35TH
CENTER SECTION 17 107+51.58
Set County Engineers monument in well by intersection marked F.B.2315-86
COUNTY ENGINEER
SECTION CORNER
Found County Surveyor's monument in handhole per C.S.8737 marked F.B.2315-91
COUNTY SURVEYOR'S MONUMENT T-7-N 19,17 19,20
AVENUE
C.S 8202
1/4 SECTION CORNER
Found County Surveyors monument 22" below surface marked per C.S. 8737. Set 1"×2" stake flush with surface over same F.B.2315-90

CSB-2726-1
A4 of A4